
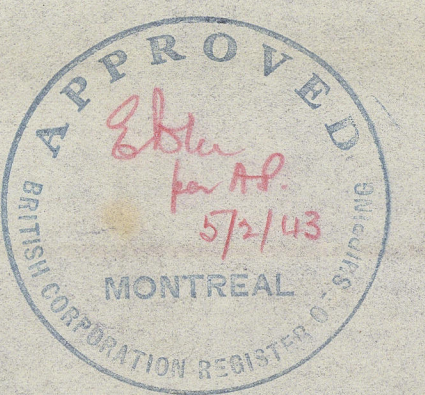


3600 TON OIL TANKERS GENERAL ARRANGEMENT SCALE: 1/8" = 1 FOOT

3 JUN 1943

*Approved
Continued
16.6.43*

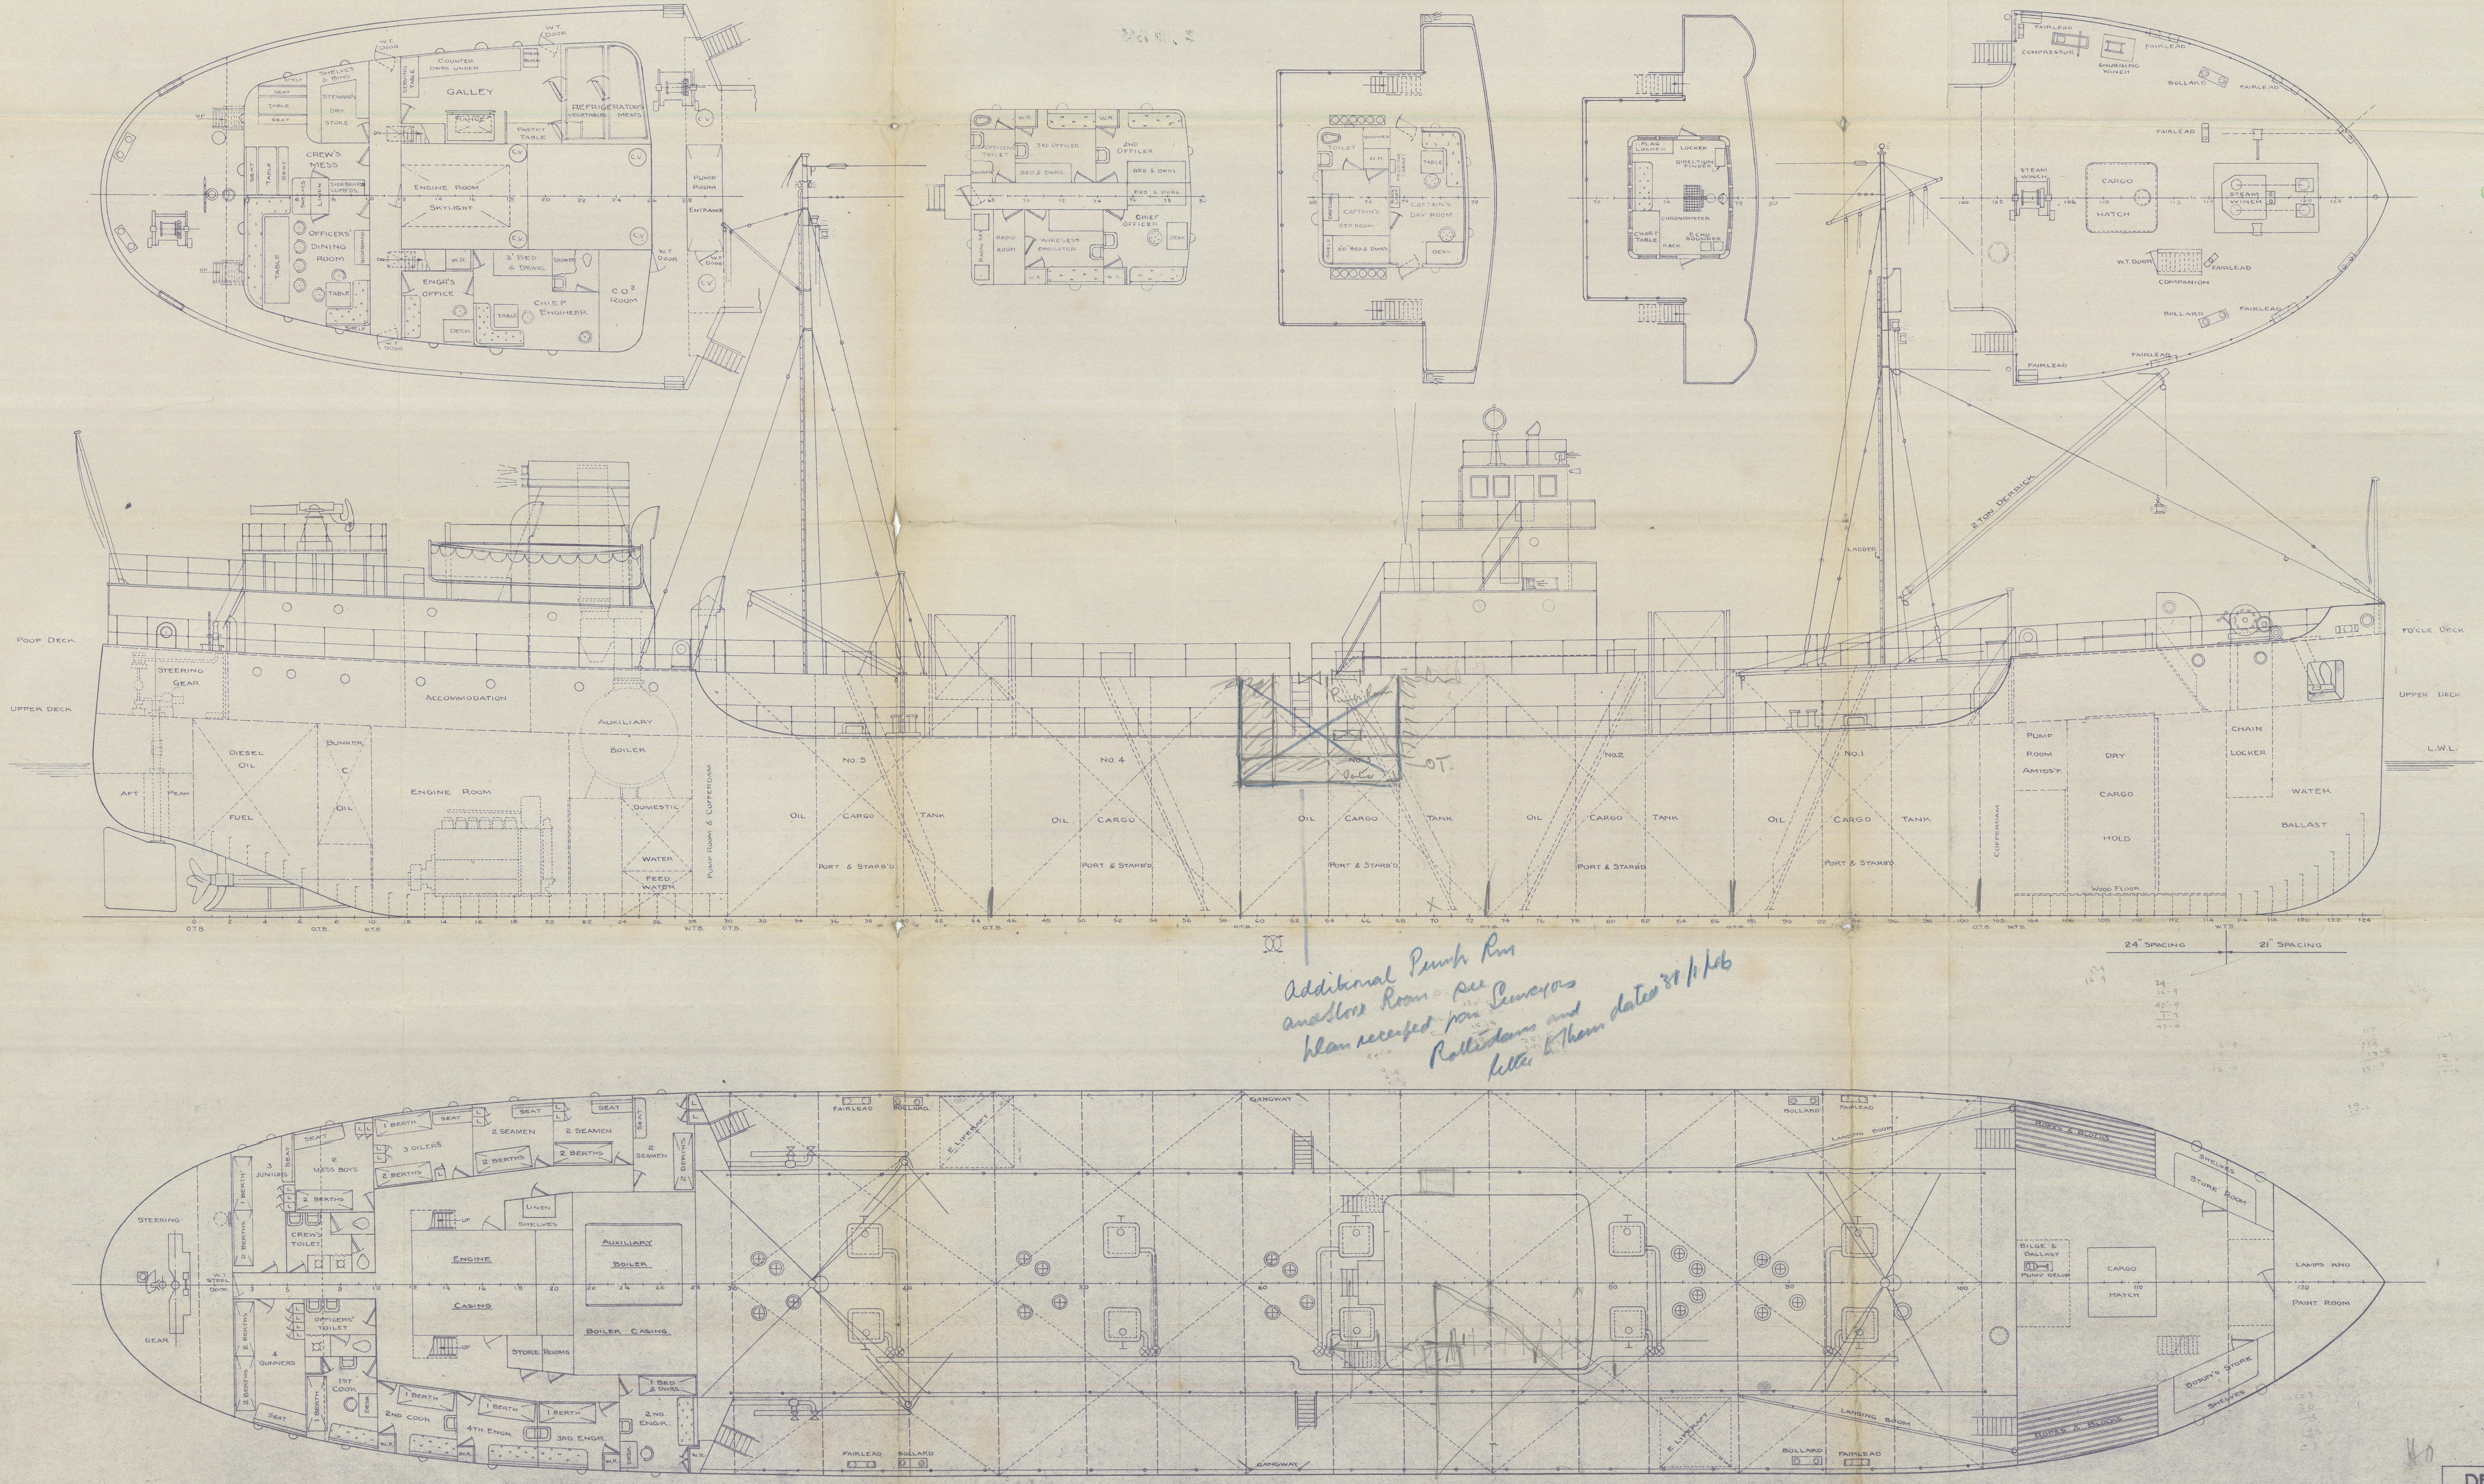

DESIGN NO. 529
GENERAL ARRANGEMENT
SCALE: 1/8" = 1' 0"
GERMAN & MILNE
NAVAL ARCHITECTS

009904-009911-0139

9A

20

General Arrangt

Collingwood Shipyards Ltd

Ocean Tankers N^o 122-4-5-6-7-8 14-6-13
T.C. 1.9-13.

COLLINGWOOD S.B.CO. MARINE INDUSTRIES LTD.

122 NIPAWAN PARK. X 141 OTTERBURN PARK.

124 NORWOOD PARK. 142 EGLINTON PARK.


125 SPRINGBANK PARK. 143 MILLICAN PARK.

D/s 731

Boat

3 JUN 1943




Ocean Tankers.

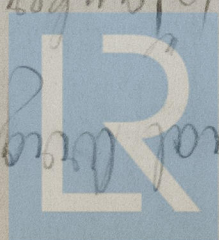

© 2021

Lloyd's Register
Foundation

009904-009911-0139

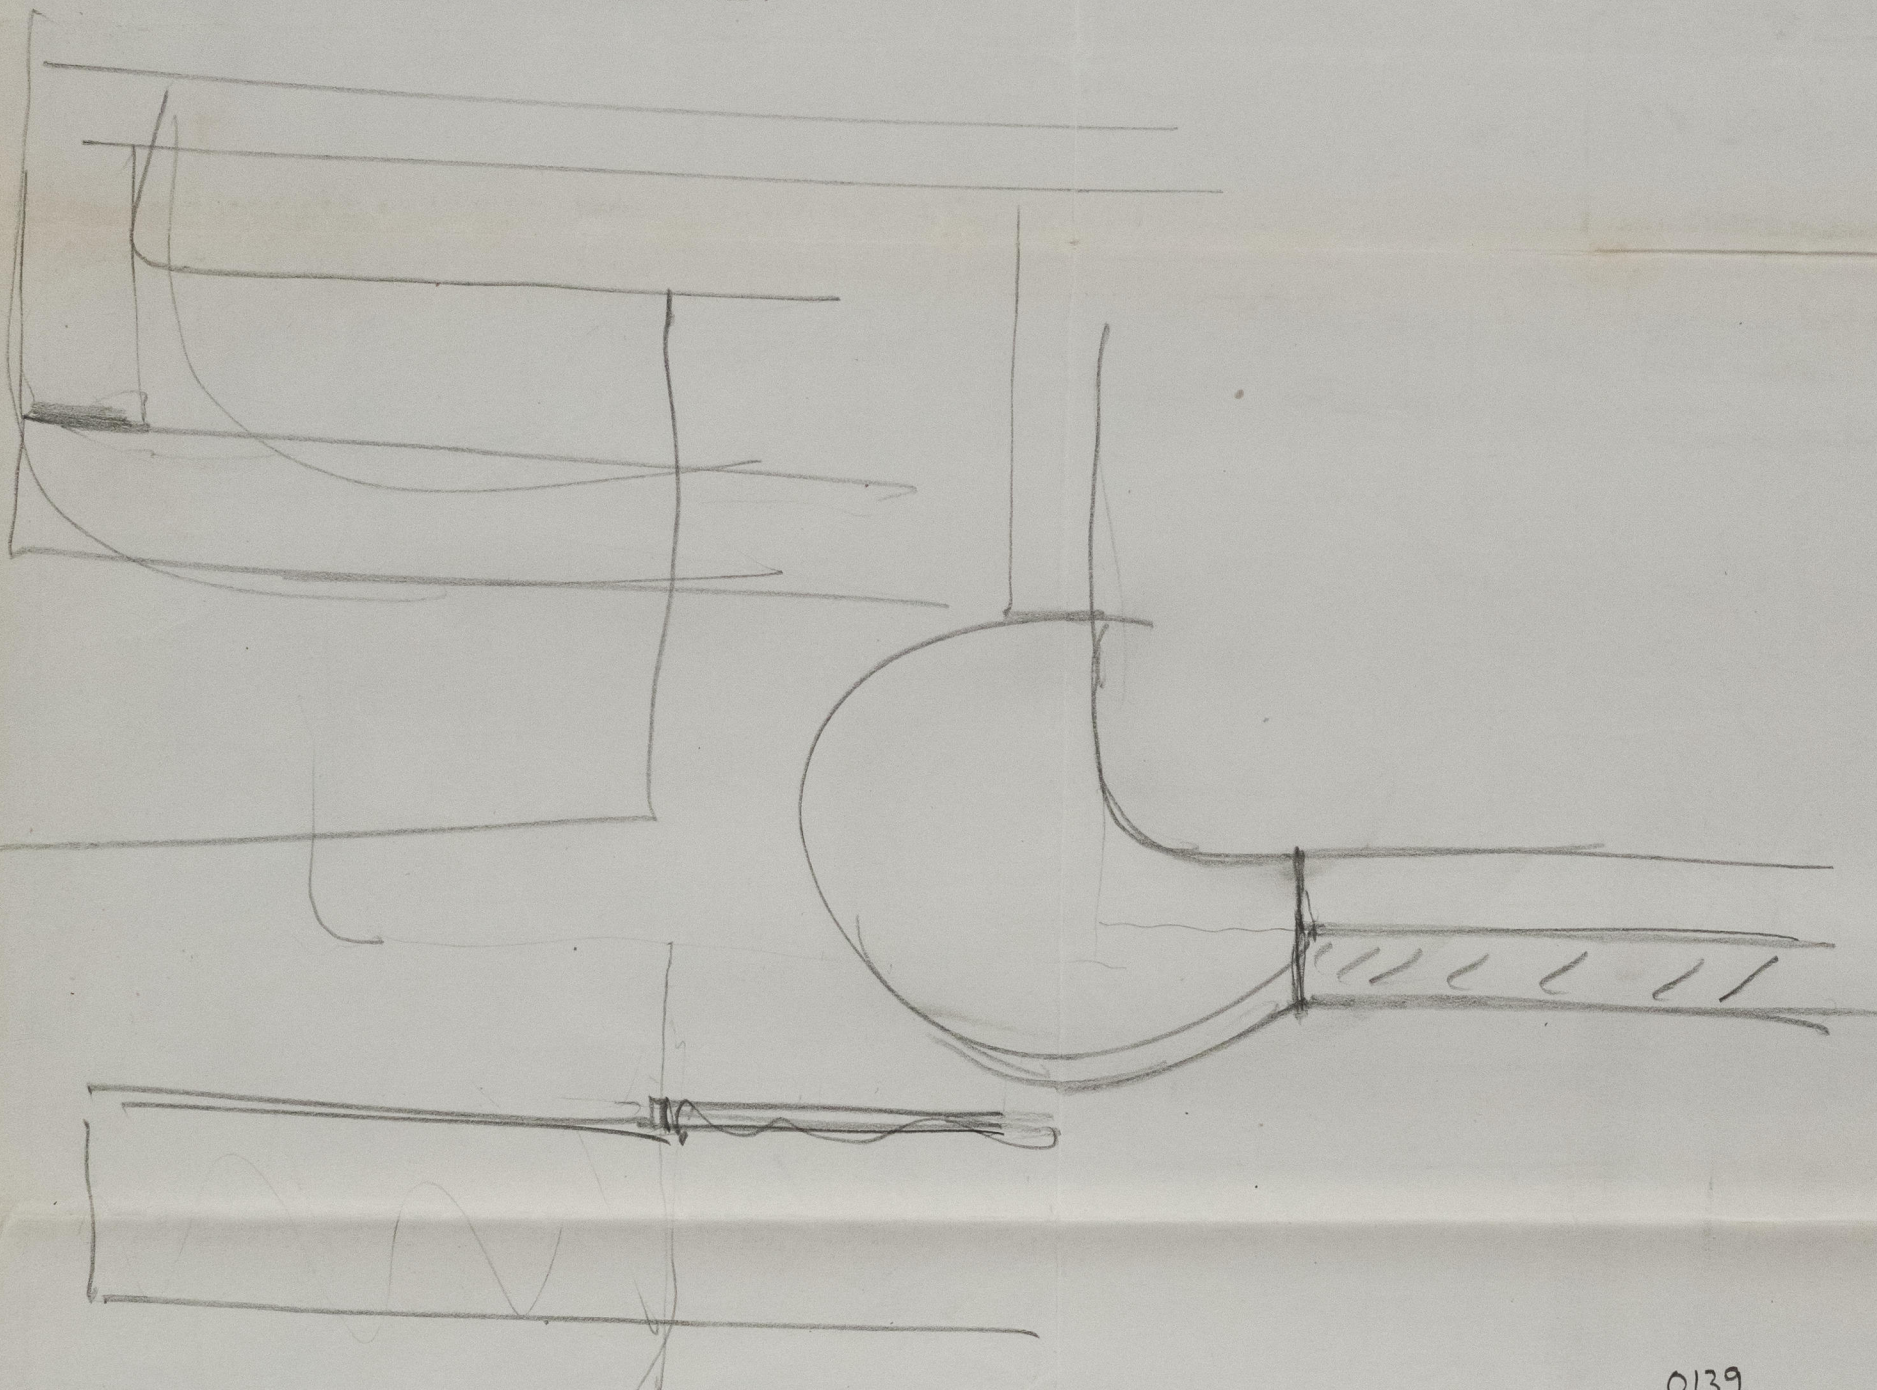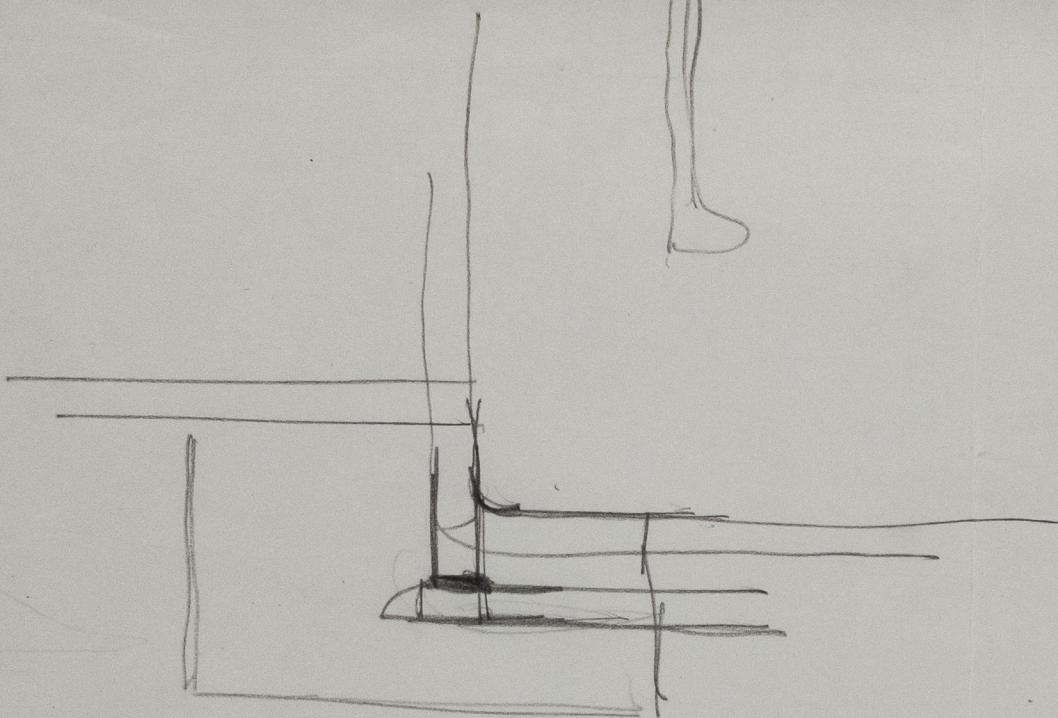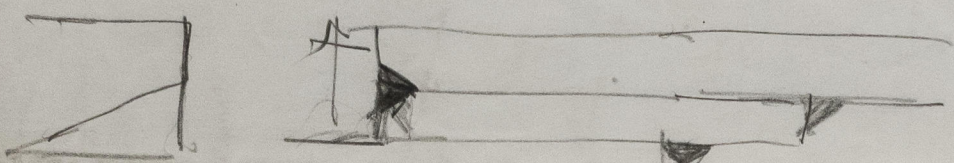

0139