

N^o 632.

PROFILE.


SCALE $\frac{1}{8}$ "=1 FOOT.

TO CLASS \pm 100 A.I. WITH FREEBOARD
CORRESPONDING TO MEAN MOULDED DRAFT OF 15'6"

DIMENSIONS:-


250' B.P. x 48' MLD. x 17' TO MAIN DK.

Noted.

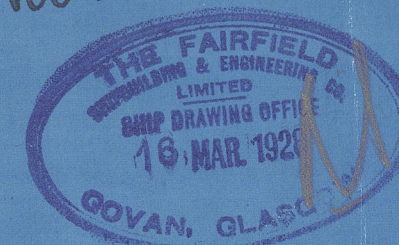

SHEER HEIGHTS ABOVE 17'0"

AT F.P.	5'3"
AT $\frac{1}{8}$ L. ABAFT F.P.	2'11"
MIDSHIP	—
AT $\frac{1}{8}$ L. FORD. A.P.	8'2"
AT A.P.	1'6"

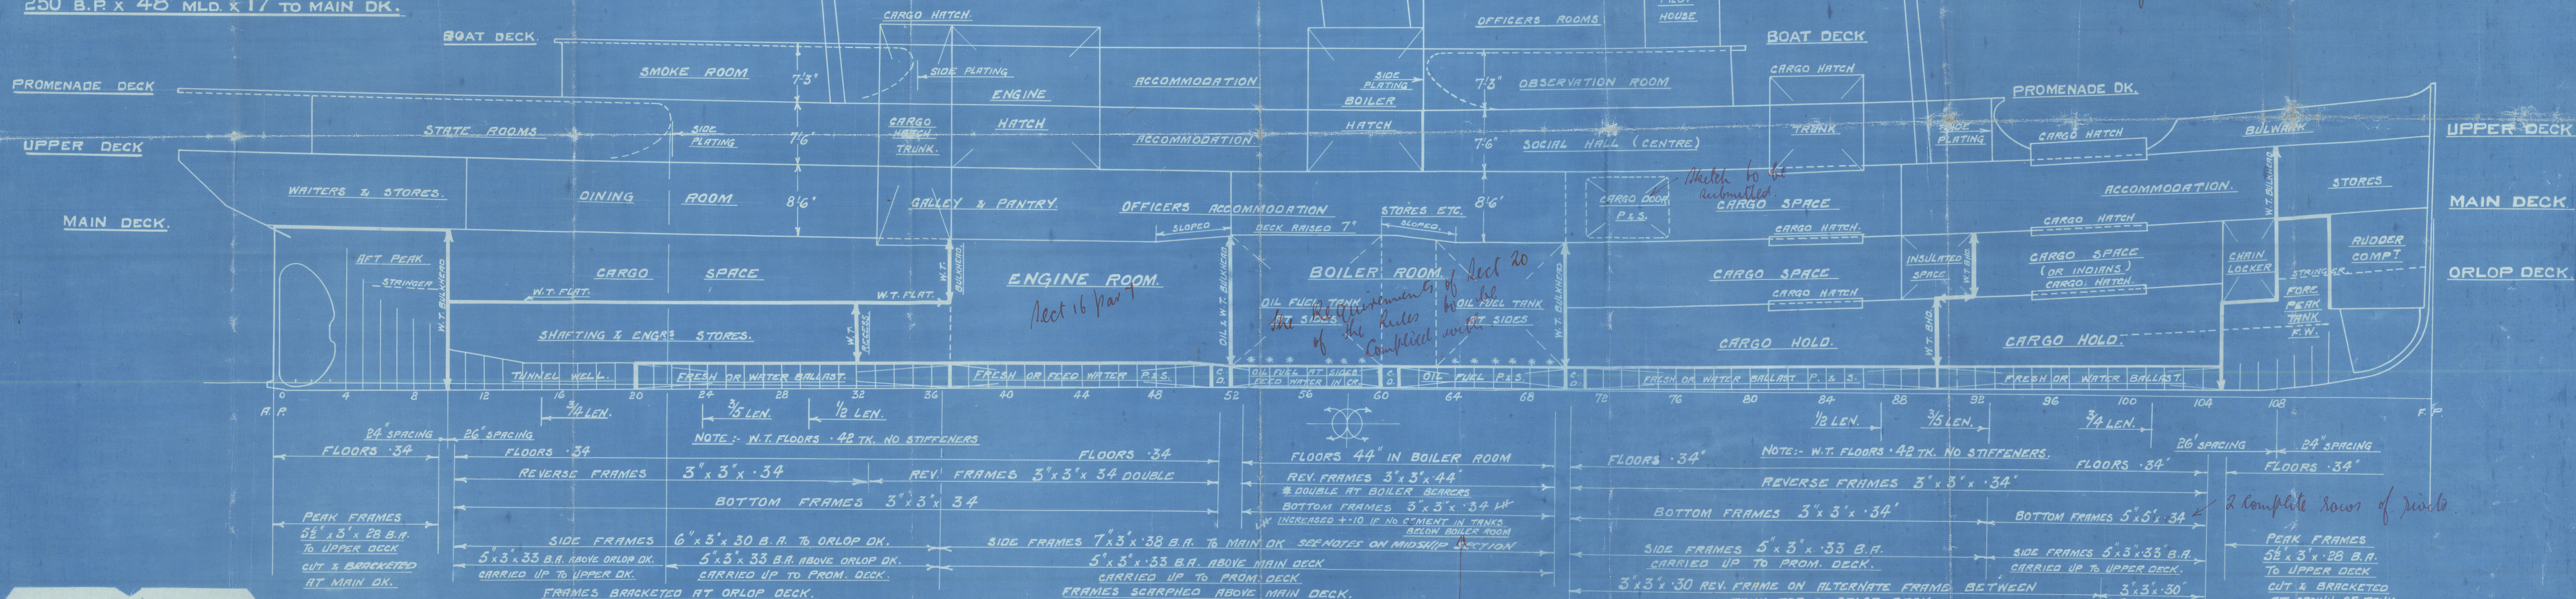

Plan of Painting argt. and strengthening
of hlm. fwd. to be submitted.



APPROVED
LLOYDS REGISTER OF SHIPPING

© 2021

Lloyd's Register
Foundation


Profile

N^o. 632.

The Fairfield S B & E Co. Ltd.

Princess Norah

GLASGOW REPORT No. 48624

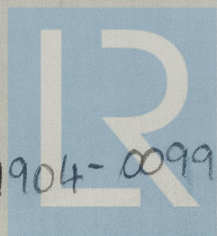

© 2021

009904-009911-0259
Lloyd's Register
Foundation