


Official Copy

SECTION C-D.

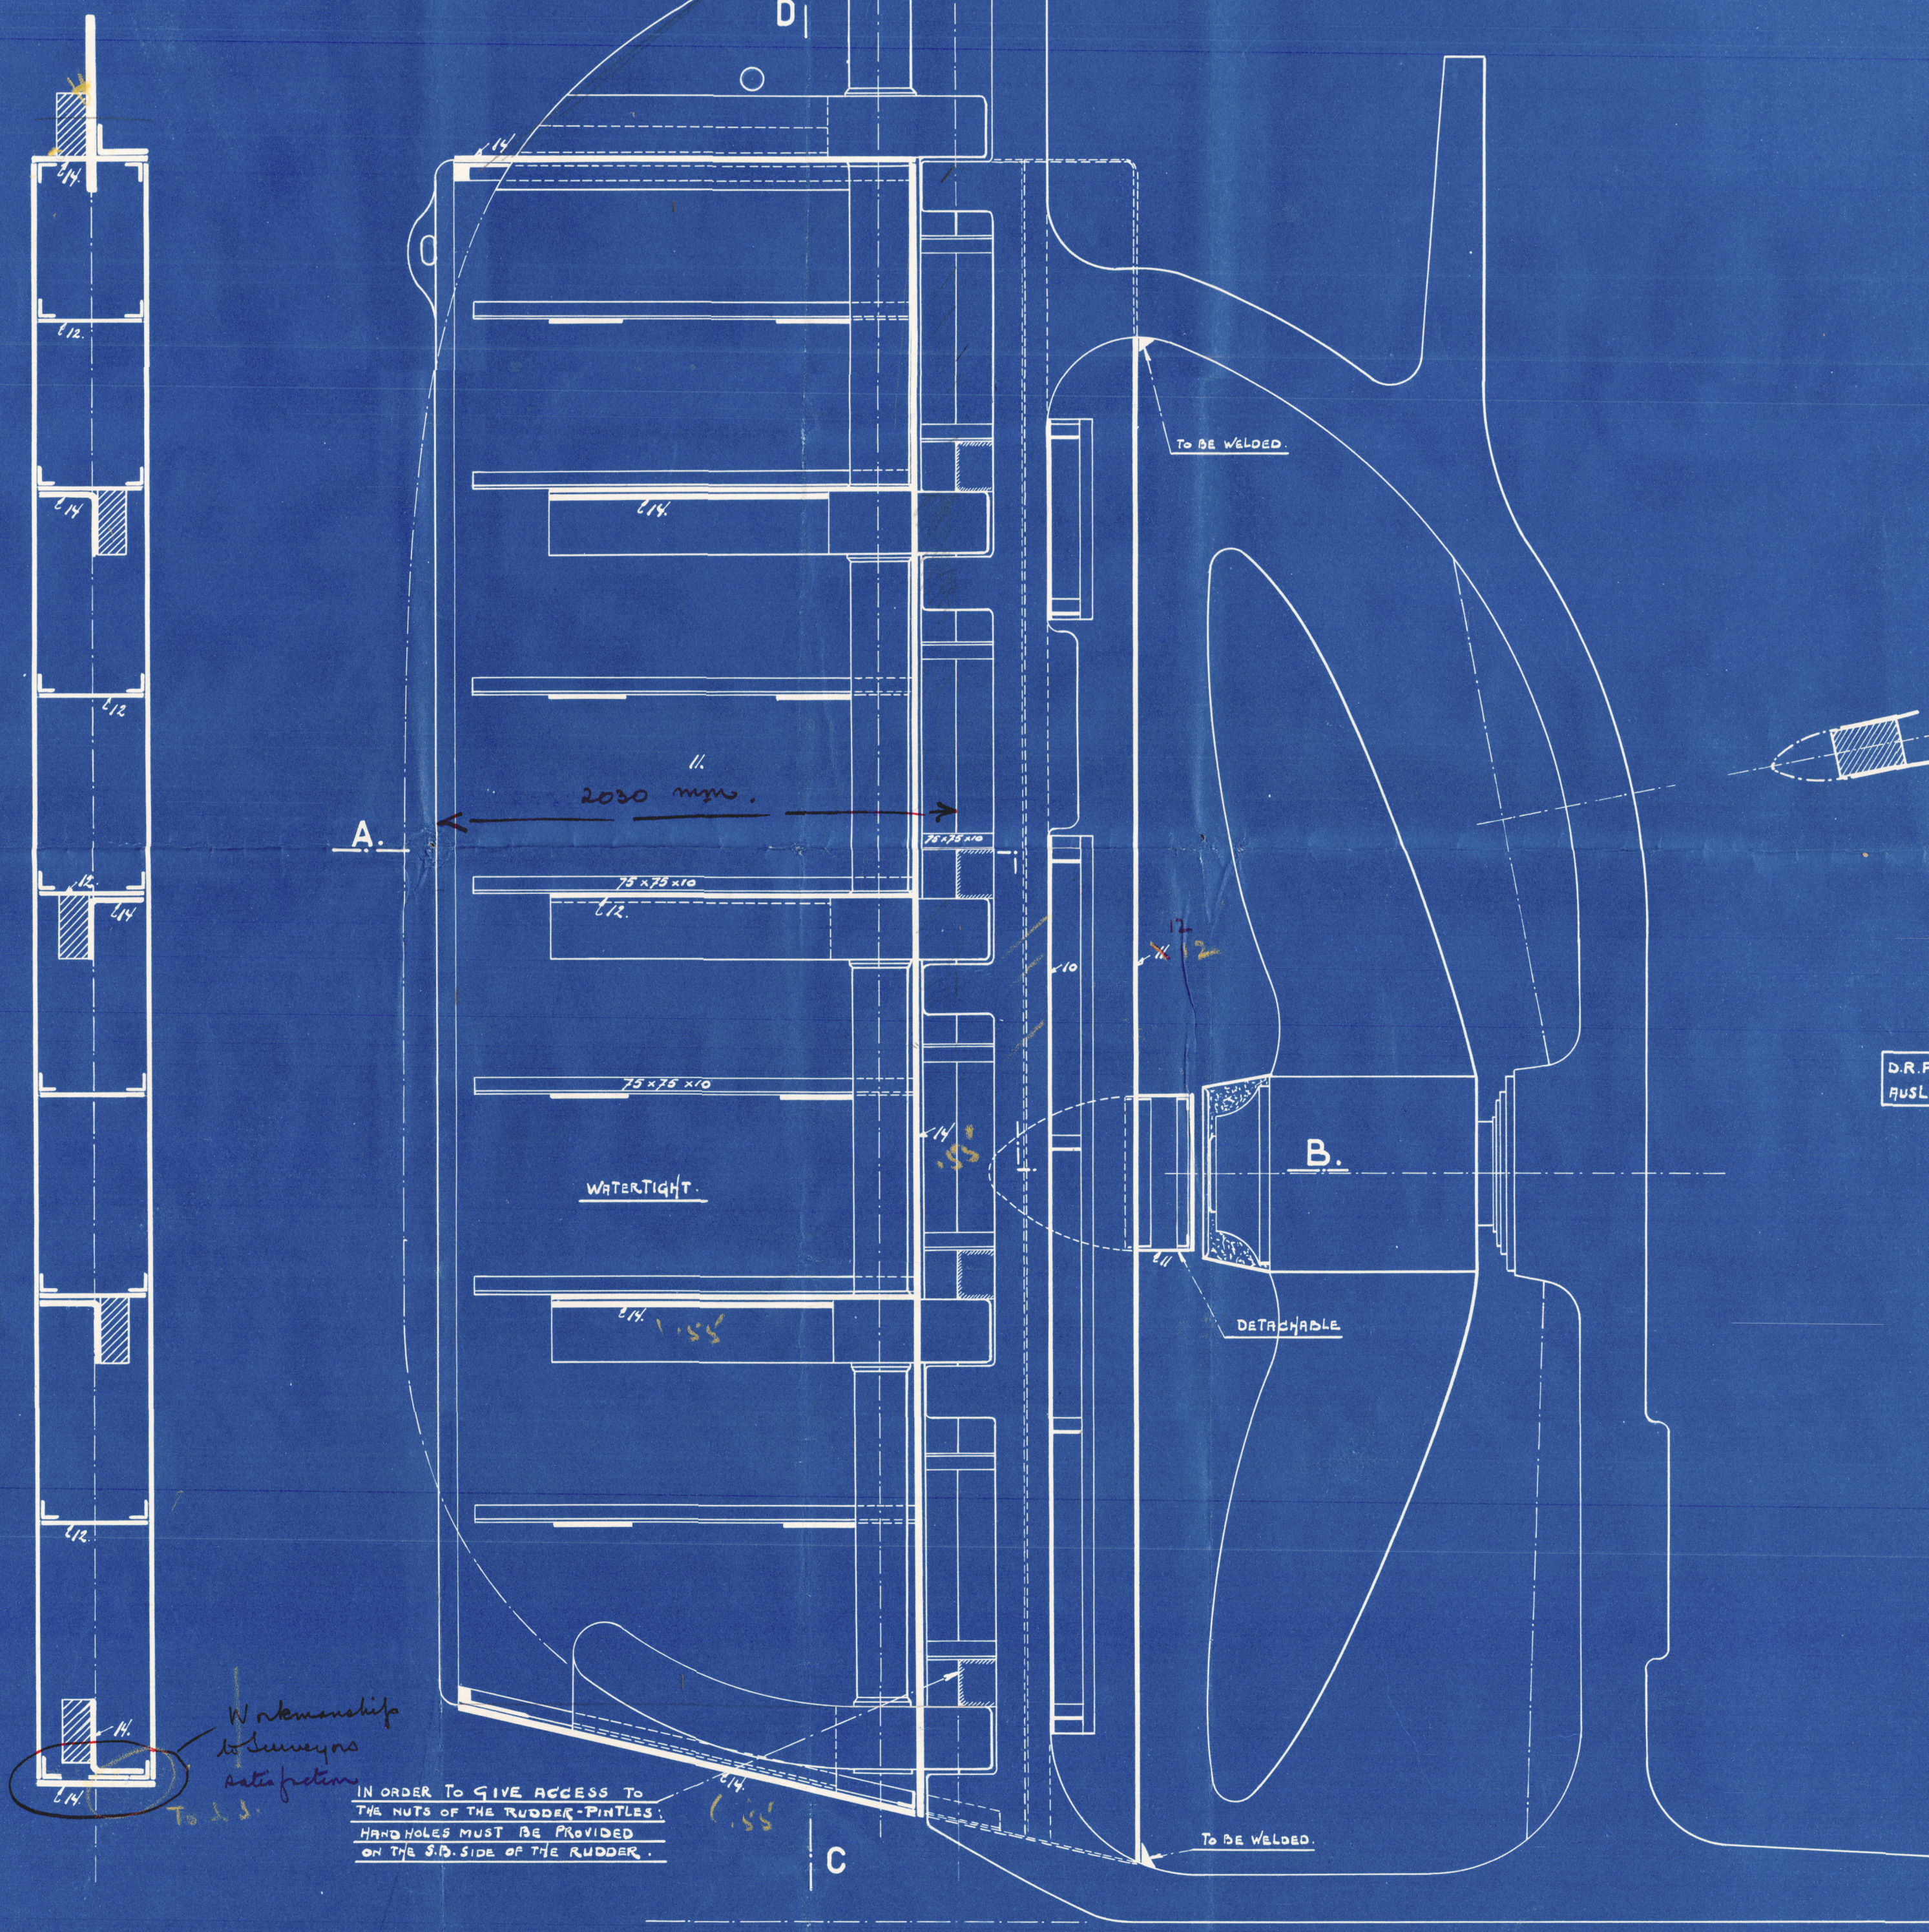


OERTZ - PATENT - RUDDER.


FOR *s/s "Carignano" gemito*
del S.S. "MONCALIERI".

SCALE 1:20 EN 1:10.

SECTION A-B.

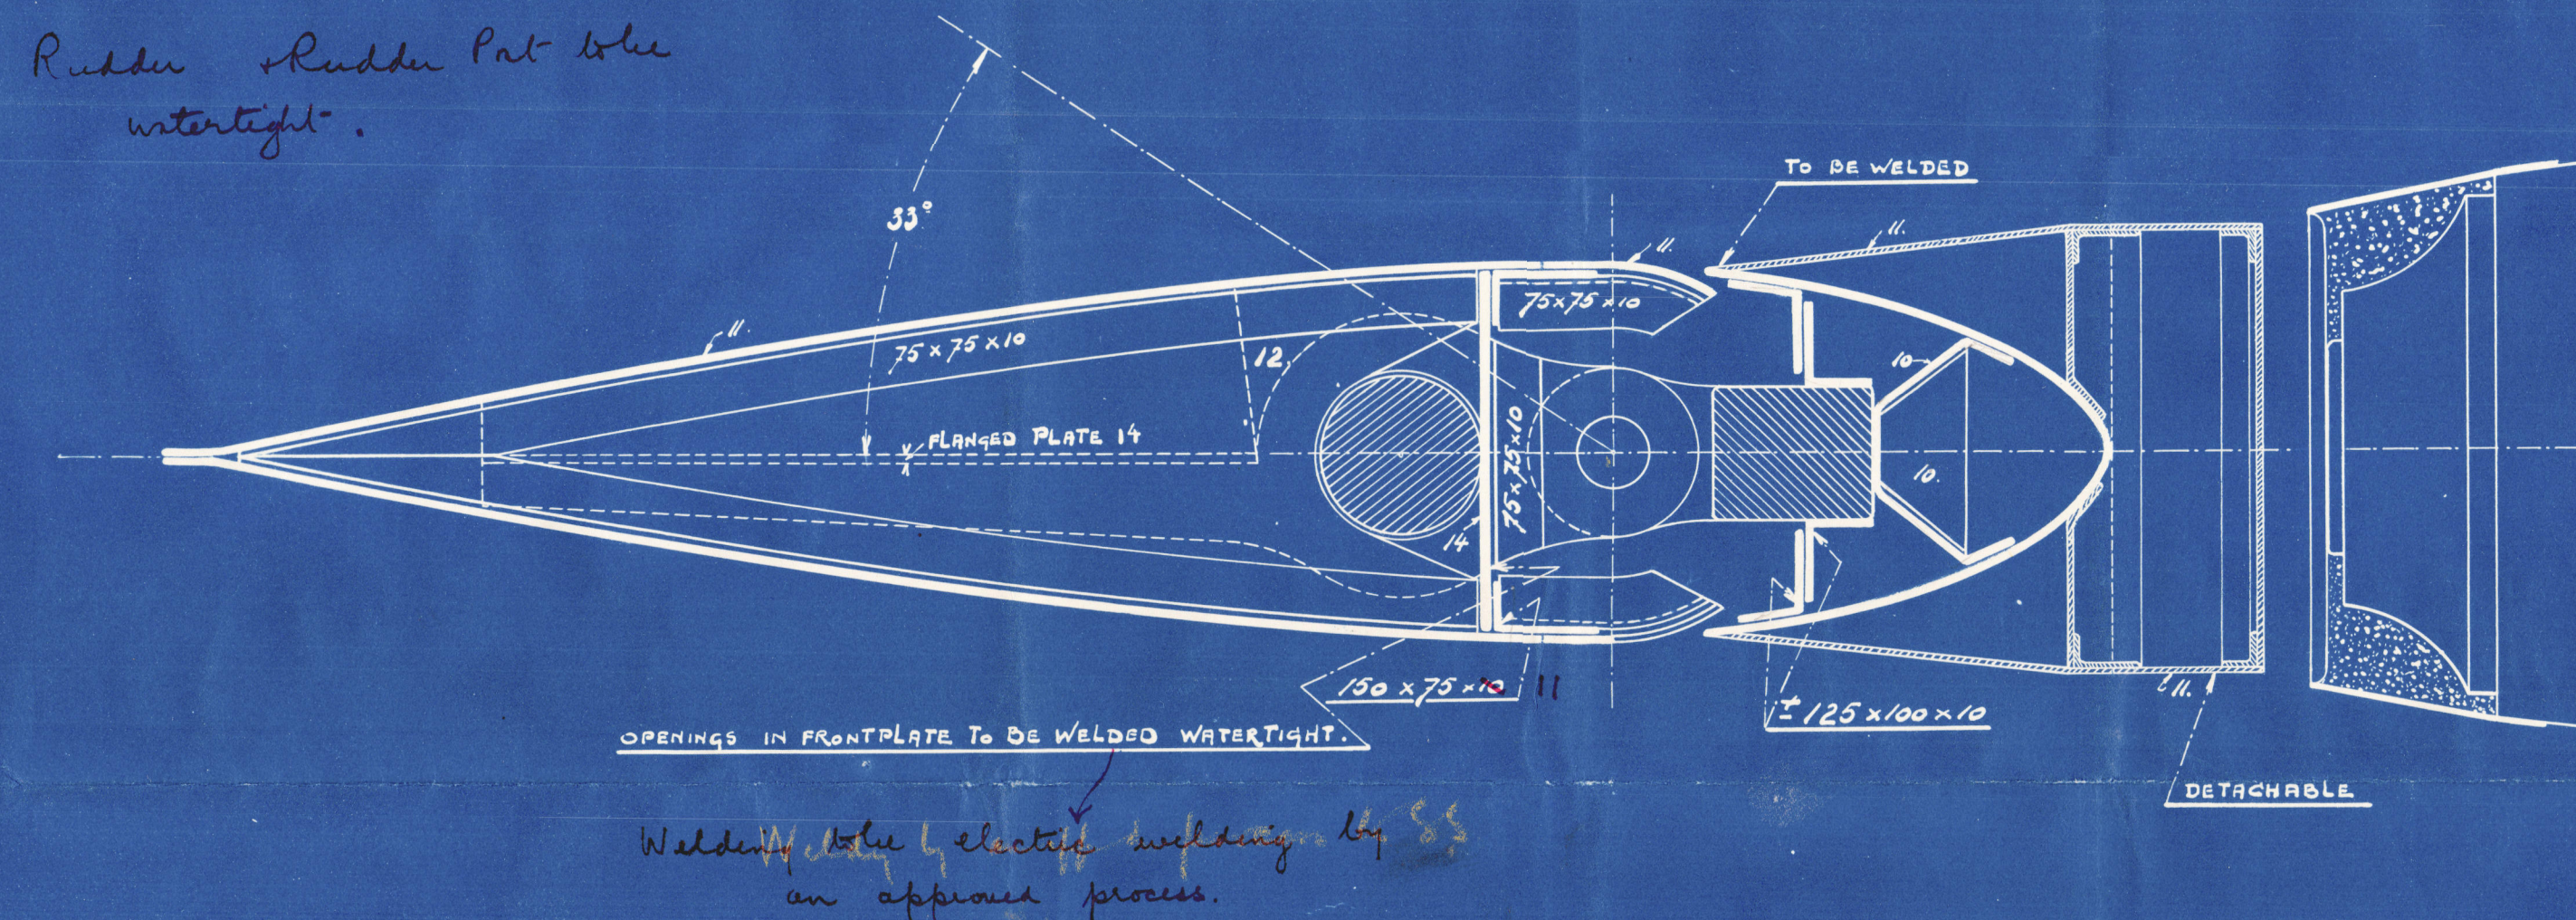

OUTLINE OF RUDDER.

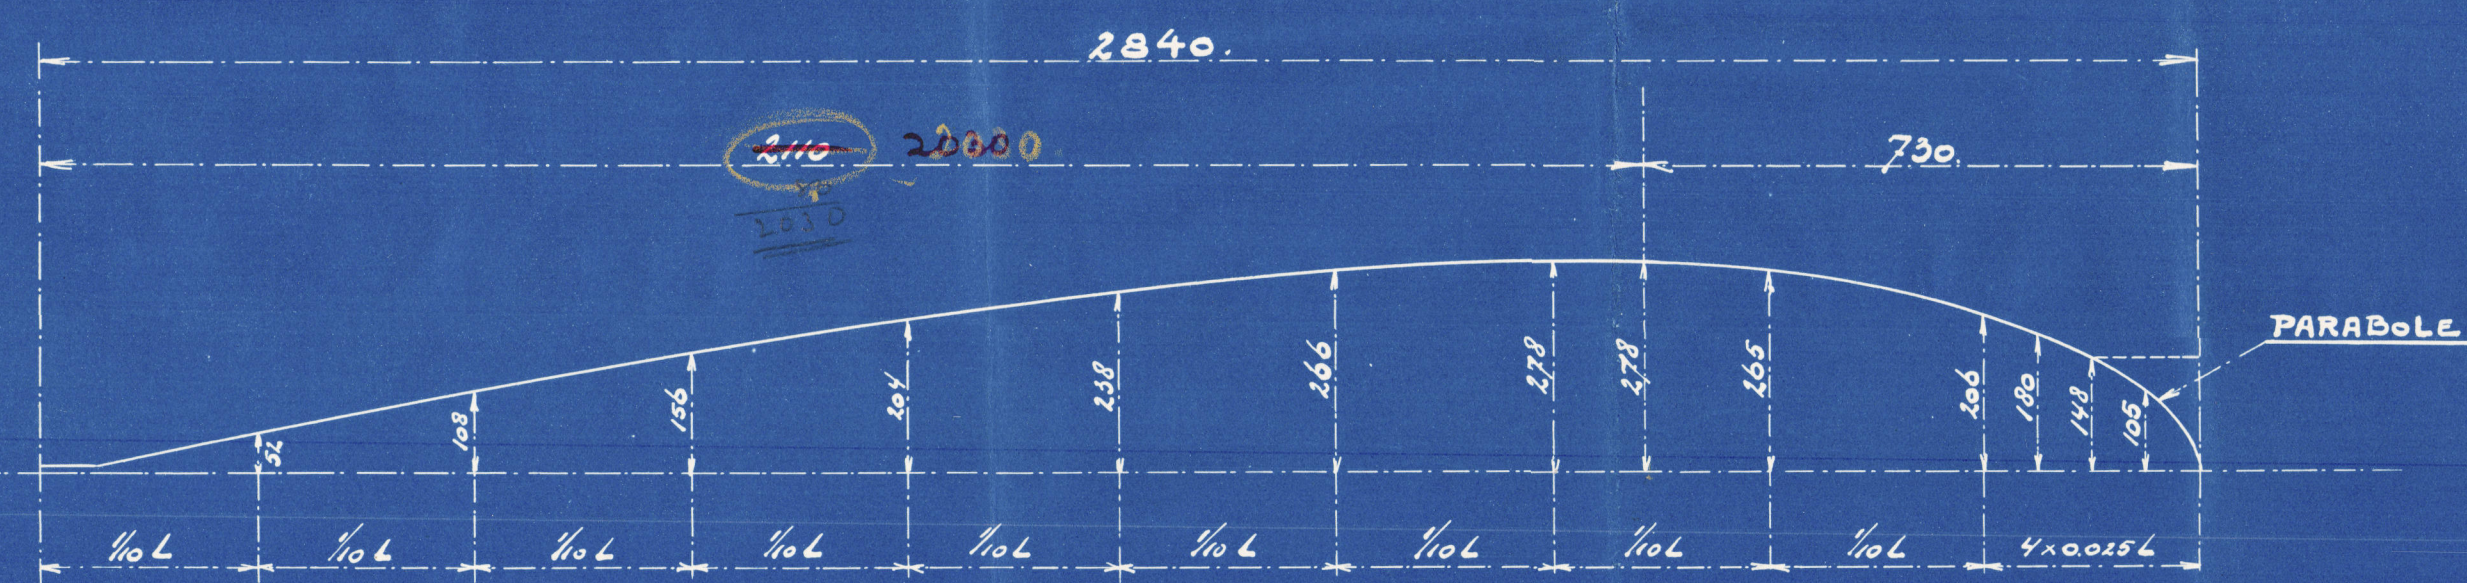

N.V. CARP EN HORTER'S HANDELMAATSCHAPPU.

AMSTERDAM - DEN HAAG.

MAART 1927.

W.J.
20.5.27

62.


KENNETH J. L. & C.
GENOVA (101)
Palazzo Nuova Borsa, 115
Tel. 52-882 - Casella Post. 1277

KENNETH JOLL & C.

GENOVA (101)

Palazzo Nuova Borsa, 115

Telef. 52-862 - Casella Post. 1277

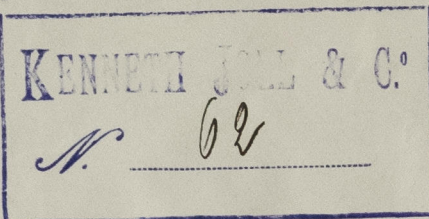

Timone "Derte"

per 1/2 "Carignano" (gemello del

1/2 "Moncalieri") della Spett.

Società "Lloyd Sabauda"

OERTZ RUDDER

S.S. "CARIGNANO"

Report No 10202



© 2021

Lloyd's Register
Foundation

009954-009961-0152