

Verification

THU. 20 JUN. 1918

10129

Lloyd's Register of British & Foreign Shipping.
SURVEYS FOR FREEBOARD.—STEAM SHIPS.

25909.

PARTICULARS RELATING TO ALL STEAM SHIPS EITHER FLUSH DECKED, OR WITH TOP GALLANT FORECASTLES, SHORT POOPS AND BRIDGE HOUSES DISCONNECTED, OR WITH TOP GALLANT FORECASTLES HAVING LONG POOPS, OR RAISED QUARTER DECKS CONNECTED WITH BRIDGE HOUSES, OR OTHERWISE.

Port of Survey Middlesbrough
Date of Survey White Building
Name of Surveyor D. H. Barker

Ship's Name War Pigeon
Number in Register Book No. 525

Port of Registry and Nationality London
Br.

Official Number 142617

Gross Tonnage.

Date of Build. 1918

Particulars of Classification.
+100 at
(contemplated)

Registered dimensions from Ship's Register.	LENGTH.	BREADTH.	DEPTH.	UNDER DECK TONNAGE.
	400.0	52.45	28.40	4824.36
Length on LOADLINE.	399.5	Frame Depth 10 Rule " 6	Ceiling 1.20 Sheer 1.19	Peak in Tanks above
		284.66 284.66 284.66 284.66 284.66	Level Tanks No open air 284.66	

Moulded Depth as measured.....

31'-0"

NOTE.—If the depth is measured when vessel is afloat, the details of measurement should be reported.

Allotments for keel
for draught.

2 1/2

Co-efficient of fineness.....	• 78- 777
Any modification necessary [Para. 4 (a) to (e)]*	- .02 all 10 ft m
Co-efficient as corrected	• 76-
Sheer { Stem..... 120 } 186 ÷ 2 = 90 Mean 36 42.77 at Sternpost ... 60 1.19	
Sheer at $\frac{1}{2}$ of the length from { Stem 68 } 102 ÷ 2 = 51 Mean 36 42.77 Sternpost 34 1.19	
Gradual mean Sheer 91.36 - .86 = 92.72	
Standard mean Sheer [Table, Para. 18] 49.95 Correction	
Difference 41.41 ÷ 4 = 10.35 § If limited as Para. 18 (f) - 10.44	

CORRECTION FOR LENGTH.

Length of Ship on Loadline..... 399.5'

Length in Table 372.0'

Difference 27.5'

Correction for 10ft., Table A. 1.6 Table C. 8

× Difference divided by 10 4.4 (if required.) 2.2

If $\frac{1}{10}$ ths length covered divide by 2 + 14 1/2 + 2 1/4

CORRECTION FOR IRON DECK.

Proportion covered, if less than $\frac{7}{10}$ ths length covered 5064

Thickness of usual wood deck, less stringer 32 - 1 3/4

CORRECTION FOR ROUND OF BEAM.

Breadth at Gunwale amidships 52-0"

Round of Beam 1-1

Normal round 1-1

Difference 2 ÷ 2 = 2

Proportion of Deck uncovered (Para. 19) 2

NOTE.—The round of beam should be reported on the full breadth of vessel at the gunwale.

Freeboard, Table A	7-11"
Correction for Sheer	- 10 1/4
Correction for Length	7-0 3/4
Allowance for Deck Erections	+ 4 1/2
Correction for Round of Beam	7-5 1/4
Correction for Fall in Sheer (if any)	- 9 1/2
Correction for Iron Deck (if required)	6-6-

Corrections for Round of Beam

Corrections for Fall in Sheer (if any)

Corrections for Iron Deck (if required)

Additions for non-compliance with provisions of
Para. 11 (d) and (e) { }

Other Corrections (if any)

Winter Freeboard	6-6-
Summer Freeboard	6-0 1/2
Indian Summer Freeboard	5-7 1/2
N.A. Winter Freeboard	5-7 1/2

Corrections necessary because clearside amidships, measured in accordance with the Statute is not taken at the intersection of the wood or iron deck with side. + 1 1/4

Winter Freeboard from deck line	6-7 3/4
Summer " " "	6-3 1/4
Indian Summer " " "	5-8 3/4
N.A. Winter " " "	6-2

State dimensions of freeing port area on back of this form.
The Surveyor should state whether the fall in sheer as reported is measured relatively to the straight line of keel or to the water line. If measured relatively to water line the vessel's draft at time of survey, and also the usual load draft forward and aft should be reported.

© If the frames, skin planking, or ceiling are of unusual thickness the breadth of vessel to inside of ceiling should be reported if possible.

† In vessels obtaining an allowance for deck erections under Para. 11 where the sheer drops abaft amidships the height of the R.Q.D. is to be taken from the level of the top of the amidship beam.

§ In flush-decked vessels the total standard mean sheer means the sheer measured at the stem and stern-post. In vessels having poops and forecastles, it means the sheer measured at points distant one eighth of the vessel's length from stem and stern-post.

2m,14. T.

009954-009961-0193

© 2021

MARKING REPORT
RECEIVED 3.9.18

(P.T.O.)

Do all the Frames extend to the top height in the Poop? Yes Raised Quarter Deck? ✓ Bridge House? Yes Forecastle? Yes
 To what height do the Reverse Frames extend? Bulk angle framing.
 Has the Poop or Raised Quarter Deck an efficient Iron Bulkhead at the fore end? Yes
 Give particulars of the means for closing the openings in Bulkhead Iron doors.
 Is the Poop or Raised Quarter Deck connected with the Bridge House? No Has the Bridge House an efficient Bulkhead at the fore end? Yes
 Give particulars of the means for closing the openings in Bulkhead no openings
 What is the thickness of the Bridge Front plating? .4" and Coaming plate? .44"
 Give scantlings and spacing of the Stiffeners 9' 3 $\frac{1}{2}$ " x 56 B. & C 30" spacing ✓
 Are bracket plates fitted at each end of the Stiffeners? Yes Are hor'l. brackets fitted connecting Bridge Bulk'd. with Bulwarks? Yes
 Has the Bridge House an efficient Iron Bulkhead at the after end? Yes
 How are the openings closed? Storm boards, half height, in permanent channels
 Is the Forecastle at least as high as the main or top-gallant rail? Yes Has the Forecastle an efficient Iron or Wood Bulk'd. at after end? Yes
 Are the Engine and Boiler openings covered by a Bridge, Poop, Raised Quarter Deck, or enclosed by a Strong Iron or Steel Deckhouse? Yes
 If the openings are not so protected are the exposed parts of the Casings efficiently constructed?
 Give thickness of plating; scantlings and spacing of Stiffeners
 What is the height of the exposed Casings? Are suitable means provided for closing all openings in them in bad weather? Yes

Position and Size.	W. 1. 32' 6" x 26'	W. 2. 14. 34' 8" x 26'	W. 3. 10-10" x 18'	W. 5. 30' 4" x 26'						
Item.	Ship.	Rule.	Ship.	Rule.	Ship.	Rule.	Ship.	Rule.	Ship.	Rule.
COAMING Height above top of DECK	30"		30"		30"		30"			
Thickness Sides.....	.44		.44		.44		.44			
Thickness Ends.....	.44		.44		.44		.44			
SHIFTING BEAMS OR WEB PLATES.	Number..... Section and Scantlings..... Material.....	Six 26/20 x .37	Six 27/21 x .38	Six 18/13 x .34	Six 28/19 x .37					
* FORE AND AFTERS.	Number..... Section and Scantlings..... Material.....	nil	nil	nil	nil					
HATCHES Thickness	2 $\frac{1}{2}$ "	2 $\frac{1}{2}$ "	2 $\frac{1}{2}$ "	2 $\frac{1}{2}$ "	2 $\frac{1}{2}$ "					
Remarks.....										

* When the Fore and Afters are of wood the depth should be stated from the underside of the hatches.

(If the sill of the lowest side scuttle will be less than 6 inches above the Indian Summer Load Line if assigned under the tables, state vertical distance from top of deck at side amidships to lower edge of lowest side scuttle.)

The following information is to be given in all Cases of vessels dealt with under Paras. 11, 12 (under 15 feet Moulded depth) and under Shelter Deck Rules.

What is the thickness of the Bridge Sheerstrake? Strake between Main and Bridge Sheerstrakes?

Delete the words {The Crew are, are not, berthed in the bridge house.
that do not apply {The arrangements to enable them to get backwards and forwards from their quarters are, are not satisfactory.


Length of Bulwarks in well

Area of Freeing Ports required by Para. 11 (e) each side of vessel = Sq. ft.

Ft. Tenths. Ft. Tenths. No. Freeing Ports (each side of vessel) = Sq. ft.

x x
x x

Total deficiency or excess = ✓ Sq. ft.

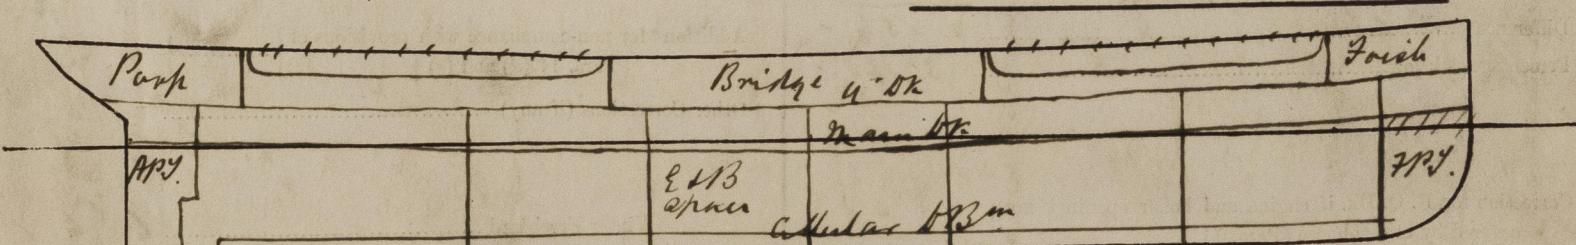

Show hereon line of Floors or Tank Top with position of any Breaks in same; also height of Peak Tank tops, &c., &c.

State any special features in the construction of the Vessel. Ship screw steamer, astern 103m bulk angle framing. Iron stbd decks. Displacement & Tons per inch as per scale herewith.

Standard "B" tonal. Tonnage as for no open ceiling. Sails need to be s.s. Maristrich Mott report
Builder: Messrs Ropner How 2d
Owners

Address Blackton on Tys

Fee £ 7 : 7 : 0

Received by me



Lloyd's Register
Foundation