

PROFILE & DECKS PLAN.

S.S. No 515-516



Rule 515 - 404.75 x 53.25 MLD. x 25.0 MLD TO UPPER D.

TO CUBS 30 A.I.



SCALE 1/8" = 1'-0"

SEE SEPARATE PLAN, TO BE SUBMITTED, FOR HATCHWAYS, PILLARS & GIRDERS.

MASTS, WINCHES & WINDLASS SUPPORTED TO SURVEYORS SATISFACTION.

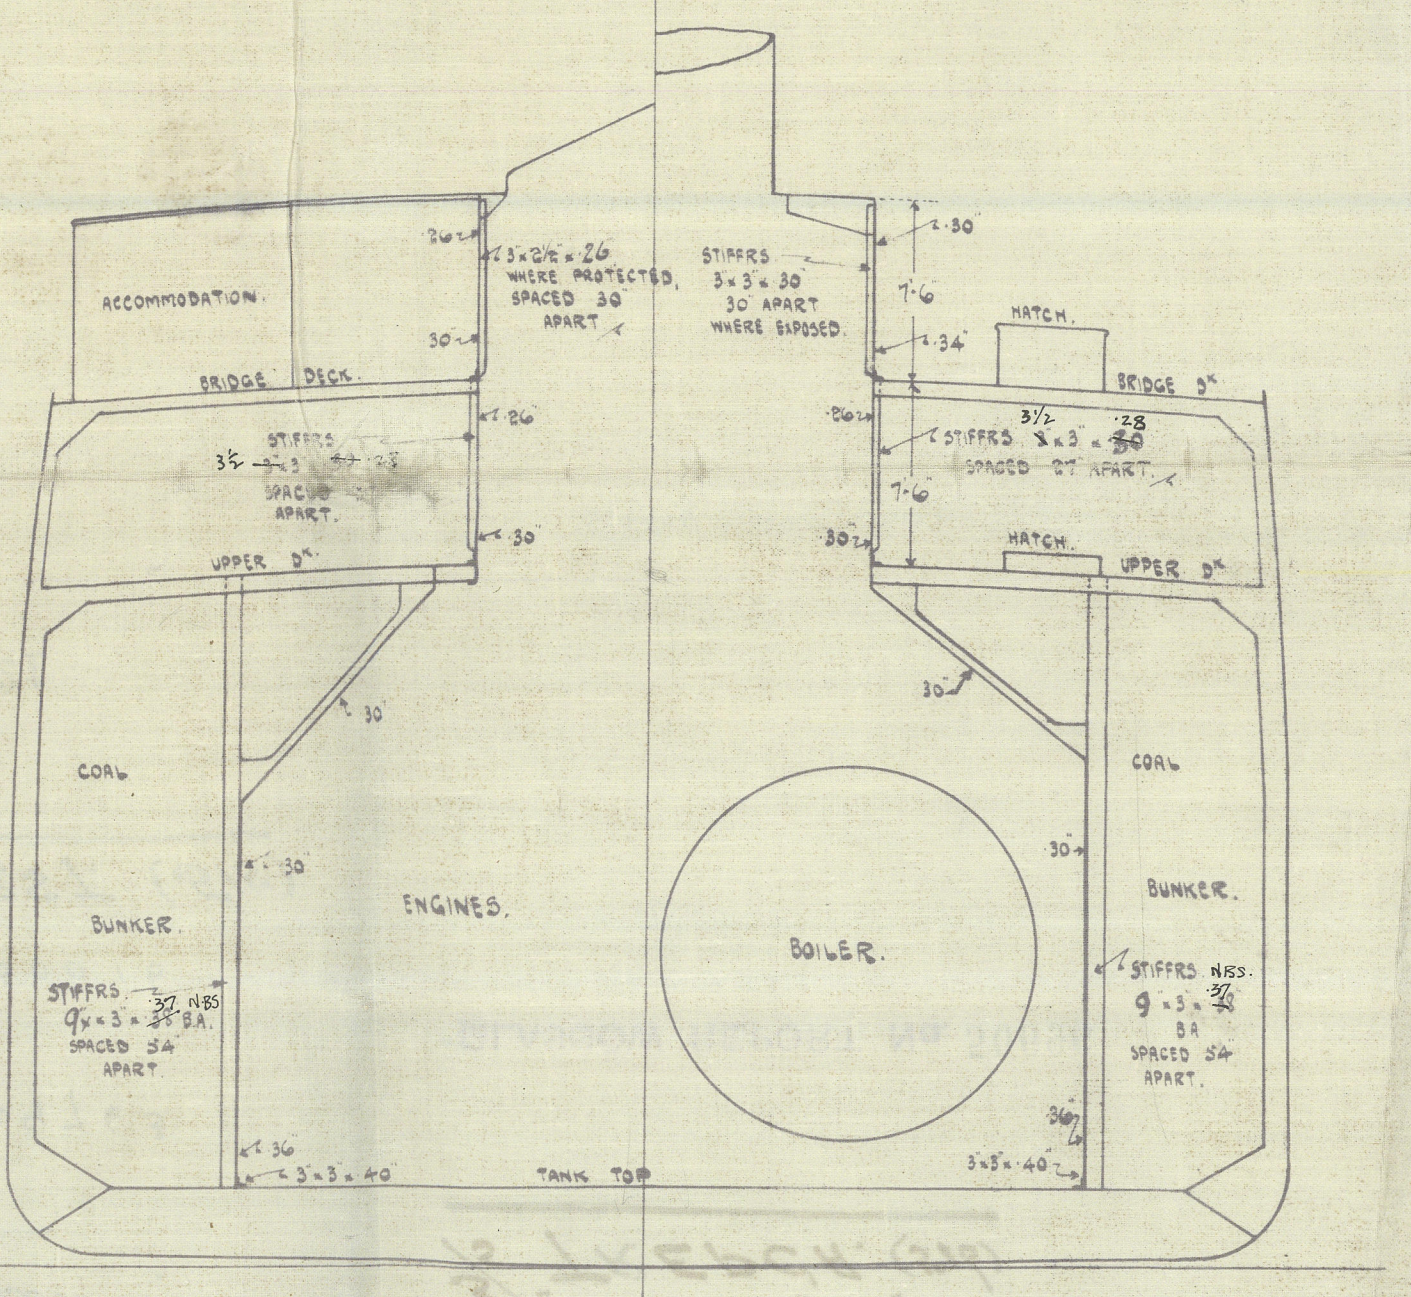 

SECTION THROUGH ENGINE SPACE.
SECTION THROUGH BOILER SPACE.
NOTE: BUNKER BULKHEADS DO NOT ACT AS RAILS OF PILLARS.

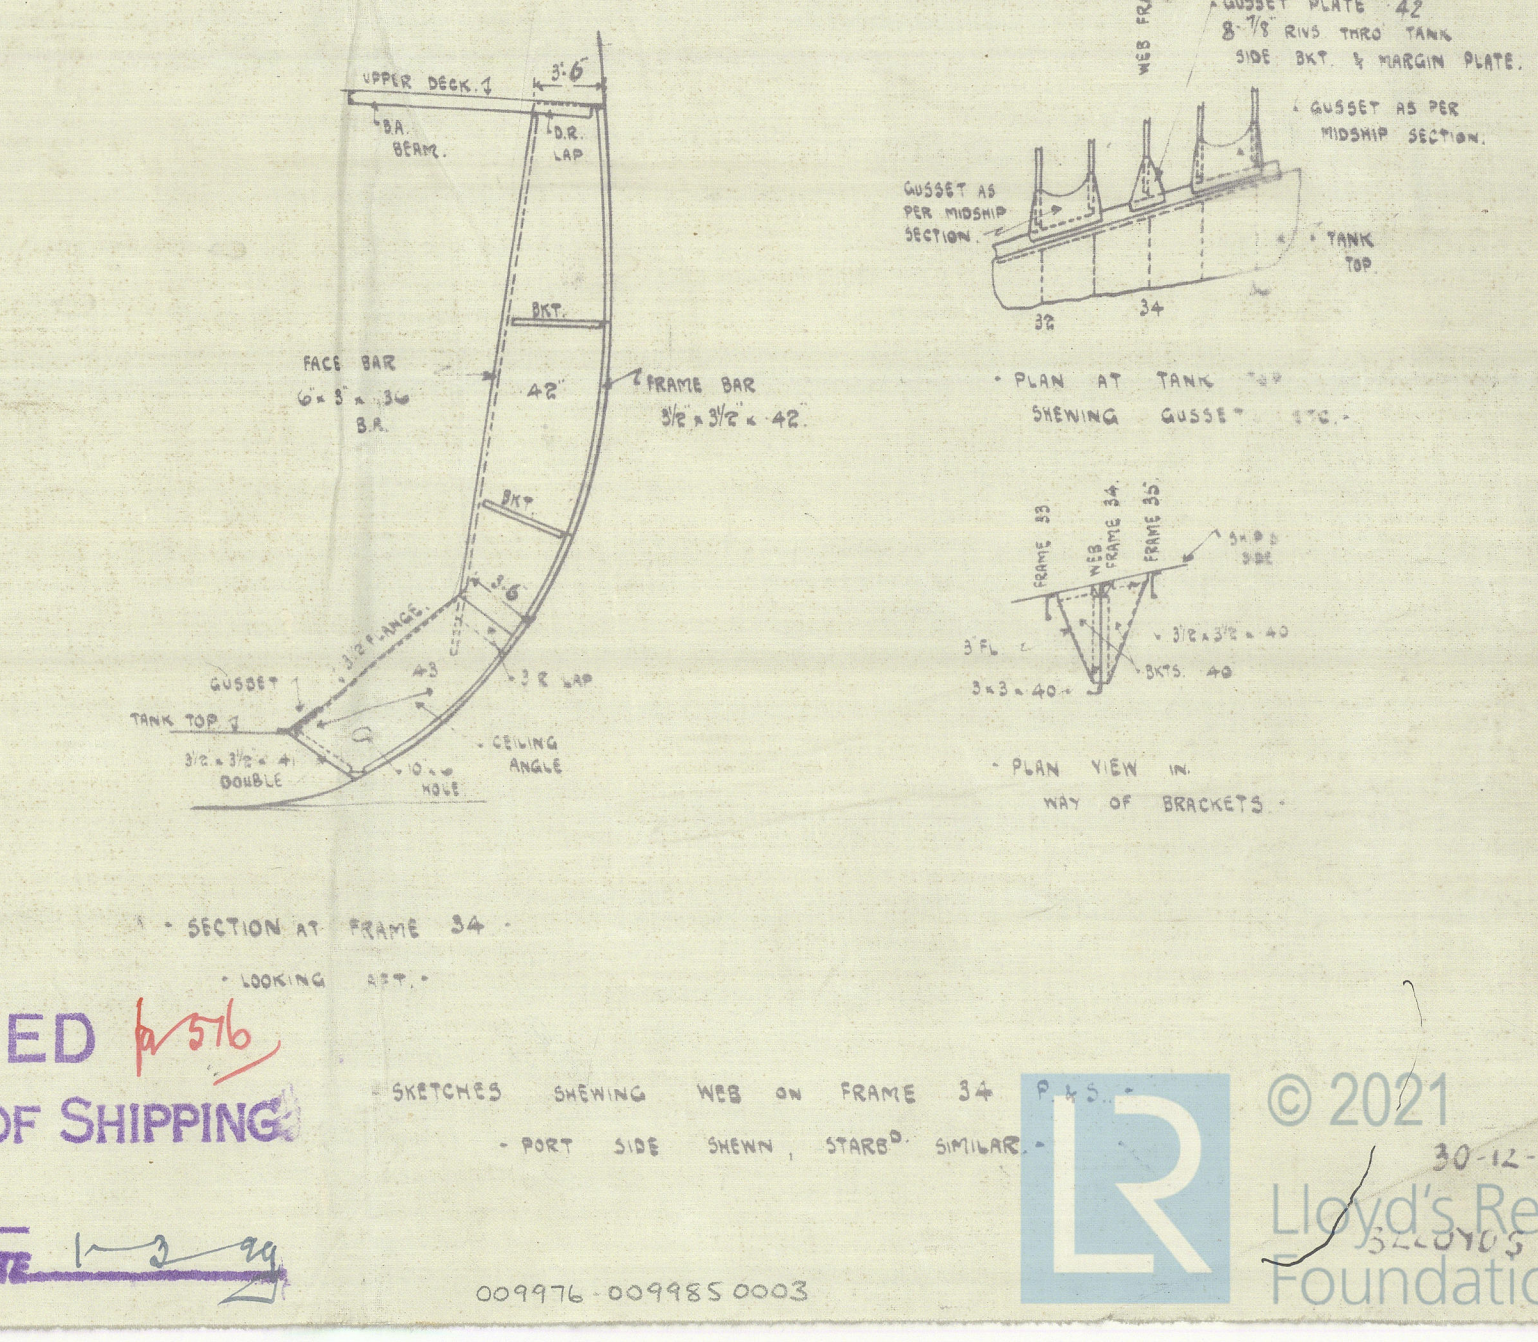 

APPROVED
LLOYD'S REGISTER OF SHIPPING
DATE 27.10.18

APPROVED
LLOYD'S REGISTER OF SHIPPING
DATE 1.2.19

Ayrshire Dockyard
Co. Ltd.

Zyphenberg * No. 575 - 576.
Dis. J.R. 2
2/ Profile & decks.

GLASGOW REPORT No. 49763

516 Filed

GLASGOW REPORT No. 50016

5/5 CHARTERHURST. (515)

GLASGOW REPORT No. 50221

5/5 "TREPČA" (516)

GLASGOW REPORT No. 50696



© 2021

Lloyd's Register
Foundation

009976-009985-0003