

Lloyd's Register of Shipping.

1° 28921

Ship's Name *S. S. "Z YPENBERG"*

Official No.

Memorandum of alterations reported since ship was surveyed for assignment of Load Lines
in


Accommodation in forecastle space removed, all sidescuttles removed and openings closed by riveted plates. -


Tonnage door fitted in end bulkhead forecastle 1530 x 1230 sill 470 $\frac{1}{2}$ closed by portable plate fastener with hookbolts

Poop space arranged for the accommodation of the crew, side scuttles fitted each side with permanently attached deadlights, tonnage doors in poop fore removed and openings closed by riveted plates.

A new deckhouse containing enhance crew space, 2 WC & and washplaces fitted on poop deck 3300 $\frac{1}{2}$ long; 3000 $\frac{1}{2}$ broad and 2250 $\frac{1}{2}$ in height; entrance to crew space on afterside opening 1650 x 700 sill 300 $\frac{1}{2}$ closed with 1 $\frac{1}{4}$ " teak door operated from both sides.

One sanitary discharge from WC is on poop deck fitted each side above freeboard deck. 2 $\frac{1}{2}$ " pitch pine sheathing fitted on poop deck in way of accommodation Tunnel escape fitted against poop deck with steel hinged watertight door

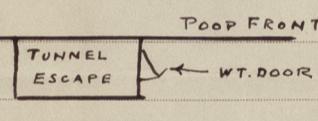 on starboard side opening 1530 x 530, sill 500 capable of being operated from both sides. -

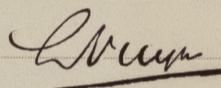

Fee f 25.-

