

GENERAL NOTES -	
Dimensions	
LENGTH	300'-0"
BREADTH	44'-0"
DEPTH MOULDED	22'-3"
TO CLASS # A-1 AT LLOYDS -	
LLOYDS NUMERALS	
B	44-0
D	22-25
B+D	66-25
L	300
L(B+D)	198-75
EQUIPMENT NO.	
HULL	2806
PROP	2806
BRIDGE	2806
FORECASTLE	2806
HAUSES	2806
EQUIPMENT	
2 POWER ANCHORS - STOCKLESS EACH	- 4000
1 STEERIN "	EX STOCK - 11
1 HEDGE "	- 54
210 FATHOMS	1 1/2" STOD CHAIN CHABLE - 42
100 "	4 1/2" STEEL WIRE TOW LINE - 42
2-OF 90 "	4 1/2" STEEL WIRE TOW LINE - 42
2-OF 90 "	4 1/2" STEEL WIRE TOW LINE - 42

THE PUSEY & JONES COMPANY
WILMINGTON, DELAWARE, U. S. A.

TITLE "CHARGE STEAMERS"

SUB-TITLE "MIDSHIP SECTION"

UNCLASSIFIED

NO. 1337-(101-1005) SUB-DIVISION 100

SCALE 1/2" = 1' FOOT

DRAWN 16

CHECKED U. K.


APPROVED 1337

DATE 24041A

Midship Section
S.S. "LYNCHBURG"

No 1004

built by.
The Rusey & Jones Co.
Wilmington
Del.

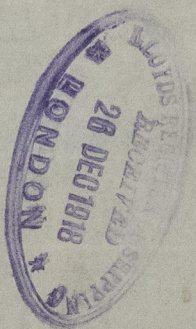

DR. No 24041-A

ORDER 1337

TITLE

MIDSHIP
SECTION

10



© 2021

Lloyd's Register
Foundation

009976-009985-0056