


BUILDING NR. 178. LONGITUDINAL SECTION AND PLAN.

SCALE. 1:50.

 

DIMENSIONS	
LENGTH BETWEEN PP.	170'0" = 51.815 M.
BREADTH MLD.	29'6" = 8.992 M.
DEPTH.	14'6" = 4.42 M.

CLASS.	
100. A. I.	CARRYING PETROLEUM IN BULK.
STRENGTHENED FOR NAVIGATION IN ICE.	


Detail of butt welding in way of hull angle beams and channel stiffeners to be submitted for consideration.

M/ 178
LONGITUDINAL SECTION
& PLAN.

RECORDS DEPT
LONDON

2

"DIVINA" ★

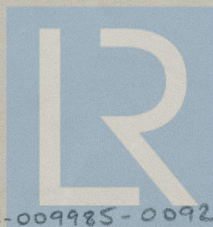

© 2021

Lloyd's Register
Foundation

009976-009985-0092