
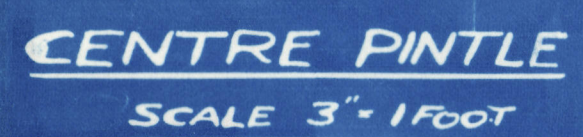
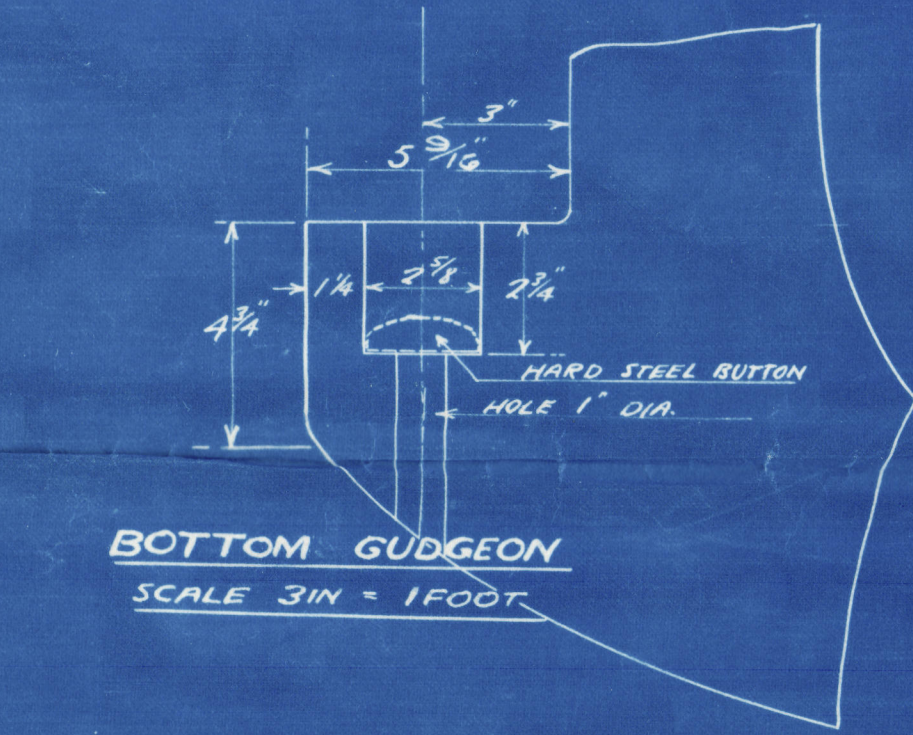


$$A \times D = 26.2 \times 1.95 = 51.1 = 3\frac{3}{4} \text{ DIA.}$$


DRAWING N^o 7
7/8


$$L \times D = 1345$$


BOTTOM GUDGEON
SCALE 3IN = 1FOOT

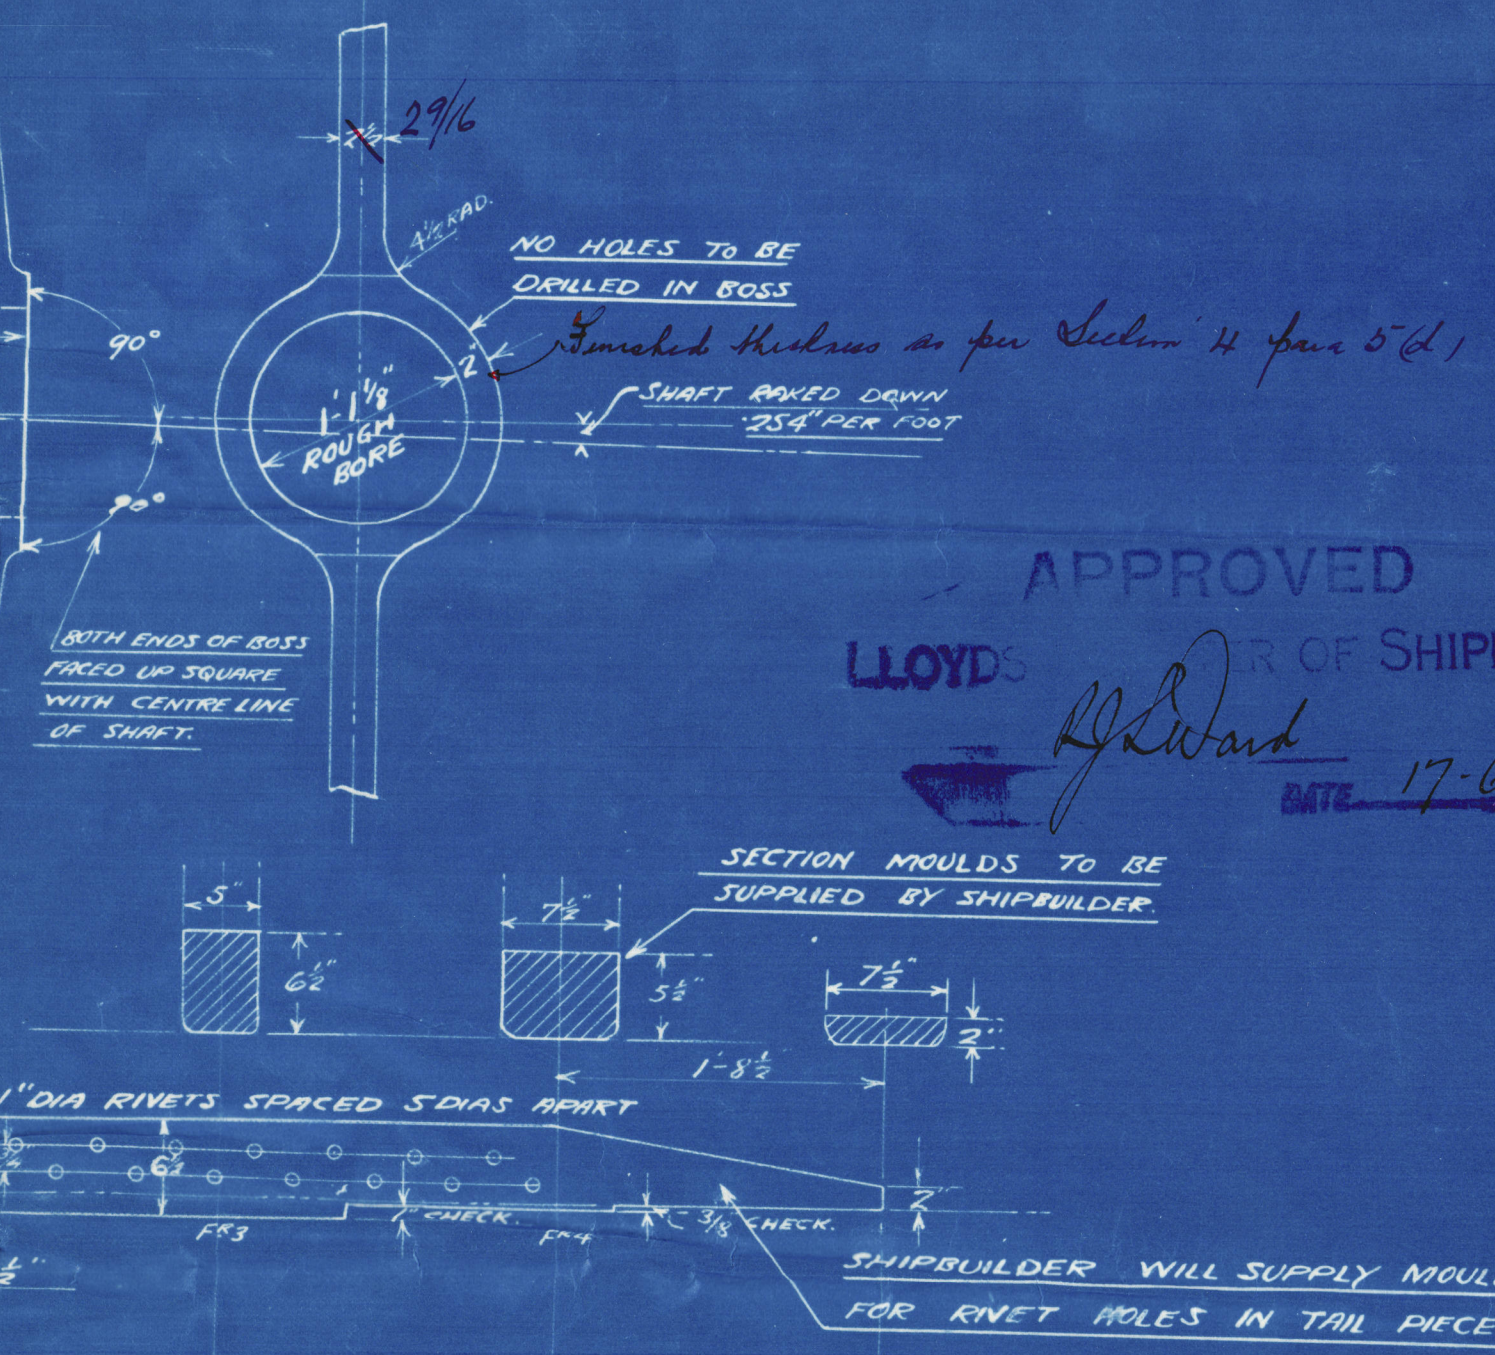

APPROVED

LLOYDS REGISTER OF SHIPPING

DATE 17-6-30

SECTION MOULDS TO BE
SUPPLIED BY SHIPBUILDER.

SHIPBUILDER WILL SUPPLY MOULD
FOR RIVET HOLES IN TAIL PIECE

DRAWING N^o $\frac{6}{718}$

Nº. 718.

Hall Russell & Co. Ltd.

Stein & Rudder Frames.

S.S. "EARL SIGURD."

Ann. Report. 16451.

F. 372

27.10.30

00 9986-009993-0046

© 2021

Lloyd's Register
Foundation