




Anguille centrali Scala 1:50

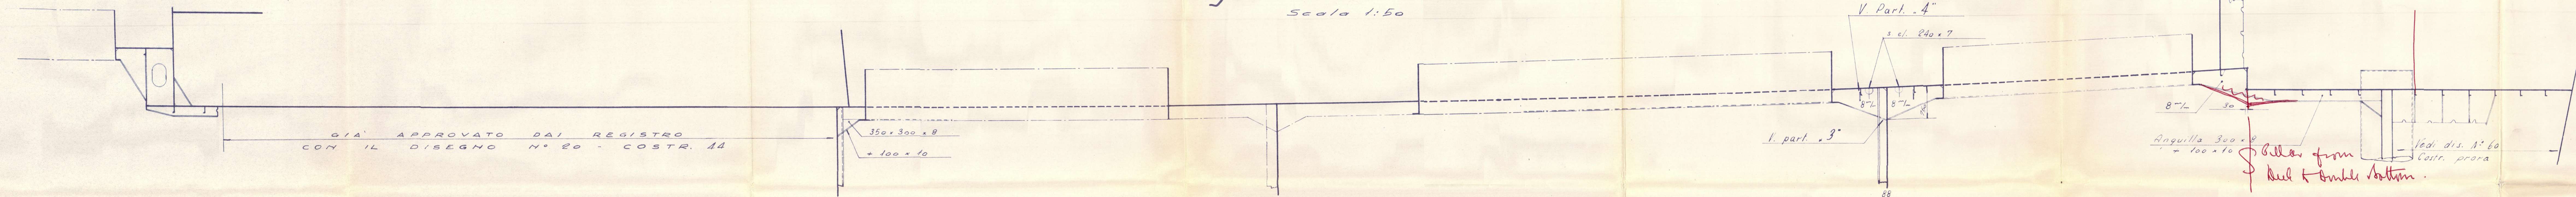


Anguille laterali a 2250 dalla M.N. Scala 1:50

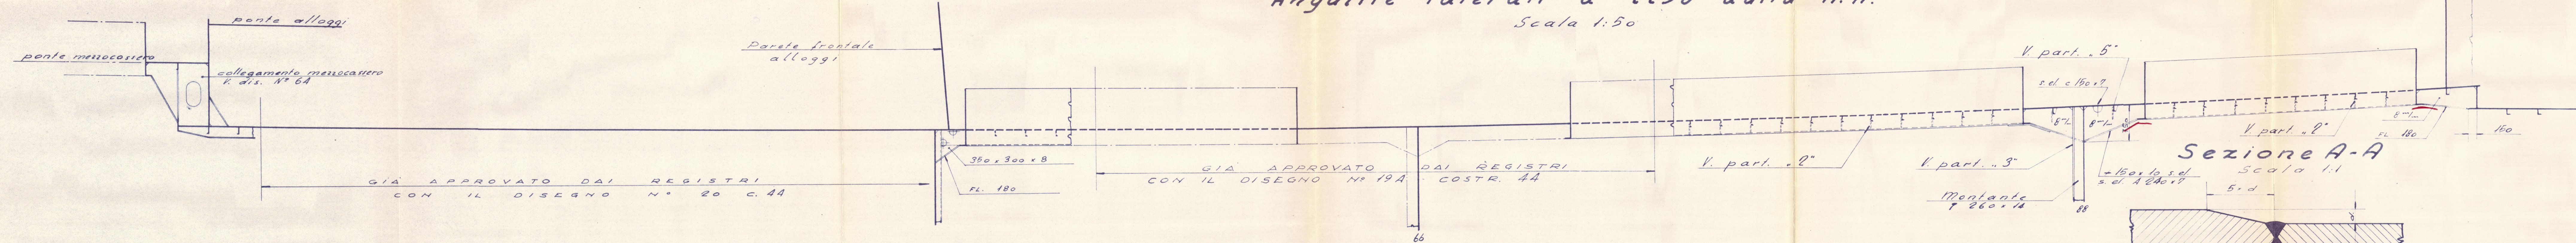


Sezione A-A Scala 1:1

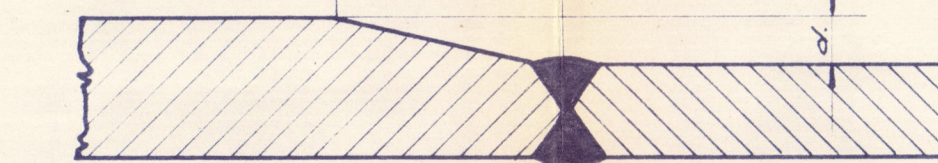


Particolare „3\"/>

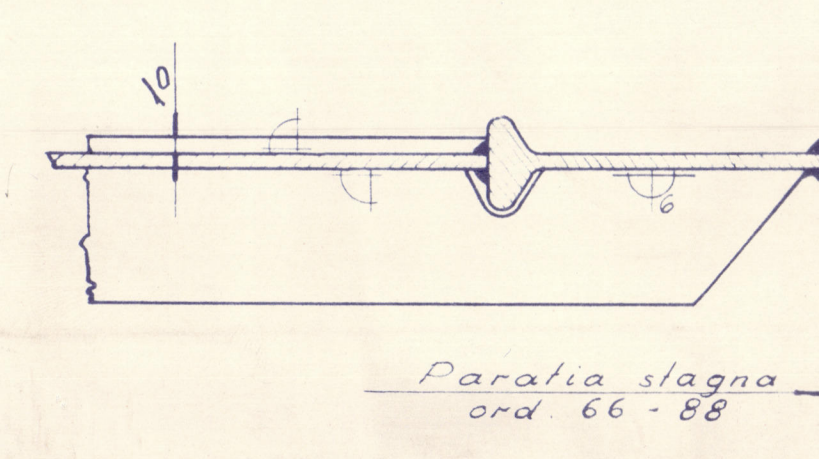


Particolare „4\"/>

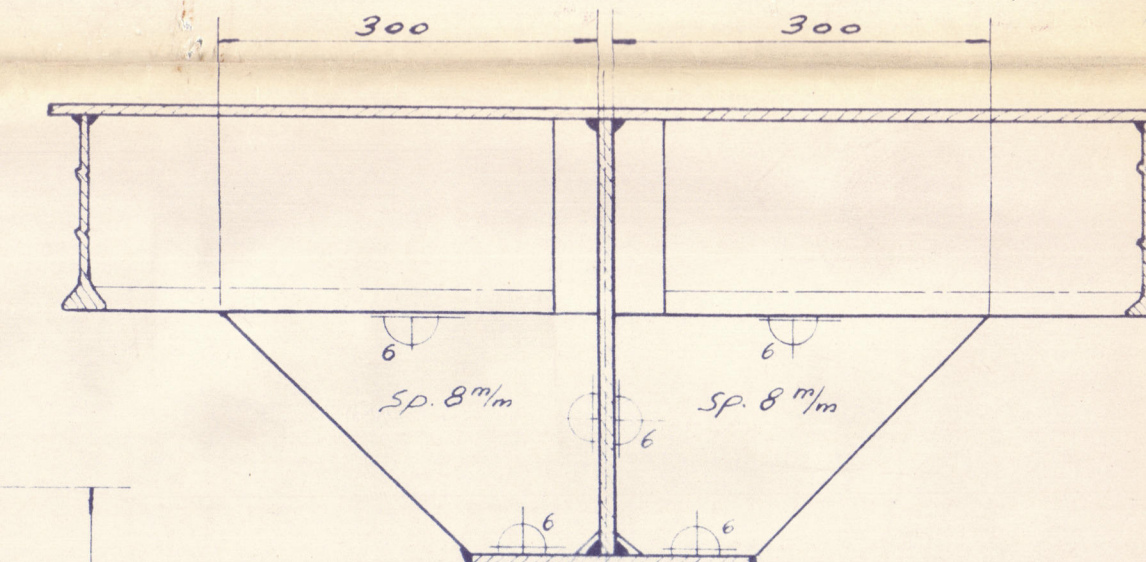



Particolare „2\"/>

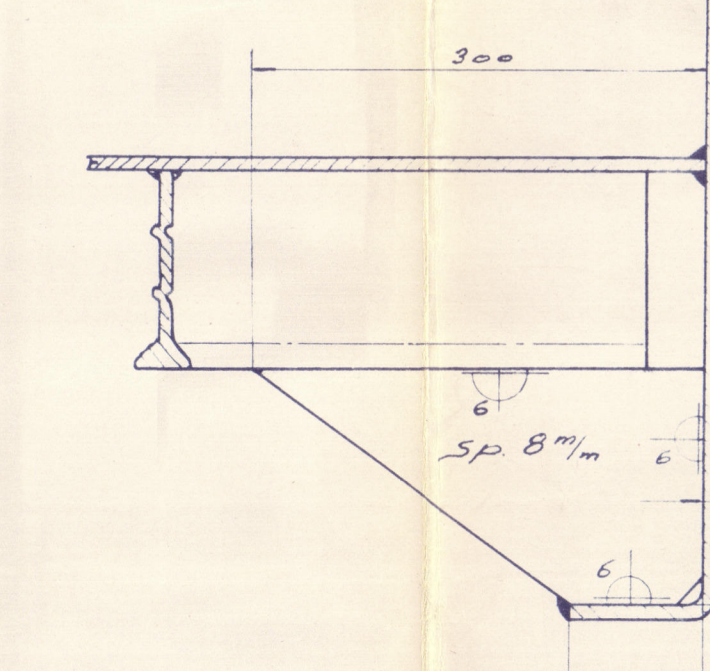

Particolare „5\"/>

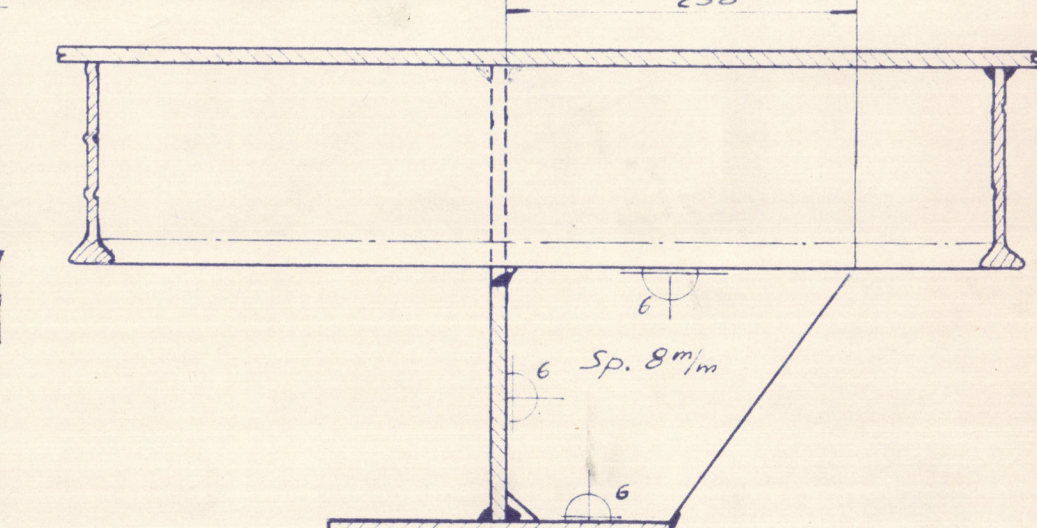


Part. „7\"/>

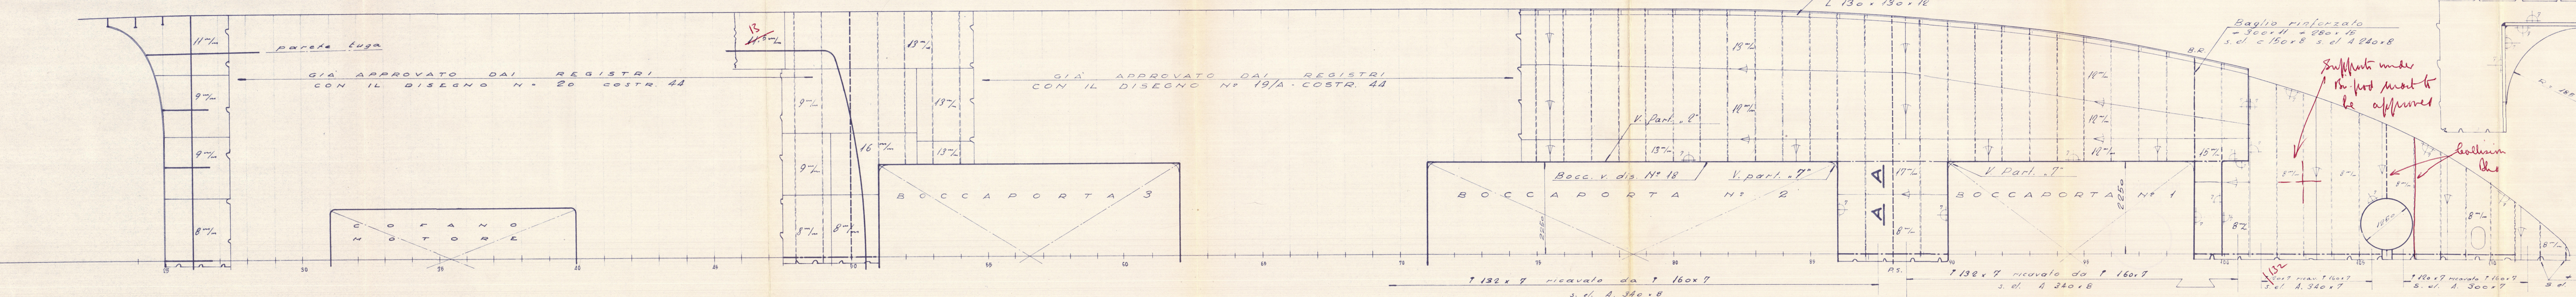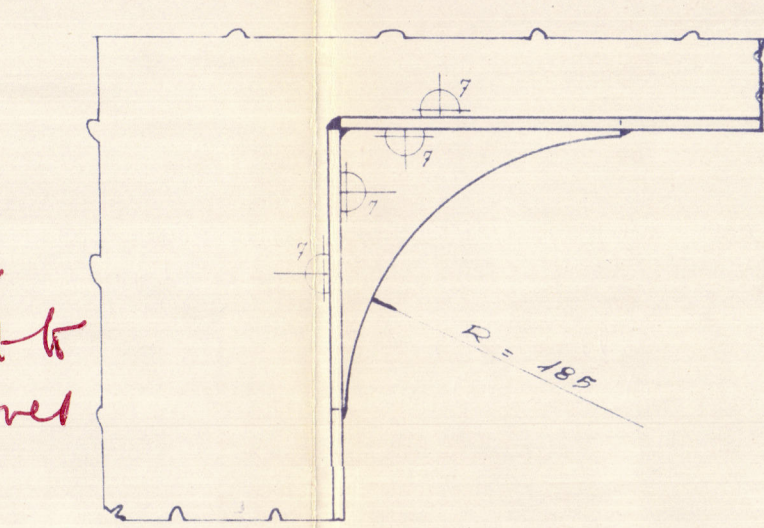

Supporti under the foot must be approved

ballium

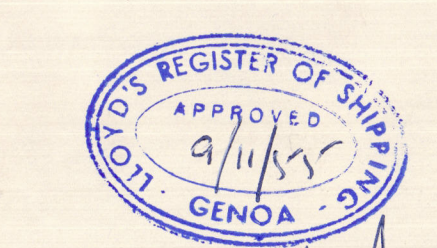


Deck details fore.	
CANTIERE NAVALE GIULIANO S. GIUSTO TRIESTE	
Motonave da carico	
COSTR. N° 45	Modificata
DIS. N° 63	SCALA: 1:50
Ponte coperta	
DATA: 17.10.55	DISEGNATO: [Signature]
CONTROLLATO: [Signature]	

004985 009992 0183

"CAPO FARO" ★

deck details, final.

RECORDS DEPT.,
LONDON.

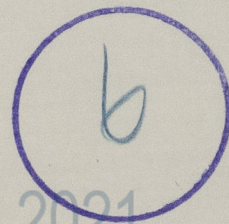

© 2021

Lloyd's Register
Foundation

009986-004493-0187