


S. S. N^{os} 88 & 92

PROFILE & DECKS.

DIMENSIONS
 LENGTH BETWEEN PERPENDICULARS... 280' 0"
 BREADTH MOULDED... 40' 6"
 DEPTH MOULDED... 21' 0"
 SCALE 1/4" = ONE FOOT
 TO CLASS LLOYD'S 100 A1

PARTICULARS FOR FREEBOARD
 REGISTERED DIMENSIONS 280' 0" x 40' 6" x 21' 0"
 UNDER DECK TONNAGE 1630 TONS APPROX.
 SHEER AT STEM 6' 6" AT 8' LEN FROM STEM 5' 7"
 STERN 3' 5" STERN 1' 10"
 BRIDGE BUILT PLATE DOORS (4' 6" x 3' 0" OPENING) AT FORE END
 BRIDGE CLOSED AT AFTER END
 ROOF CLOSED
 FORECASTLE OPENING 4' 6" x 3' 0" CLOSED BY PORTABLE WOOD
 BATTENS 2 1/2" THICK

Depth at center 21'-10"
 Depth of double bottom 3'-0 1/2"
 15'-9 1/2"
 Depth to inner bottom

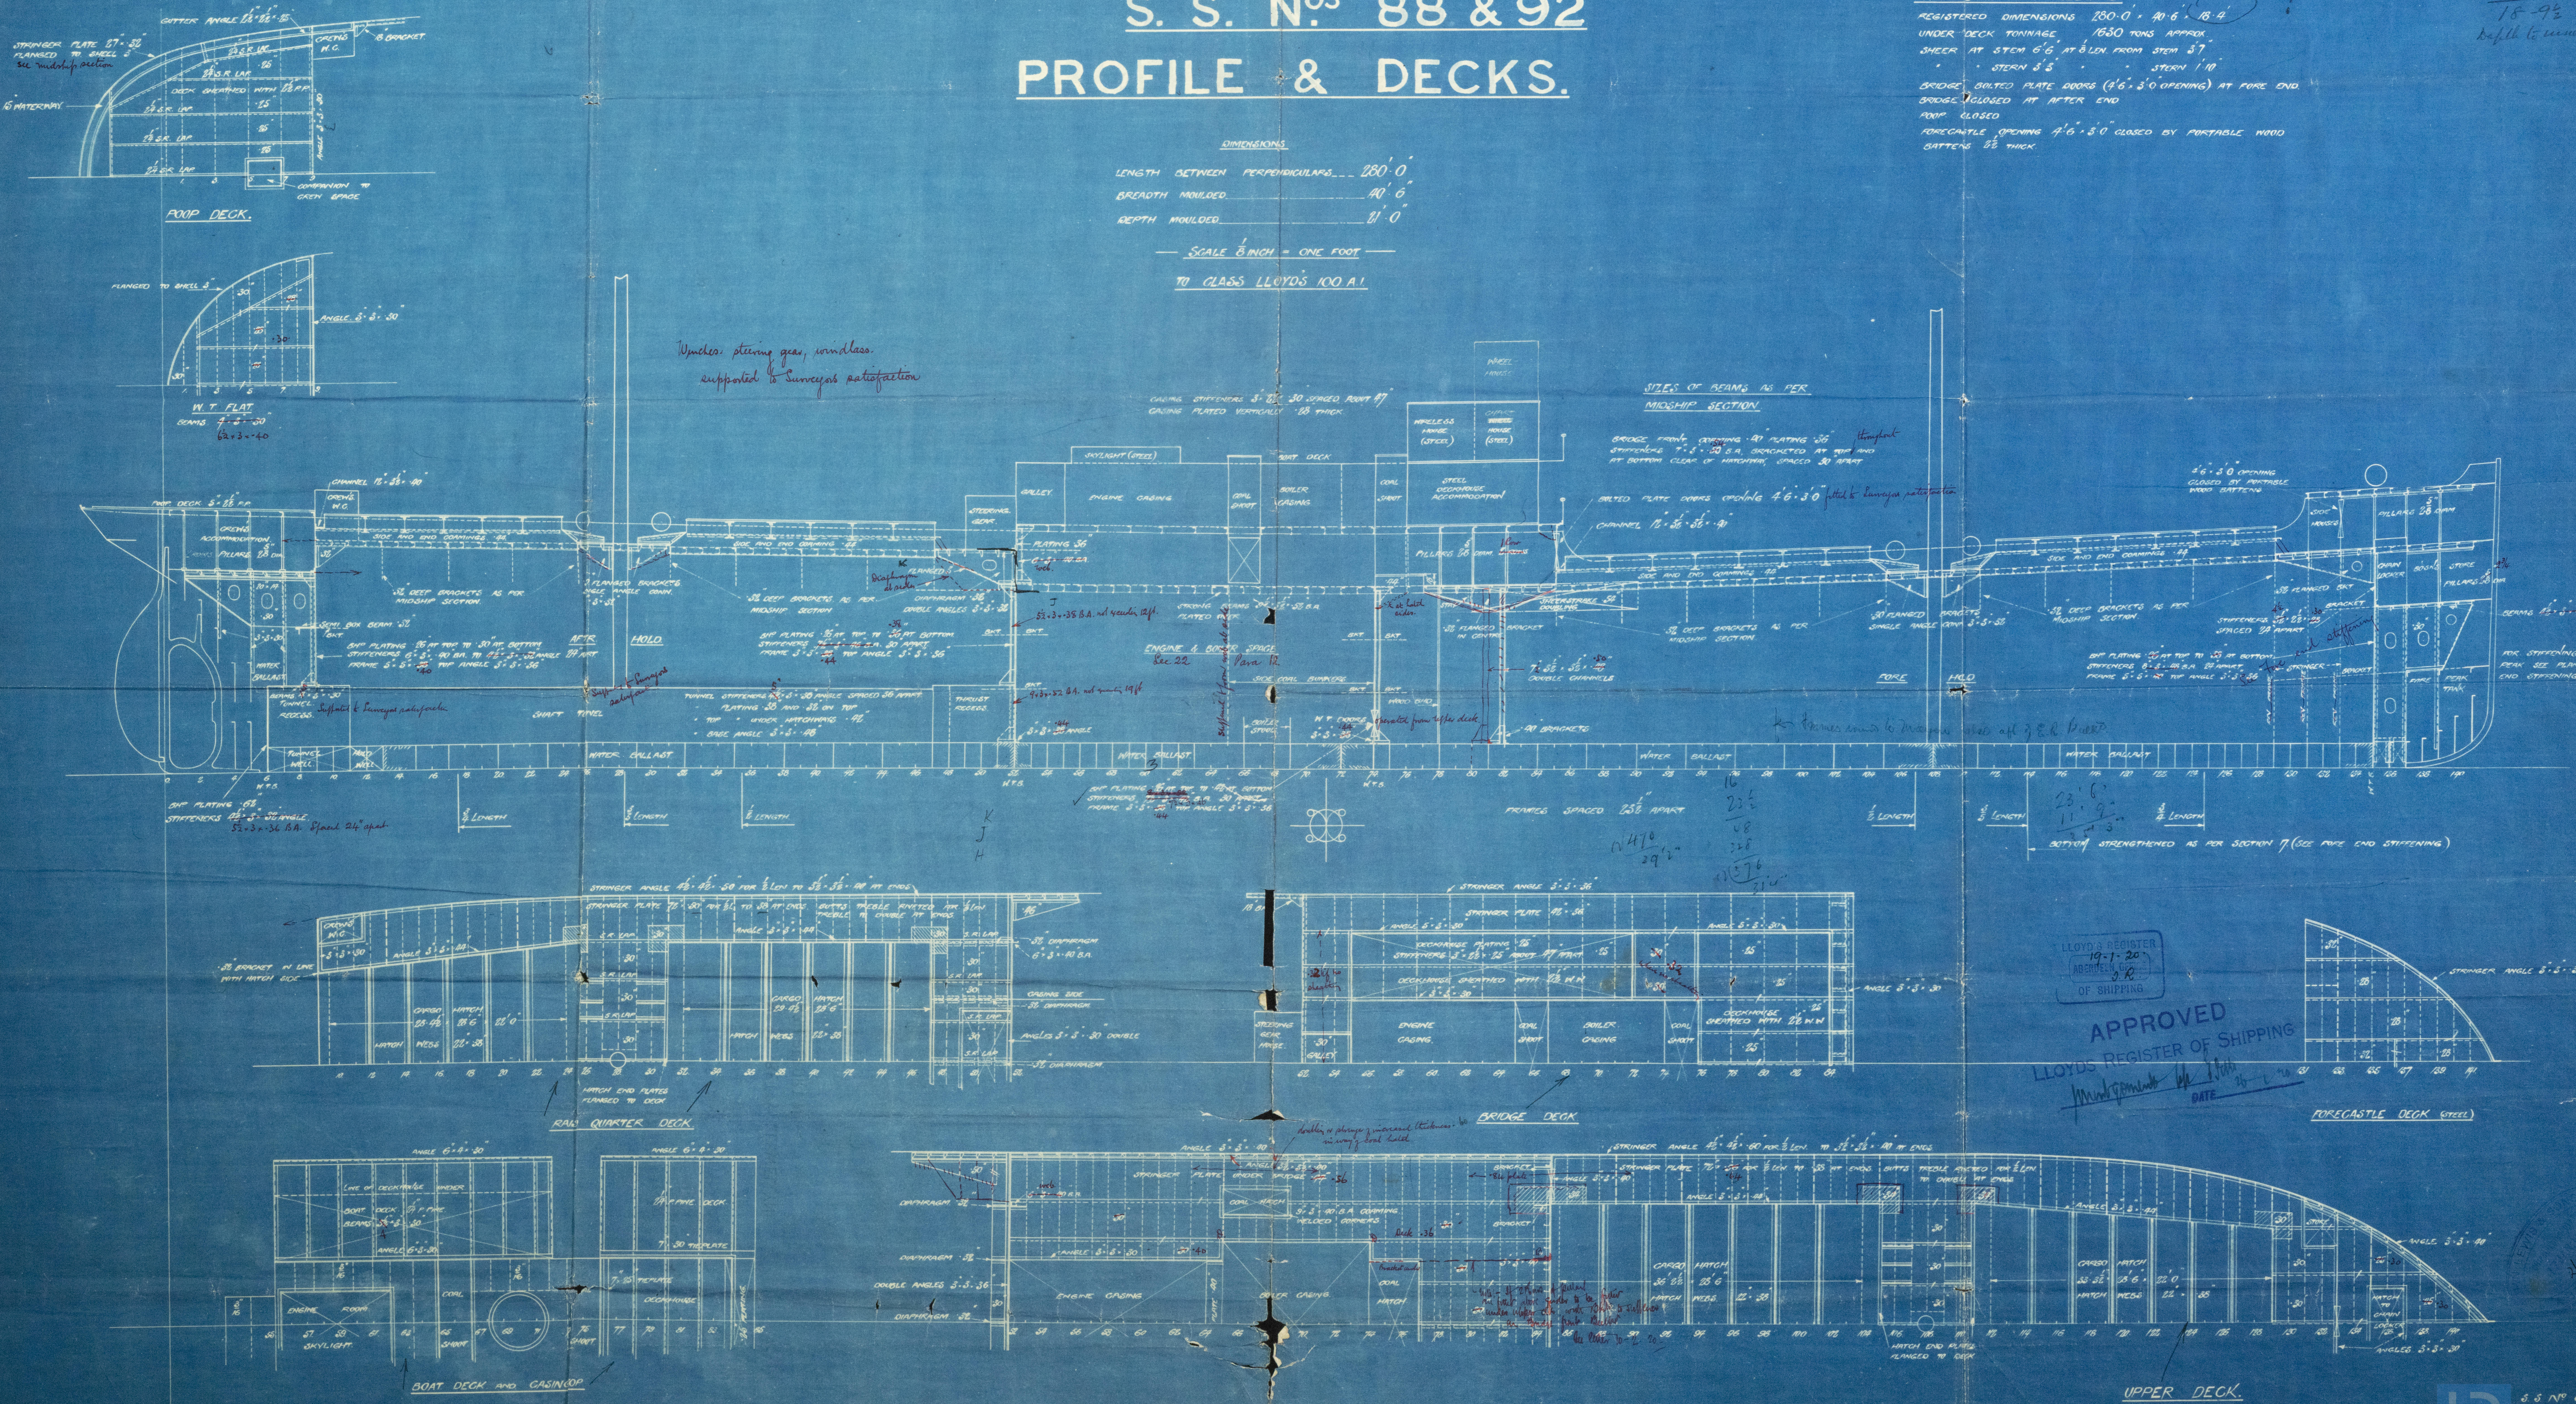

LLOYD'S REGISTER
 19-1-20
 APPROVED
 LLOYD'S REGISTER OF SHIPPING
 DATE 19-1-20

S. S. N^{os} 88 + 92.

MESSRS. J. LEWIS & SONS. LD

PROFILE + DECK PLAN.

N^o 88. = "ELAINE LLEWELLYN" *

ABN. REPORT N^o = 13196.

N^o 92. "BETTY LLEWELLYN."

ABN. REPORT N^o = 13506.

Moyle Leudnitza

*Plants to be put back into
= "Elaine Llewellyn"*

N. N. Sausanna Papadakis

Ex
master Meolas 55



© 2021

Lloyd's Register
Foundation

009994-010003-0109

009914-01003-0109



© 2021

Lloyd's Register
Foundation