

DETAILS OF STERN AND RUDDER FRAME

YARD No 127.

SCALE $\frac{3}{4}$ " = 1 FOOT.



Area Rudder 25.125.

C. shaft & pintles 1.75.

$A \times D = 43.97$.

FORGED IRON.


SECTIONS AT

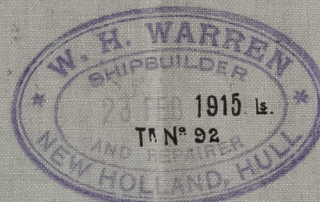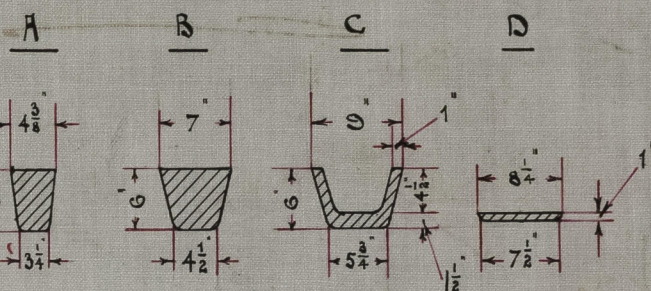



Examined by Mr. Wright.

18 Feb. /16.

To LLOYD'S TESTS AND INSPECTION
AT YOUR WORKS.

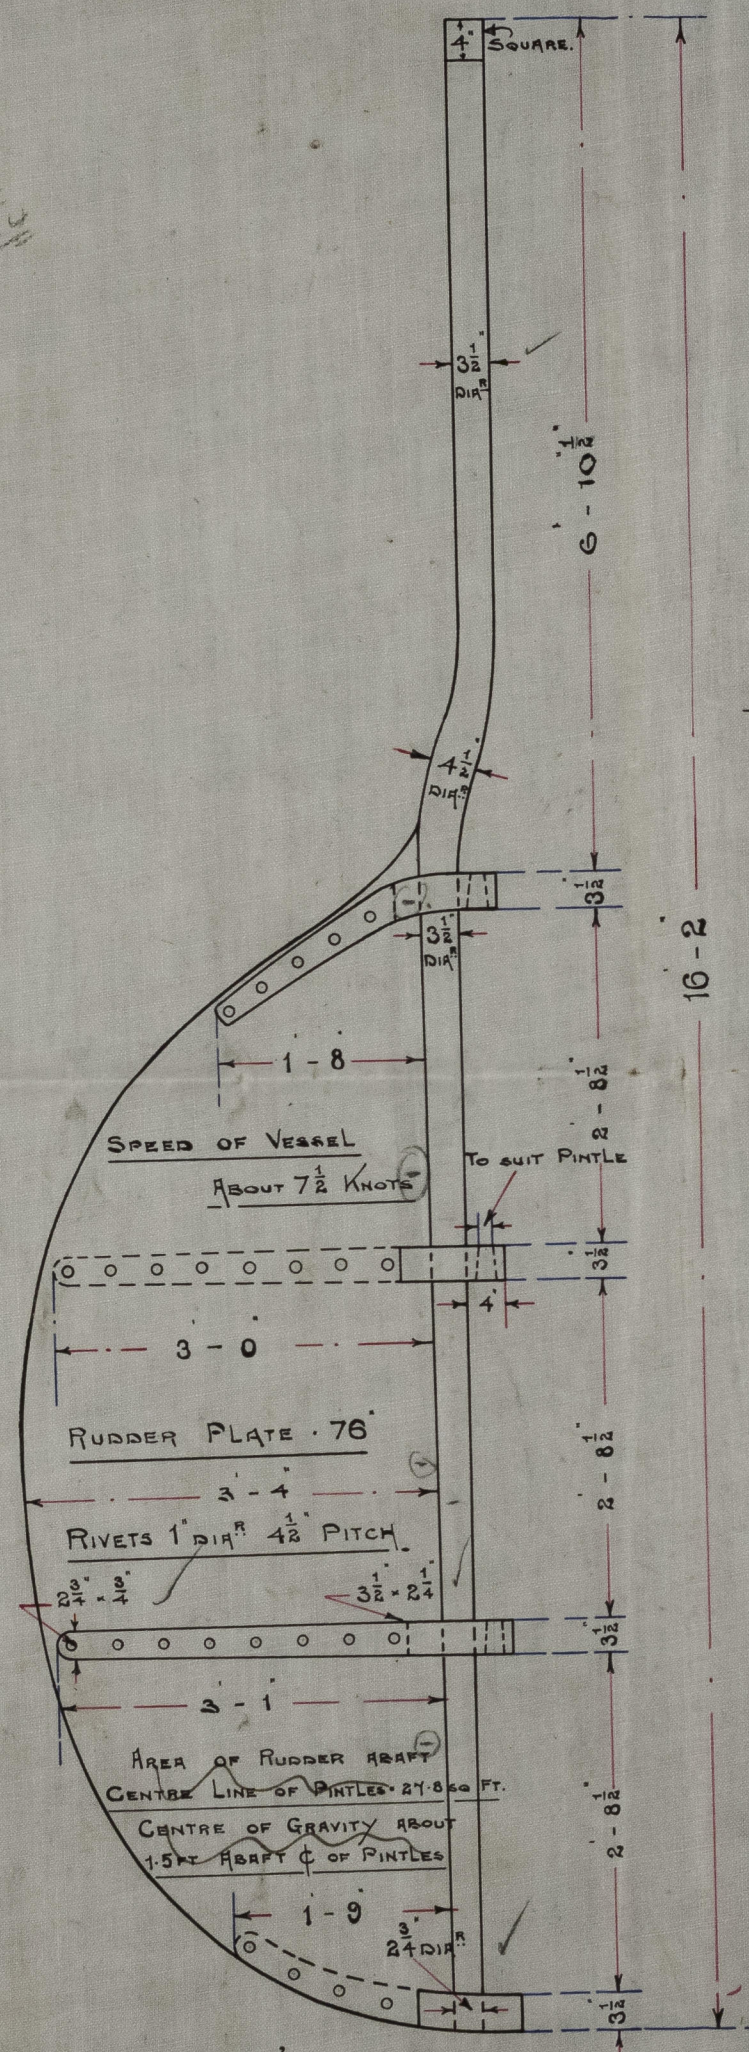

SECTION THRO' ARM

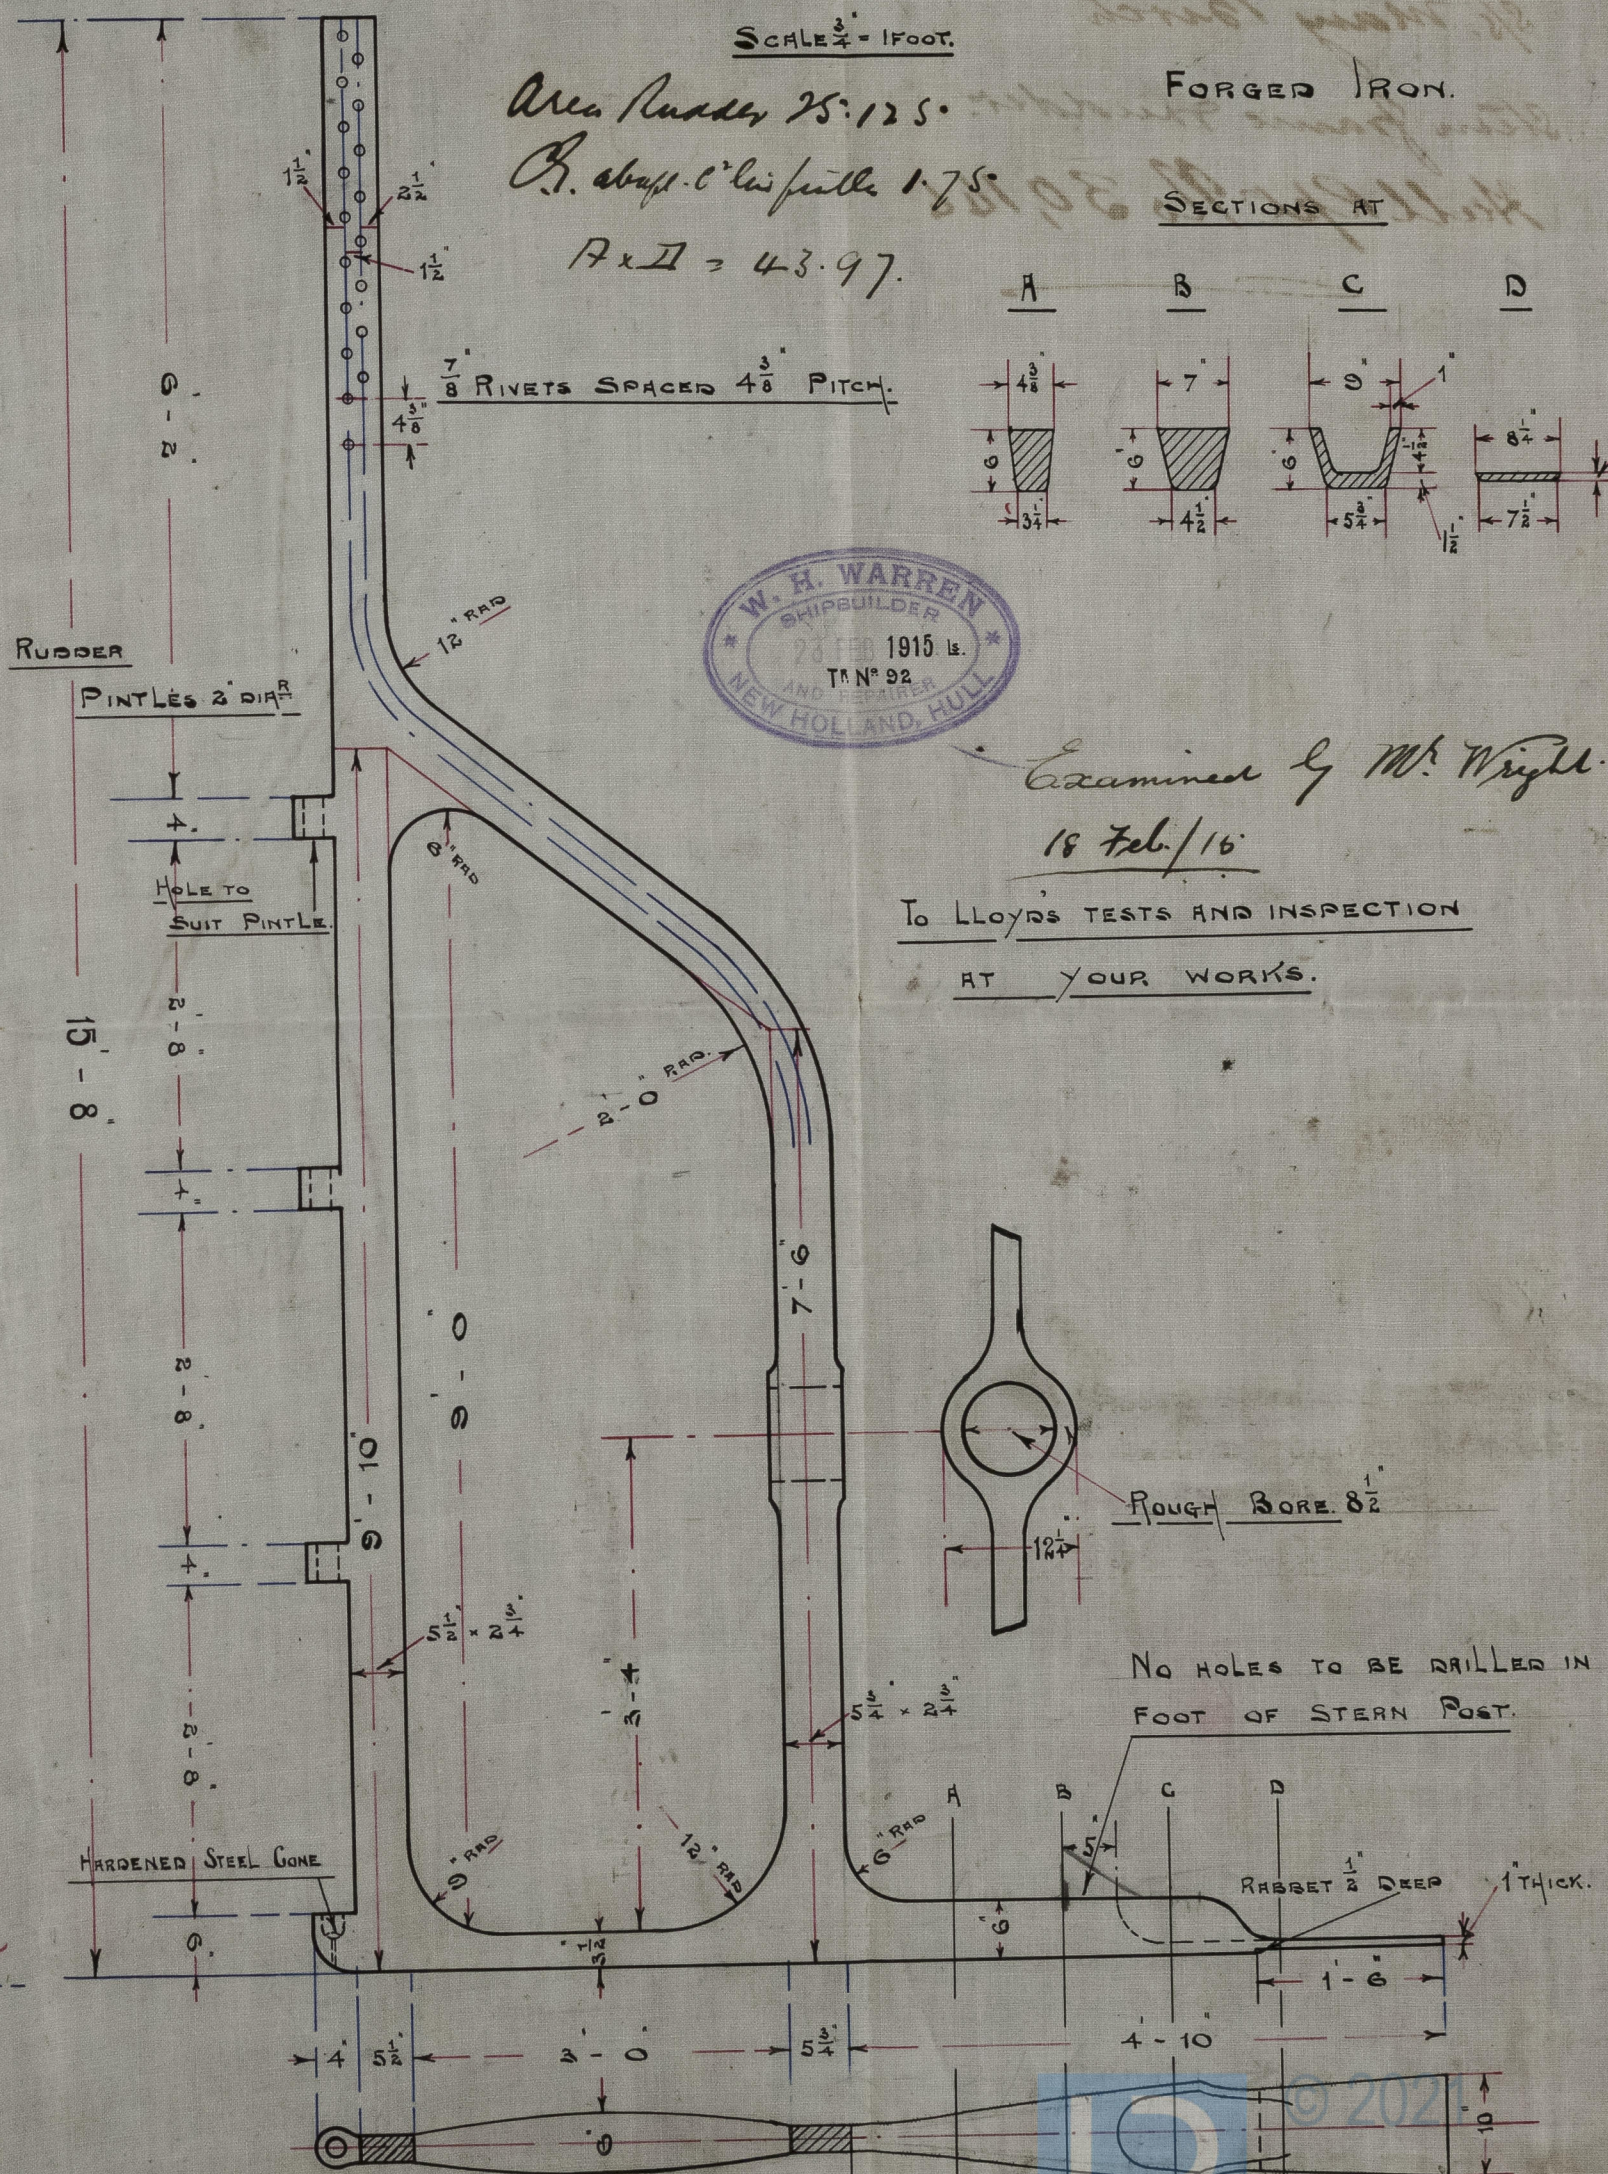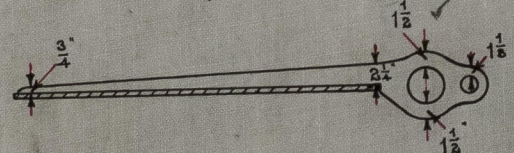

ROUGH BORE 8 1/2

NO HOLES TO BE DRILLED IN
FOOT OF STERN POST.

RABBIT 1/2" DEEP 1" THICK.

9/7/15.


Yr "Vincennes" Series

Warren N. 127.

S/S. Mary Birch

Stem frame & rudder.

Hull Rpt. No 30, 166

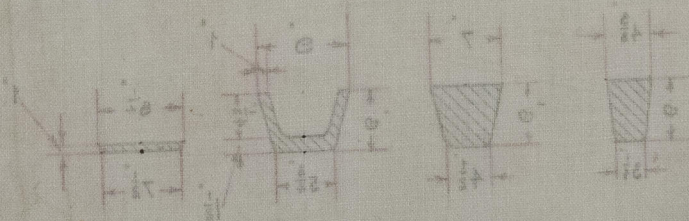

© 2021

Lloyd's Register
Foundation

010037-010041-0205

AT YOUR WORKS