

LOYDS REGISTER OF SHIPPING

# MIDSHIP SECTION OF MOTOR COASTER

EQUIPMENT *ho. 3773*

110 - 0 B.P. - 21 - 0 - 11 - 0 MLD *to upper dk*

SCALE: - 1/2" = 1 FOOT

32.42  
1ST N° 32  
2ND N° 3750 *3066*


DEPTH TO LENGTH 10 *to upper dk.*  
*8.9 Rained Quarter dk.*

To Class LLOYDS 100 A1.


*4-12'3" Rained Quarter deck*  
*d = 8.5 to upper dk = 9.75 to Rained*  
*Quarter deck.*

2 IN NO 5 CWT STOCKLESS ANCHORS  
1 IN NO 12 CWT STREAM ANCHOR *ex stock.*  
1 IN NO 3/4" KEDGE " "  
120 FATHOMS 3/4" STUD CHAIN CABLE.  
45 " 8/16 SHORT LINK " *2 1/2" all wires*  
75 " 6" HEMPA HAWSER. *with 15/16/17*  
90 " 4" HAWSER. *main*

28.1.15

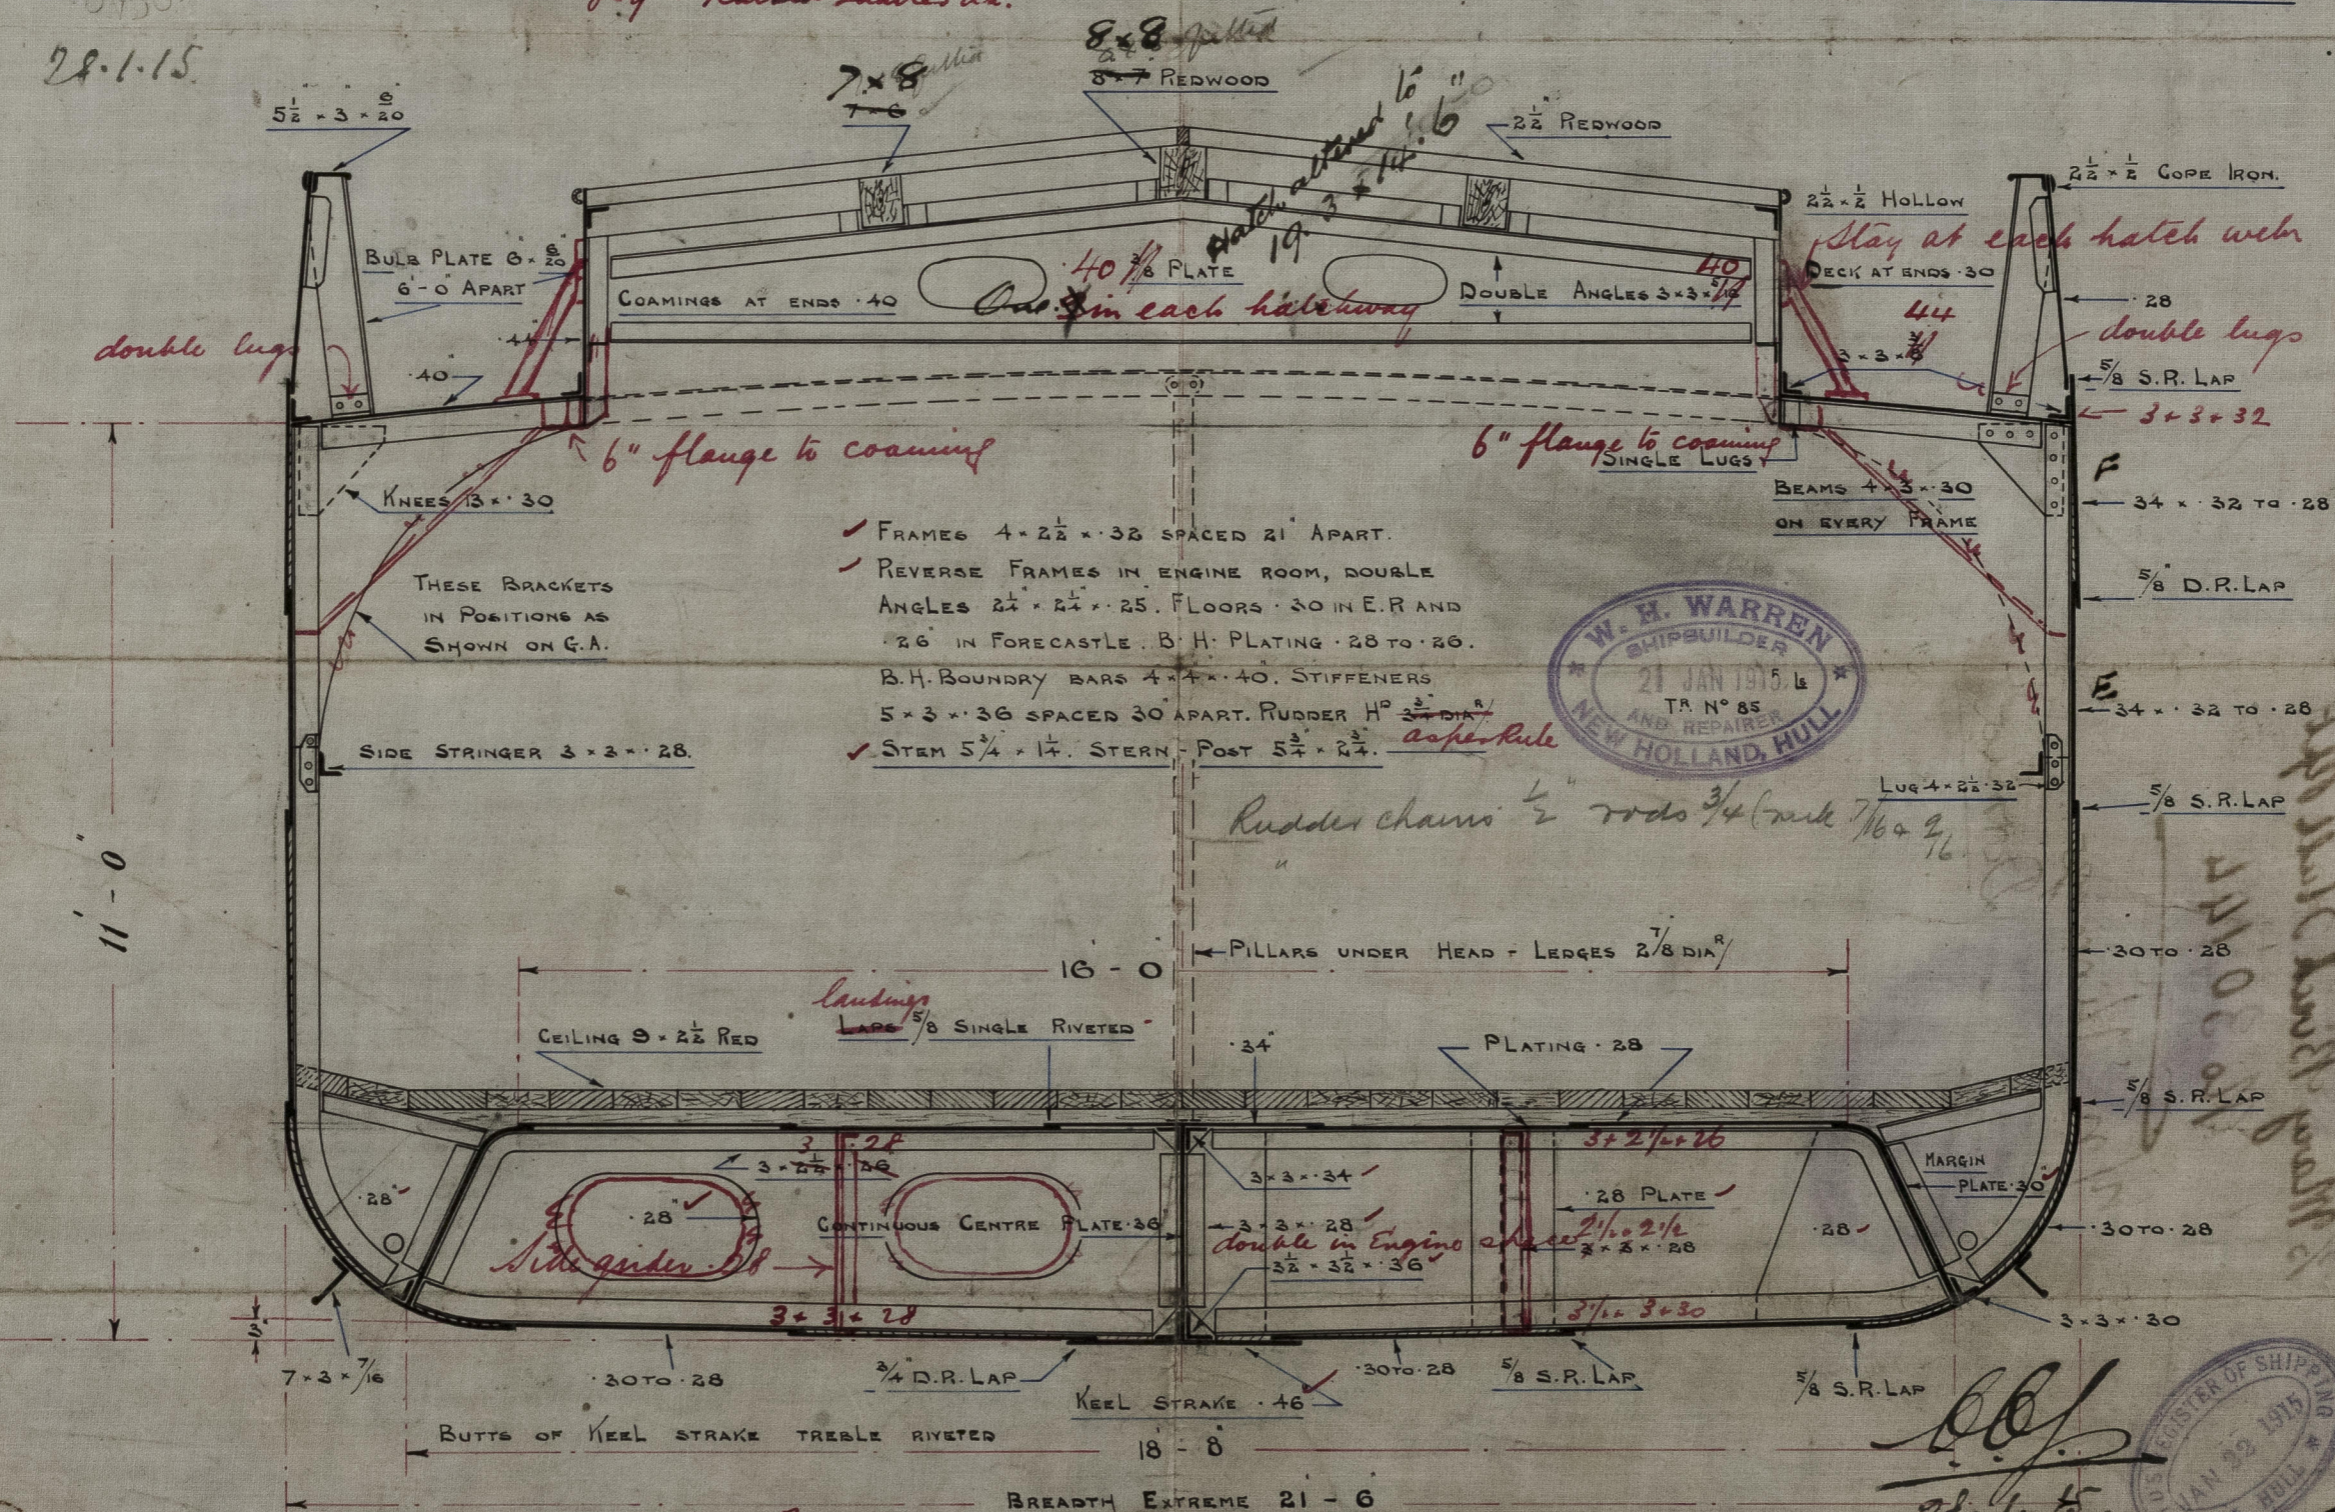

- ✓ FRAMES 4 x 2 1/2 x 32 SPACED 21' APART.
- ✓ REVERSE FRAMES IN ENGINE ROOM, DOUBLE ANGLES 2 1/2 x 2 1/2 x 25. FLOORS 30 IN E.R AND 26 IN FORECASTLE. B.H. PLATING 28 TO 26.
- B.H. BOUNDARY BARS 4 x 4 x 40. STIFFENERS 5 x 3 x 36 SPACED 30 APART. RUDDER HP 3 1/2 DIA.
- ✓ STEM 5 1/4 x 17. STERN POST 5 1/2 x 2 1/2. *as per rule*

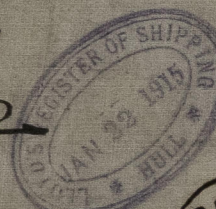

*22/1/15*

*Section 18.*

Bottom forward of the half length to be strengthened as required  
THESE ARRANGEMENTS ON ALTERNATE FRAMES *by the Rules.*

*Solid floors to be fitted to every frame in the machinery space and forward of the half length*



Lloyd's Register  
Foundation

Midship Section  
W. H. Warren

110 X 21.5 X 11

Mary Birch Hull  
Hull Rpt No 29857 No 127

1/2 Mary Birch Hull Rpt  
No 30,144

n/n "Vincenzo"

Dormio



© 2021

Lloyd's Register  
Foundation

010037-010045-0207