



PLAN OF SHUTTER DECK

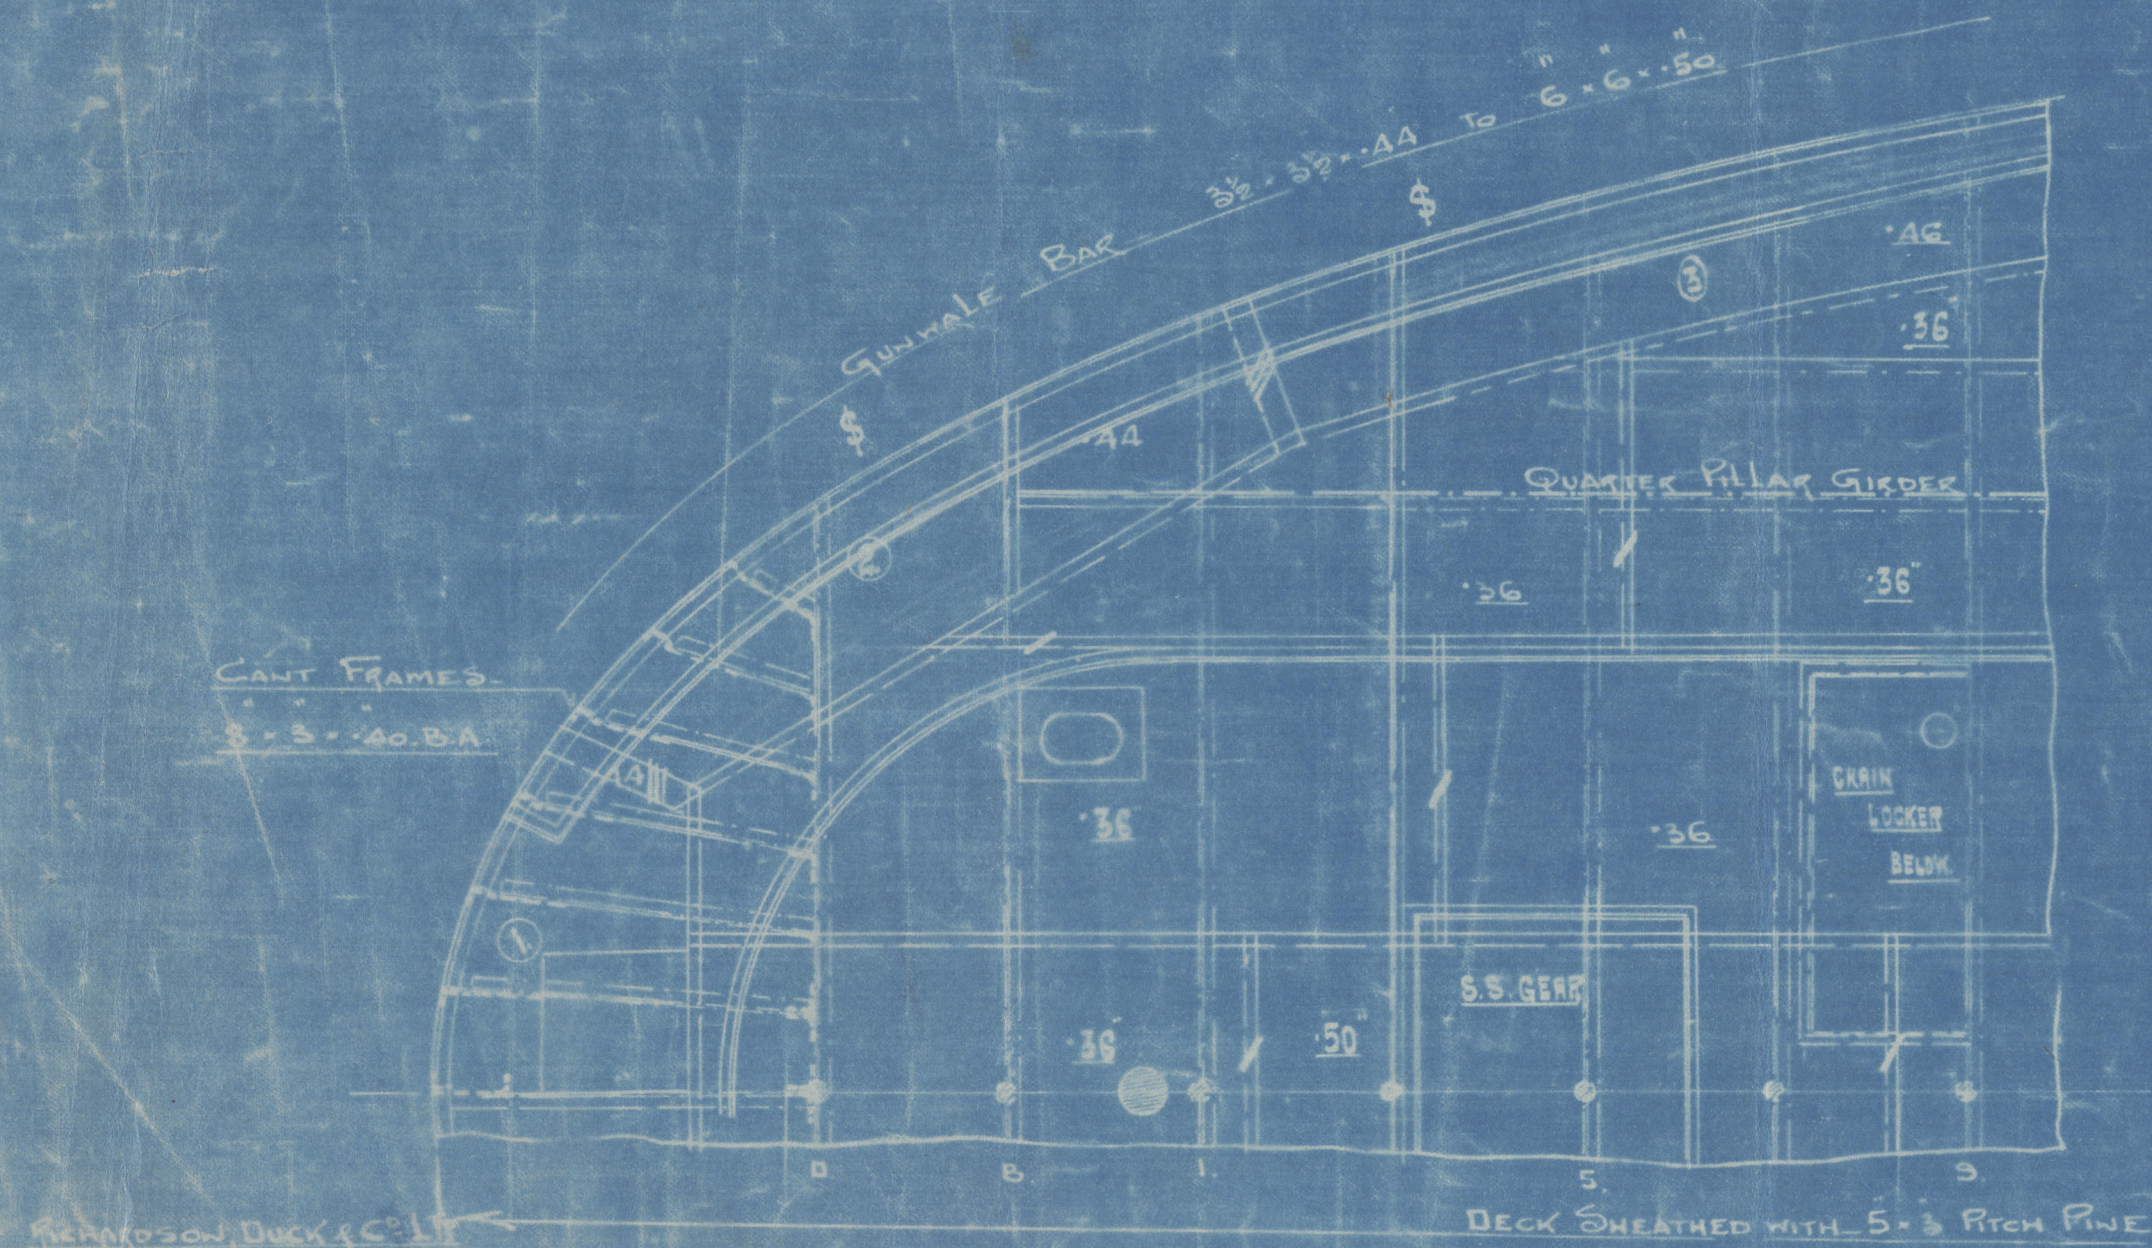


PLAN OF UPPER DECK

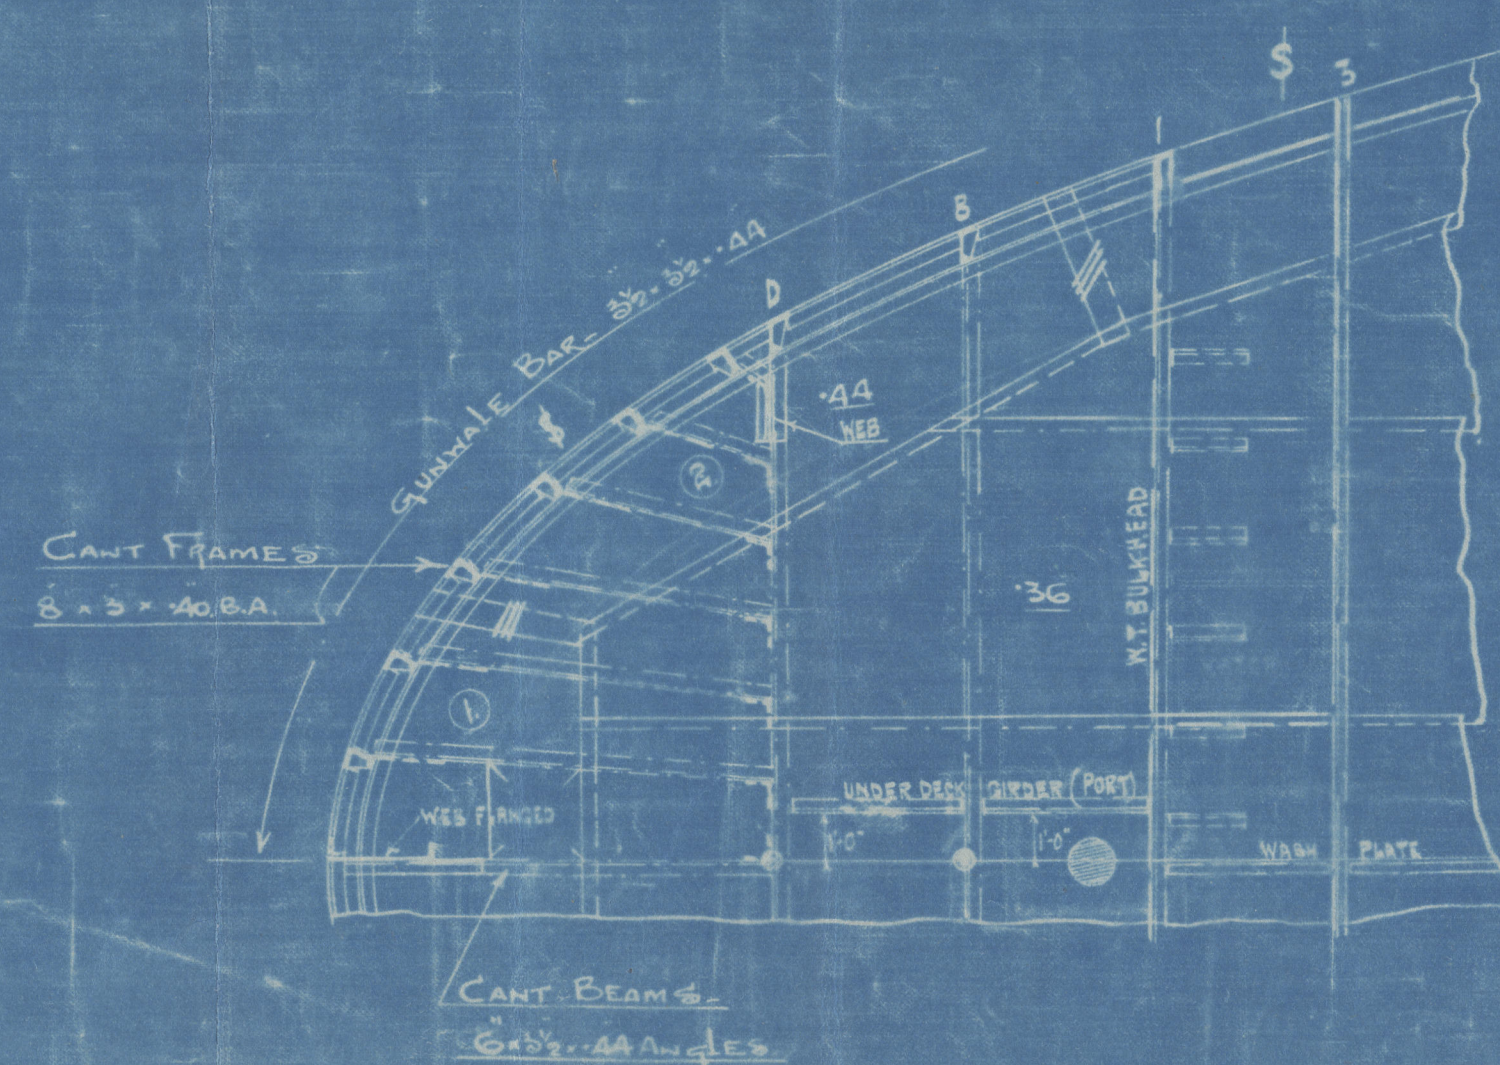

SKETCH OF CRUISER STERN

SCALE 1/4" = 1 FOOT

Nº 662.

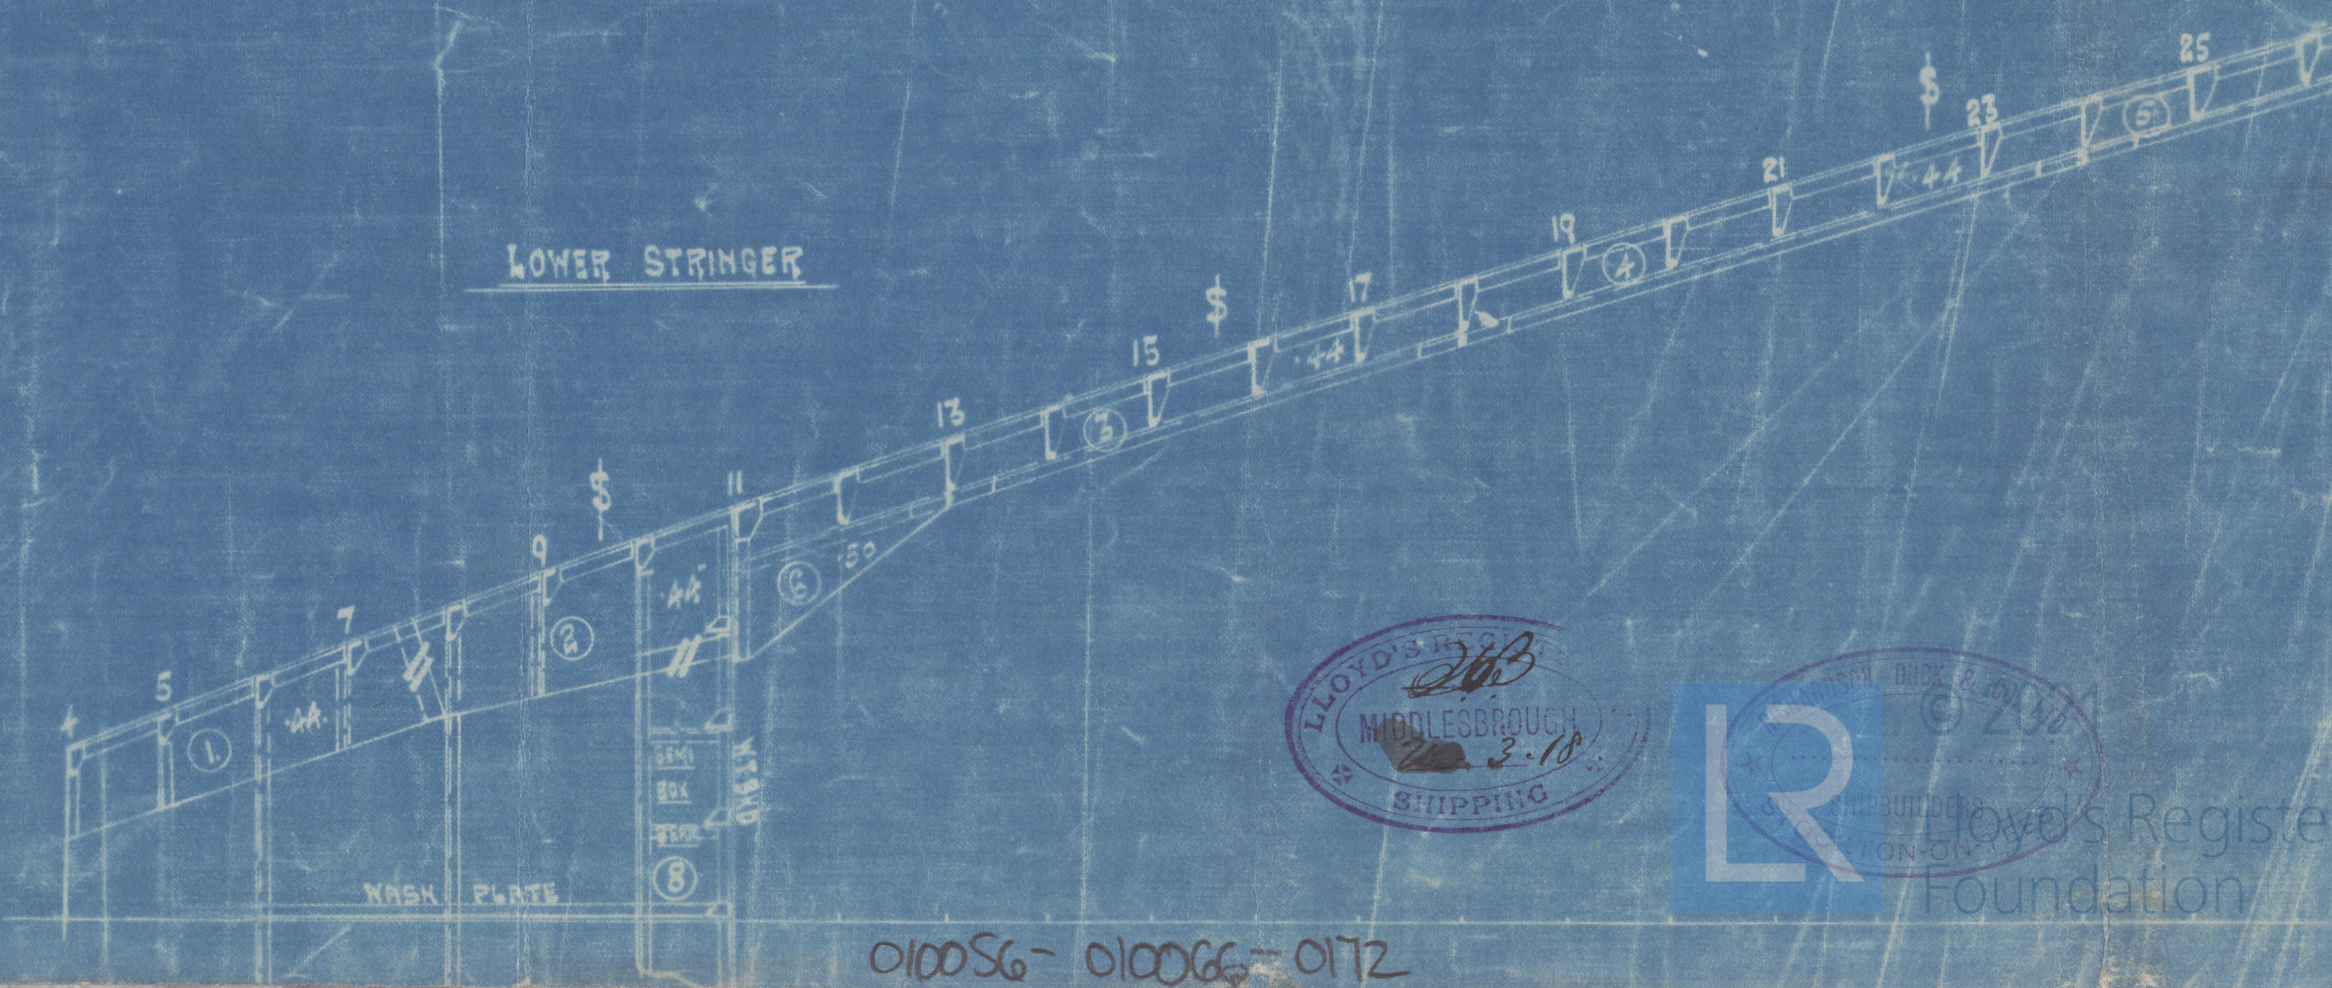

18/3/18

Nº 5767

010056-010066-0172




Messrs Rohnsden & Co
No 62

Cruiser Stern as built

Sp Kenilworth

Mkt report N^o 10057

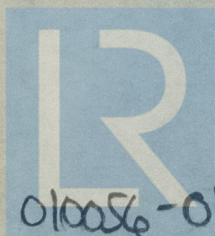

© 2021

Lloyd's Register
Foundation

010056-010066-0172