

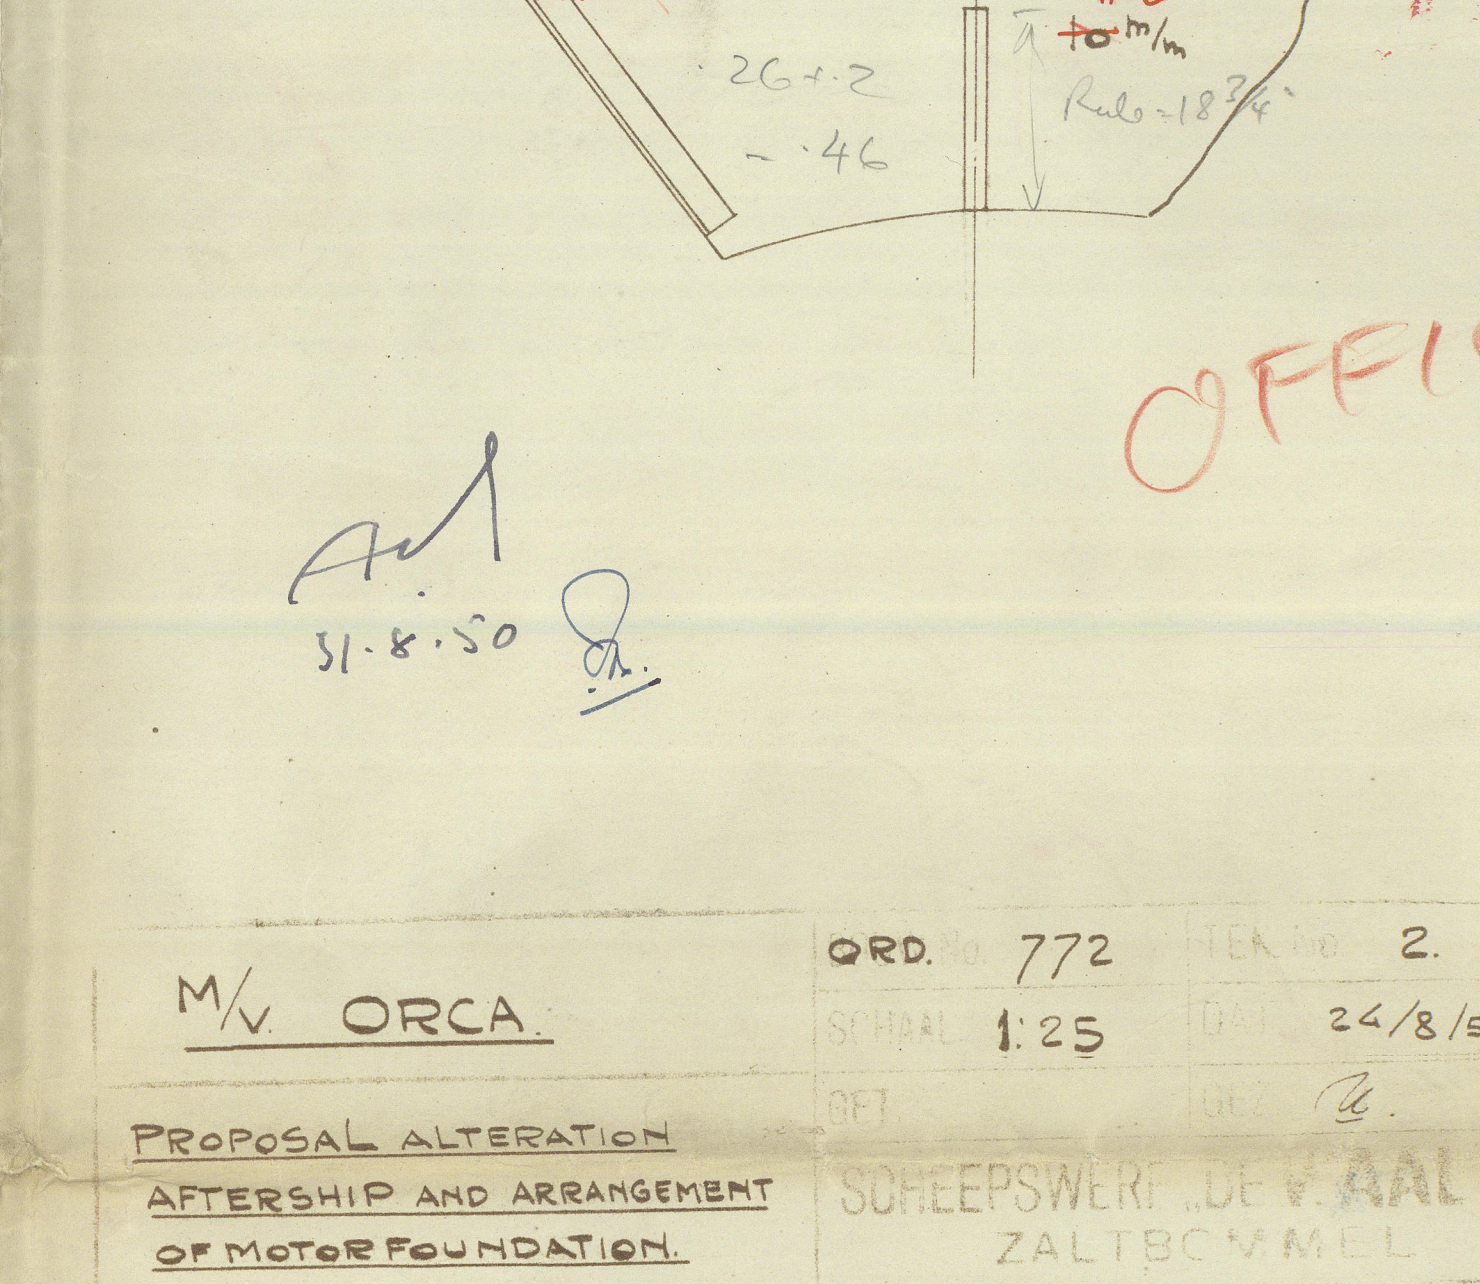
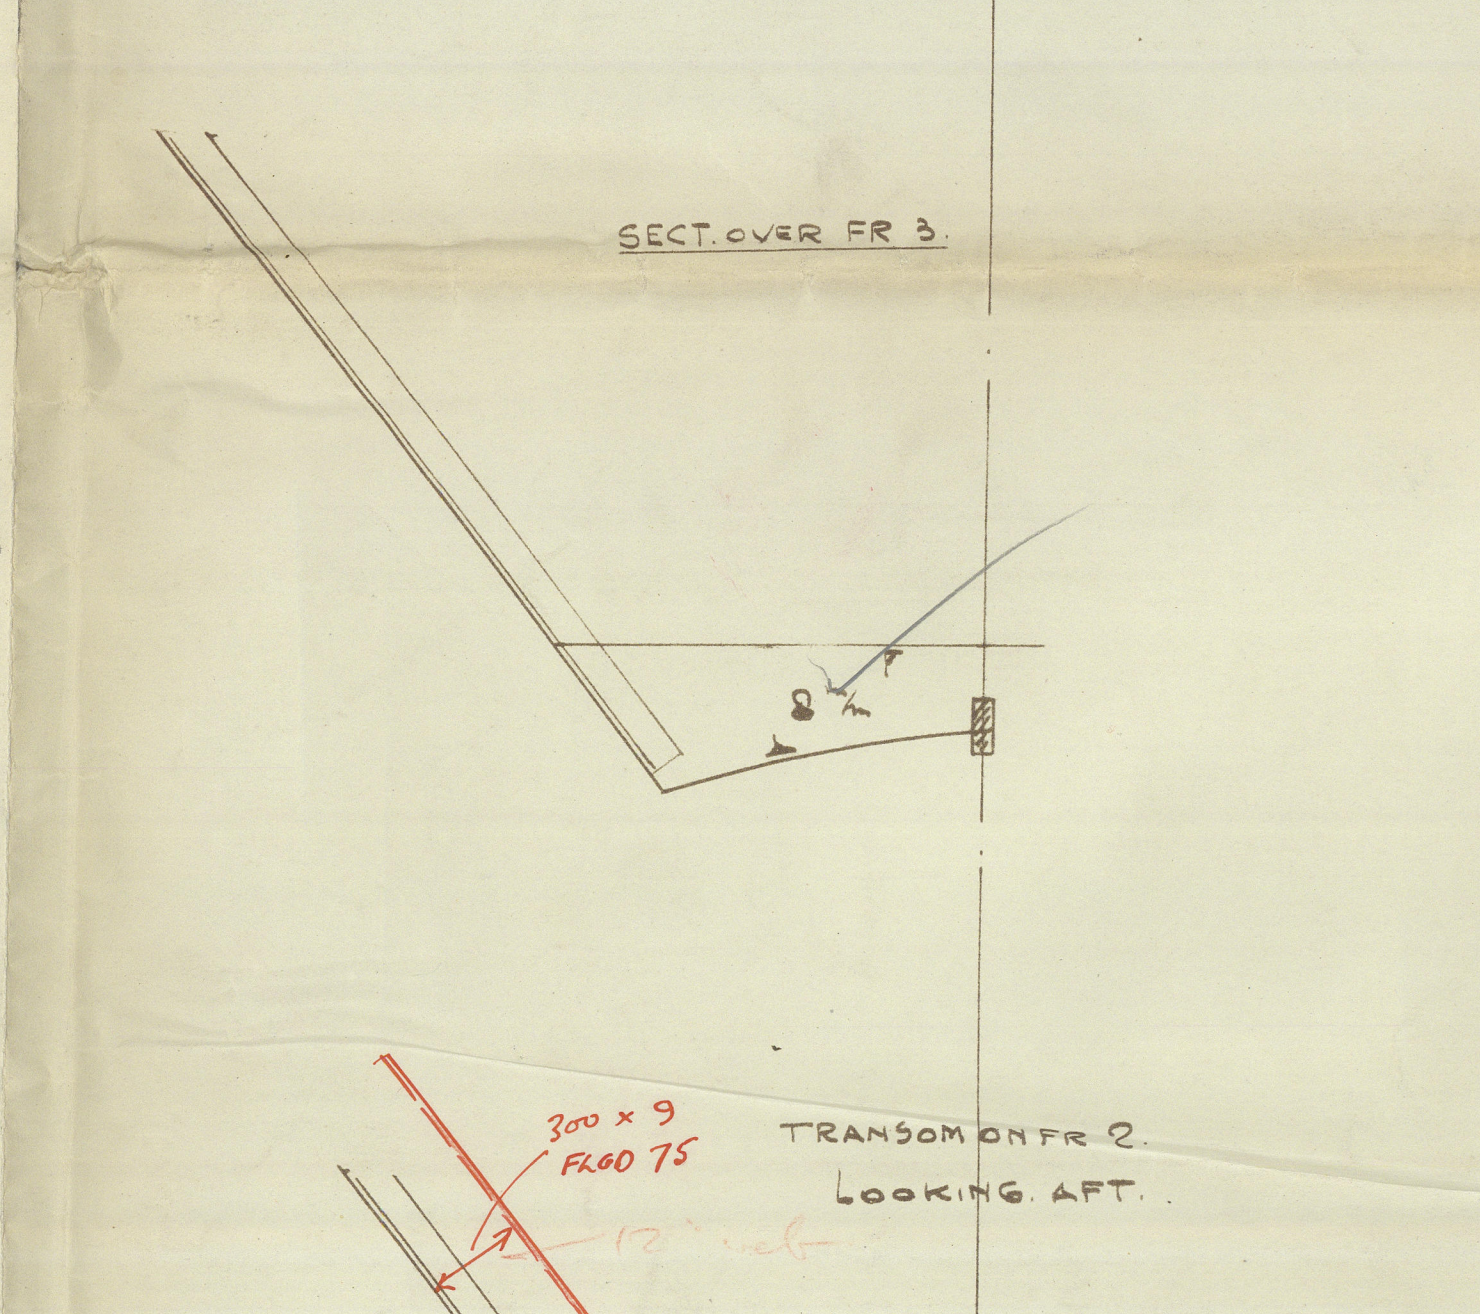
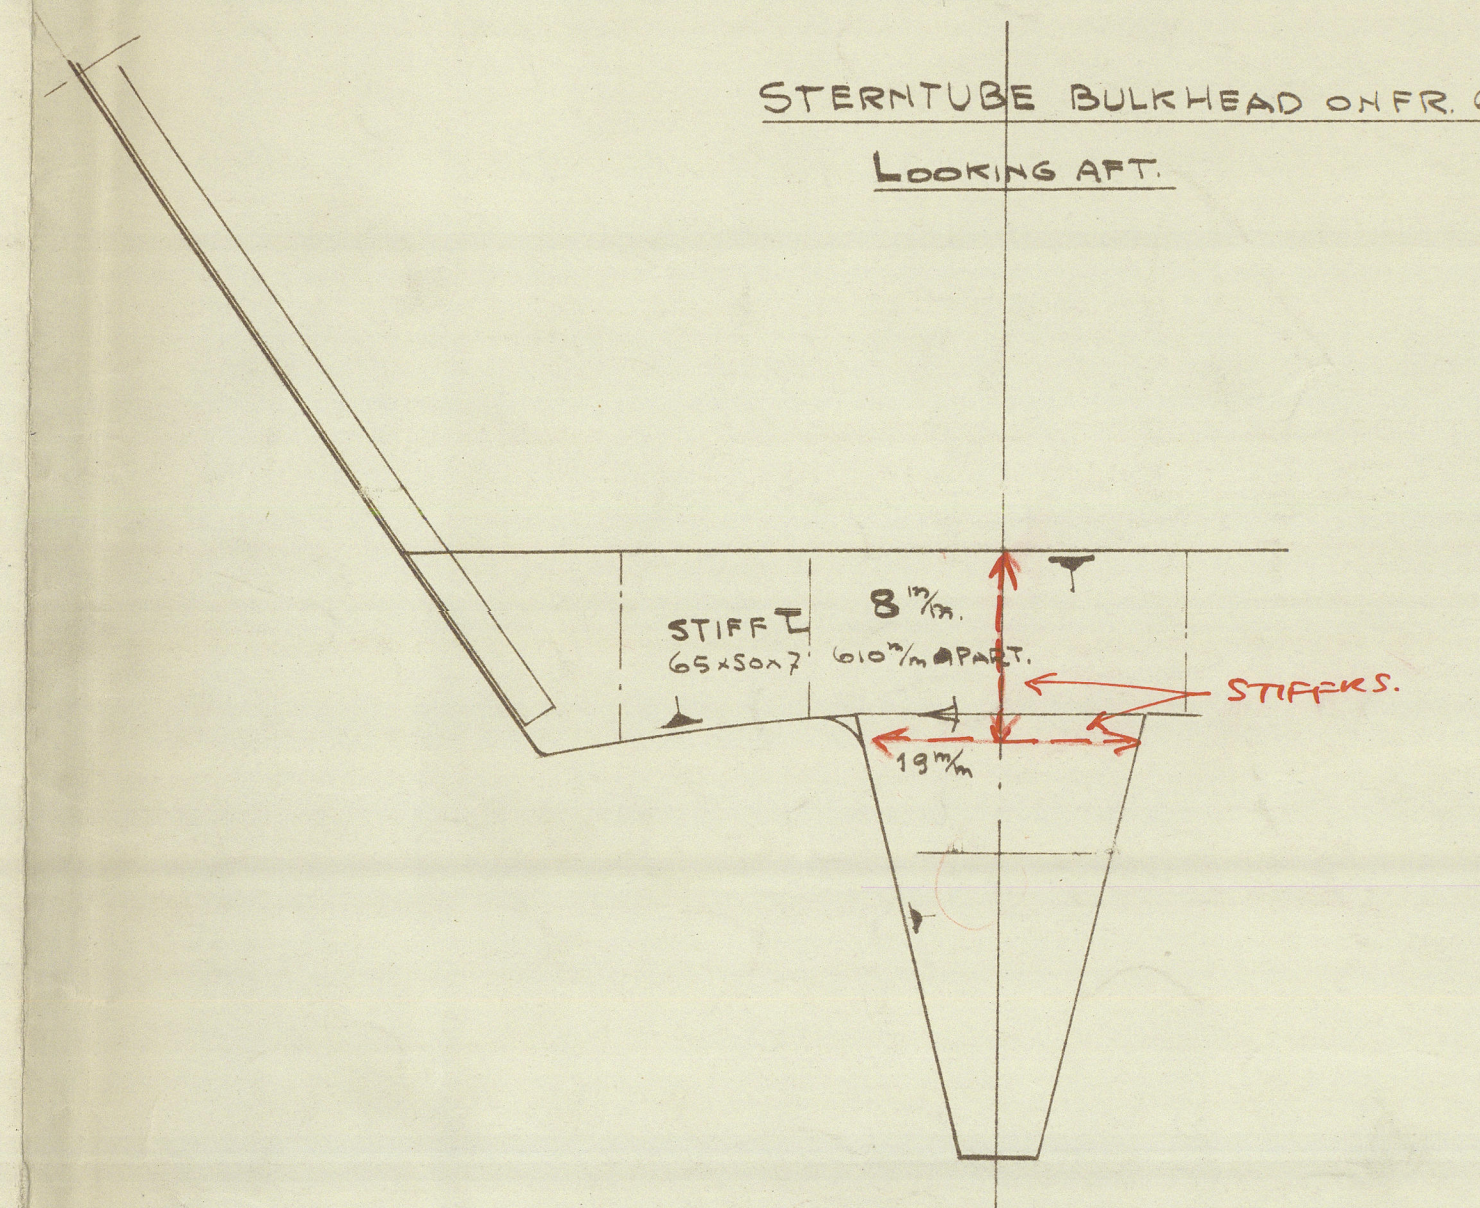
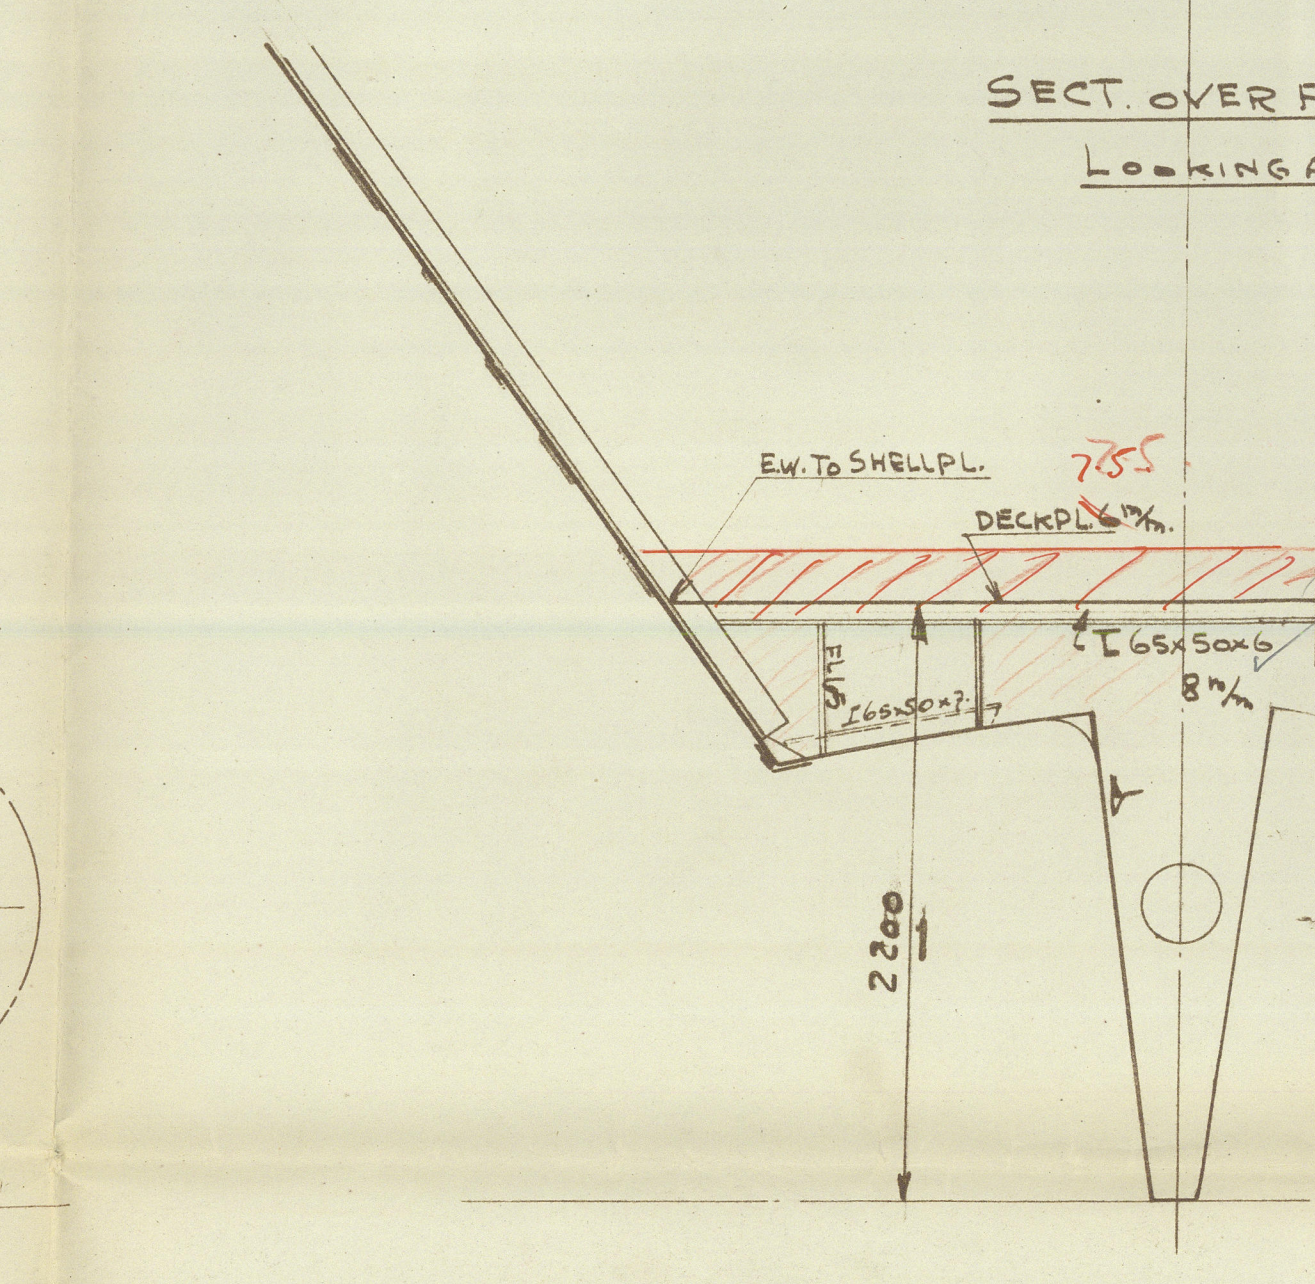
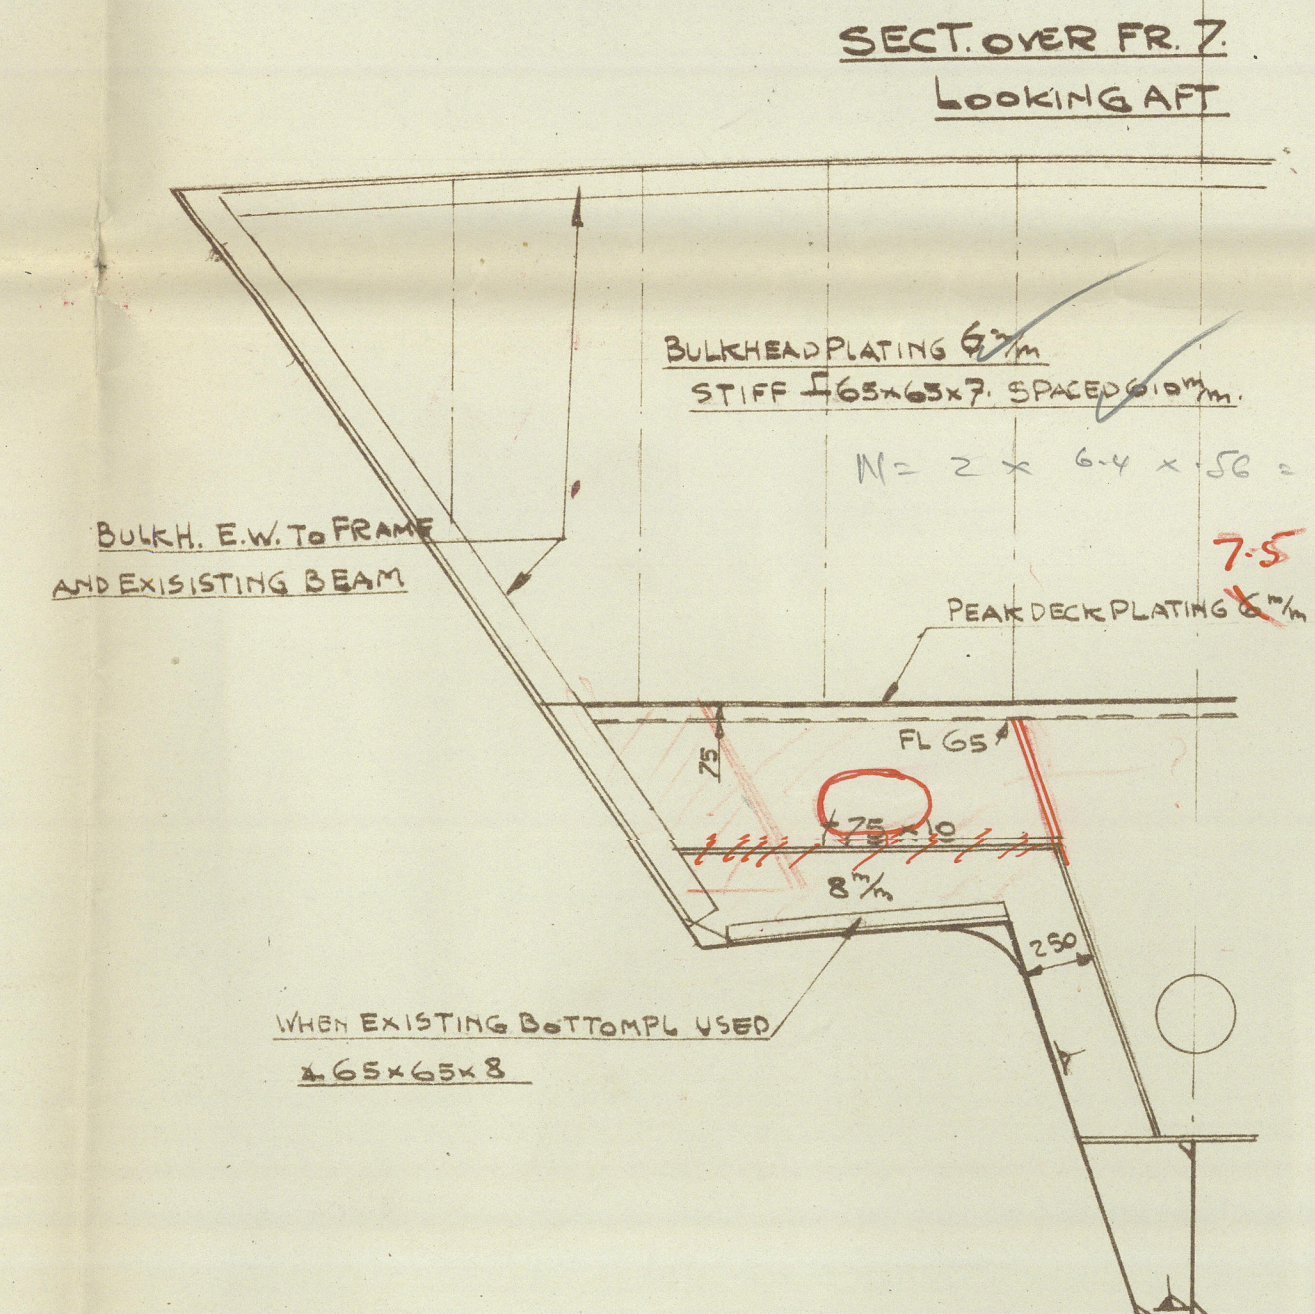
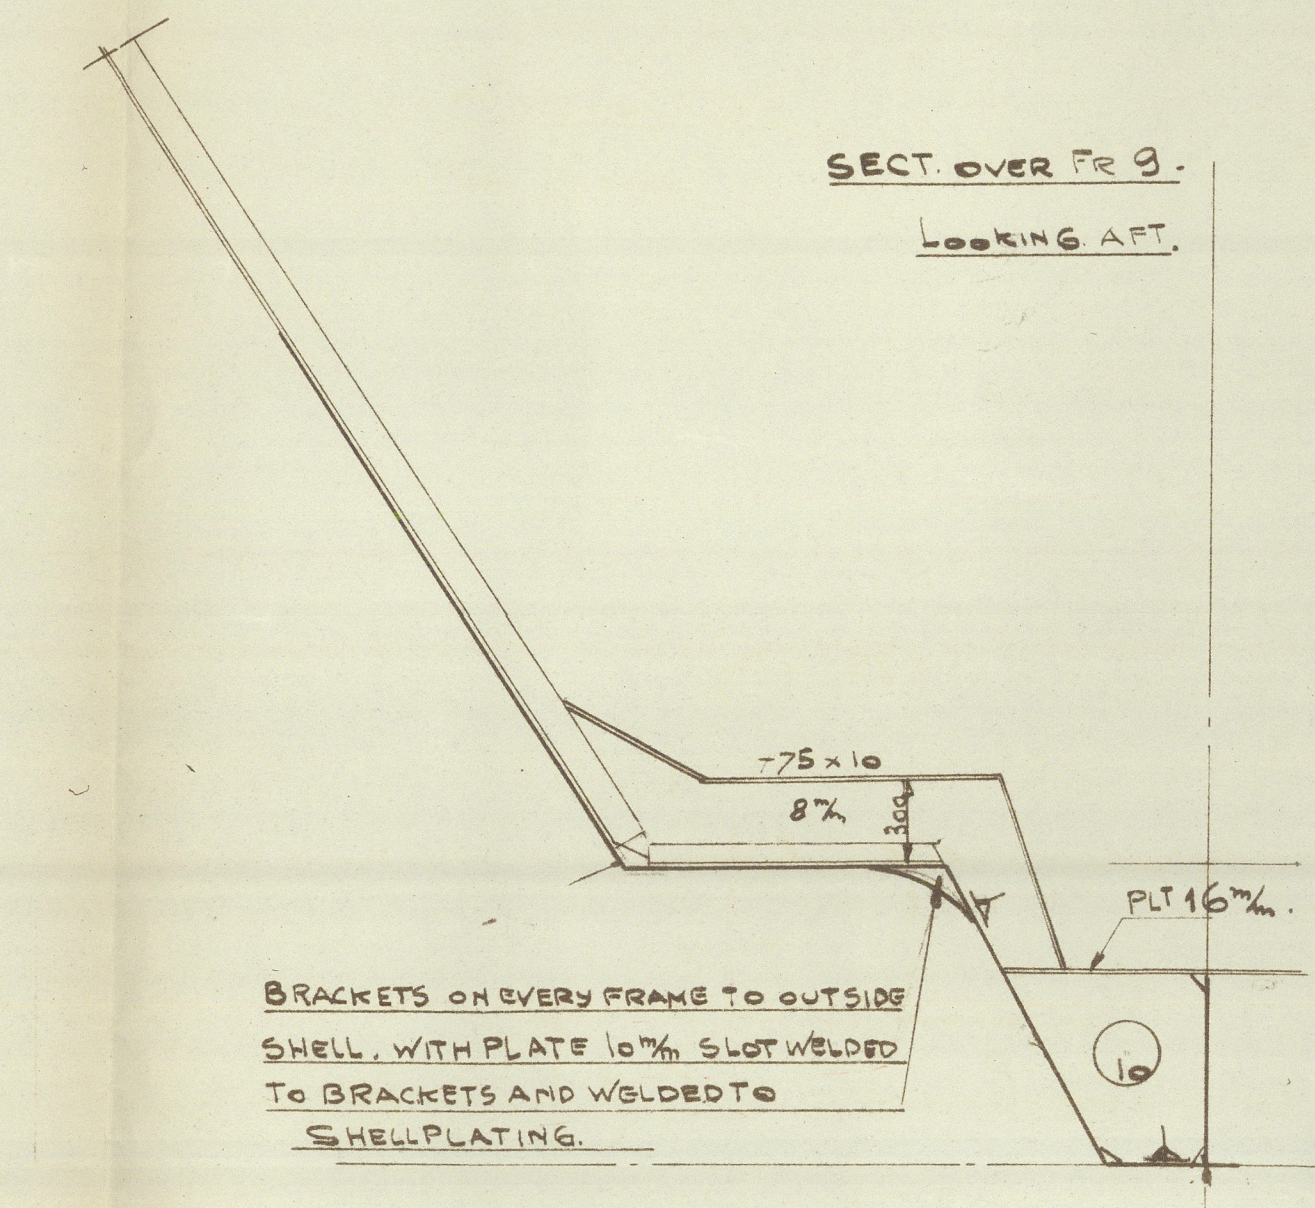
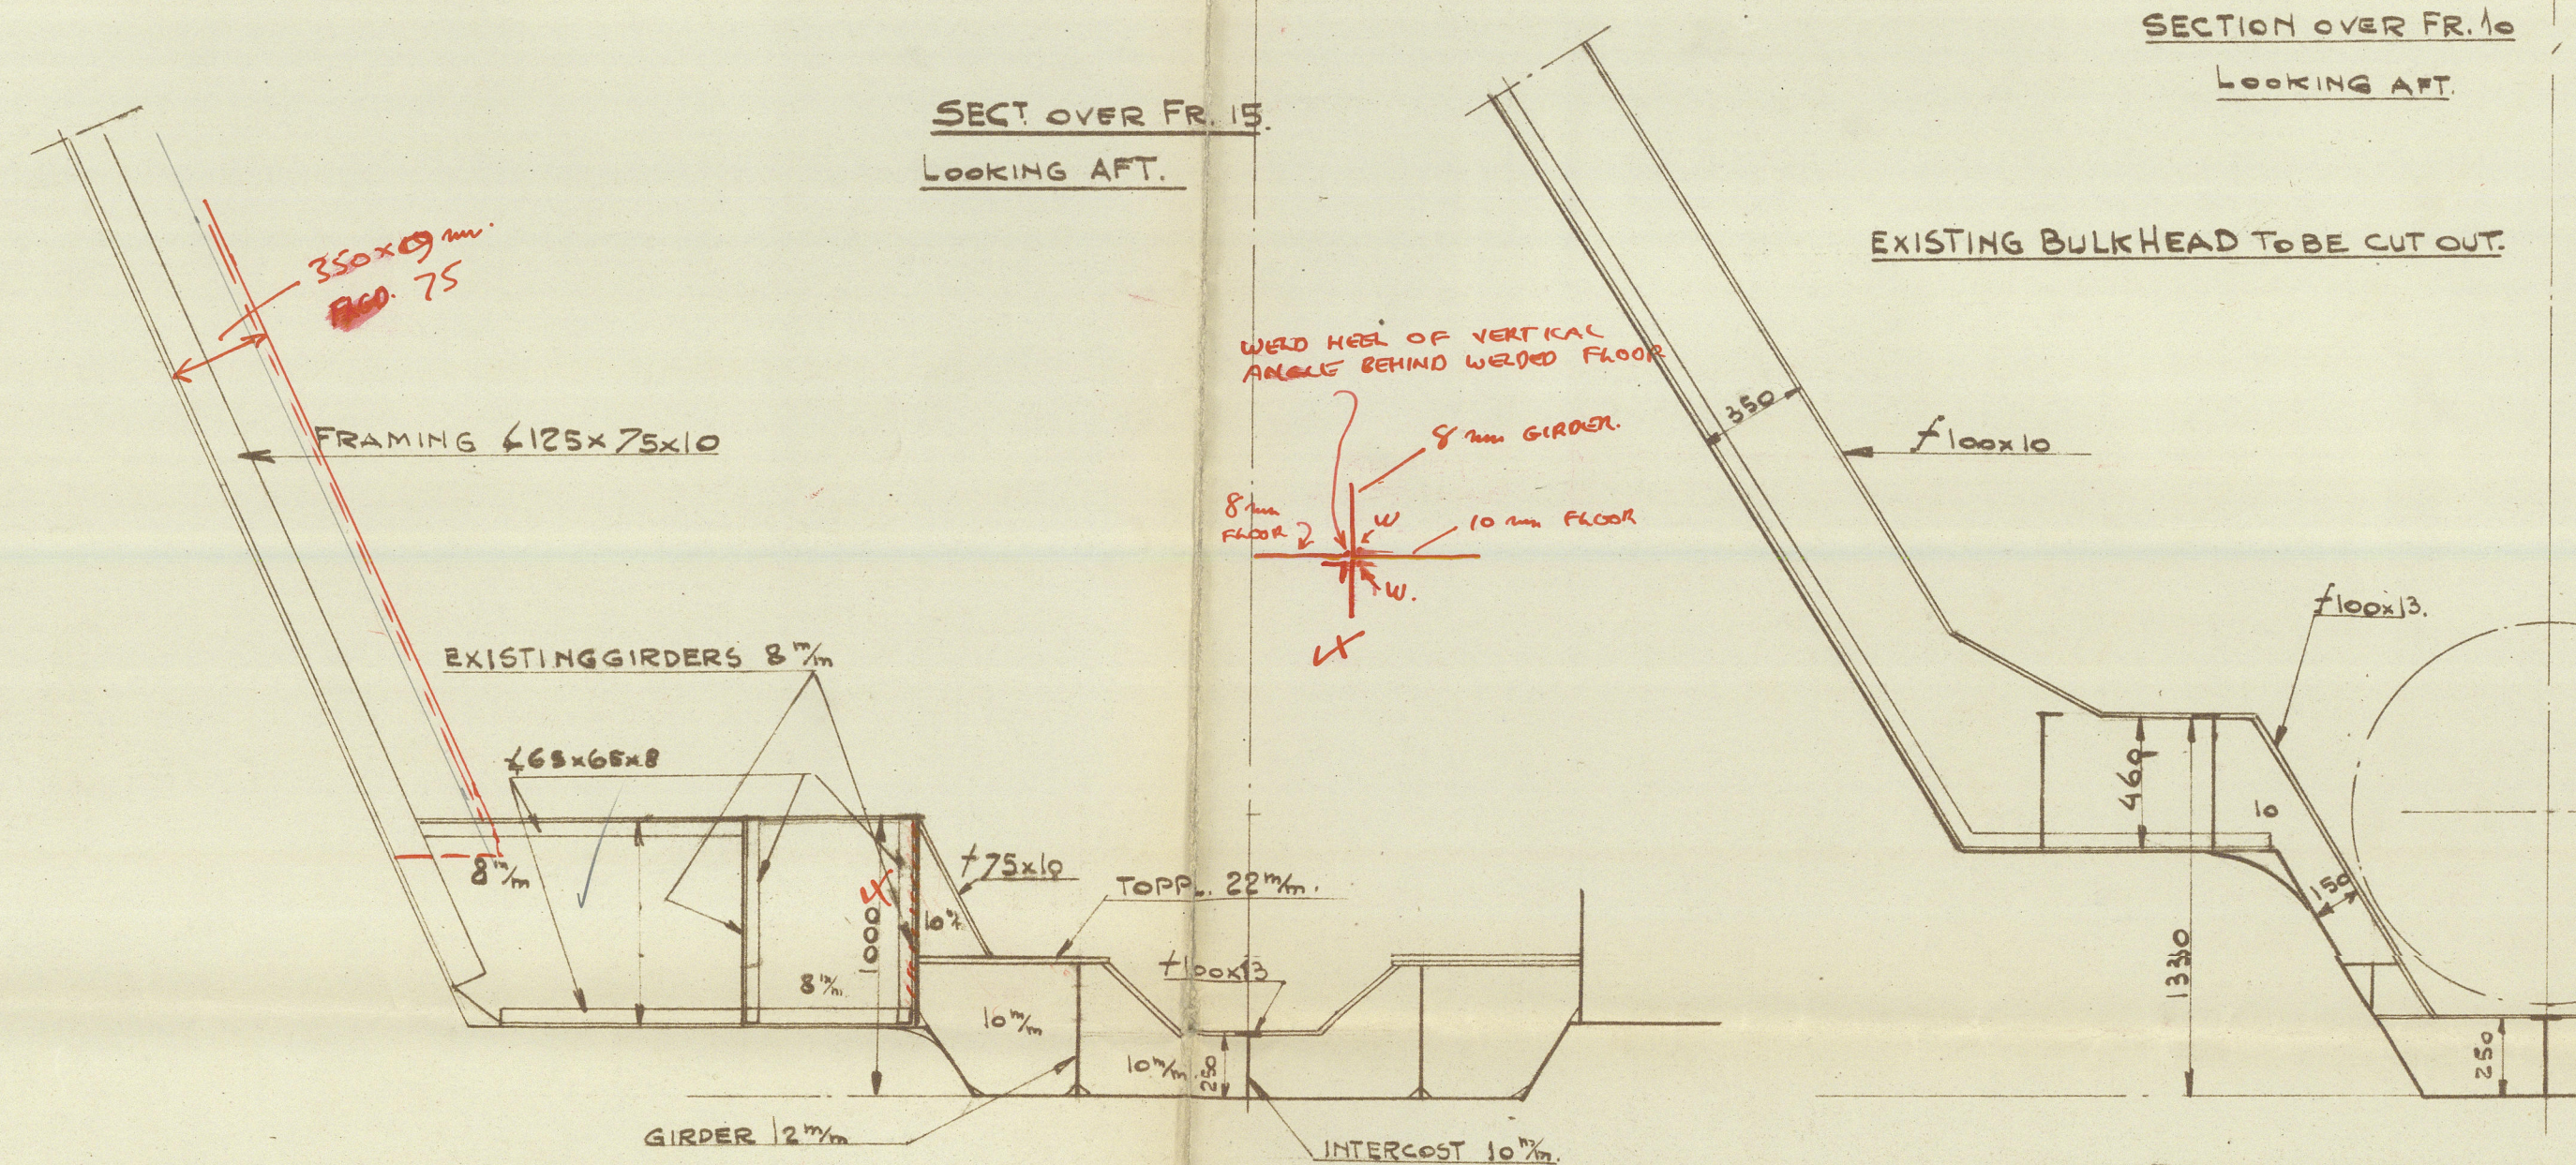
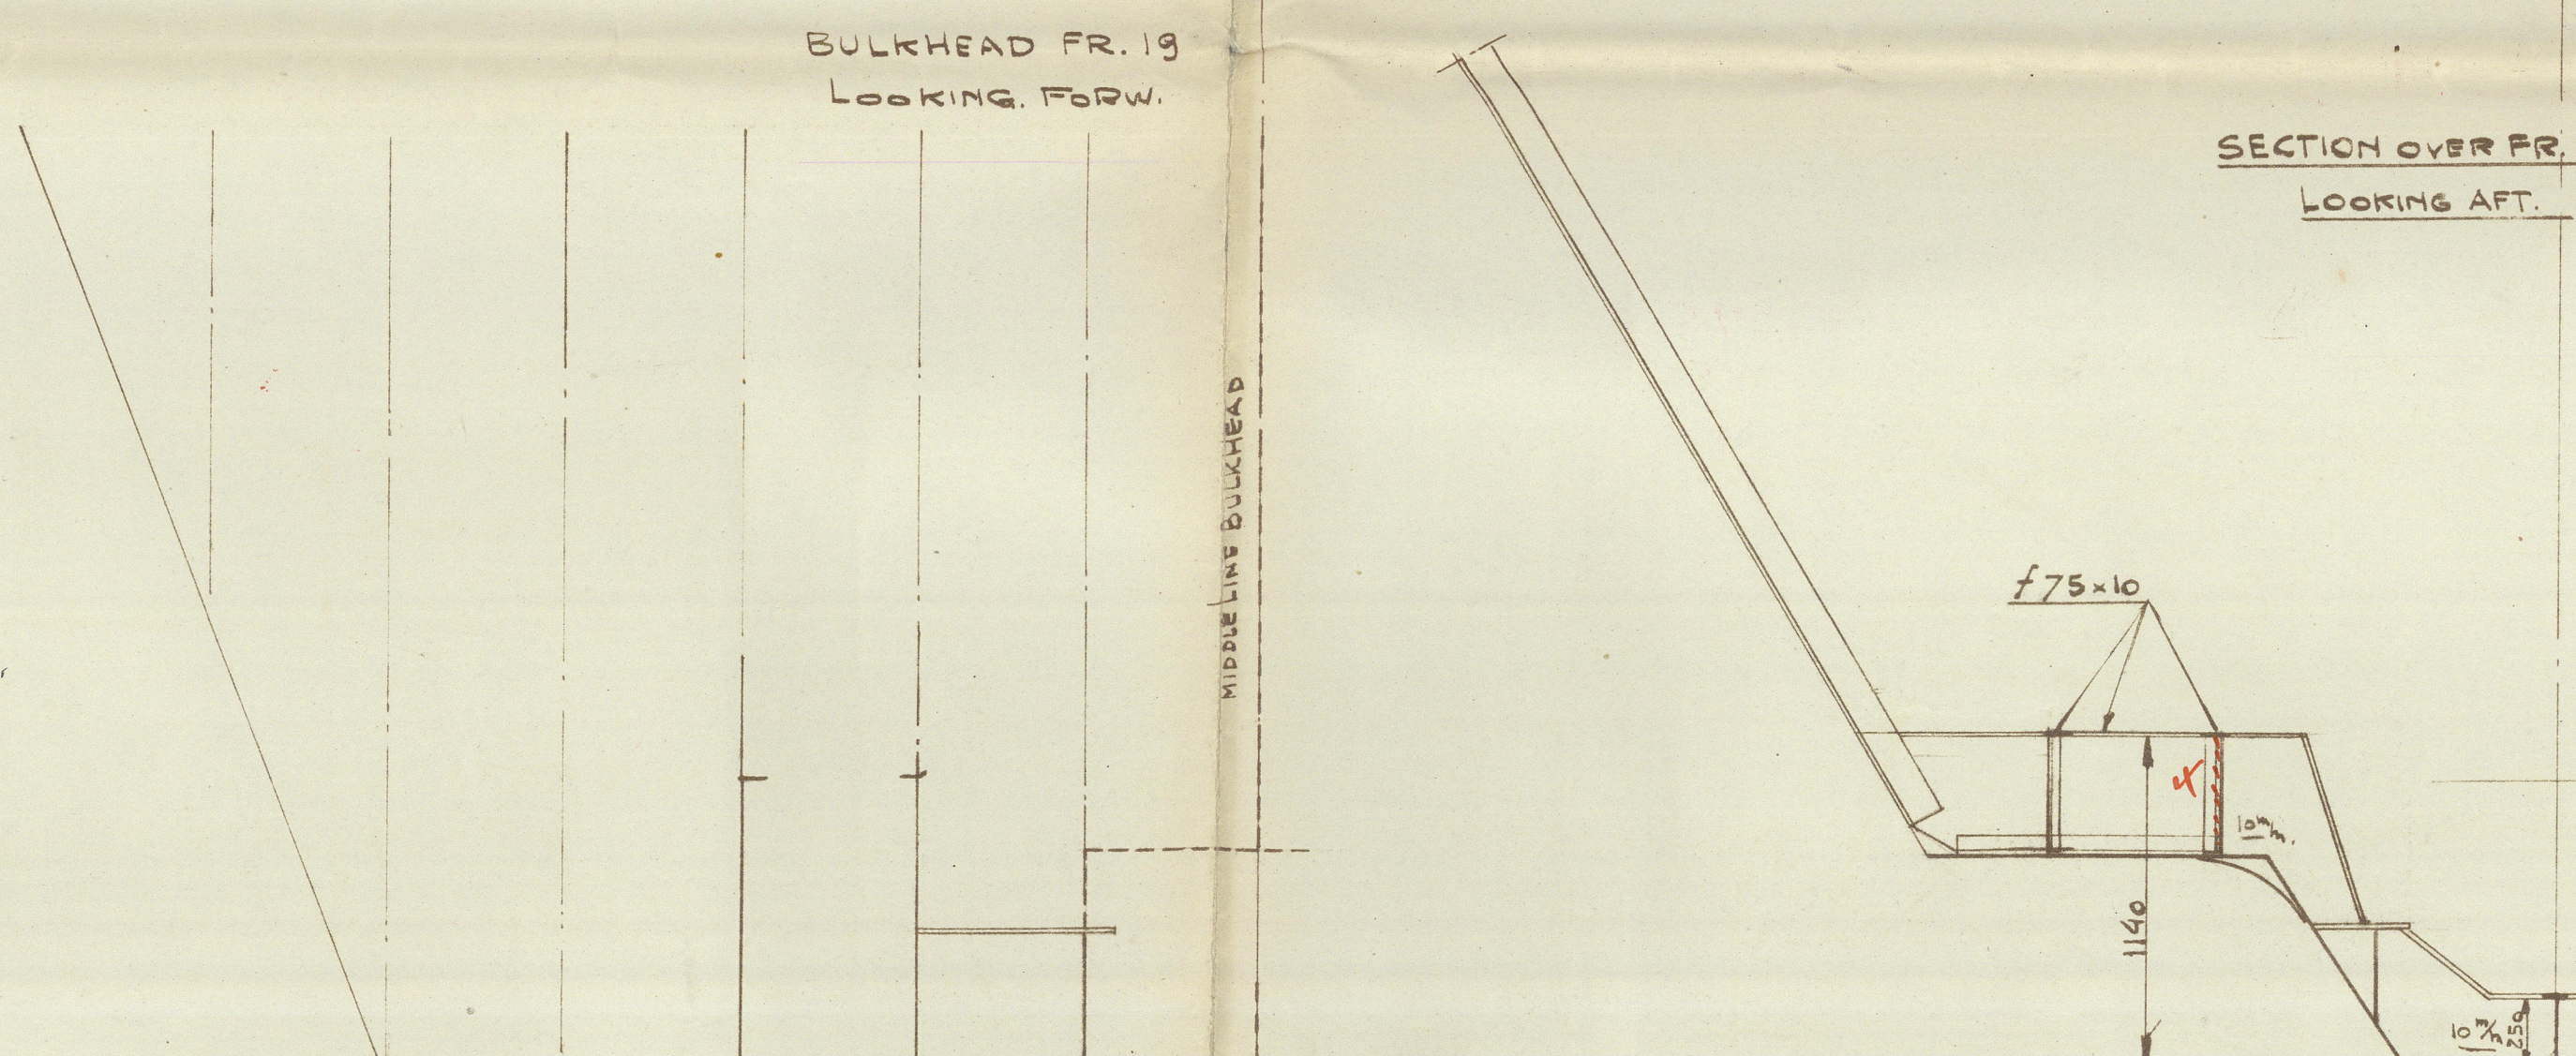
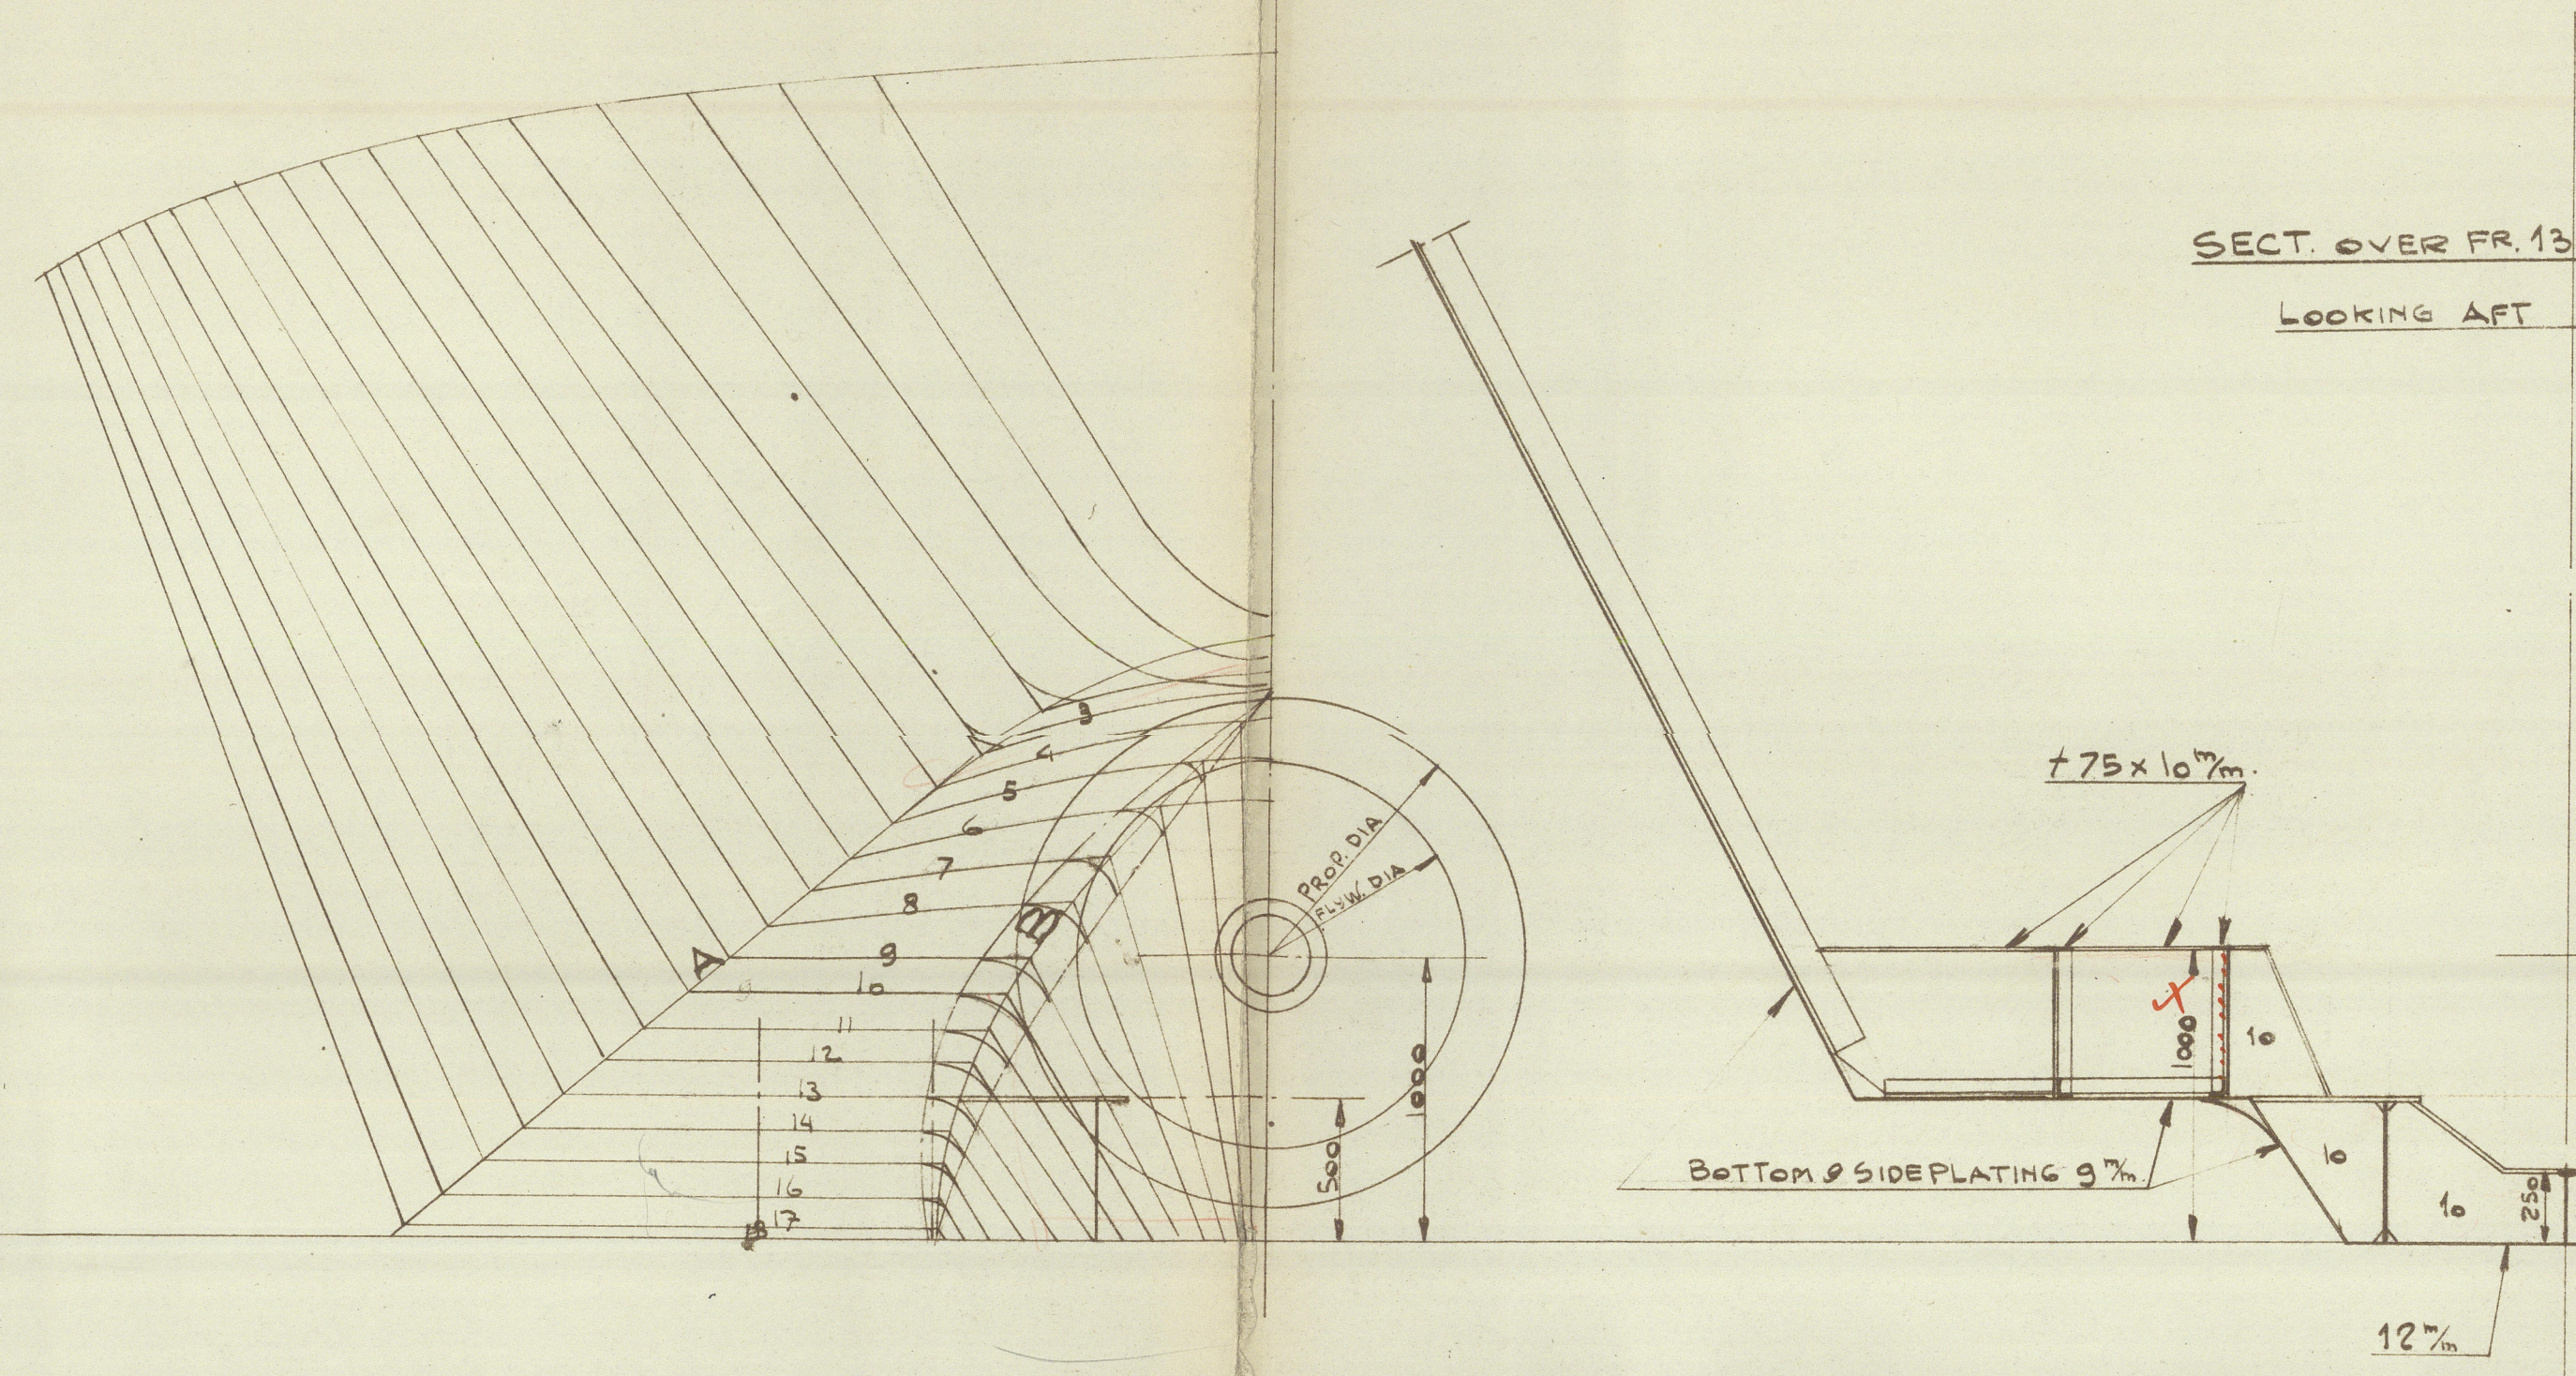


DETAIL CONNECTION TOPPLATE WITH FLOORS AND GIRDERS

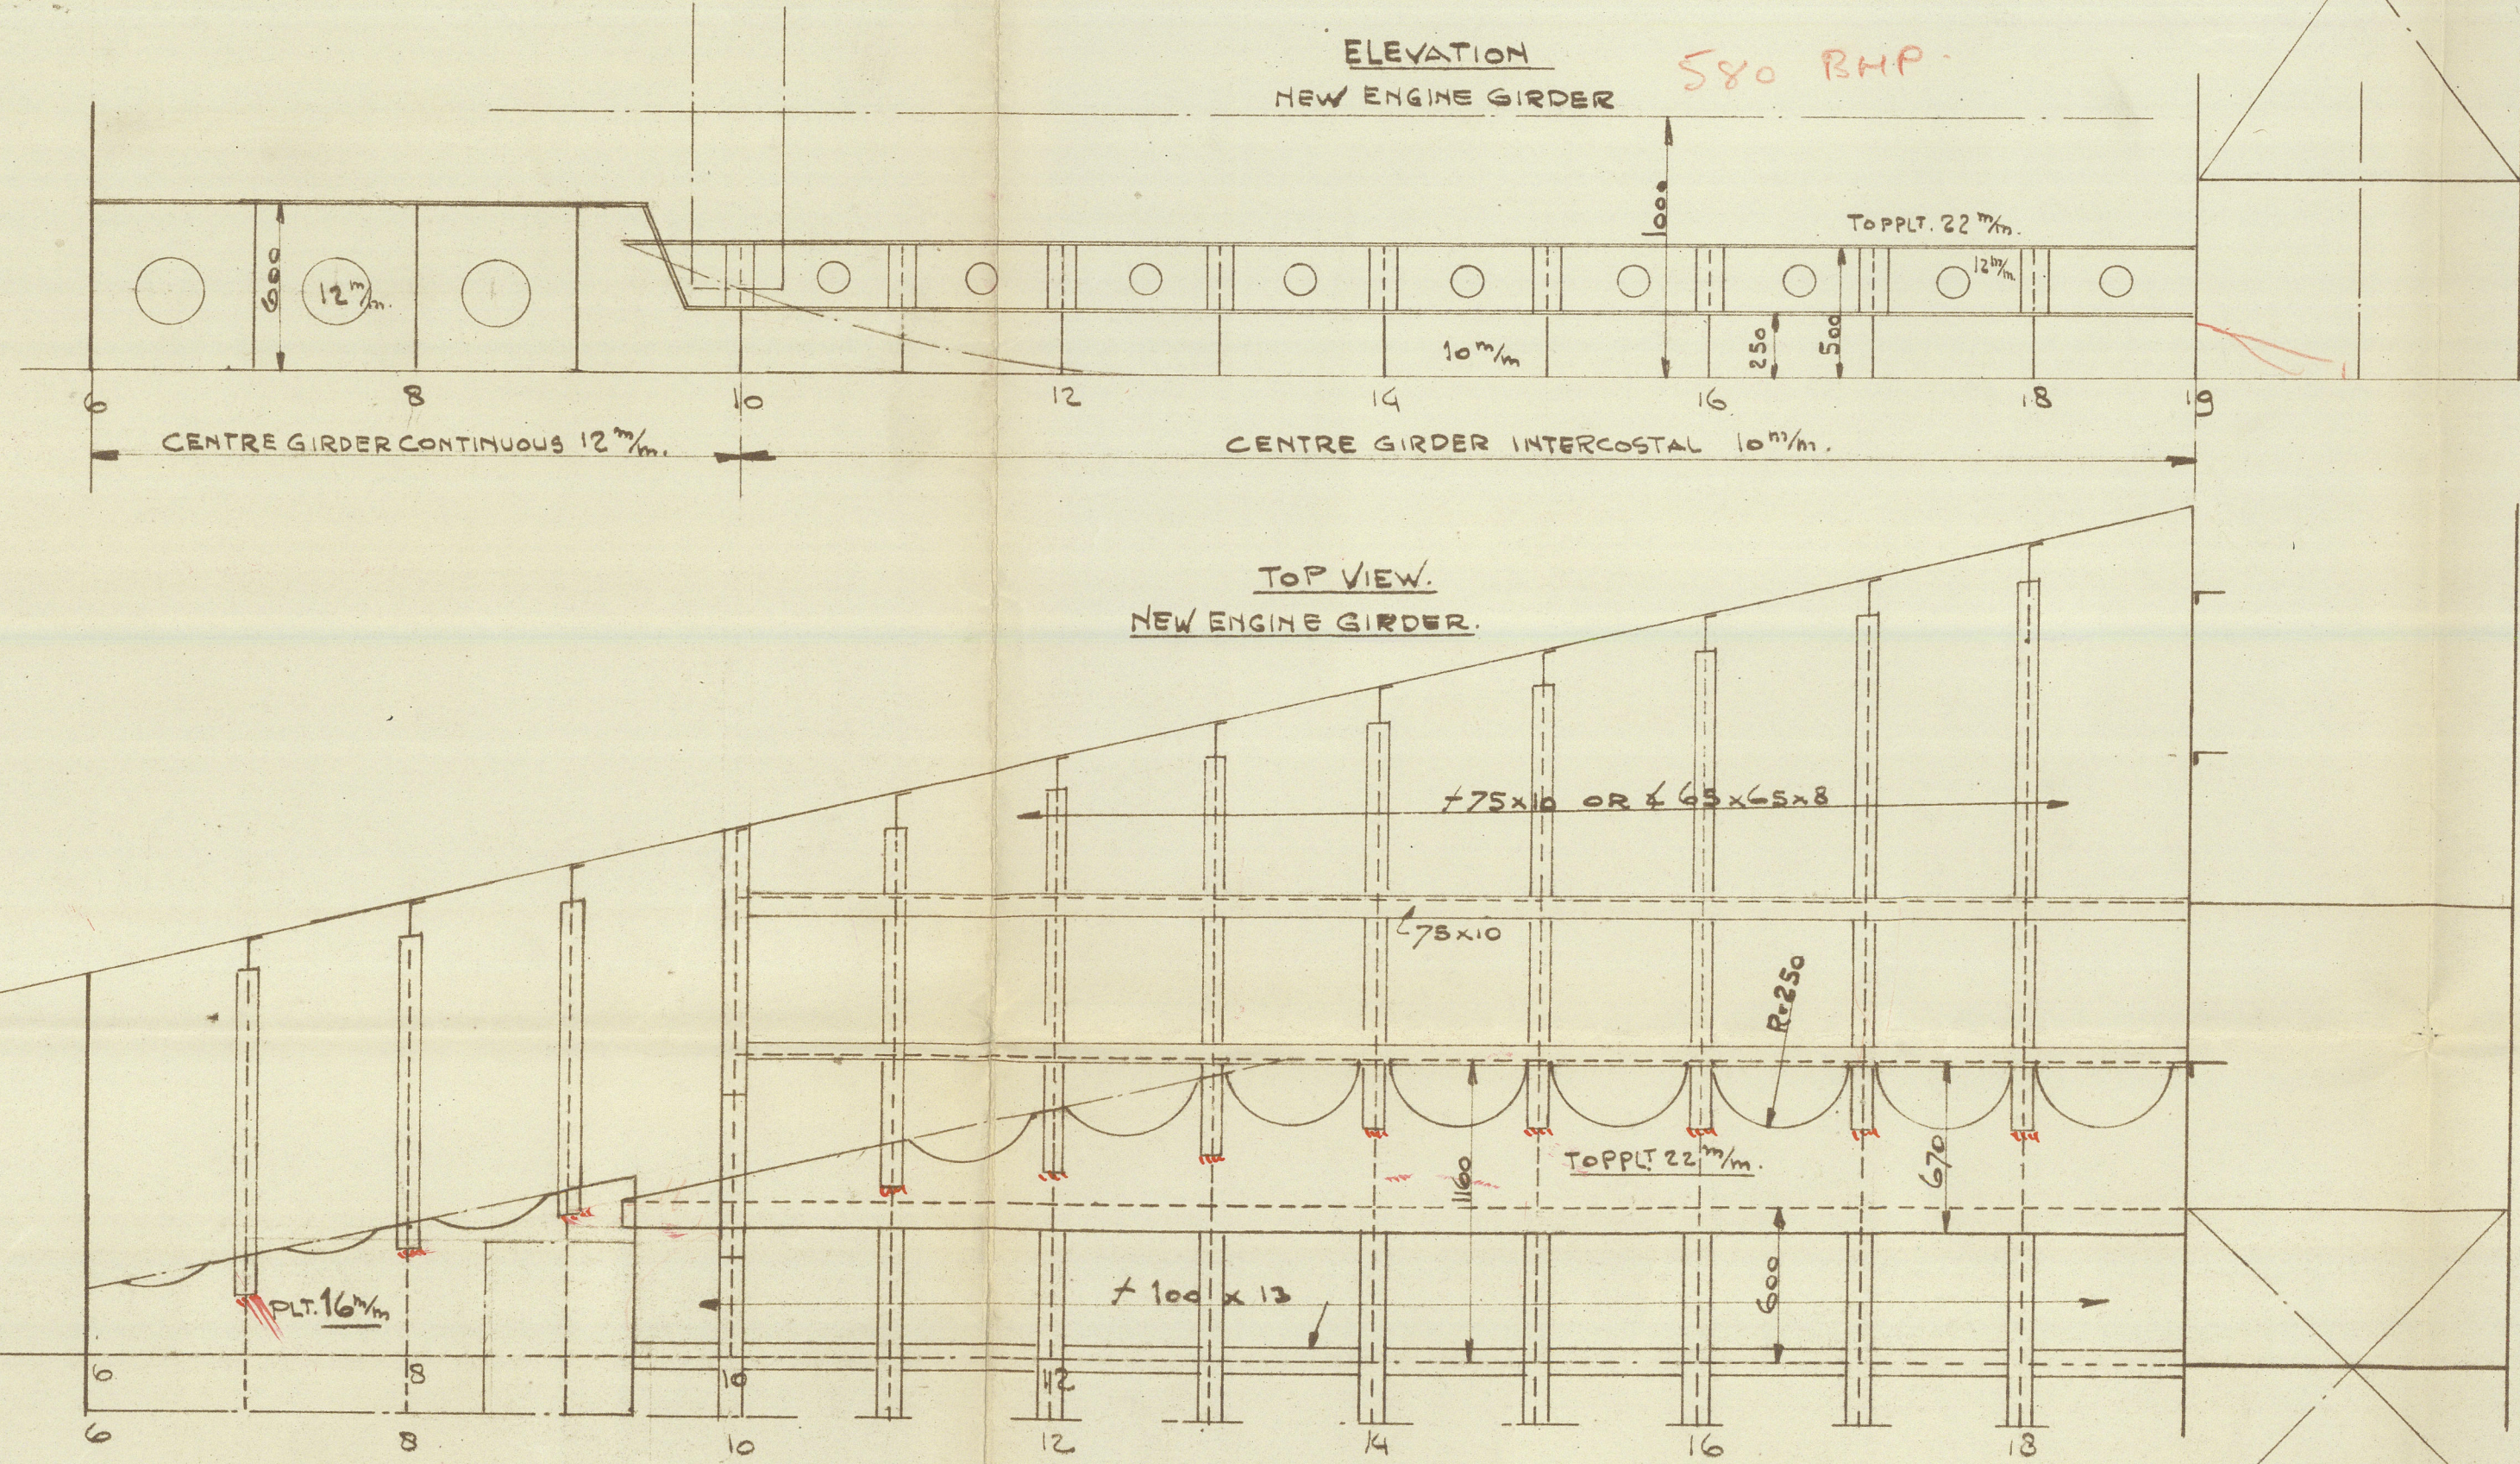

M/V ORCA	ORD. 772	SEA NO. 2
PROPOSAL ALTERATION	SCHAL 1:25	DATE 24/8/50
AFTERSHIP AND ARRANGEMENT	OF MOTOR FOUNDATION	BY 3.
	SCHREPSWELDER, DE VRIES, ZALTBOMMEL	

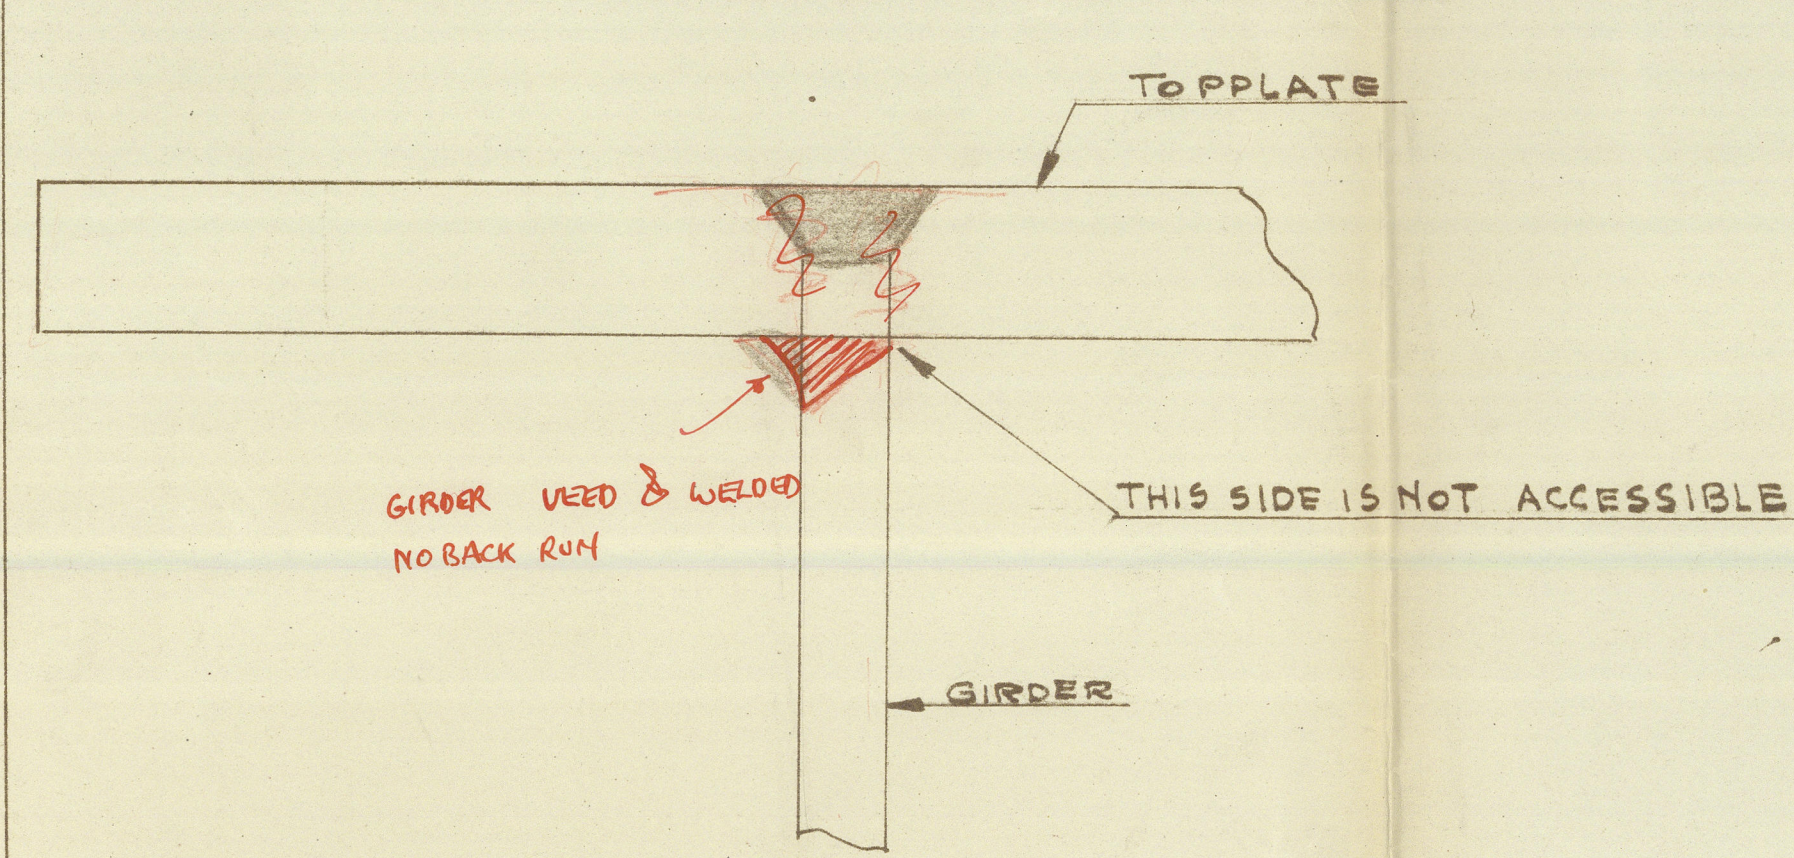

" Nigeria. "

Proposal alteration aftership  
+ arrangement of motor foundation.

Rot-rept-No. 33531.



© 2021

Lloyd's Register  
Foundation

010067-010078-0268