

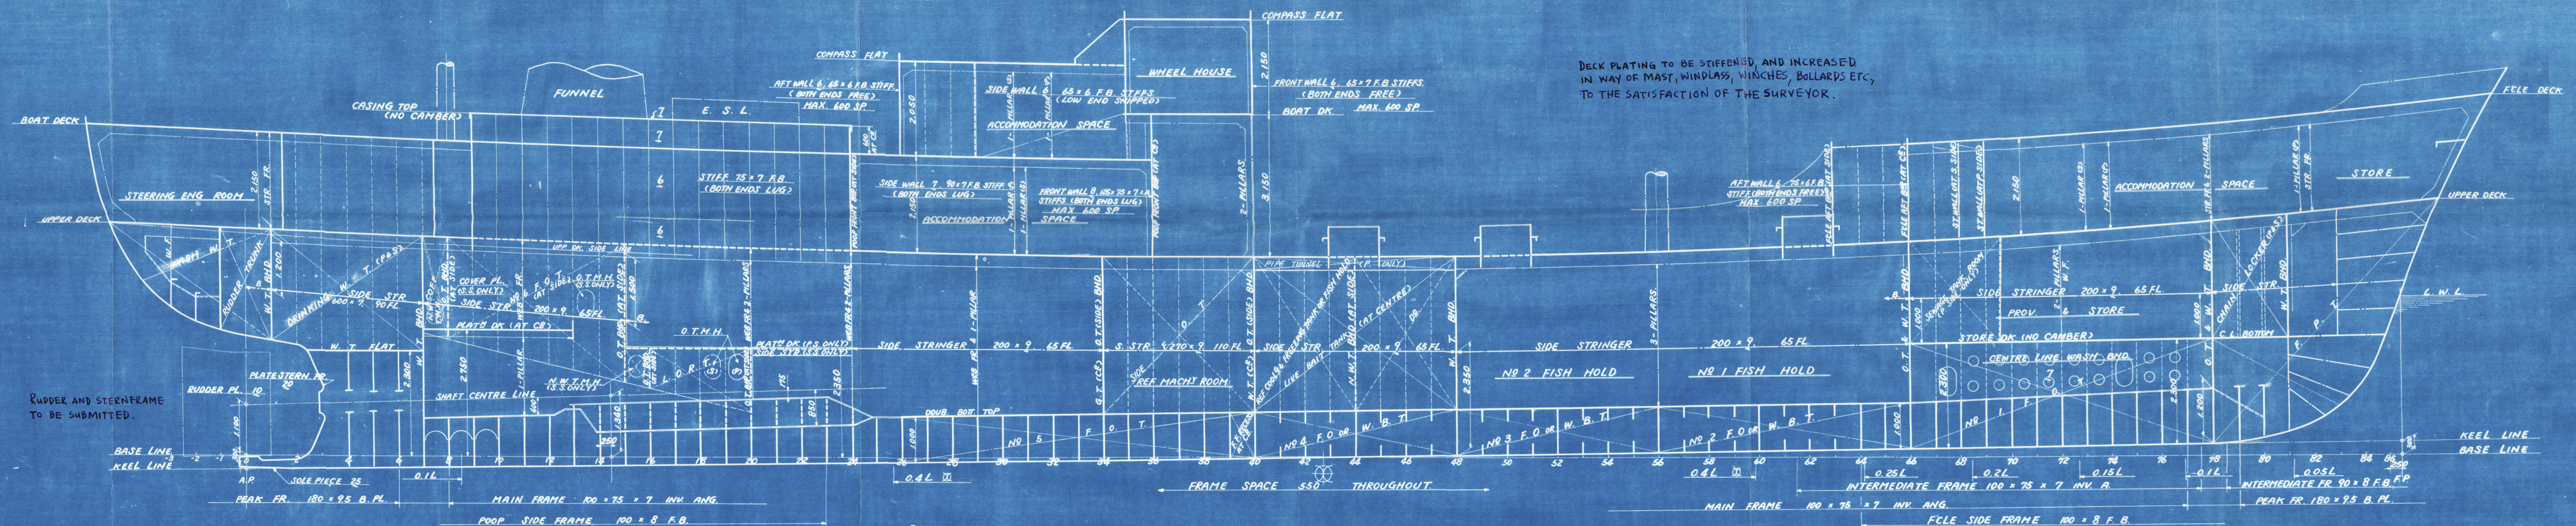
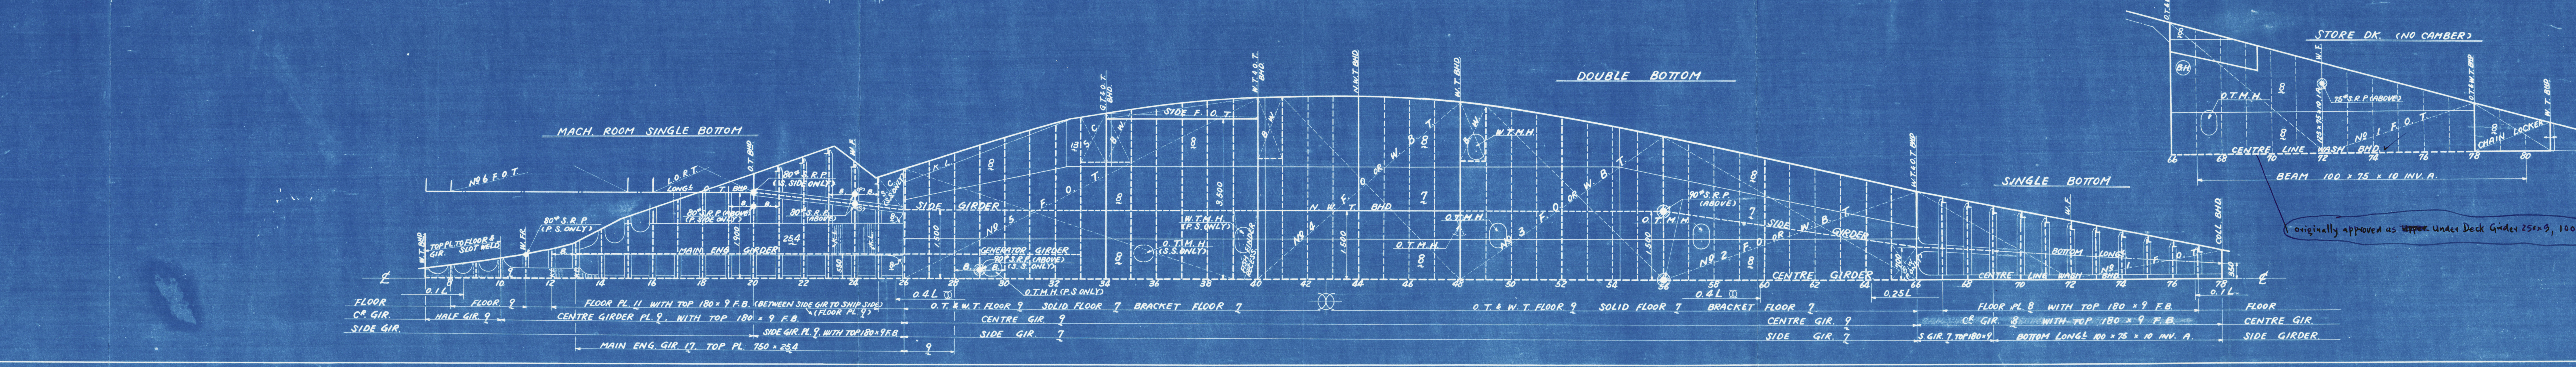


NOTE				
APR 11th 1959	FINISHED PLAN	MANUENS	DATE	REMARK

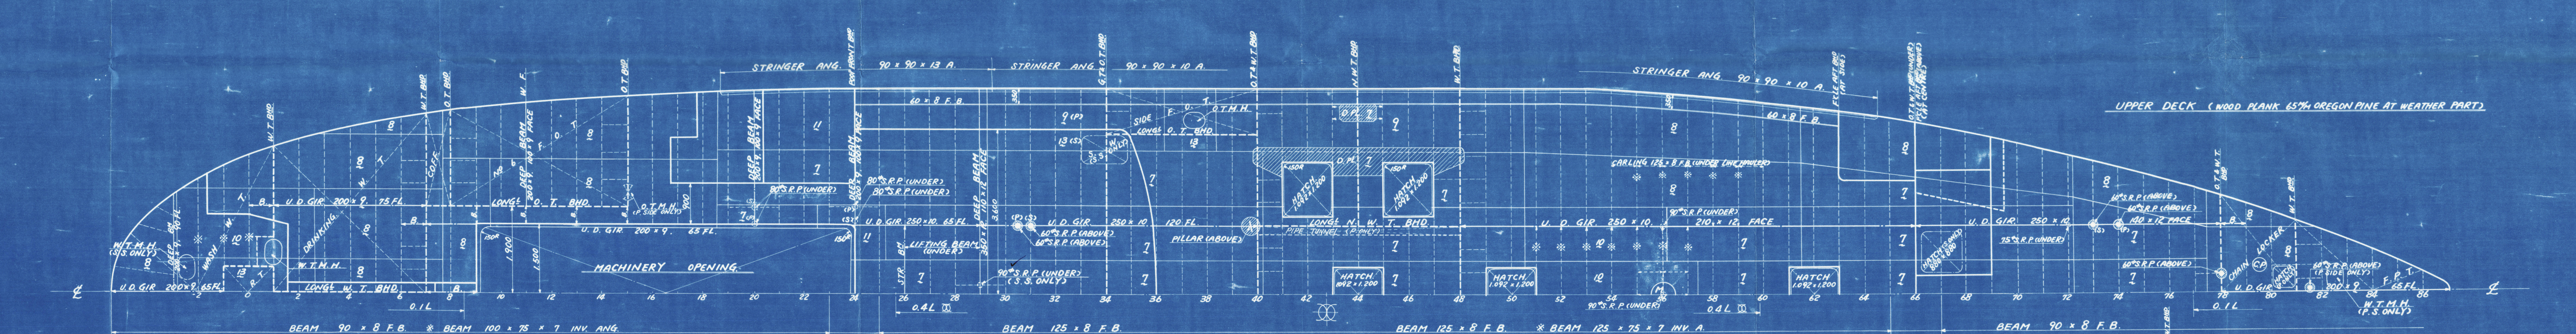

CLASS	
LLOYD'S REGISTER OF SHIPPING * 100 A 1	
FISHING VESSEL	
STRENGTHENED FOR NAVIGATION IN ICE CLASS	
PRINCIPAL DIMENSIONS	
LENGTH B.P.	47'00 (15.2420)
BREADTH MOULDED	9'00 (2.7432)
DEPTH MOULDED	4'20 (1.2802)
DESIGN DRAUGHT MOULDED	3'47 (1.1187)
SCANTLING DRAUGHT MOULDED	3'50 (1.1280)

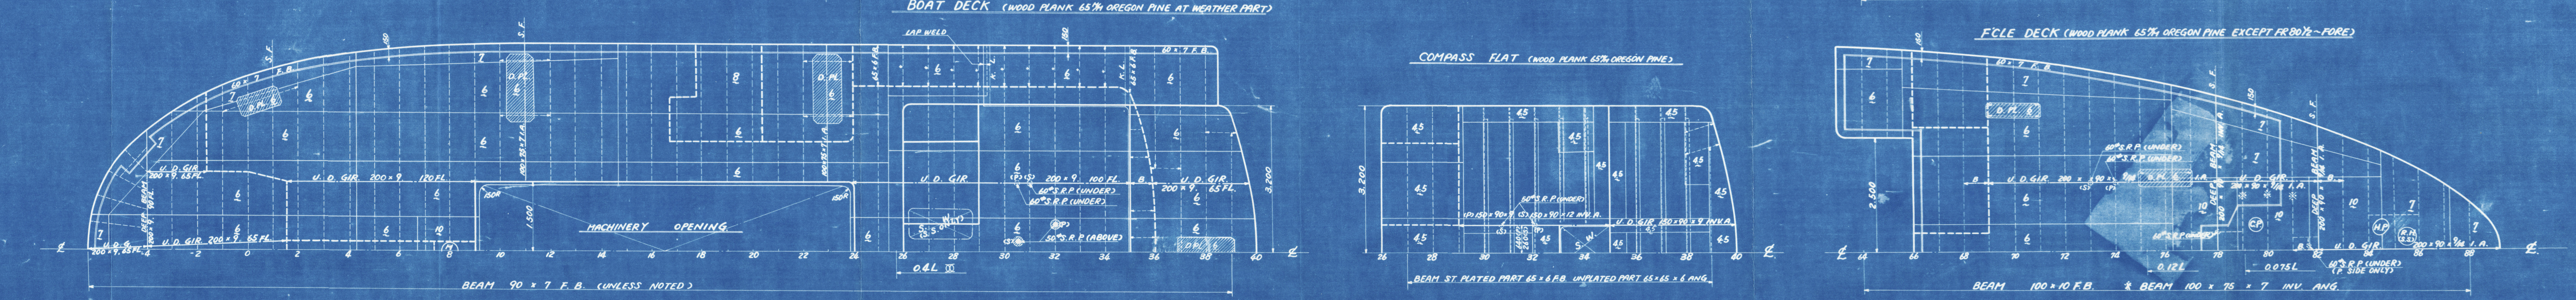


Note: Items marked in ink on this as fitted arising are as indicated in the original approved Plan.


CERTIFIED COPY OF APPROVED PLAN
PLACE OF APPROVAL KOBÉ DATE 27/10/58.
CERTIFIED BY W.M. Hensel DATE 9/6/59.

M.V. "DNESTR"				
NAME OF PART	MATERIAL	WEIGHT	REMARK	
CONSTRUCTION PROFILE & PLANS				
SCALE 1/50				
HITACHI SHIPBUILDING & ENGINEERING CO. LTD. MUKAISHIMA SHIPYARD DESIGNING SECTION				
DRAWN BY J. Oishi				
CHECKED BY M. Taniyama				
REVIEWED BY N. Kurokawa				
CHIEF OF SECTION				
DATE APR. 11th 59				
SHEET NO. FINAL-12				
DRAWING NO. 000181				

RECORDS DEPT.
LONDON.

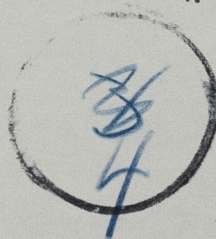

Kobe Rpt. No.	FE 6518
Port of Survey.	MUKAISHIMA
Name of Ship.	"DNESTR" ★
Title of Plan	CONSTRUCTION PROFILE & PLANS

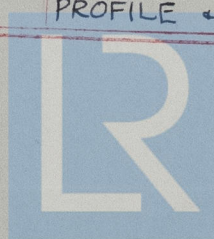

© 2021

Lloyd's Register
Foundation

010089-010095-0123