

NOTE			
DRAWN BY BUILDER	MANUF. NO.	NO. WANTED	DATE REMARK
APR. 7, 1959			

FINISHED PLAN

ДНЕСТР

1/2 "SUDDOIMPORT MOSCOW U.S.S.R.
 G.T. 500 TONS TUNA FISHING BOAT

**GENERAL ARRANGEMENT OF MACHINERIES
IN ENGINE & BOILER ROOM**

SCALE 1/25 **3/4**

HITACHI SHIPBUILDING & ENGINEERING CO. LTD
MUKAISHIMA SHIPYARD
DESIGNING SECTION

DATE APR. 7, 1959
 MANUF. NO.


DRAWN BY
 CHECKED BY *F. Matsushima*
 REVIEWED BY
 CHIEF OF SECT. *A. Yamaguchi*

SHEET NO. **010-3**

CODE NO. **201001**

DRAWING NO. **210281**

RECORDS DEPT.
LONDON.

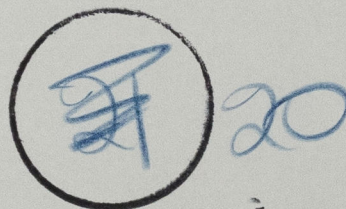

Kobe Rpt. No.	FE 6518
Port of Survey.	MUKAISHIMA
Name of Ship.	"DNESTR"
Title of Plan.	ARR. IN ENG. ROOM 3/4.



© 2021

Lloyd's Register
Foundation

010089-010095-0127

