












R.A.S.C.V. OXNA.

AFT DECKHOUSE & BOAT DECK PLATING.











SCALE:- 1/4" = ONE FOOT
E- AS MARKED.

NOTE:- BEAMS & SUPPORTS 3"x3"x3/8" O.A.
BEAMS & SUPPORTS TO BE:-
5"x3"x3/8" B.A. WHERE MARKED *

DETAILS OF BOAT DECK.

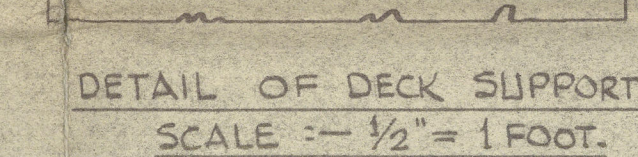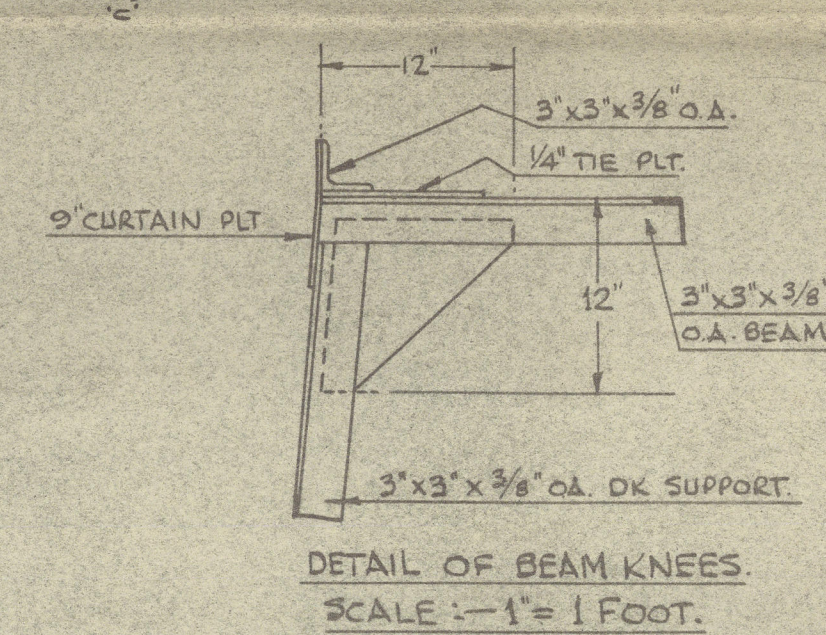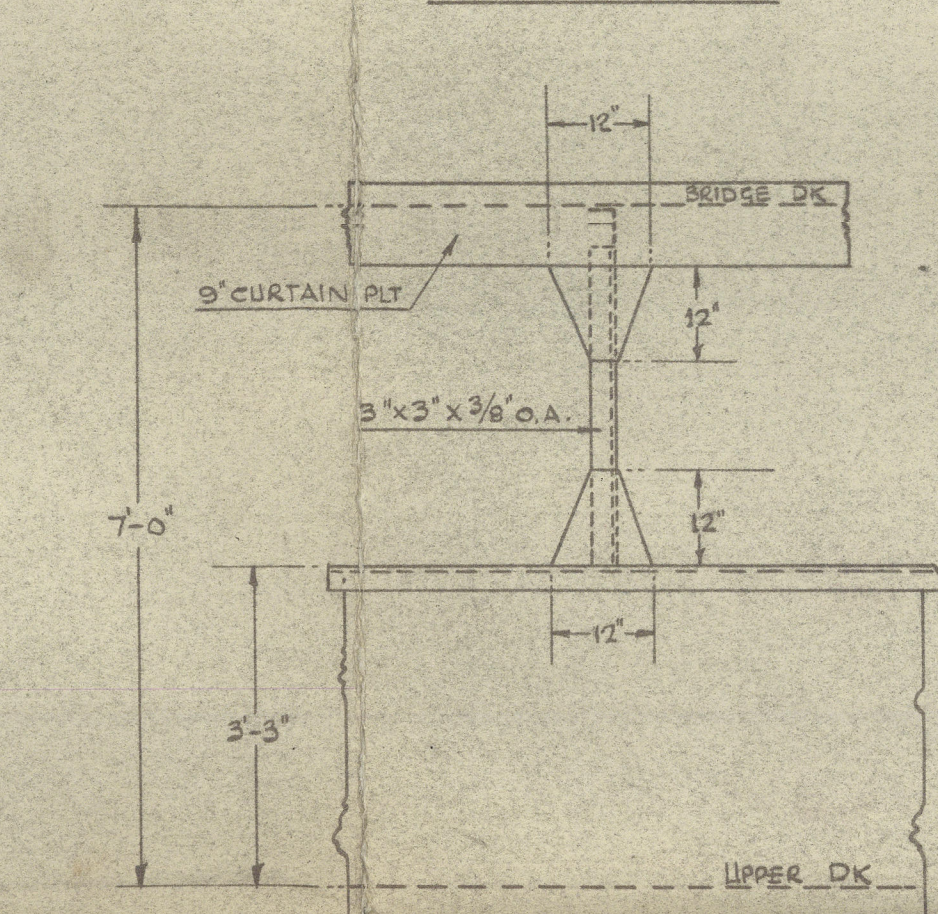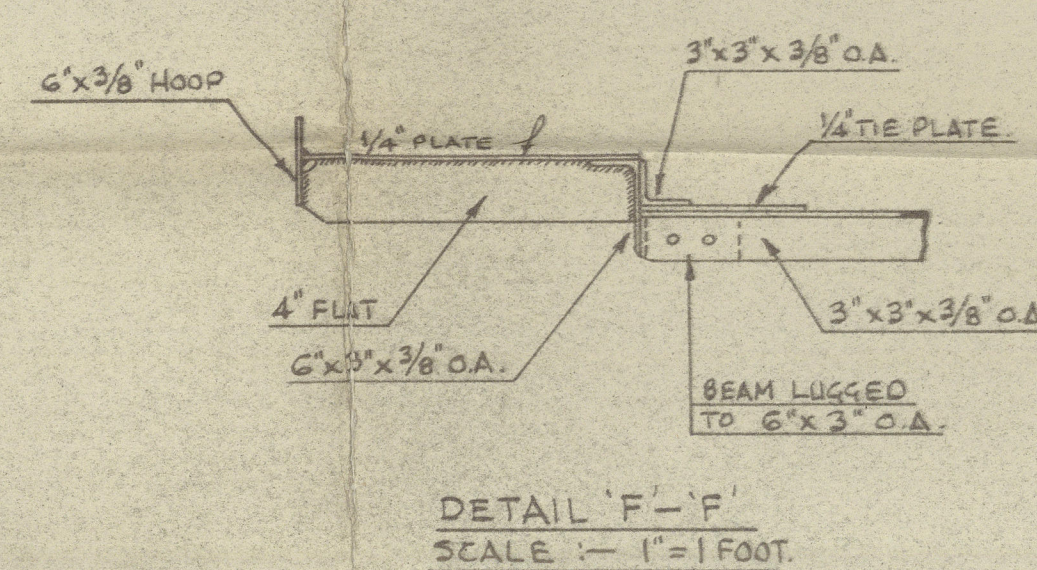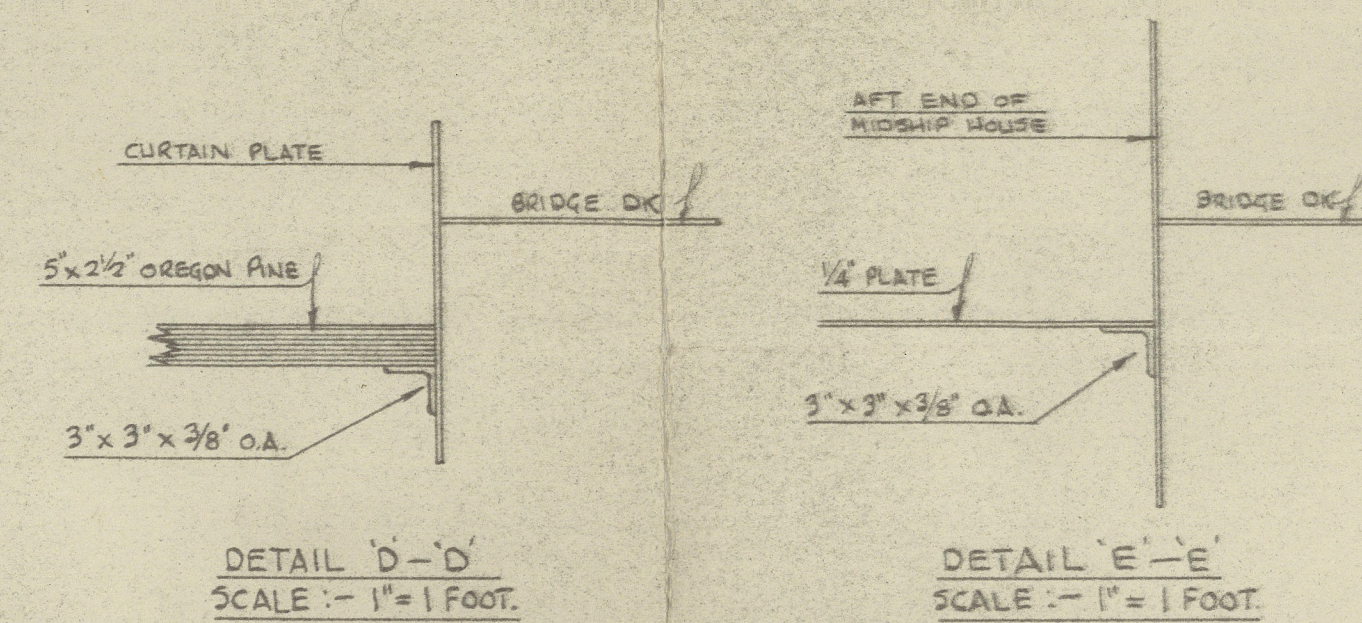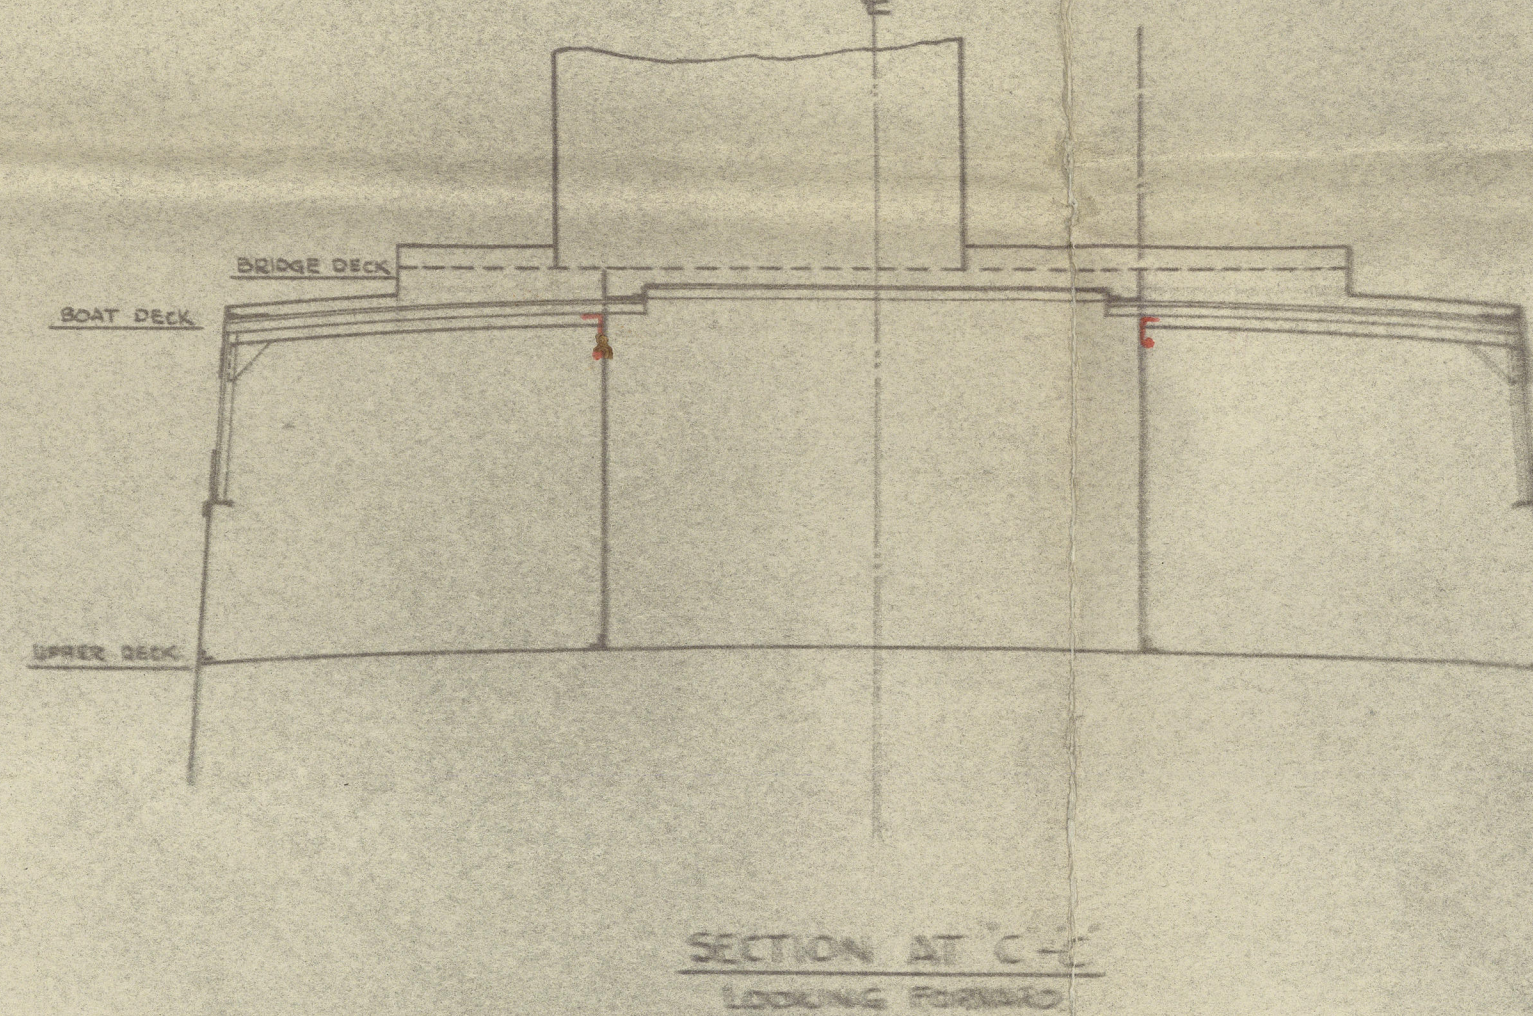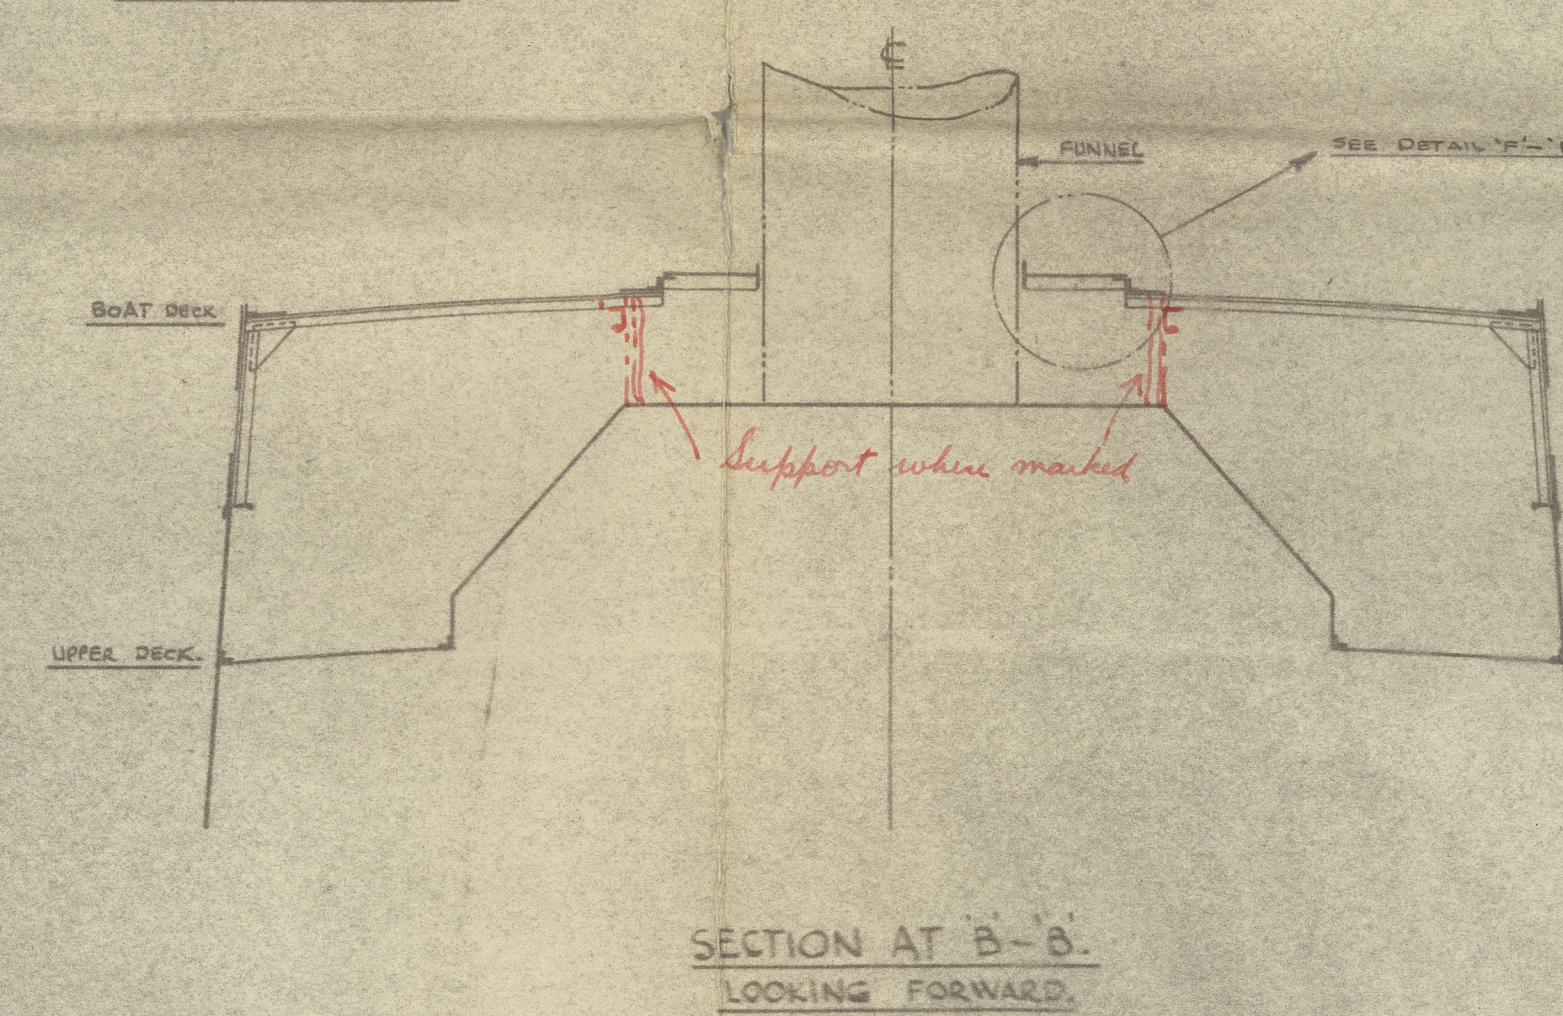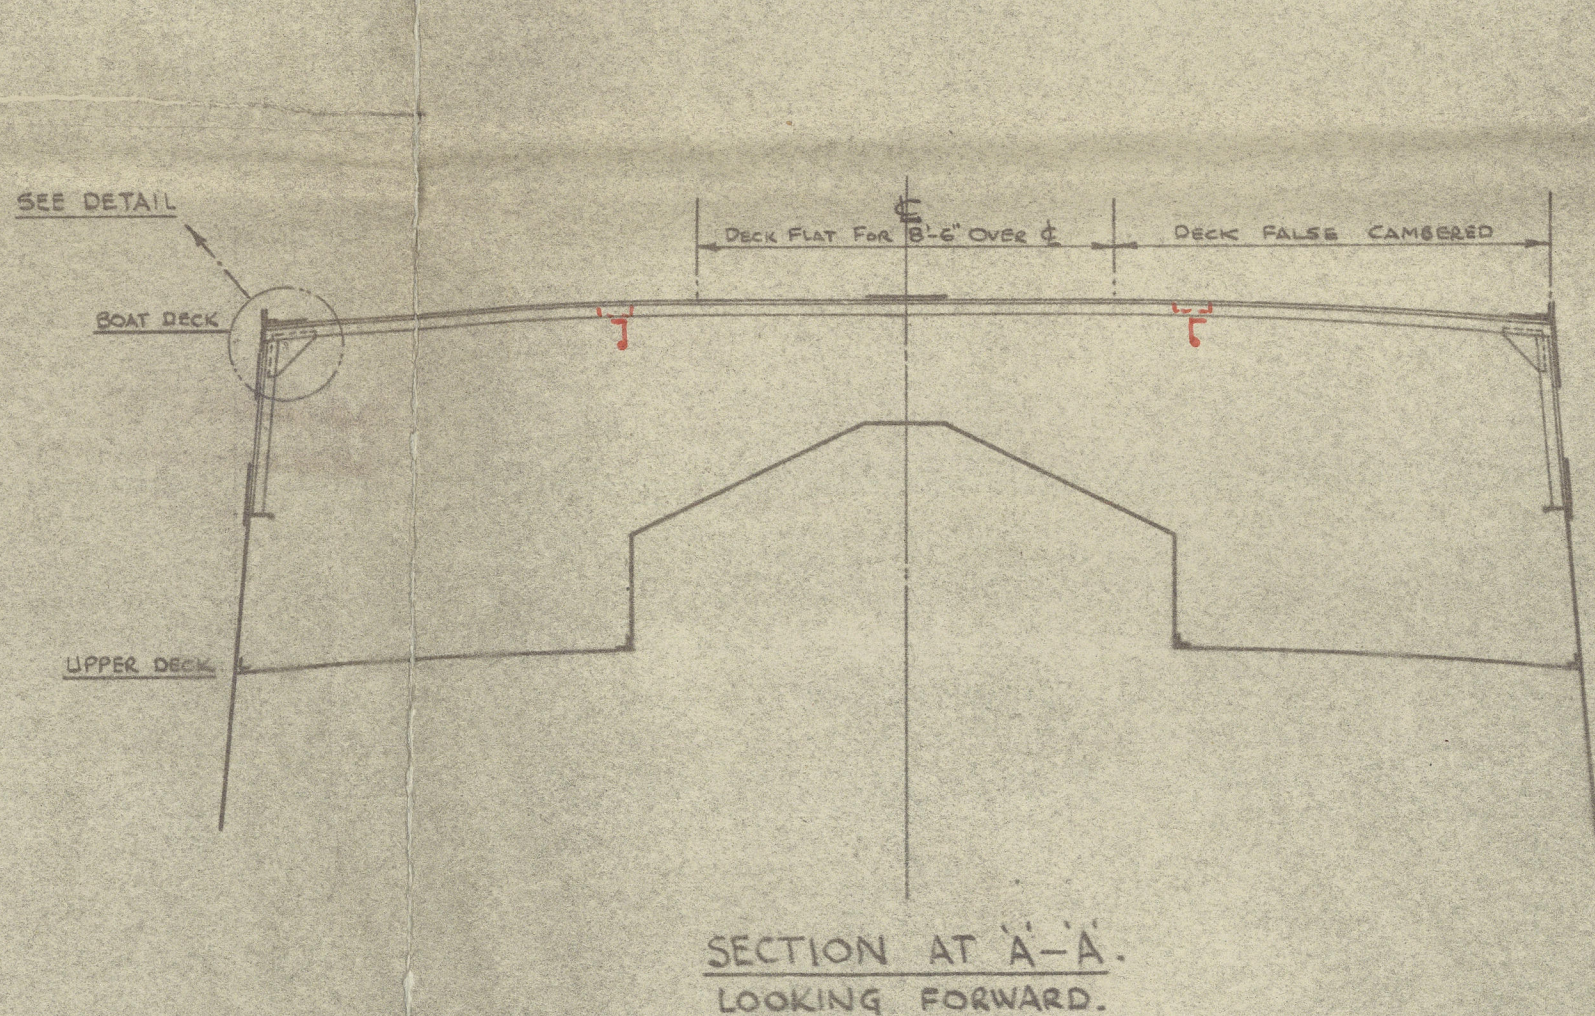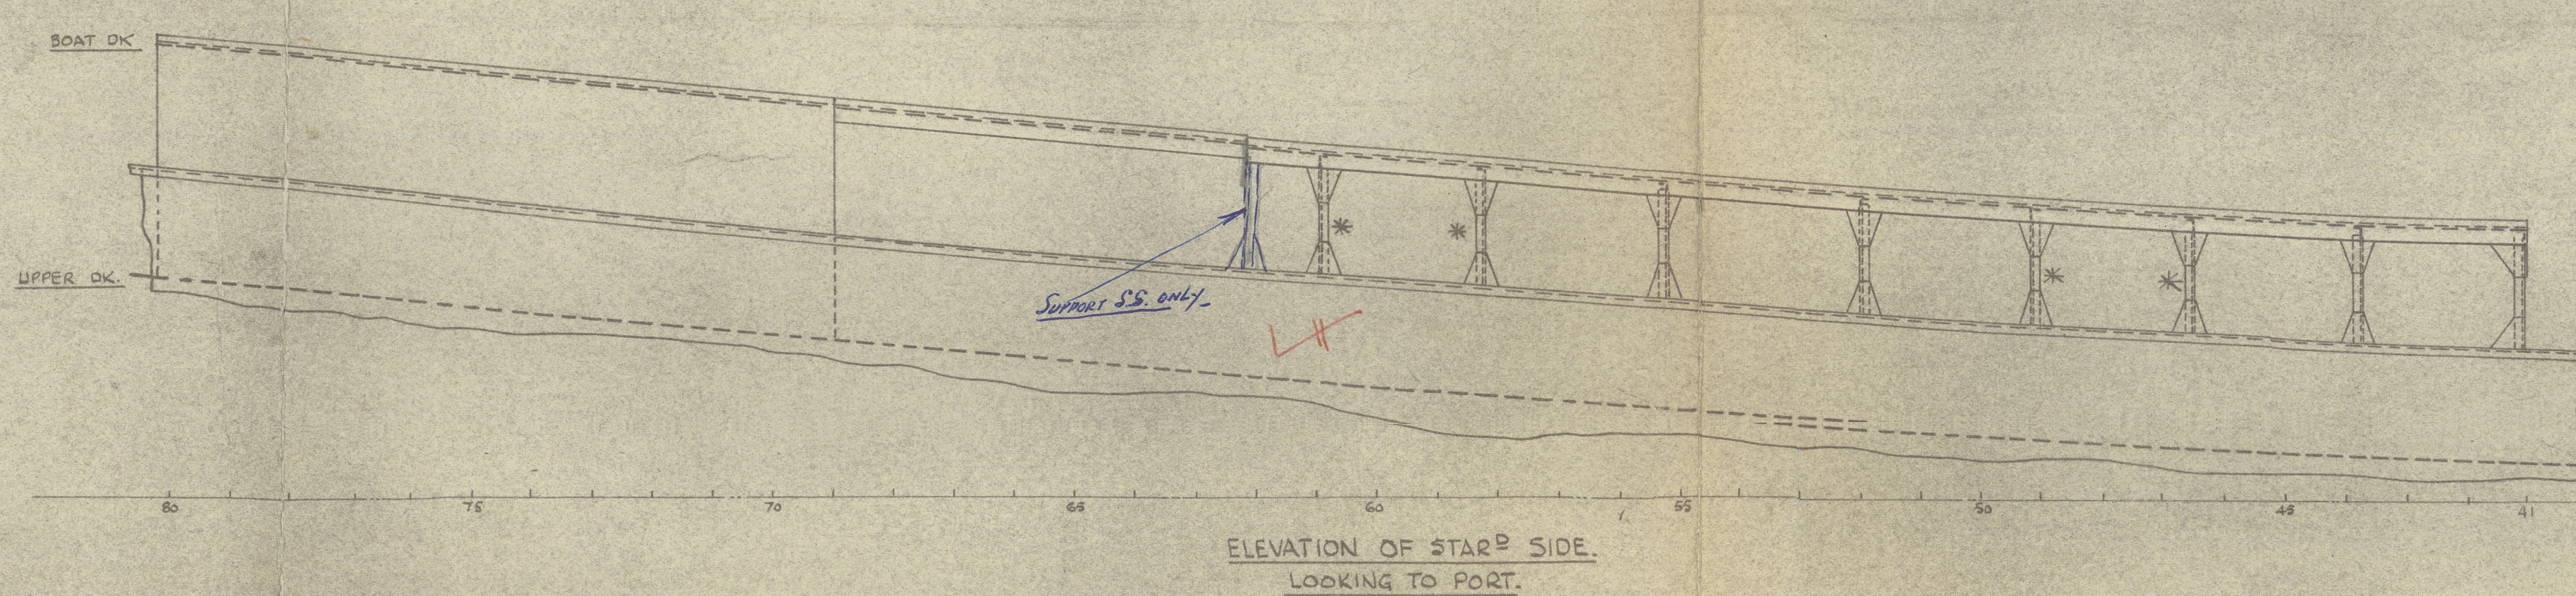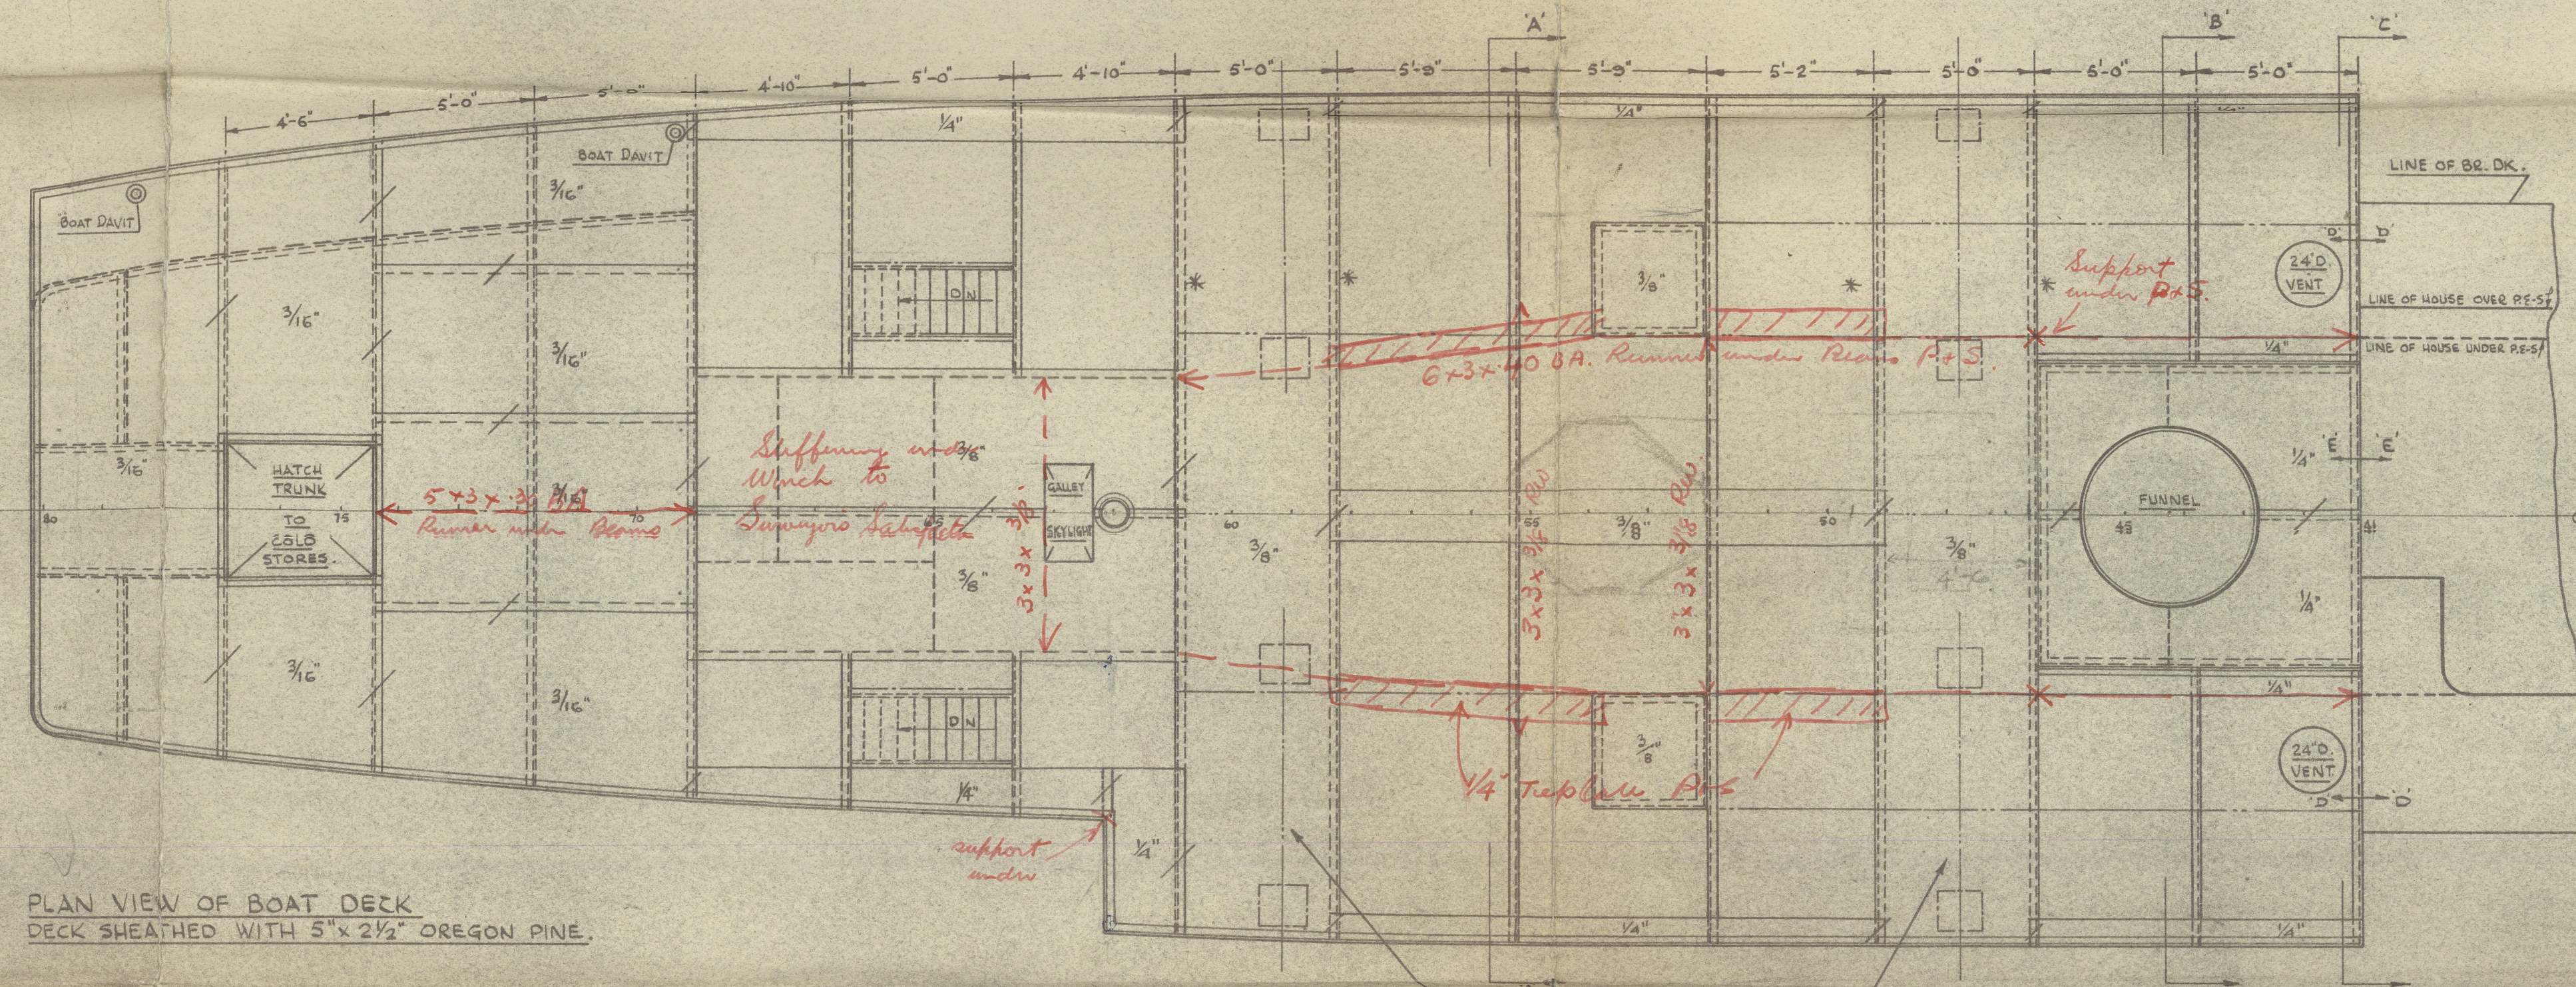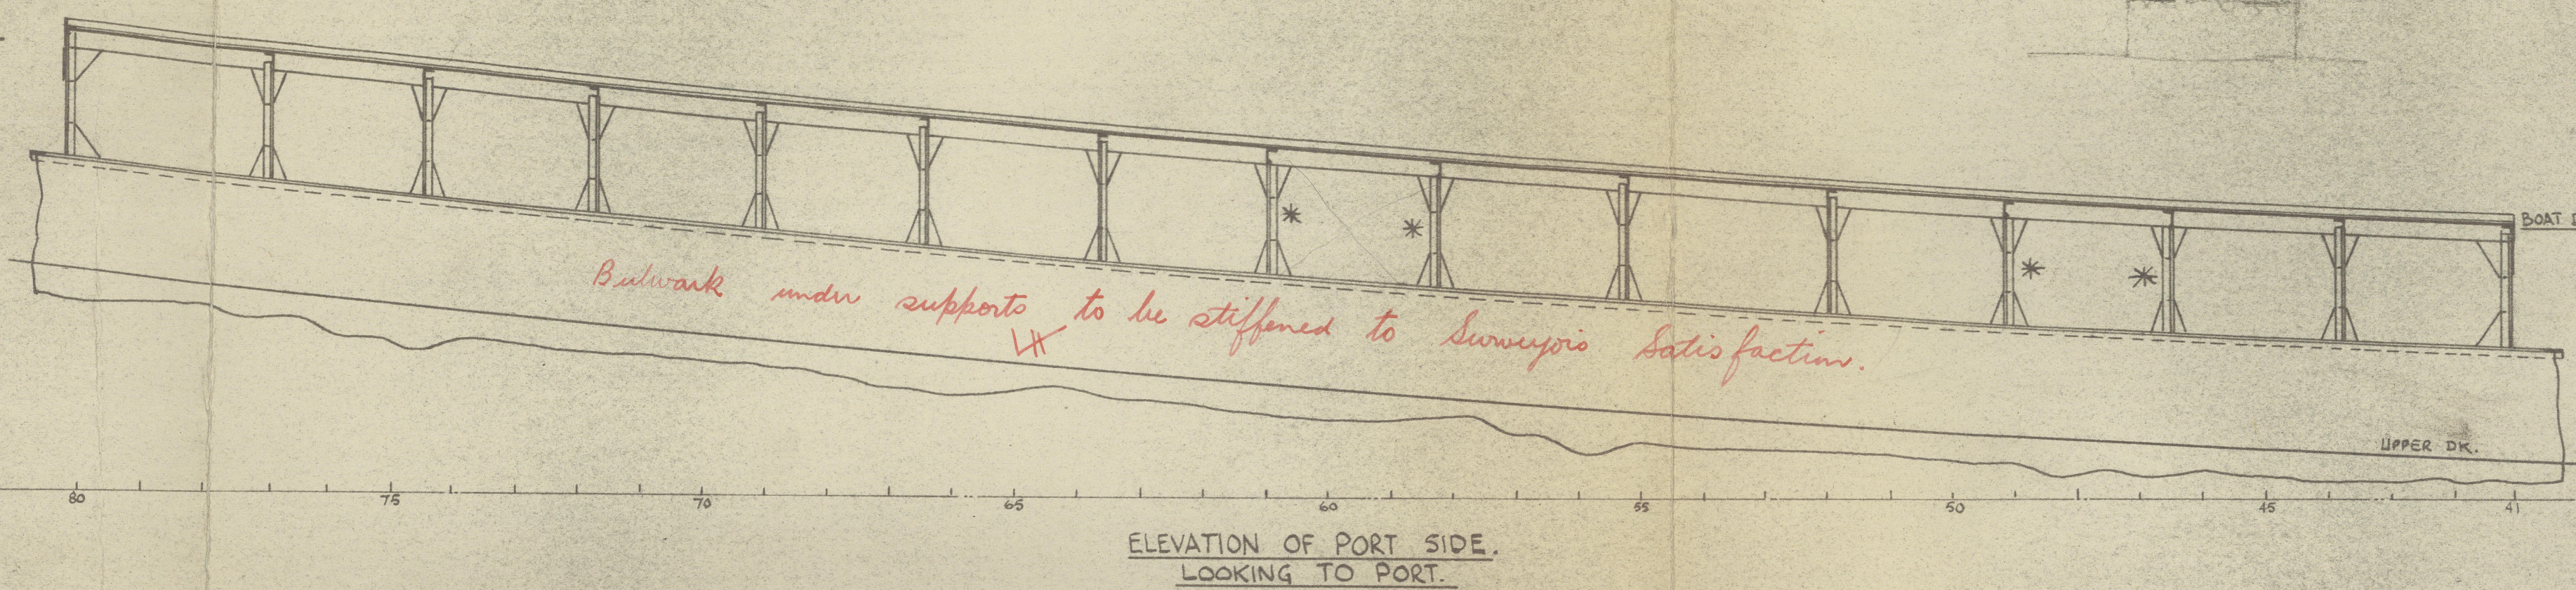

DETAILS OF AFT DECKHOUSE ON UPPER DECK.

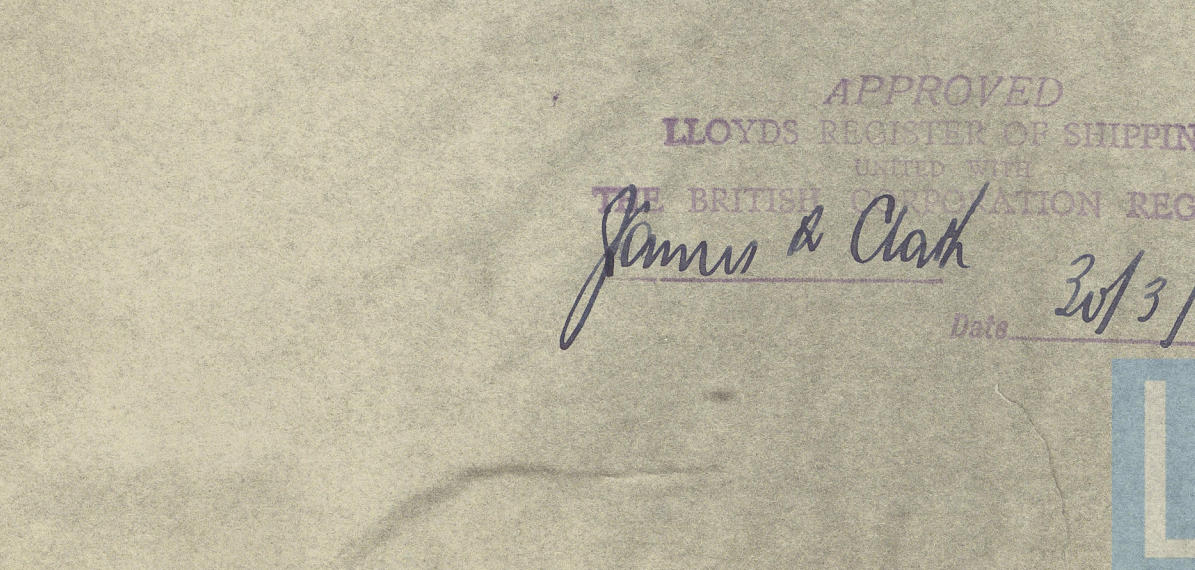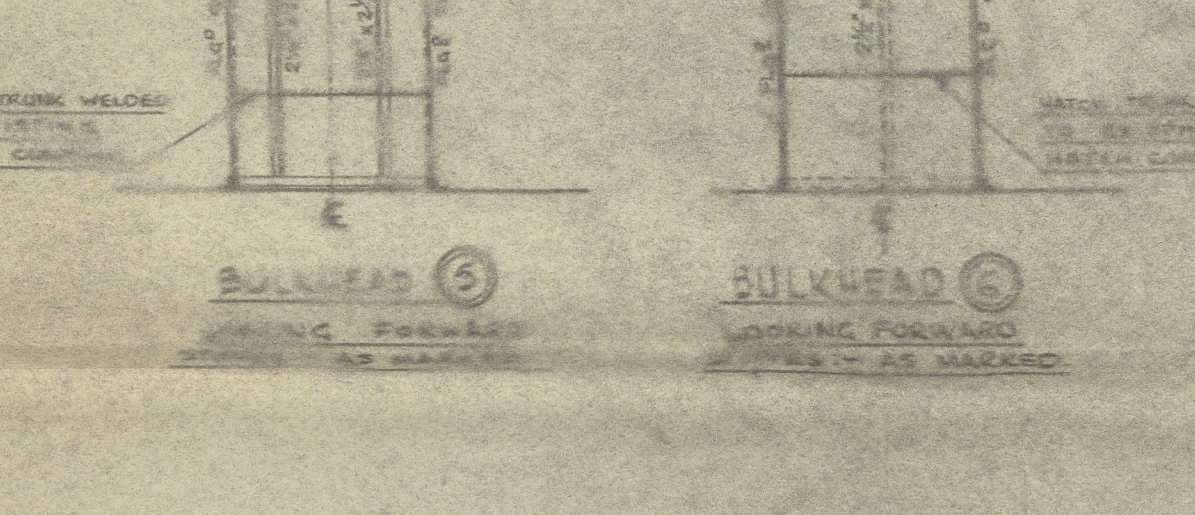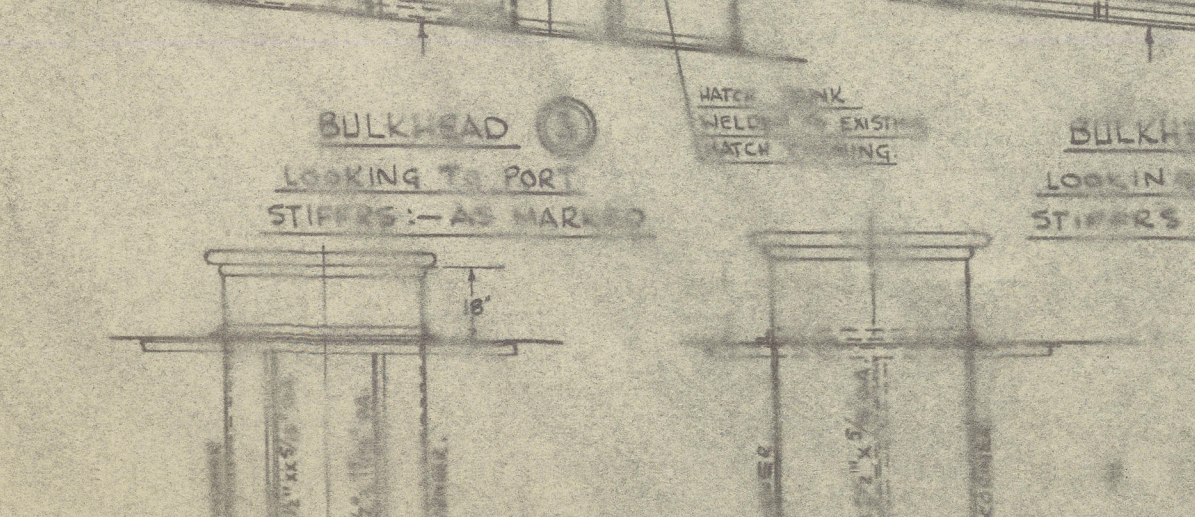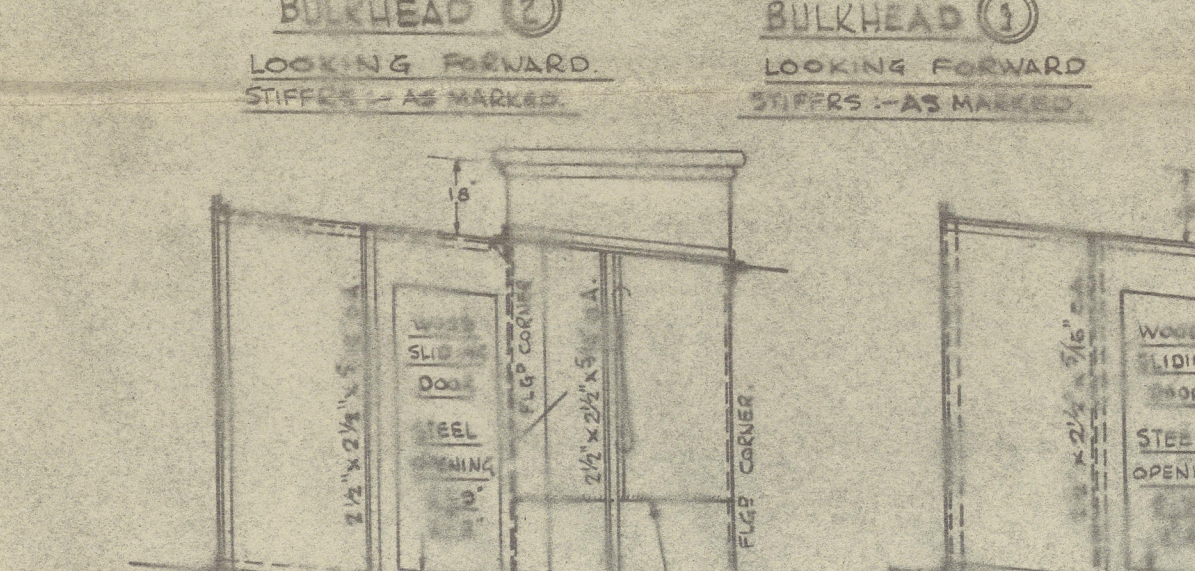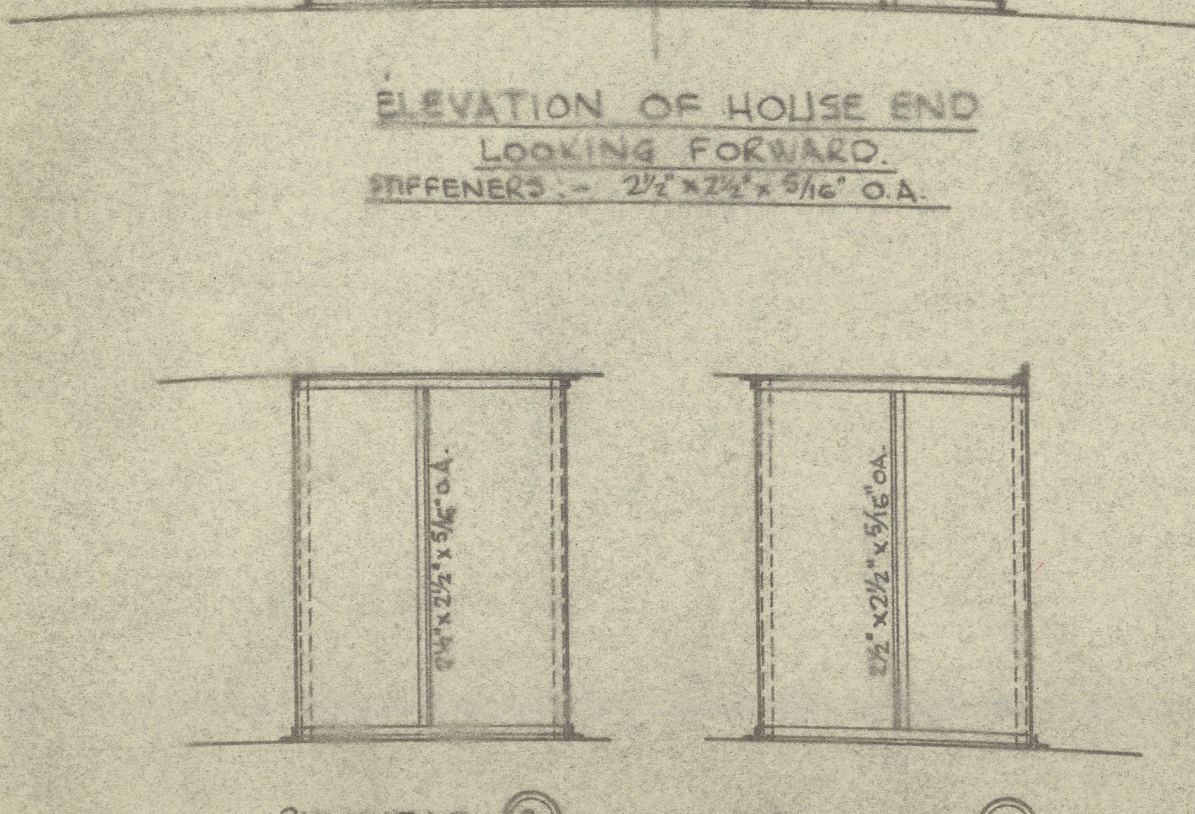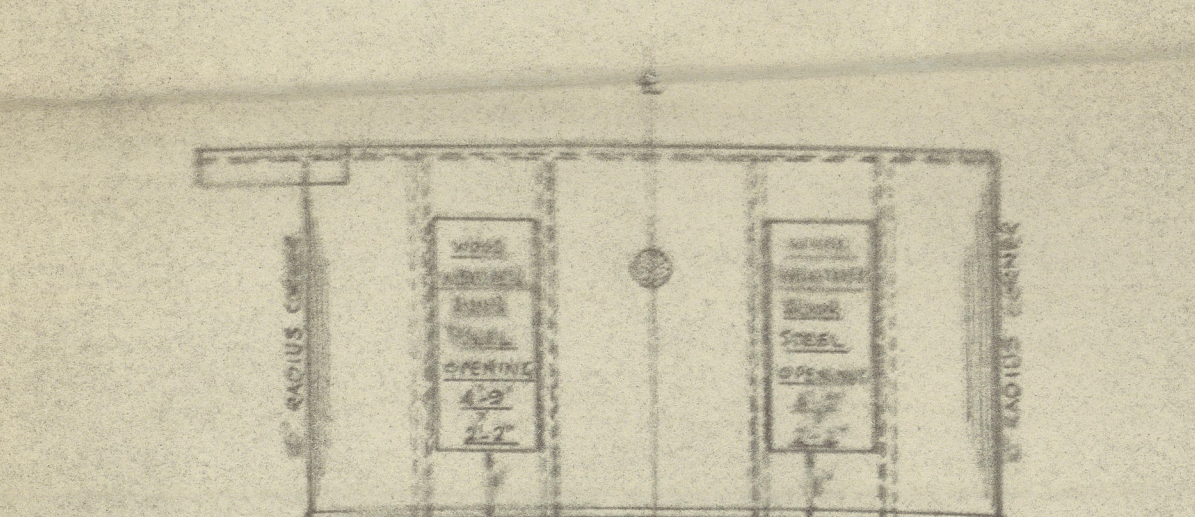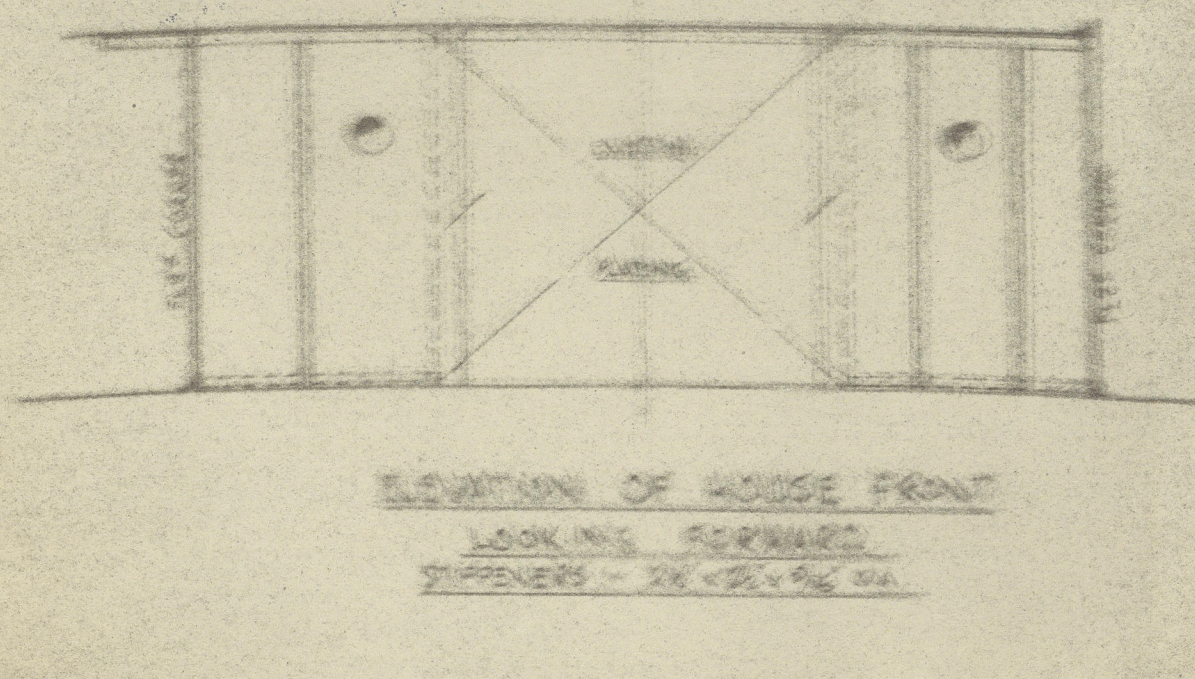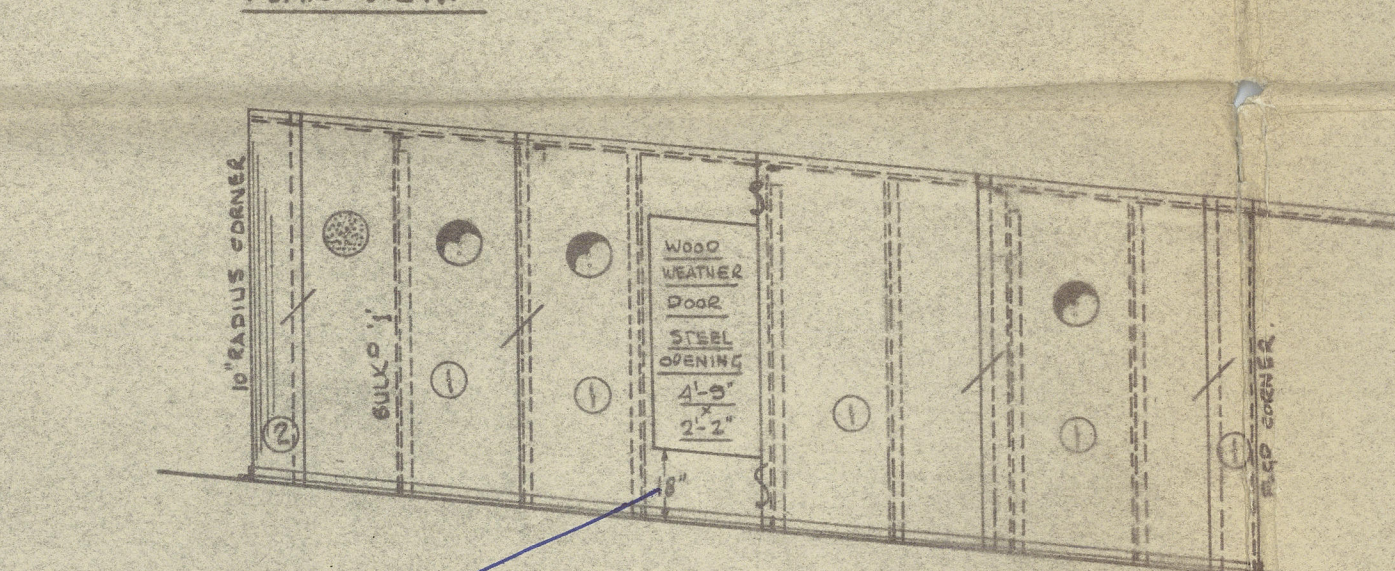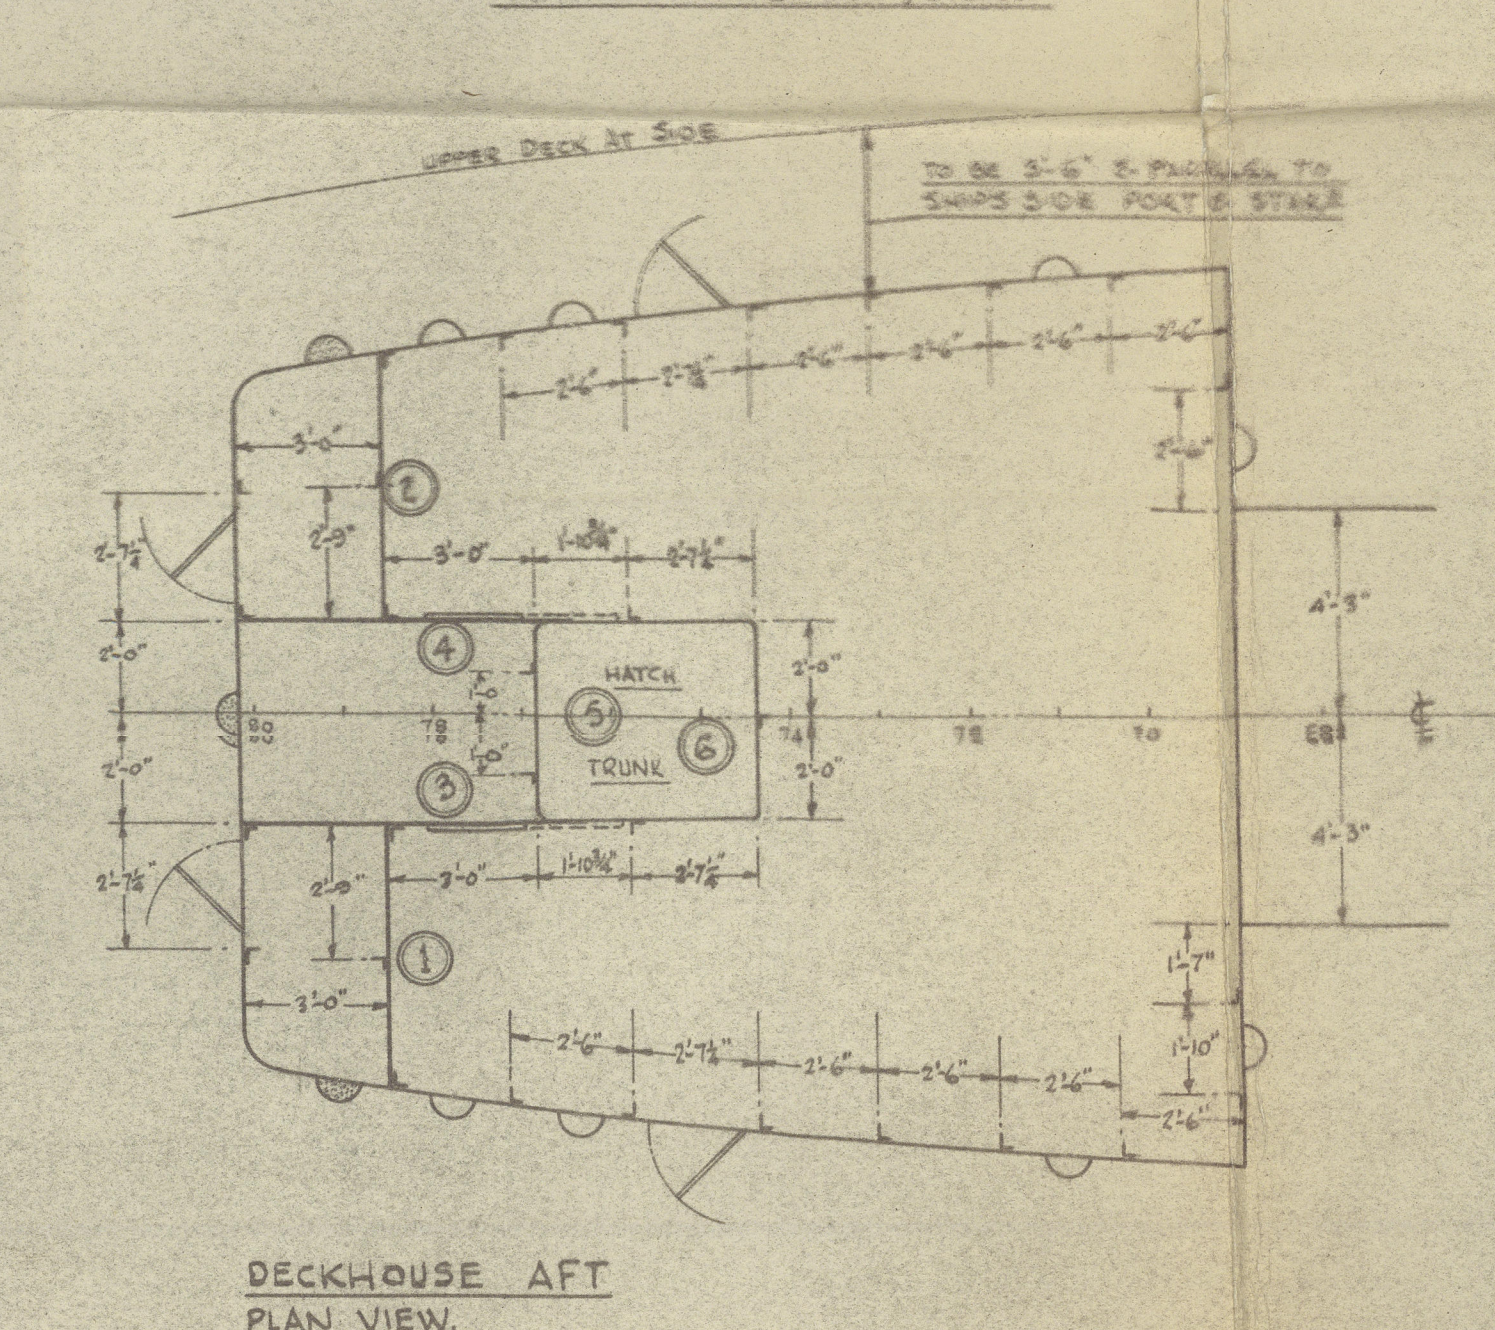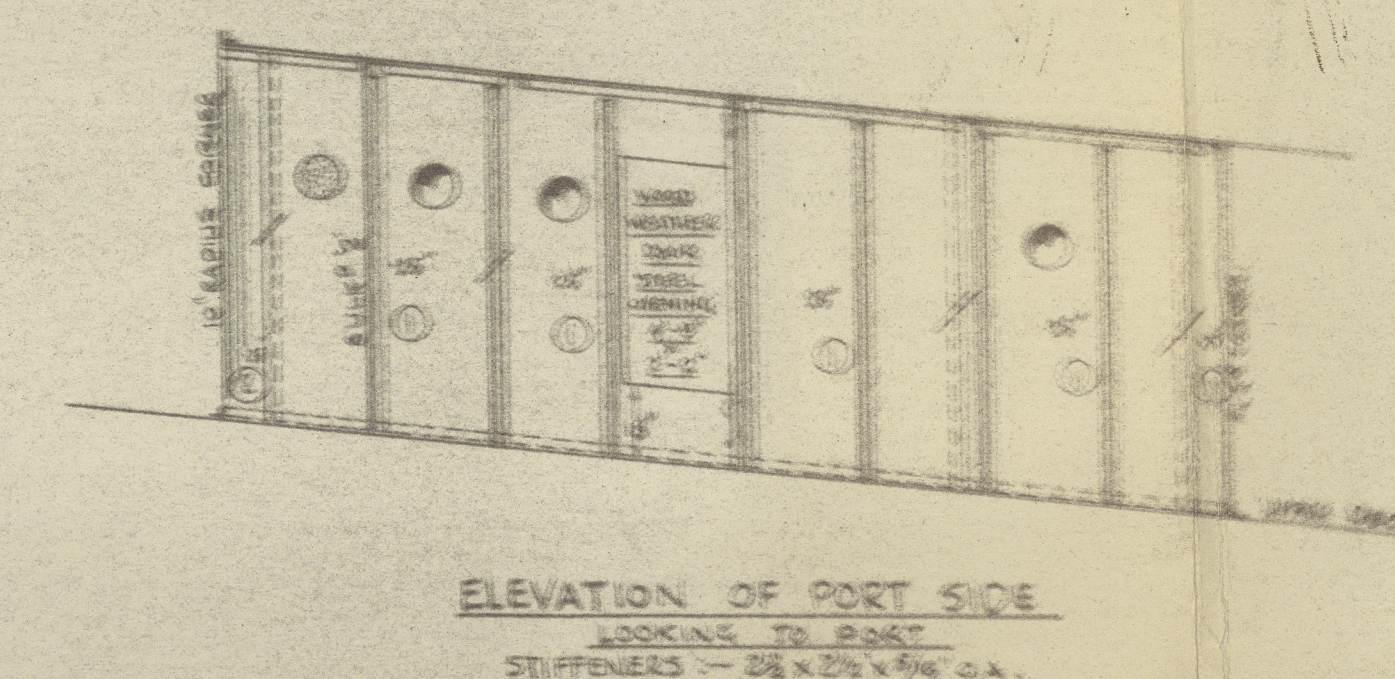


APPROVED
LLOYD'S REGISTER OF SHIPPING
BRITISH
James & Clark
20/3/53

"Grona"

Rpt. No. Gls. 80402

Aft. deck house &
boat deck plating

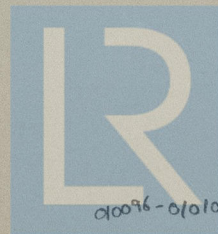

© 2021

Lloyd's Register
Foundation

010096-010102-0207