


DEEST. BIJ NIMEGEN. HOLLAND.

KLASSE LLOYDS 100 A1:

BOUWNR 206. SCHAAL = 1:50.

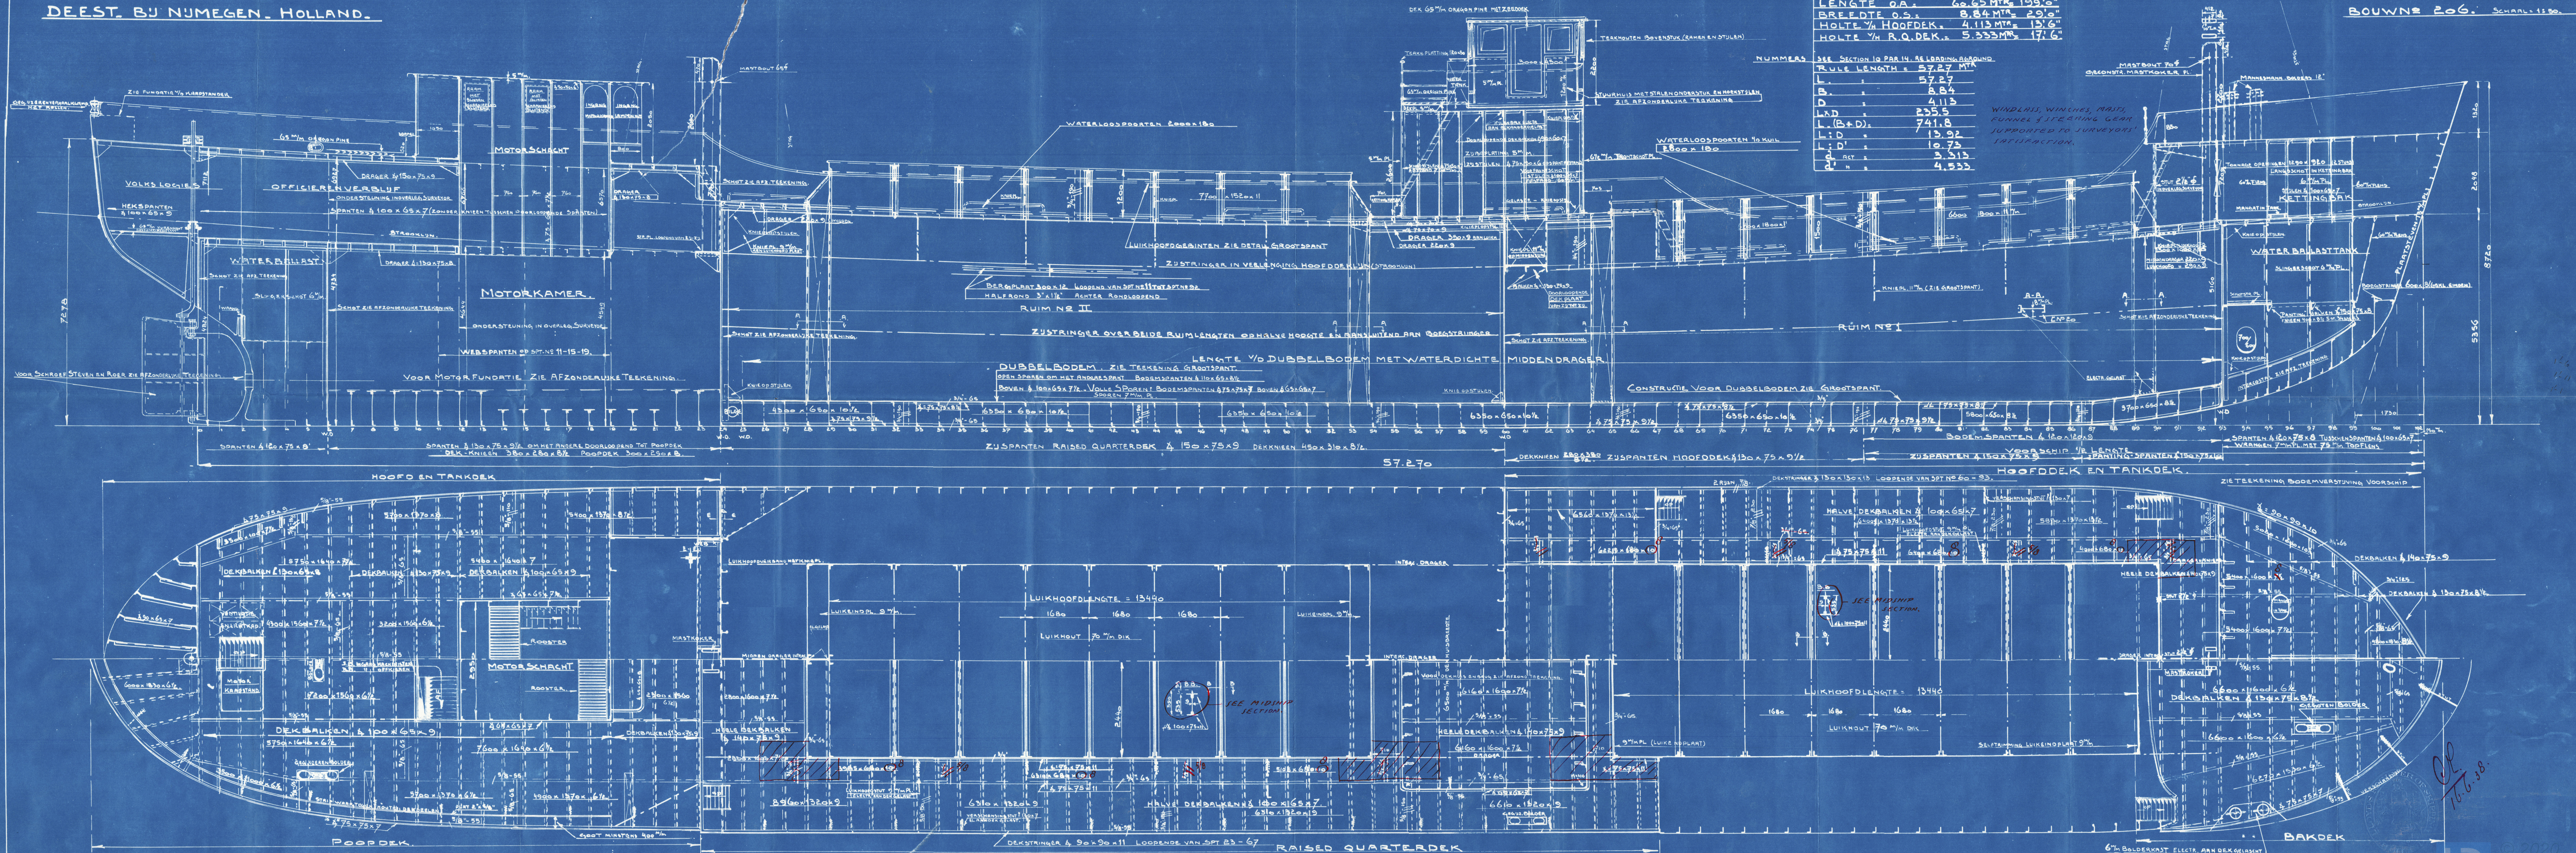



LONDON


GEBR  $\frac{1}{10}$  WERF

206.

PROFILE & DECKS

GEN BOX NO

324  
22  
© 2020



Lloyd's Register  
Foundation

010137-010149-0033