

N.V. SCHEEPSWERF. GEBR. VAN DER WERF.


DEE ST. BJ NIMEGEN - HOLLAND.

MOTORCOASTER ± 1000 TON. D.W.

PLAN VAN CONSTRUCTIE. KLASSE = LLOYDS 100 A.1.

SCHAAL = 1:25.

UITRUSTING LETTER A. 3.

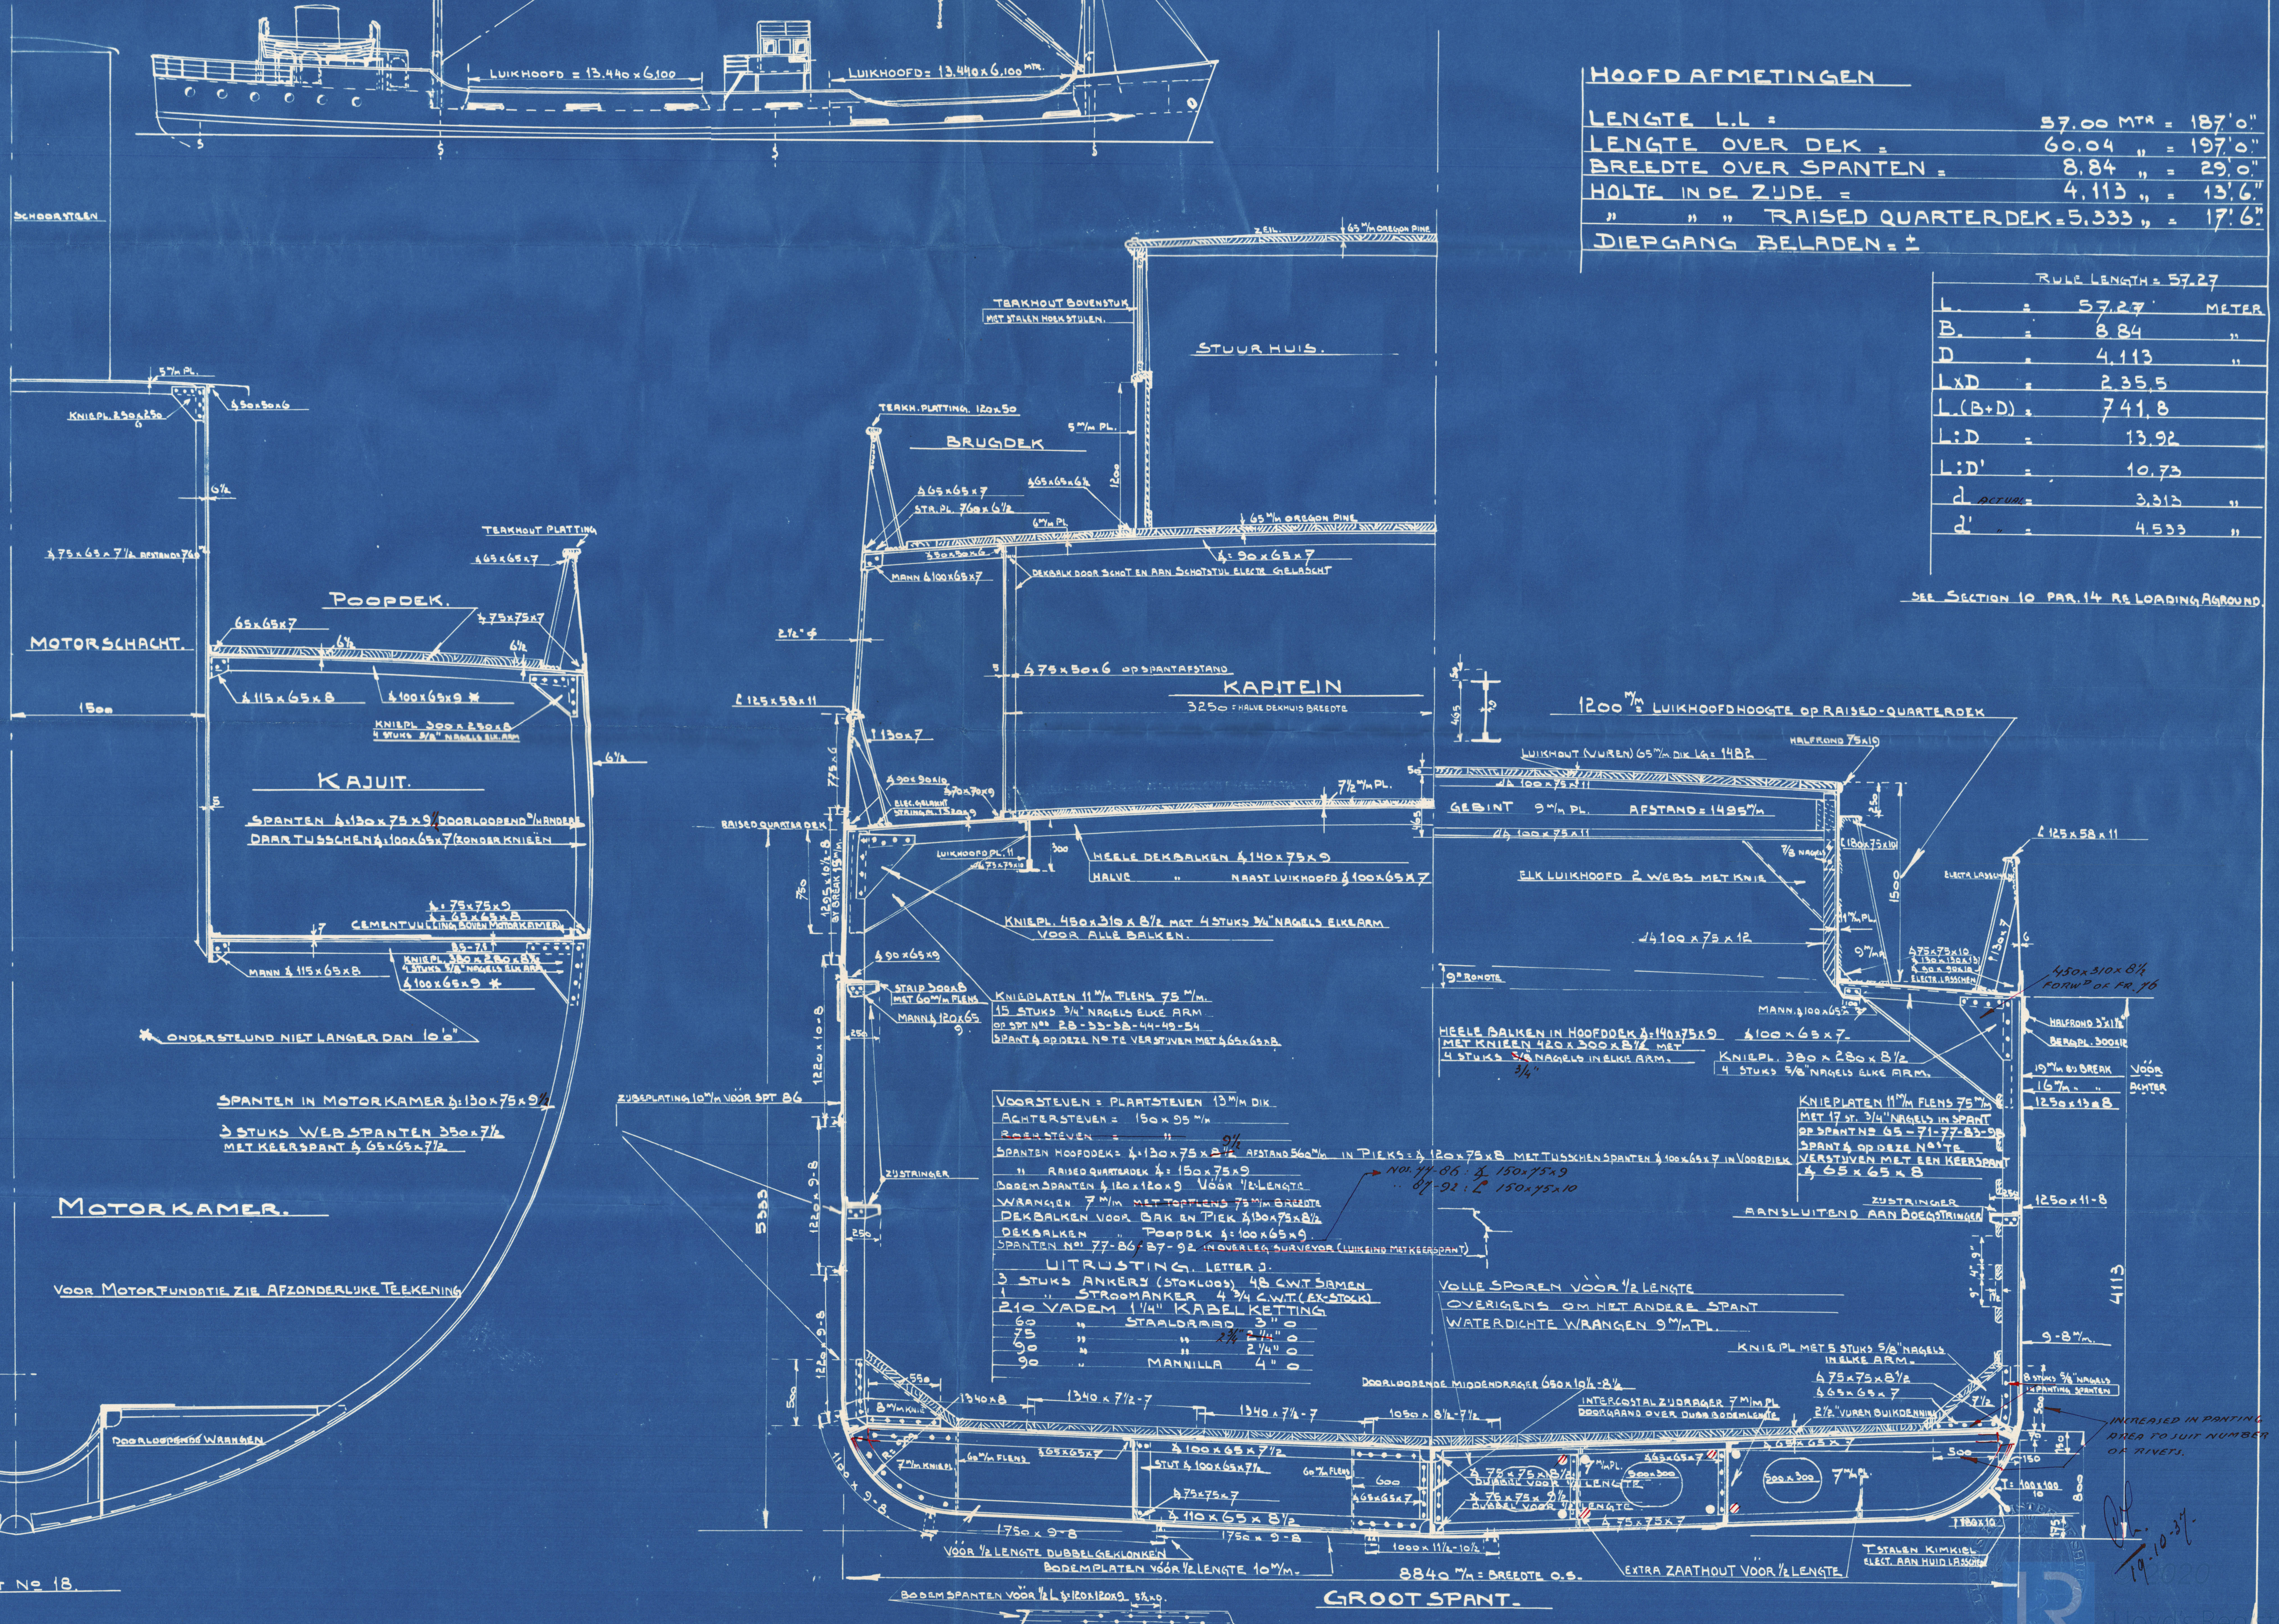

327

(12)

GEBR. V/D WERF

206

MIDSHIP SECTION

Emidtown

(no 204 sister vessel)



© 2020

Lloyd's Register
Foundation

010137-010149-0035