


M. V. "Ho Kwang"
 No 687 BULK & PACKED CARGO VESSEL
 SCANTLING PLAN






DIMENSIONS: 200'-0" B.P. x 32'-3" MLD x 11'-3" MLD
 SCALE 1/8" = 1 FOOT.

⊕ CARRYING PETROLEUM IN BULK & PETROLEUM PRODUCTS FOR SERVICE ON THE YANGTZE RIVER

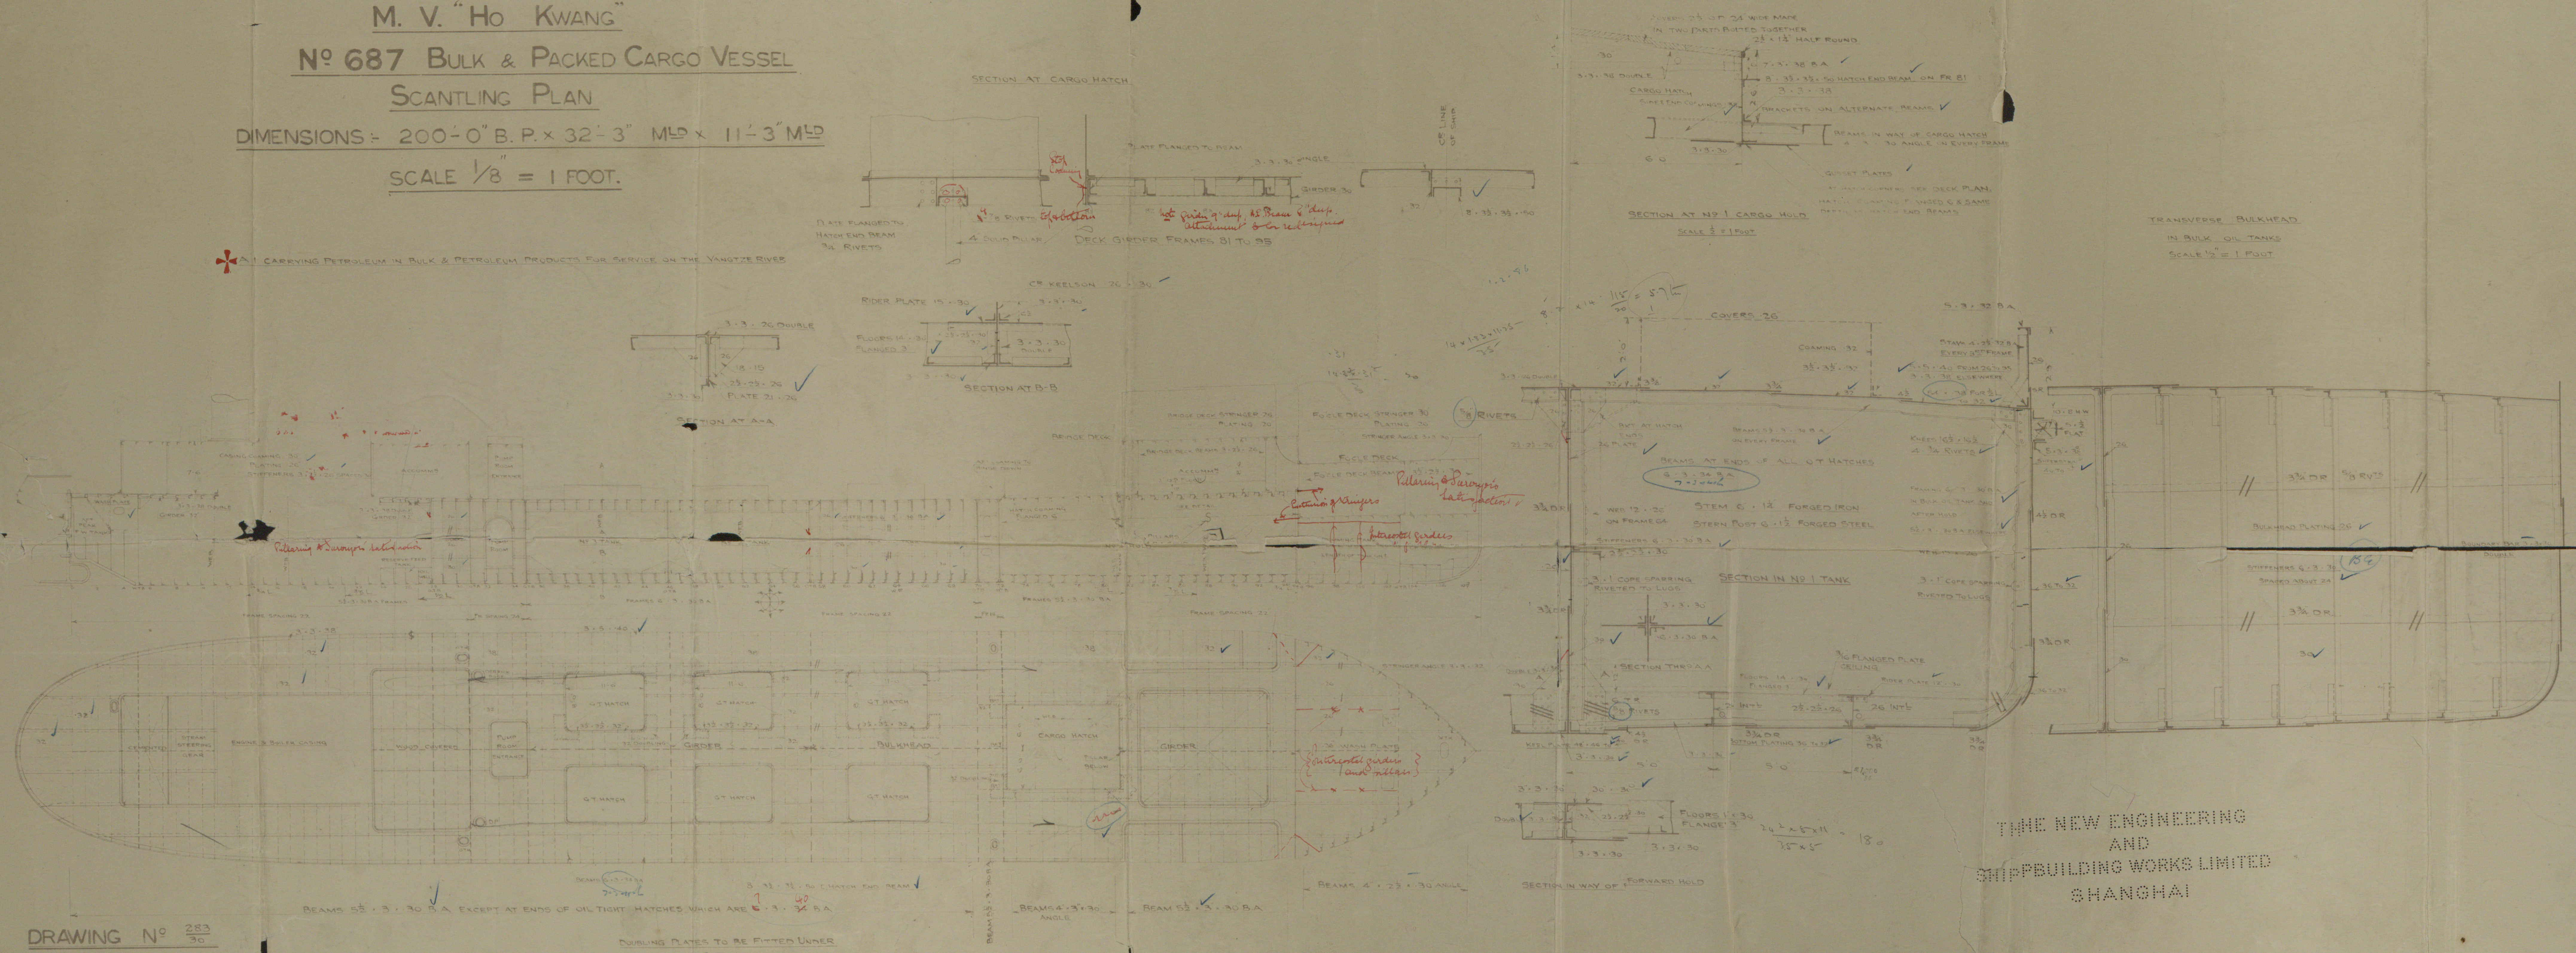

DRAWING No 283
 30

DOUBLING PLATES TO BE FITTED UNDER
 ALL BOLLARDS & FAIRLEAD STOOLS

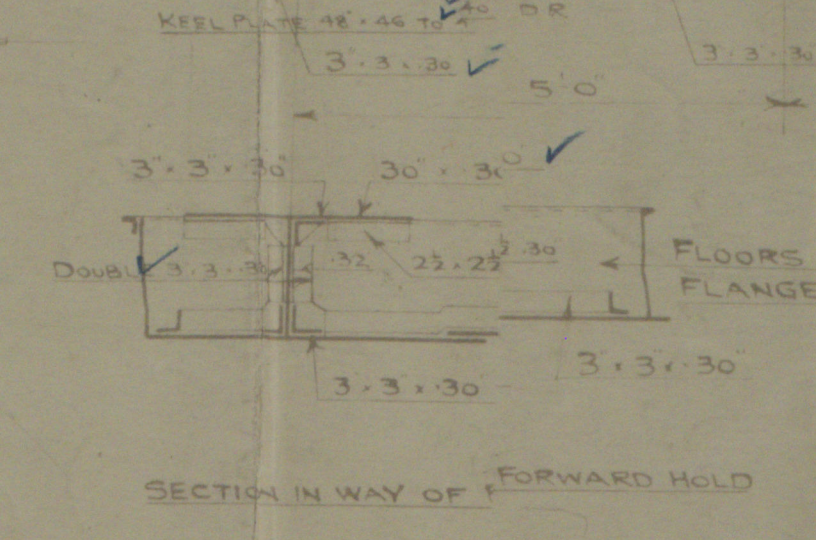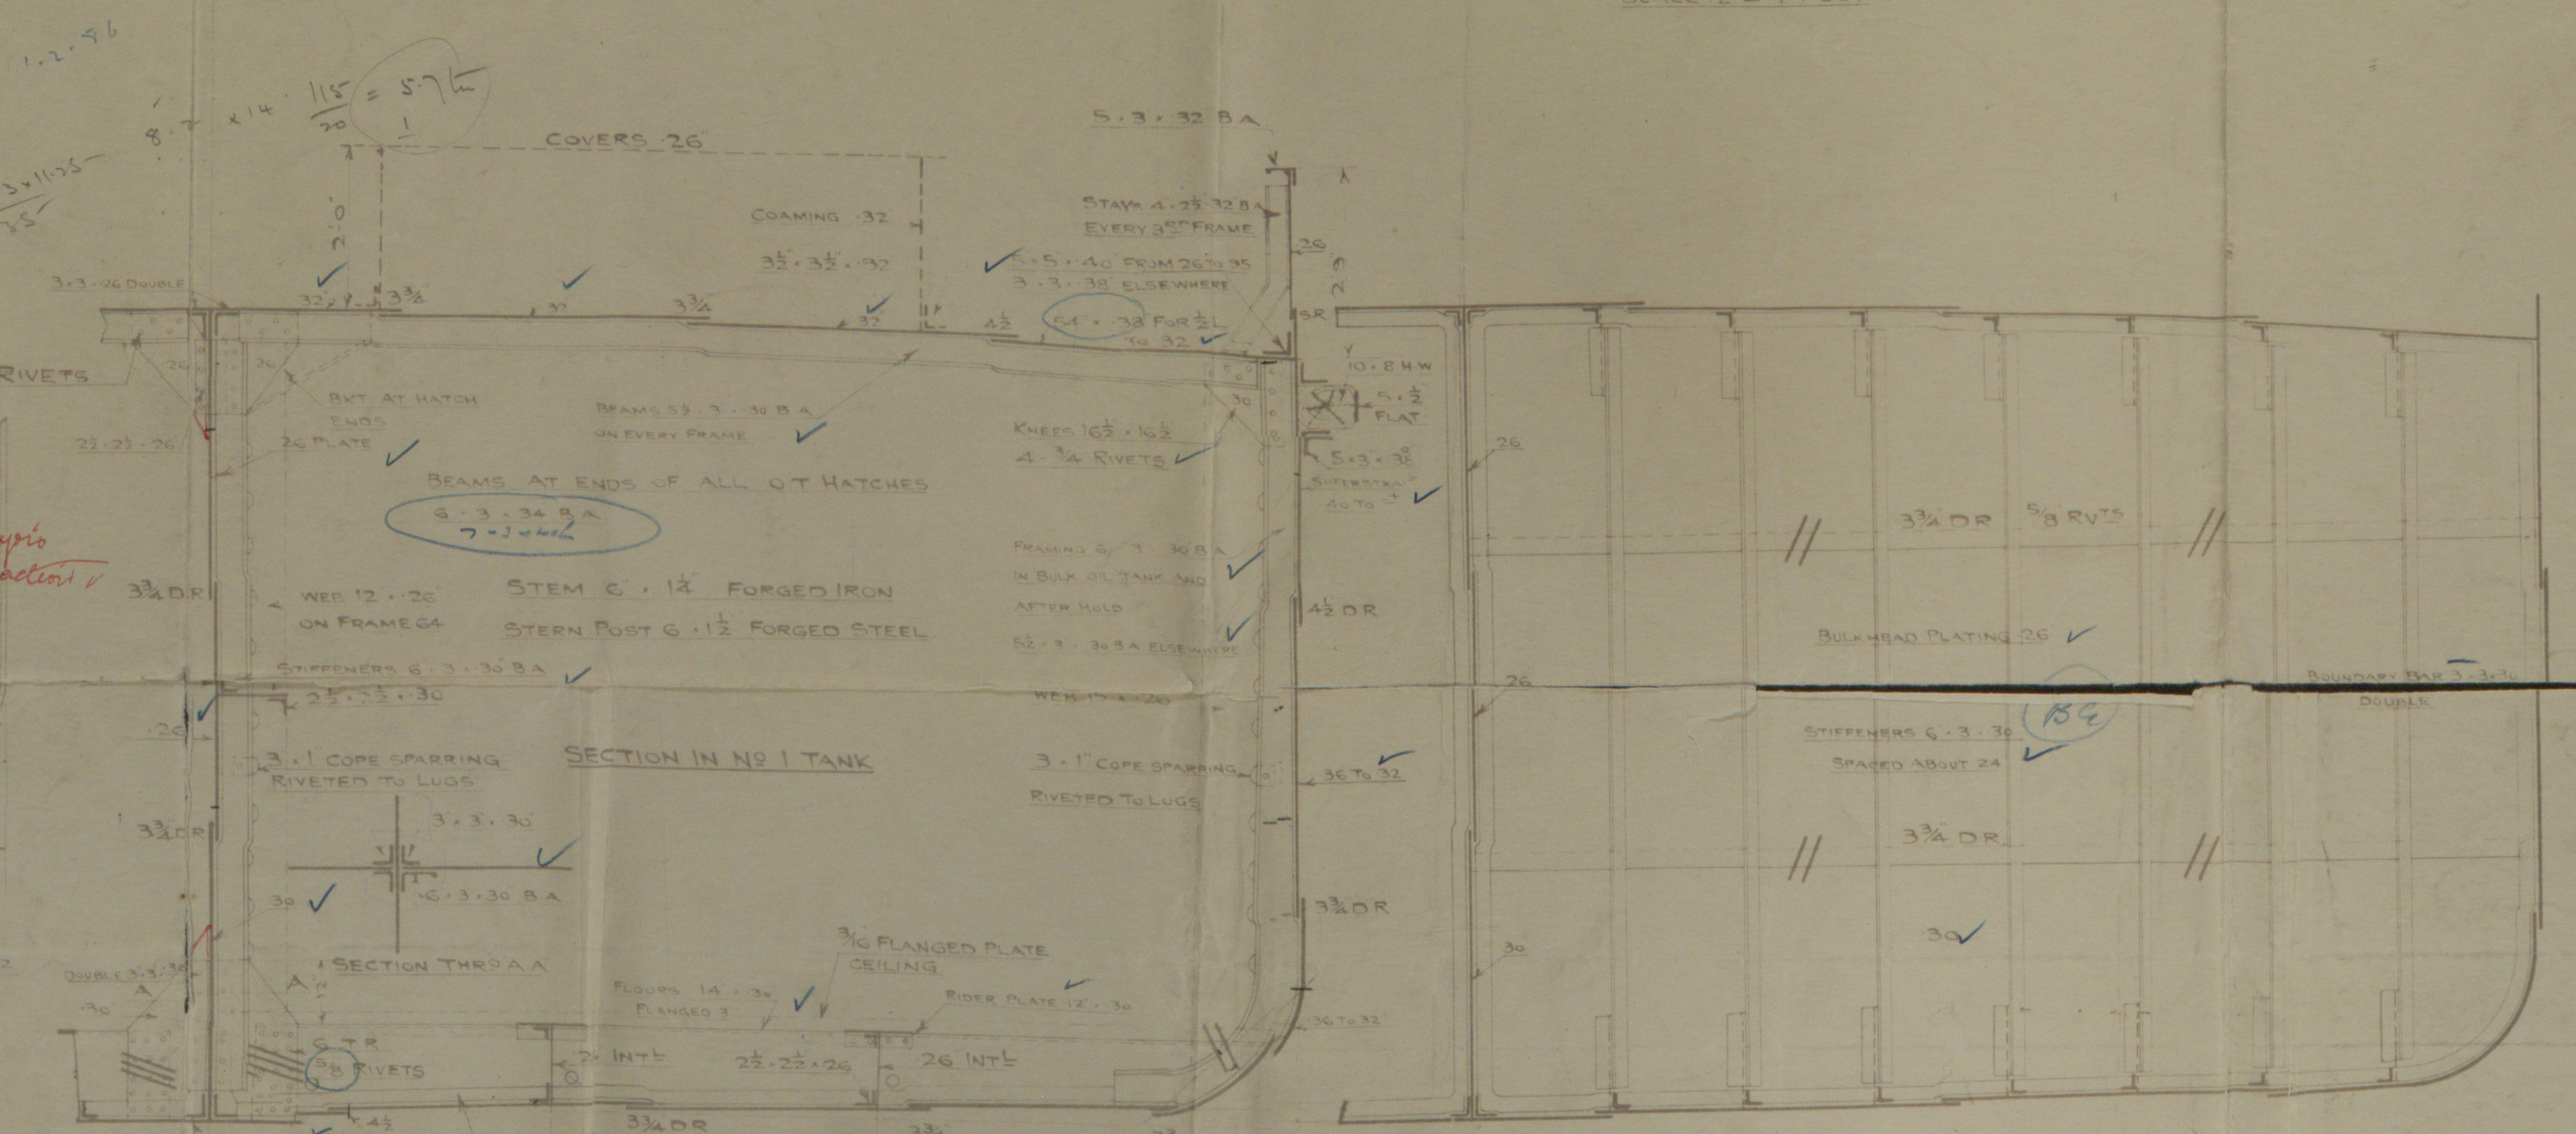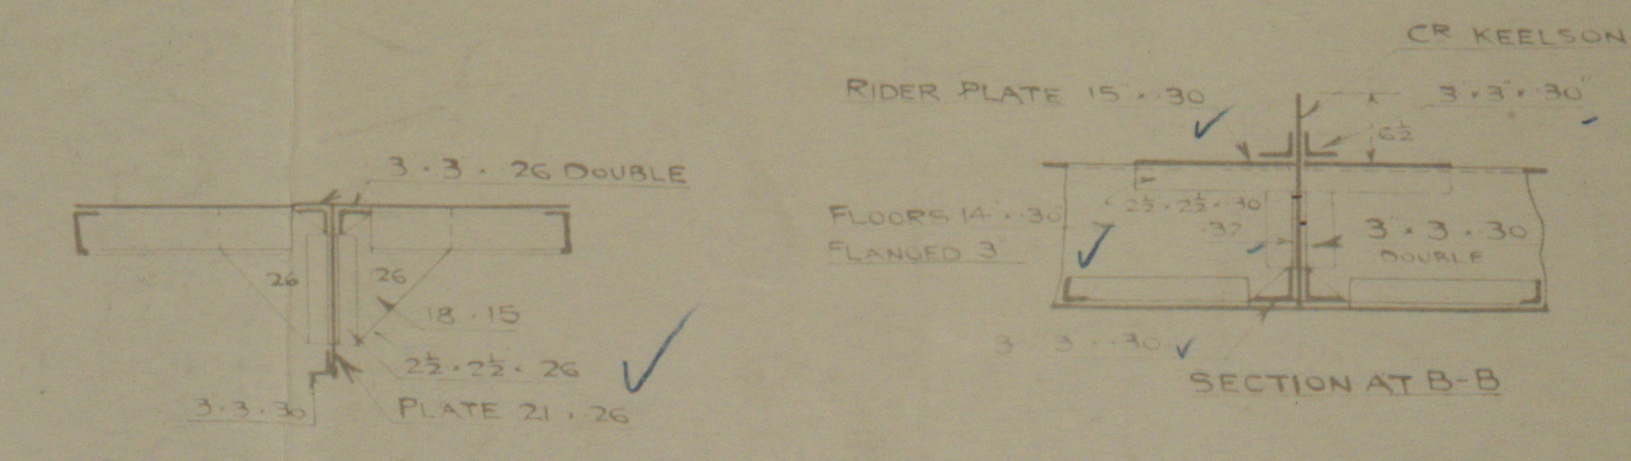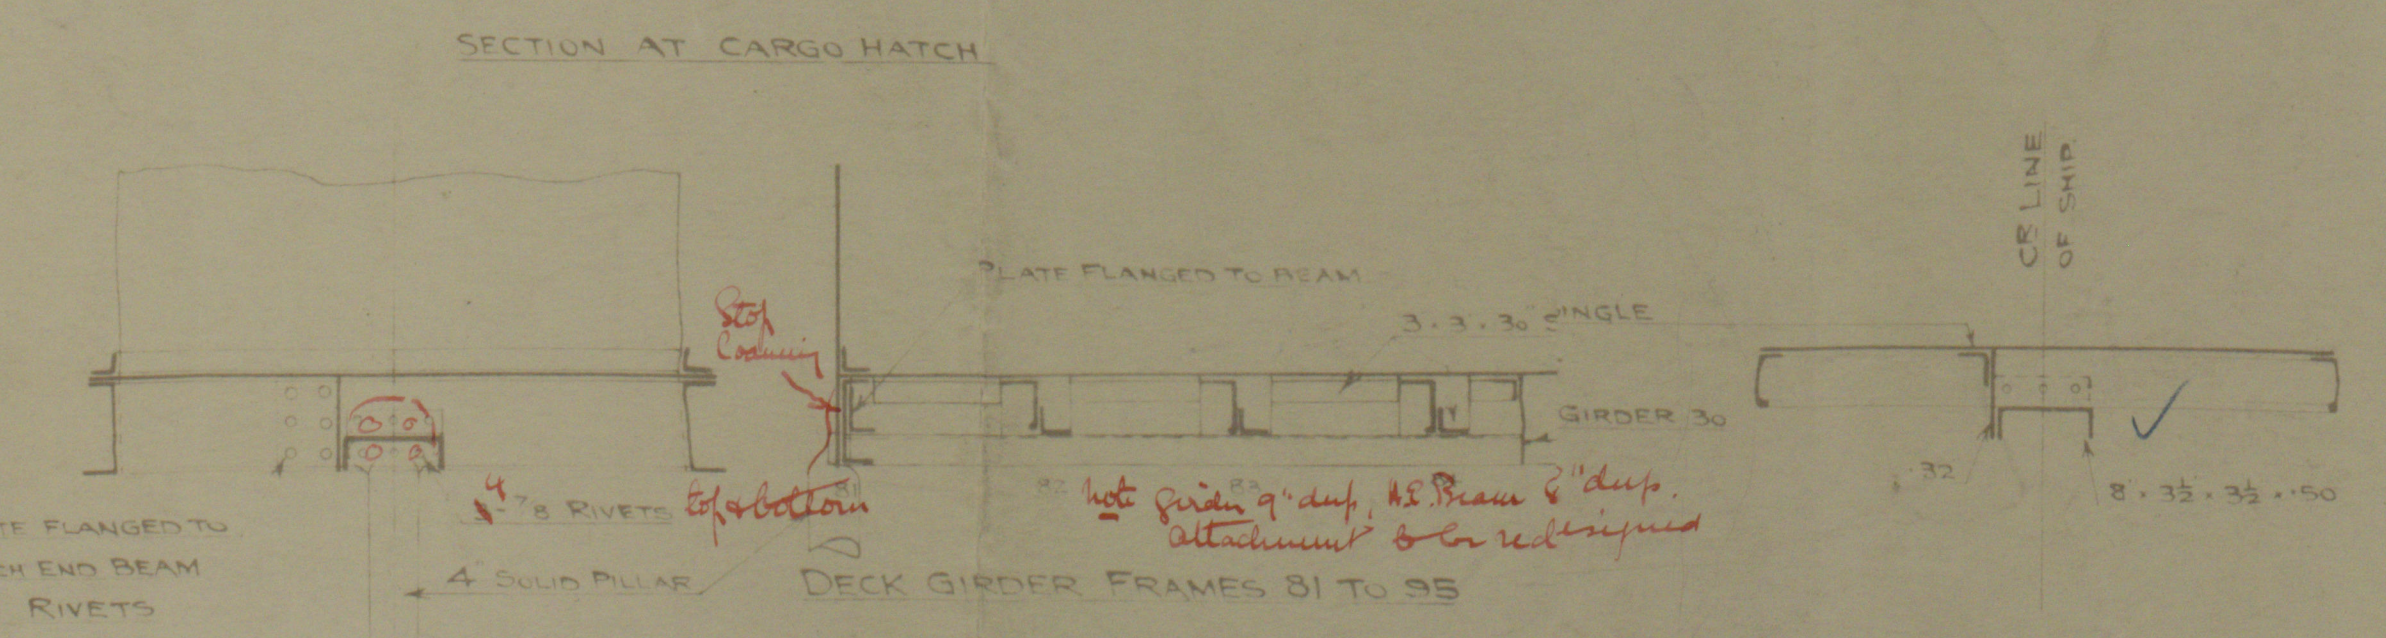
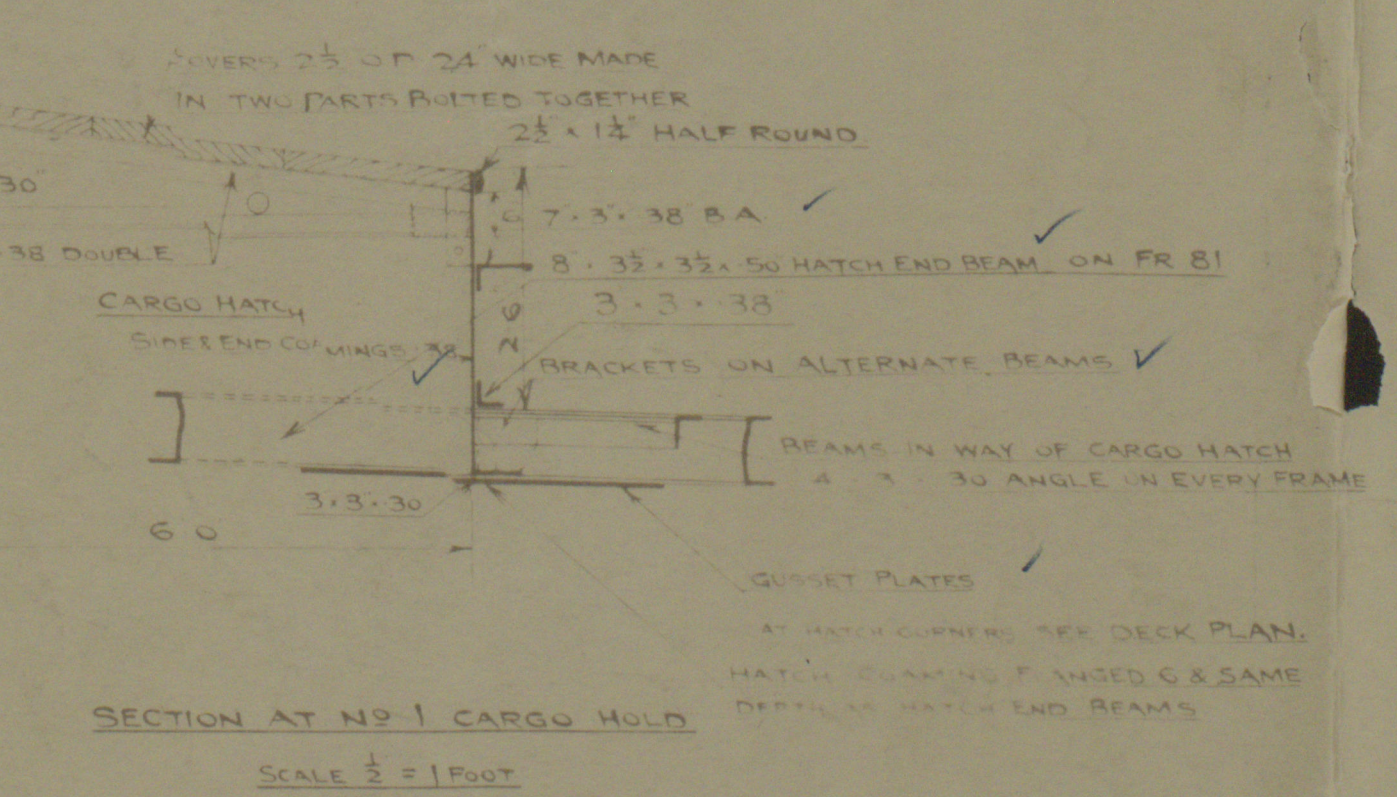


TRANSVERSE BULKHEAD
 IN BULK OIL TANKS
 SCALE 1/2" = 1 FOOT

RIVETING		SPACING OF RIVETS		DIA	SPACING

NOTE: ALL RIVET HOLES IN WAY OF OIL OR
 GASTIGHT WORK TO BE PUNCHED 1/8"
 SMALL AND REAMED OUT FULL SIZE.

EQUIPMENT	
2 - BOWER ANCHORS EACH 14 1/2 CWT'S STOCKLESS HALLS MAKE	
1 - STREAM 4 1/2 CWT'S EX. STOCK	
125 FATHOMS 1 1/2" STUD CHAIN CABLE	
60 3 SW ROPE FOR STREAM ANCHOR FITTED ON REEL	
75 8 1/2 HEMP TOW LINE	
20 2 1/2 SW ROPE HAWSER FITTED ON REEL	
30 4 1/2 MANILA HAWSER	

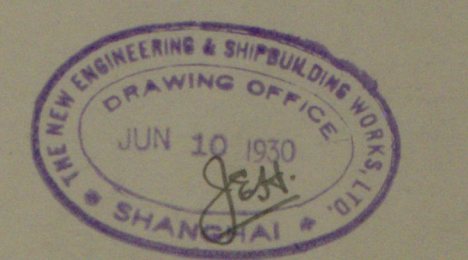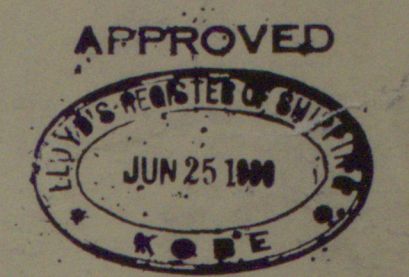

THE NEW ENGINEERING AND
 SHIPBUILDING WORKS, LTD.

New Engineering Co. N° 6817

"
M.S. + Profile"

GEN. BOX NO ~~100~~

Ho. Kwang
Shi 3152.



© 2021

Lloyd's Register
Foundation

010229-010235-0208