


S. E. A. C. TYPE COASTER S. S. "ADELINA" EX - MEMBAU
TWEEN DK CARGO HOLD BULKHEAD ALTERATIONS
DIMENSIONS : — 140'-0" L.B.P. x 27'-0" B.M. x 10'-6" 2ND DK x 17'-6" UPPER DK
SCALE : — $\frac{1}{4}$ " = 1 FOOT

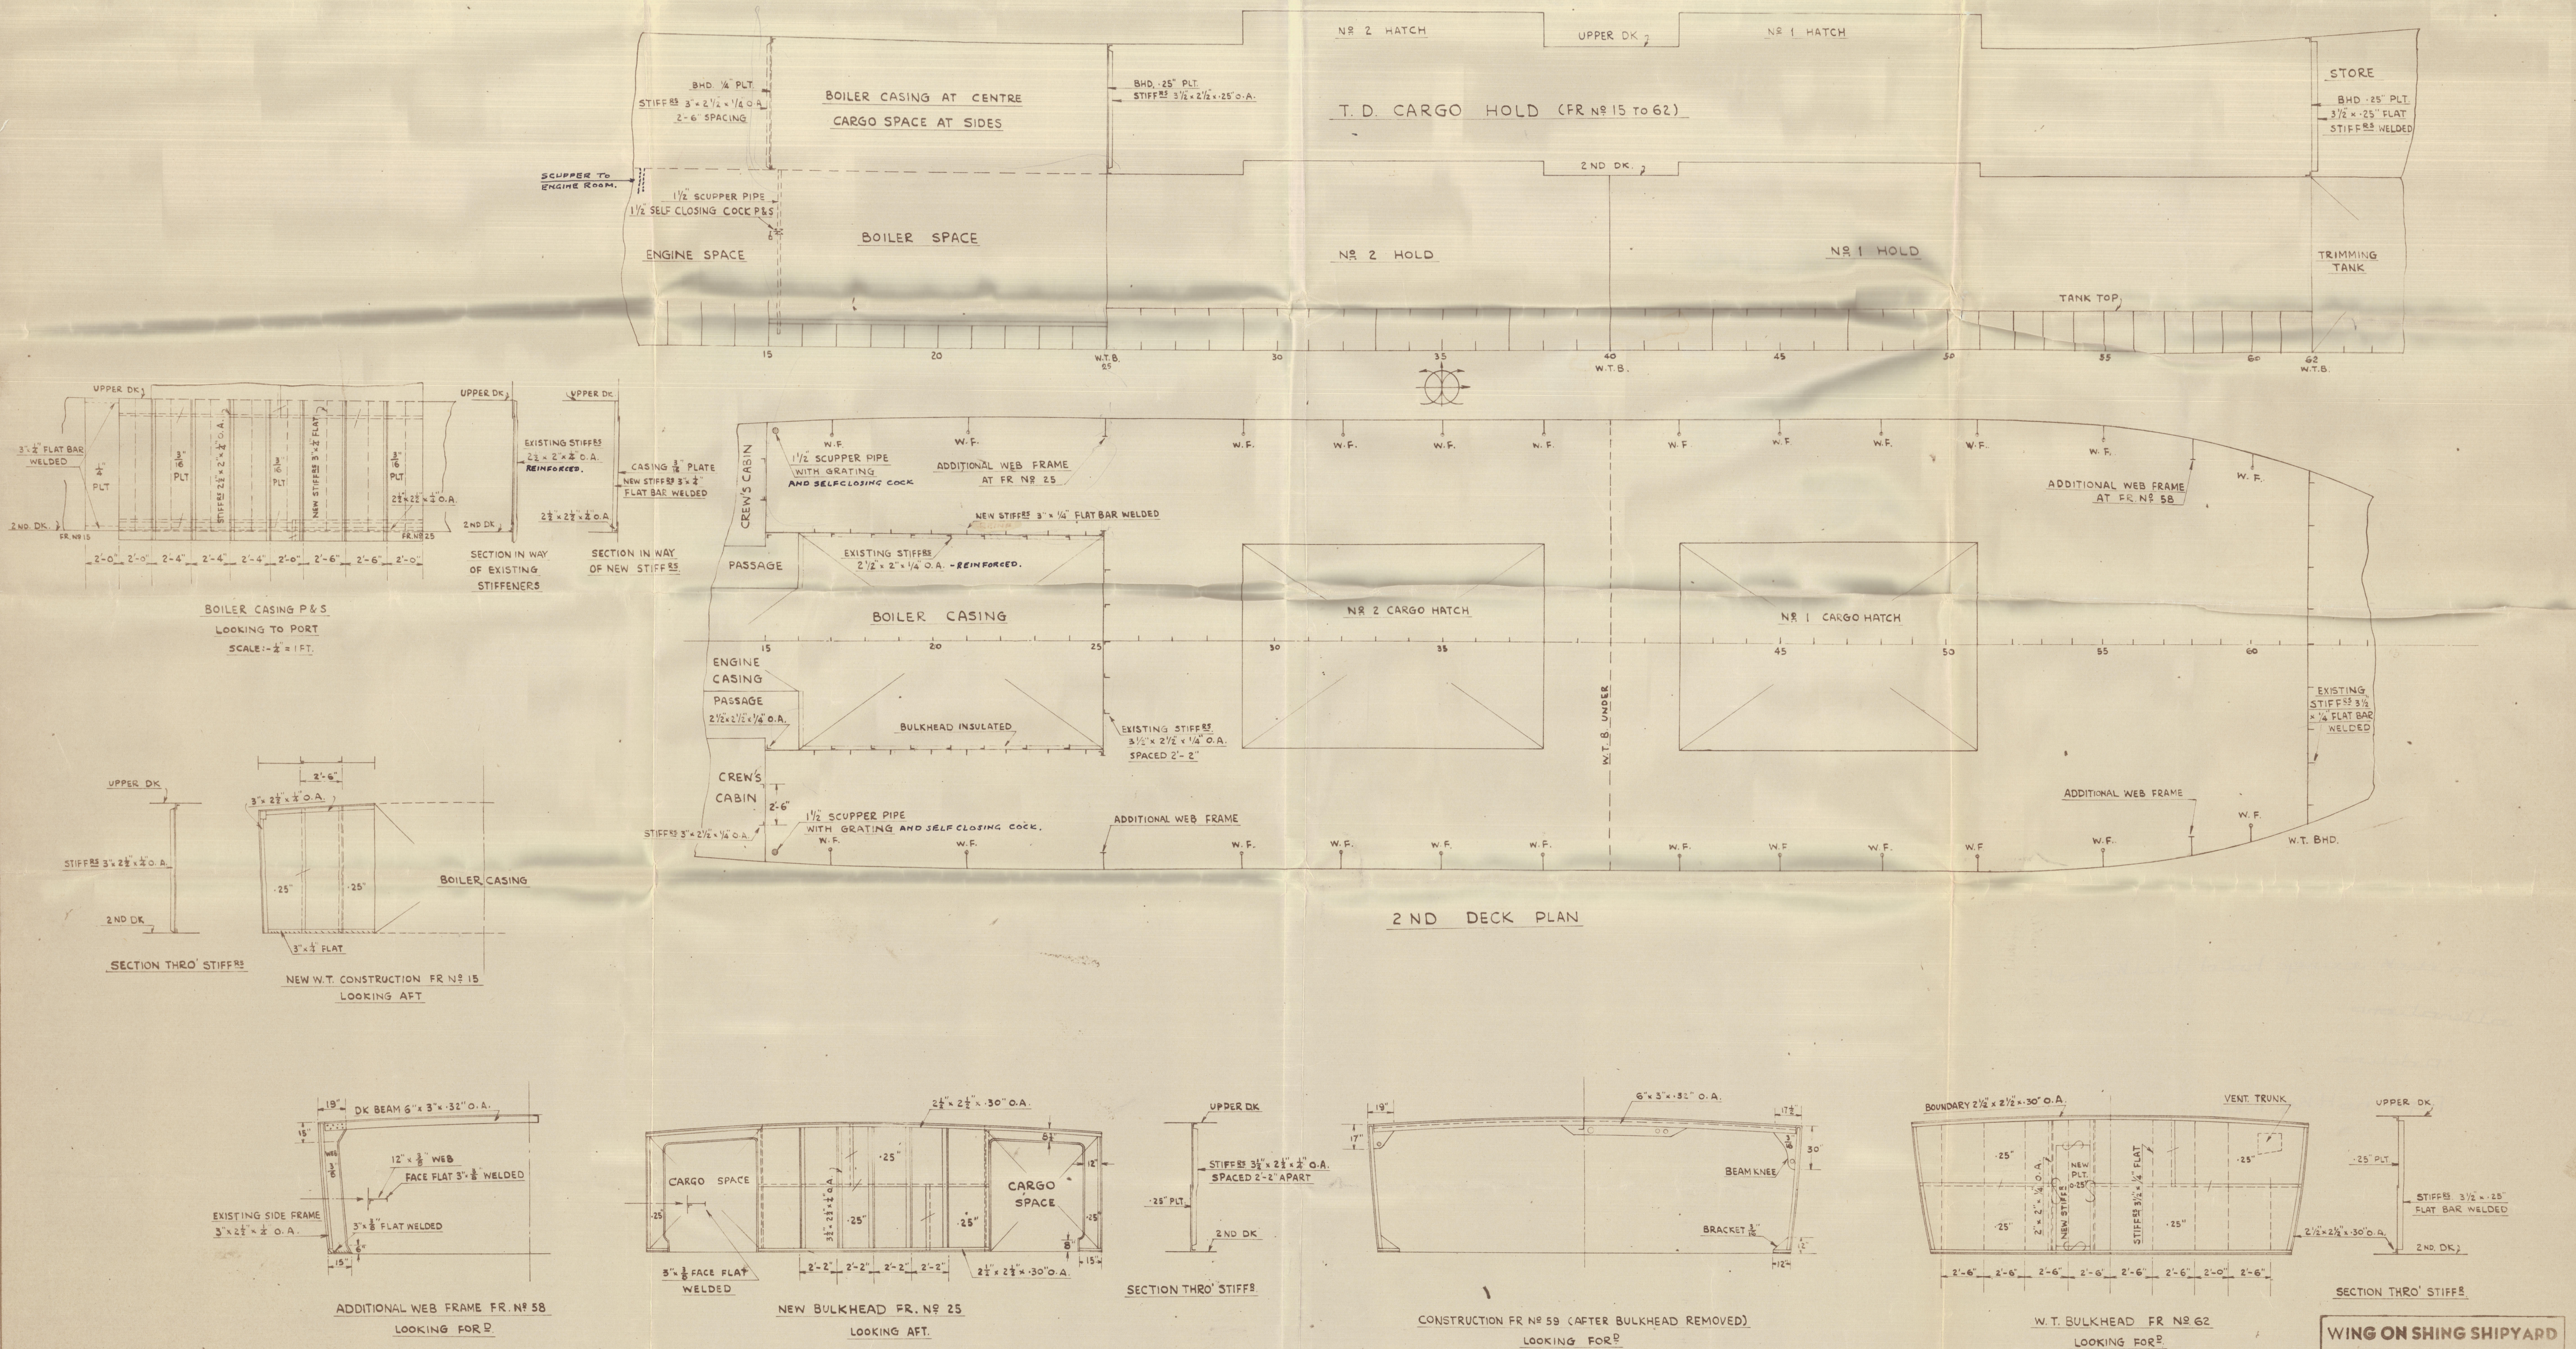

Tween deck cargo hold bulkhead
alterations.

"Adelina"

Rpt. no H.Kg. 11744



© 2021

Lloyd's Register
Foundation

010276-010282-0006