

Rpt. 11b.

32915
8 MAY 1929

Lloyd's Register of British & Foreign Shipping.

SURVEYS FOR FREEBOARD.—STEAM SHIPS. 10,164

PARTICULARS RELATING TO ALL STEAM SHIPS EITHER FLUSH DECKED, OR WITH TOP GALLANT FORECASTLES, SHORT POOPS AND BRIDGE HOUSES DISCONNECTED, OR WITH TOP GALLANT FORECASTLES HAVING LONG POOPS, OR RAISED QUARTER DECKS CONNECTED WITH BRIDGE HOUSES, OR OTHERWISE.

— SHELTER DECK. —

Port of Survey Belfast.
Date of Survey Whist Building
Name of Surveyor J. Hodgson

Workman Clark (1928) Ltd No 506 Ship's Name. "DEEBANK"	Port of Registry and Nationality. BELFAST British.	Official Number. 148166	Gross Tonnage.	Date of Build. 1929	Particulars of Classification. 100 A1. with freeboard (Class Contemplated)
Number in Register Book					
Registered dimensions from Ship's Register.	LENGTH. H21.8	BREADTH. 56.8	DEPTH. 26.7	UNDER DECK TONNAGE. 14628.31	
Length on LOADLINE.	H20.0	Frame Depth $\frac{1}{2}$ under Hatches only Rule " 6x Sheer - 1.23	Ceiling + .21 Tonnage to framing No Sparring + .33	Peak } Included Tanks	
CORRECTED DIMENSIONS.	H20.0	55.8 55.41	25.68	14628.3	

Co-efficient of fineness..... 77
Any modification necessary { - .02 C.D.B.
[Para. 4 (a) to (e)]*

Co-efficient as corrected

.75. ✓

N.B. Sheer due to Camber only except at extreme fore end. See margin				
Sheer.	Sheer { Stem..... 26" } 39" ÷ 2 = 19½ ... Mean 36 44.28 at Sternpost ... 13" } 1.23			
14"				
10½	Sheer at $\frac{1}{2}$ of the length from Stem 5½ { 8½ ÷ 2 = 4½ ... Mean 13½ Sternpost 3 } 8½ ÷ 2 = 4½ ... Mean 13½			
5½	Gradual mean Sheer 27.72			
3"	Standard mean Sheer [Table, Para. 18] 52.0	Correction		
13"	Difference 38.2 44.28	÷ 4 = + 9.2 + 11.11.07		
	§ If limited as Para. 18 (f).....	+ 11.11.07		
	Correction for depth 52 - 27.72 = 3 = 14.72 - 1.23			

Rise in Sheer { At front of bridge house.....
from amidships } At after end of forecastle

¶ Fall in Sheer { Para. 18 (d) } ÷ 2 =
Length uncovered ✓ Correction

ALLOWANCE FOR DECK ERECTIONS :-

Freeboard, Table C.....
Correction for Length, if required (Para. 12, 18, and 14)

X Freeboard by Table A. corrected for sheer, and for length, if required (Para. 12, 18, and 14)
Difference
Percentage as below 94.3%

4 - 0 1/2
8.1
4 - 1/2
3 - 1/4
4 - 0 1/2
45.73

Correction for R. Q. Dk. if engine and boiler openings not covered by bridge house (Para. 11)

Allowance for Deck Erections - 3 - 8½

	Length.	Length allowed.	Height.
Forecastle	377.7	377.7	7.0 min
Bridge House	3.0	3.0	
+ Raised Q. Dk. 3.0	36.3	36.3	9.9
Poop	414.0	414.0	
Total	414.0	414.0	
Length of Ship	H20		
Corresponding percentage (Para. 11, 12, 18, or 14)	94.3%	94.3%	99.3

FREEBOARD recommended amidships from centre of Disc to top of Statutory Deck Line, Wood (Iron) Deck :-

Fresh Water Line	above centre of Disc
Indian Summer Line	" " "
Winter Line	below " "
Winter North Atlantic Line	" "

If the frames, skin planking, or ceiling are of unusual thickness the breadth of vessel to inside of ceiling should be reported.
In vessels obtaining an allowance for deck erections under Para. 11 where the sheer drops abaft amidships the height of the R.Q.D. is to be taken from the level of the top of the amidship beam.
In flush-decked vessels the total standard mean sheer means the sheer measured at the stem and stern-post. In vessels having poops and forecastles, it means the sheer measured at points distant one eighth of the vessel's length from stem and stern-post.

2m.7.18 T.

State dimensions of freeing port areas on back of this form.
The Surveyor should state whether the fall in sheer as reported is measured relatively to the straight line of keel or to the water line. If measured relatively to water line the vessel's draft at time of survey, and also the usual load draft forward and aft, should be reported.

10 MAY 1929

7.0 12.970 6.90 010362-010368-0152½

© 2021 Lloyd's Register Foundation
RECEIVED I.P.T.O.

Do all the Frames extend to the top height in the Poop? Yes. Raised Quarter Deck? ✓ Bridge House? Yes Forecastle? Yes

To what height do the Reverse Frames extend? Main Deck

Has the Poop or Raised Quarter Deck an efficient Iron Bulkhead at the fore end? Yes.

Give particulars of the means for closing the openings in Bulkhead No openings

Is the Poop or Raised Quarter Deck connected with the Bridge House? ✓ Has the Bridge House an efficient Bulkhead at the fore end?

Give particulars of the means for closing the openings in Bulkhead ✓

What is the thickness of the Bridge Front plating? ✓ and Coaming plate? ✓

Give scantlings and spacing of the Stiffeners ✓

Are bracket plates fitted at each end of the Stiffeners? ✓ Are hor'l. brackets fitted connecting Bridge Bulk'd. with Bulwarks? ✓

Has the Bridge House an efficient Iron Bulkhead at the after end? Yes.

How are the openings closed? Weather boards full height in riveted channels.

Is the Forecastle at least as high as the main or top-gallant rail? Yes. Has the Forecastle an efficient Iron or Wood Bulk'd. at after end? ✓

Are the Engine and Boiler openings covered by a Bridge, Poop, Raised Quarter Deck, or enclosed by a Strong Iron or Steel Deckhouse? By. Shelter deck.

If the openings are not so protected are the exposed parts of the Casings efficiently constructed? ✓

Give thickness of plating; scantlings and spacing of Stiffeners ✓

What is the height of the exposed Casings? 8'-0 Are suitable means provided for closing all openings in them in bad weather? Yes.

Are the Weather Deck Hatchways efficiently constructed and at least equal to the requirements of Section 28 of the Rules for 1904-5? Give particulars below:— Yes As per Rule under.

Position and Size.	Shelter DK. N°1. 24' x 20'	N°2. 30' x 20'	N°3. 24' x 20'	N°4. 33' - 20'	N°5. 30' x 20'
Item.	Ship.	Rule.	Ship.	Rule.	Ship.
COAMING. Thickness { Sides..... Thickness { Ends.....	33"- .14"- .14"-	as fitted	33"- .14"- .14"-	as fitted	33"- .14"- .14"-
SHIFTING BEAMS OR WEB PLATES. { Number Section and Scantlings Material Steel	5 Plate 12x36 A. Angles 4x3x.144	11	5 Plate 13x34 Angles 4x3x.144	11	5 Plate 13x36 Angles 4x3x.144
* FORE AND AFTERS. { Number Section and Scantlings Material	None	None	None	None	None
HATCHES Thickness	2 3/4	2 3/4	2 3/4	2 3/4	2 3/4
Remarks.....					

* When the Fore and Afters are of wood the depth should be stated from the underside of the hatches.

(If the sill of the lowest side scuttle will be less than 6 inches above the Indian Summer Load Line if assigned under the tables, state vertical distance from top of deck at side amidships to lower edge of lowest side scuttle.)

The following information is to be given in all Cases of vessels dealt with under Paras. 11, 12 (under 15 feet Moulded depth) and under Shelter Deck Rules.

What is the thickness of the Bridge Sheerstrake? .67. Strake between Main and Bridge Sheerstrakes? .67.

Delete the words { The Crew are, are not, berthed in the bridge house.

that do not apply { The arrangements to enable them to get backwards and forwards from their quarters are, are not satisfactory.

Length of Bulwarks in well .6'-0"


Area of Freeing Ports required by Para. 11 (e) each side of vessel =

Sq. ft.

Ft. Tenths. Ft. Tenths. No.

In Tonnage Well. 2.0 x 1.0 x 1 - } Freeing Ports (each side of vessel) = Sq. ft.

Total deficiency or excess = Sq. ft.

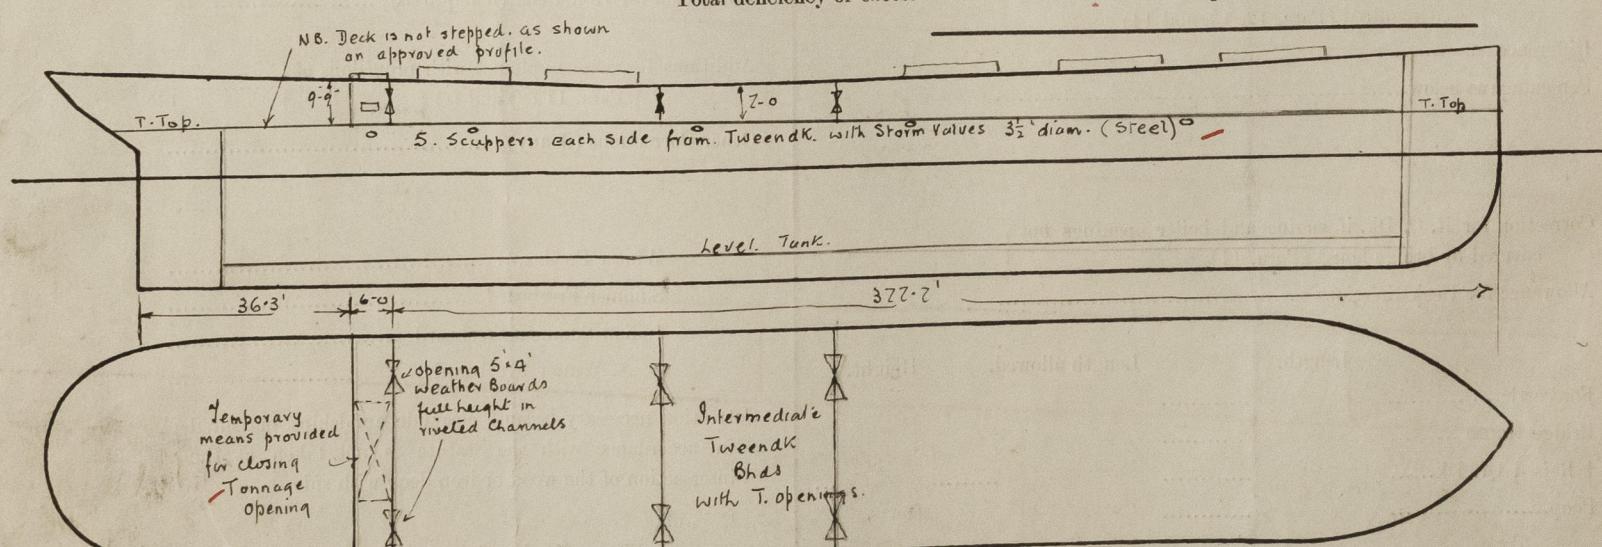

Show hereon line of Floors or Tank Top with position of any Breaks in same; also height of Peak Tank tops, &c., &c.

State any special features in the construction of the Vessel

Approved plans of this vessel are filed in the London office.

Request form forwarded herewith

Owners: Bank Line Ltd. (A. Weir & Co. Mgrs.)

, Address

Fee £ 10 : - : - Received by me
To be charged with First Entry.

See T.C. Report

© 2021

Lloyd's Register
Foundation

and in reply thereto I think it well to observe that the requirement to fit storm valves *S/S. "DEE BANK"* Belfast Report 10164.

S/S "DEEBANK"

Belfast Report 10164.

2nd Deck Hatchways

Are the Weather Deck Hatchways efficiently constructed and at least equal to the requirements of Section 28 of the Rules for 1904-5? Give particulars below:—

Are the Weather Deck Hatchways efficiently constructed and at least equal to the requirements of Section 28 of the Rules for 1904-5? Give particulars below:-					2nd Deck Hatchways				
Position and Size.	No. 1. Forward : 24 x 20	No. 2 : 30 x 20	No. 3 : 27 x 20		Deep Tank : 9'-0" Ship Post r Starbd.	No. 4, 21 x 20	No. 5 : 30 x 20	No. 6, 5-4 x 12-0 (tonnage well)	
Item.	Ship.	Rule.	Ship.	Rule.	Ship.	Ship.	Rate.	Ship.	Ship.
COAMING. Height above top of DECK	9" Bulk A. ·40 do.	9" B.A. ·40 do.	9' 8A - ·40 do		9" - ·40 ·40	Bull Angle ·40	9' ·40 ·40	26 $\frac{1}{2}$ ·464 ·40	
Thickness { Sides..... Thickness { Ends.....									
SHIFTING BEAMS OR WEB PLATES. { Number	5	5	3" & inter. malle Bulkhead		None	3	5		
PLATES. { Section and Scantlings	7" 20 x 38	7" 18 x 36	7" One at 20 x 36			7" - 19 x 36	7" - 19 x 36		
Material Steel	24 Angles 4 x 3 x 44	24 Angles 4 x 3 x 44	Two @ 16 x 36 2 Angles. 4 x 3 x 44			24 Angles 4 x 3 x 44	24 Angles 4 x 3 x 44		
* FORE AND AFTERS. { Number	None	None	None		None	None	None	None	
Material									
HATCHES Thickness	2 $\frac{3}{4}$	2 $\frac{3}{4}$	3"		Stiffened Plastic Coverd.	2 $\frac{3}{4}$	2 $\frac{3}{4}$	2 $\frac{3}{4}$	
Remarks.....	as to advise								

0152 2/2