

Hand copy


No 412 and 16 PROFILE & DECK PLANS.

DIMENSIONS:- 382'-6" B.P. x 51'-9" MLD. x 29'-0" MLD. TO UPPER DK.


SCALE $\frac{1}{8}" = 1\text{ FT.}$

CLASS 100 A.1.


Andreas; bracing, masts, steering gear supported to Surveyors satisfaction

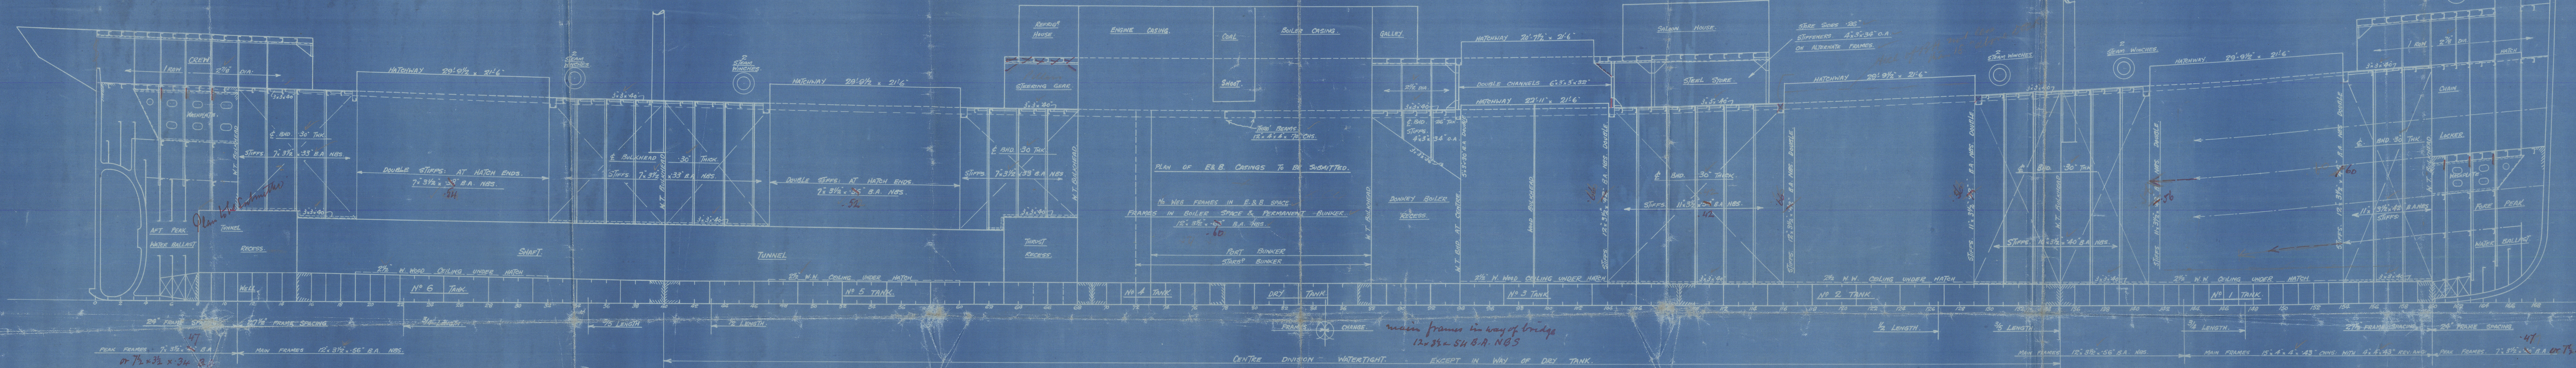


POOP DK:

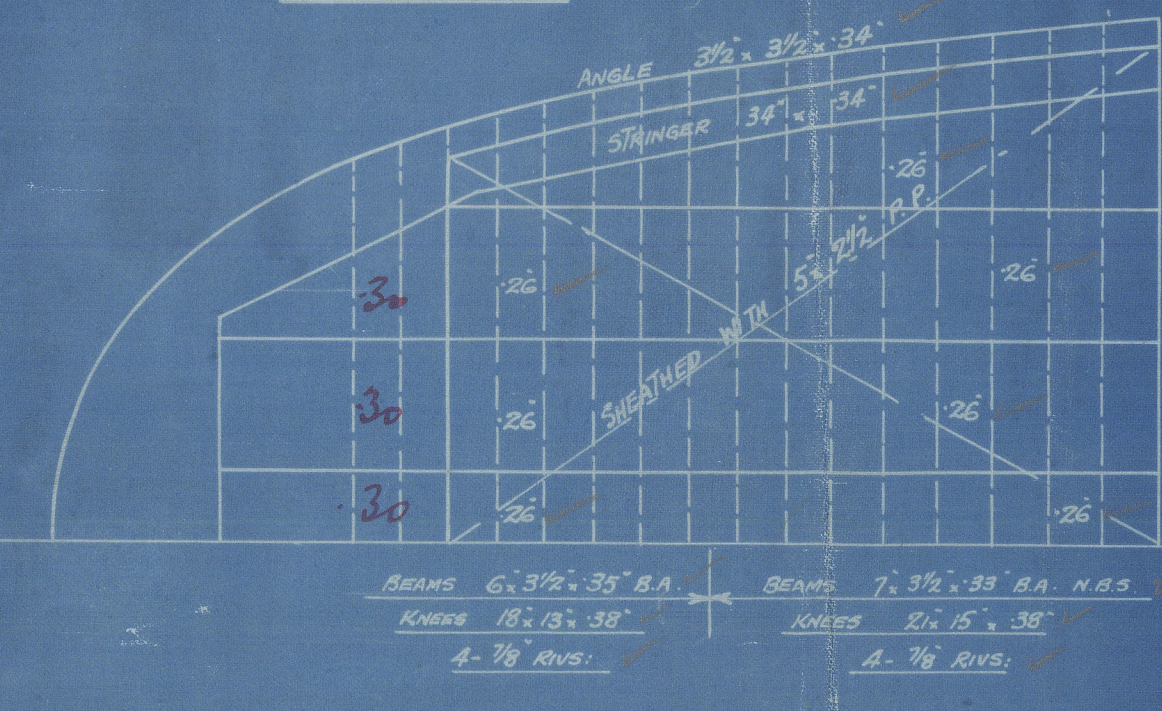

BRIDGE DECK.

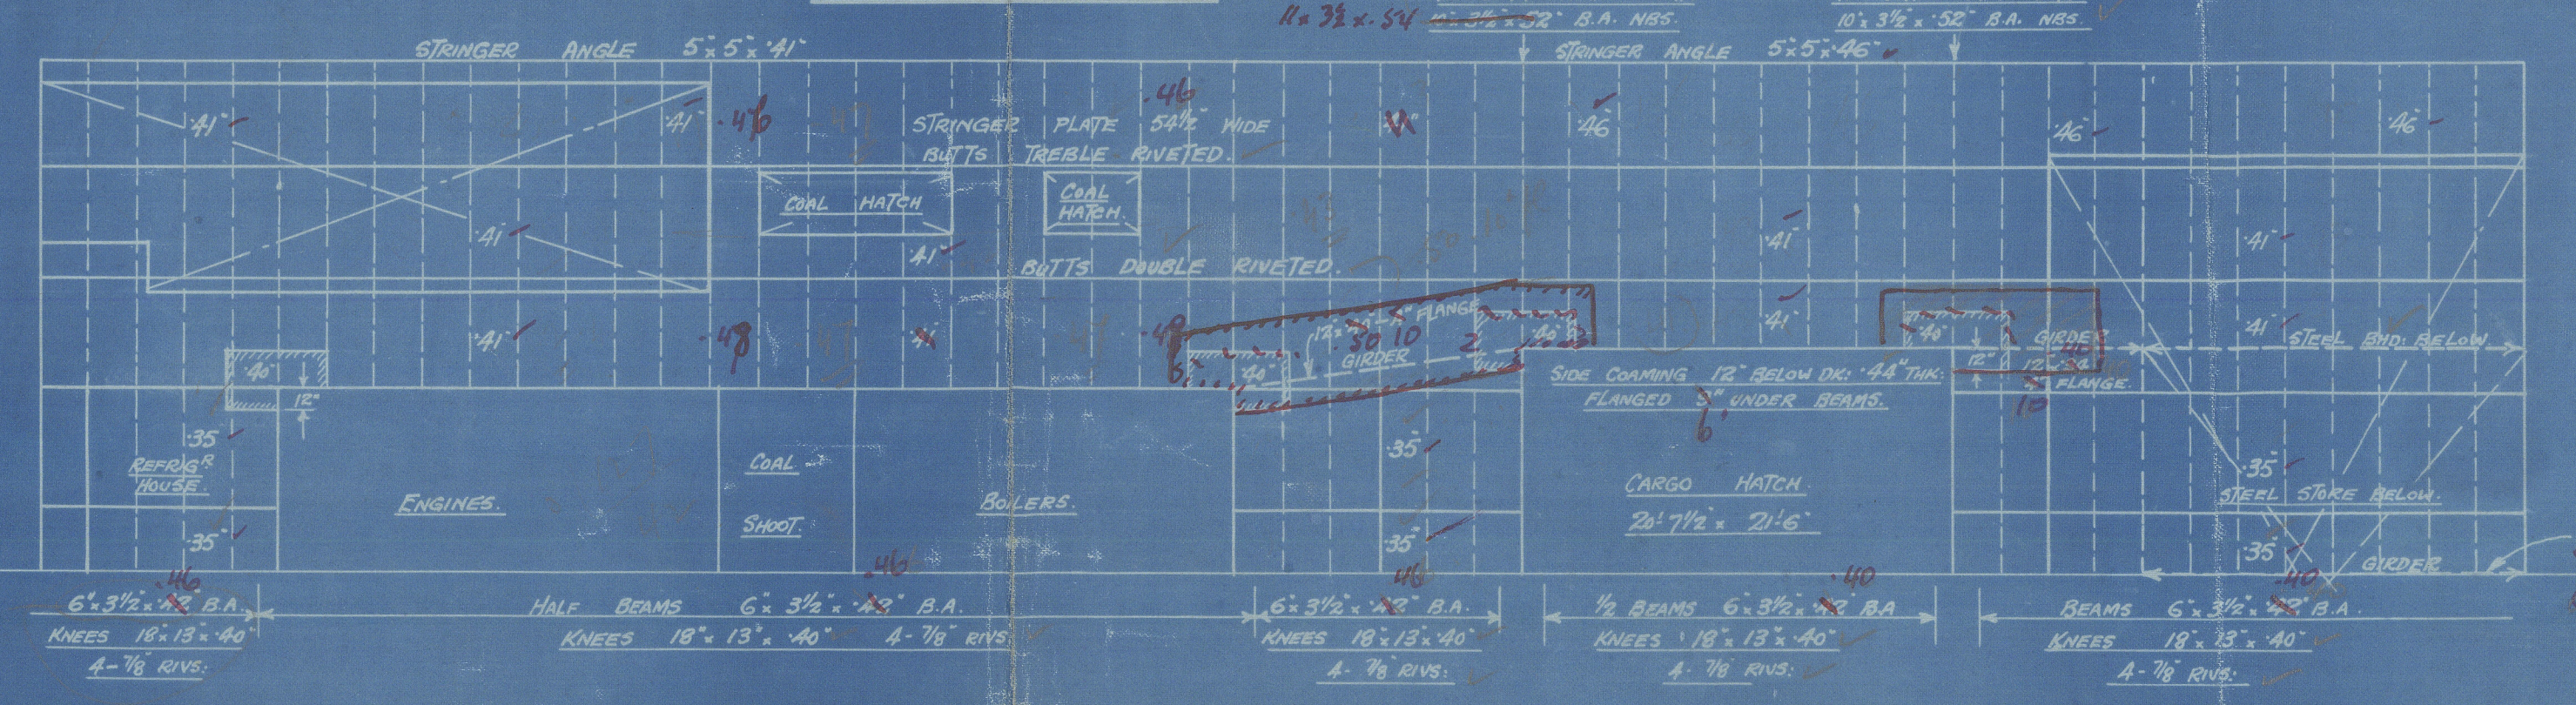

FO'LE DK:

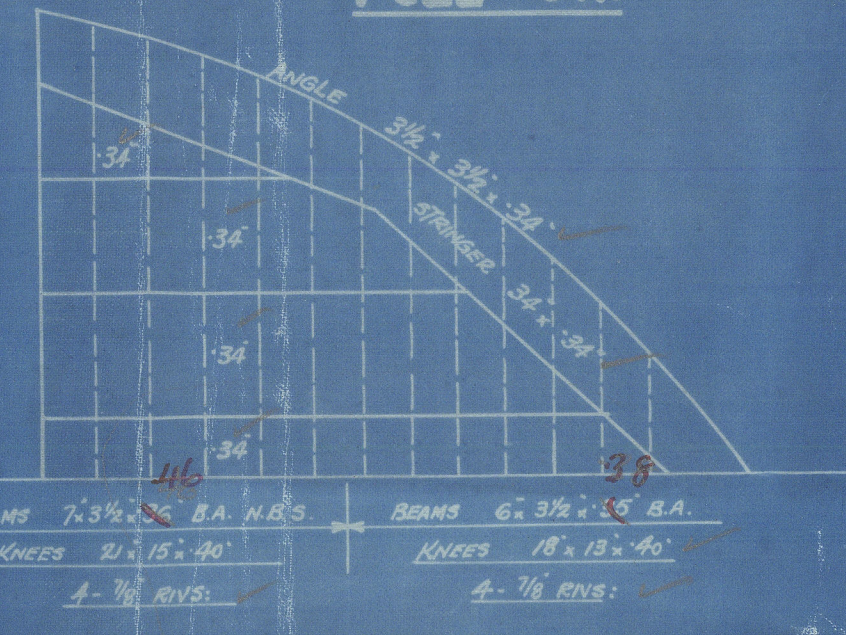

UPPER DK:



UPPER DK:

20478
2.600

Profile and decks

W^o-412 and 16

Northumbrian SB Co (1927) Ltd.

office

GEN. BOX NO

651

c. S.B. ~~Woodward~~ Wearwood

Lakerberg & —

NWB. 8515 1/2

CARITA

EX

Lakerberg



© 2021

Lloyd's Register
Foundation

010369-010377-0295