

F 189


2982

# Lloyd's Register of Shipping.

Ship's Name LOKERBERG Official No. 68430


Memorandum of alterations reported since ship was surveyed for assignment of Load Lines in \_\_\_\_\_

## FREEBOARD DECK

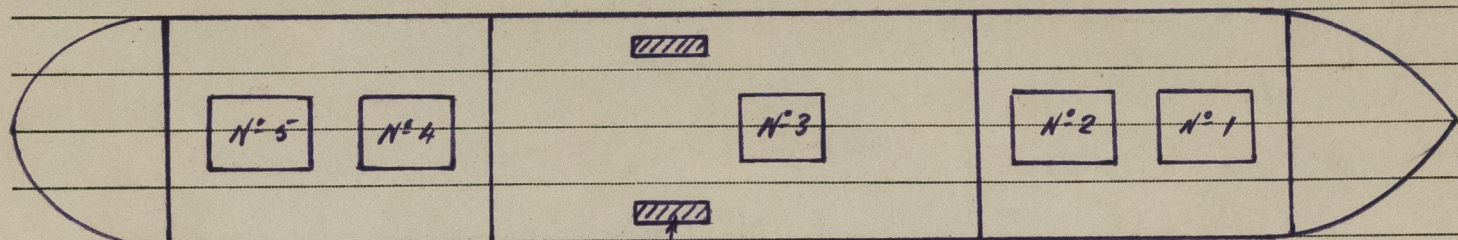

TRIMMING HATCH P+S REMOVED  
OPENING IN DECK PLATED OVER

## BRIDGE DECK

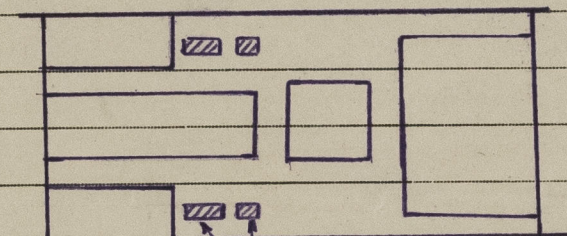

TRIMMING HATCHES P+S REMOVED  
AND OPENINGS IN DECK PLATED OVER

ASH CHUTE REMOVED & OPENING IN SHIPS SIDE PLATED OVER

## BOAT DECK

AIR PIPES FROM NEW O.F. BUNKERS & SETTLING TANKS LED TO BOAT DECK

GOOSENECKS 18" HIGH FITTED WITH WIRE GAUZE & EFFICIENT CLOSING APPLIANCES.

*[Signature]*  
BREMEN 4.4.55.

14 APR 1955