

# RUDDER & STERNFRAME


S.S. N° 338

SCALE 1"=1 FOOT


SPEED OF VESSEL = 10 KNOTS

## DETAIL OF PINTLE







SCALE 3"=1 FOOT

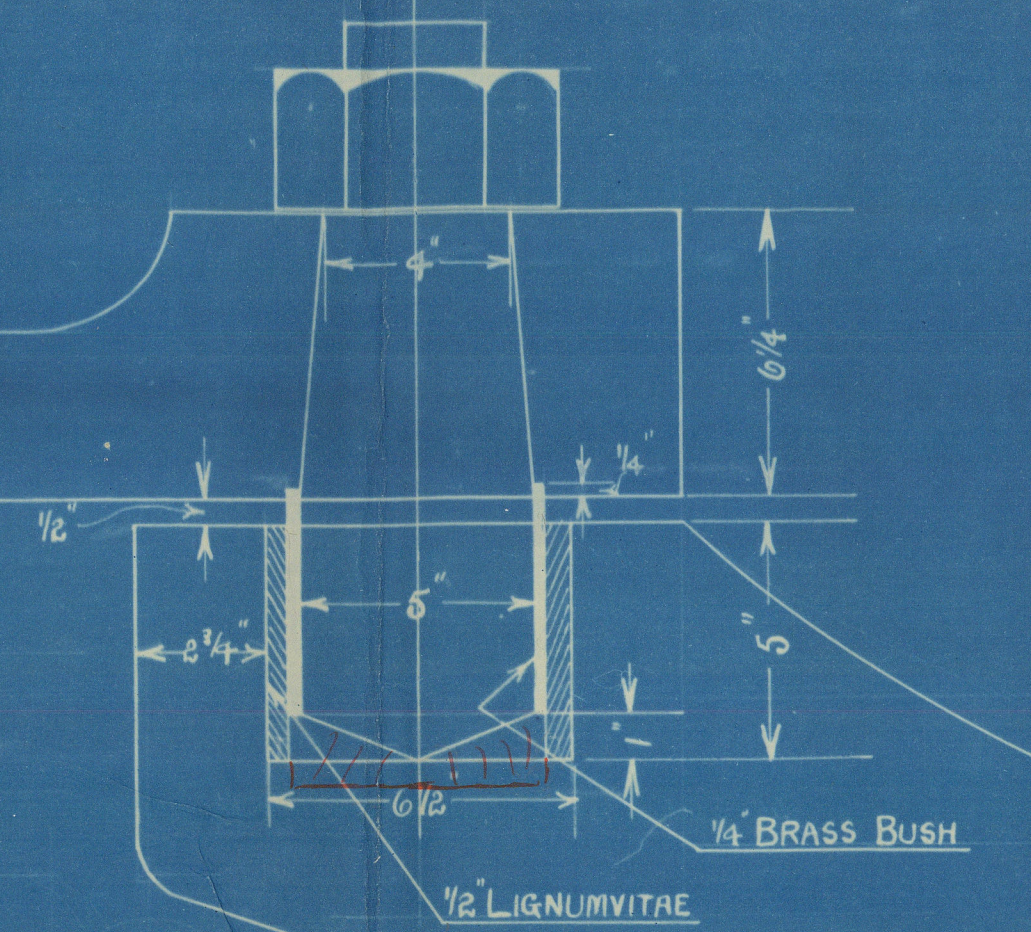

## QUADRANT

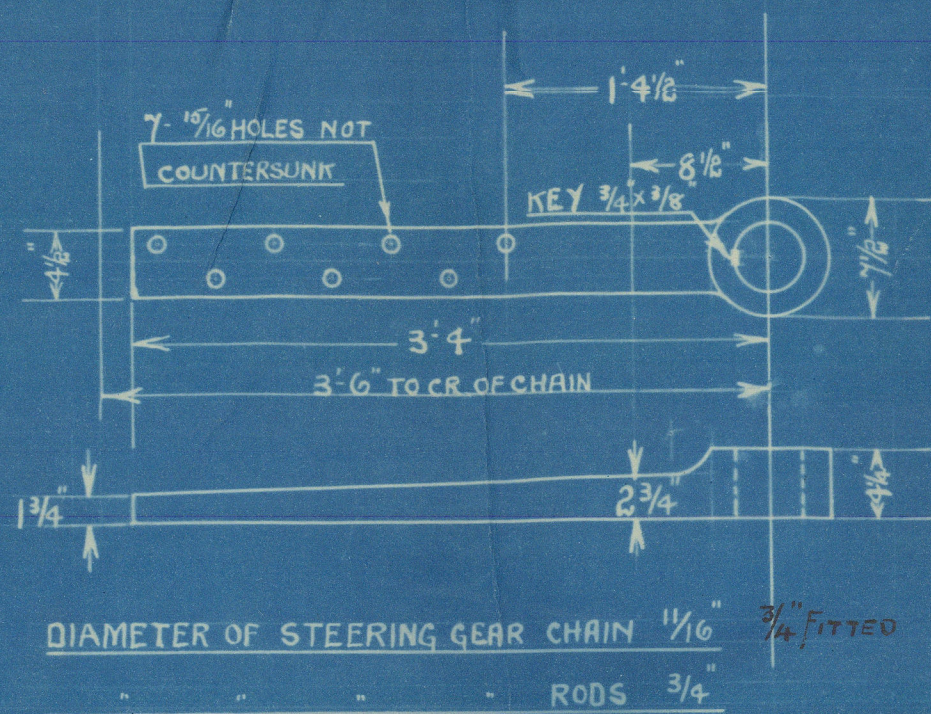


## PORTABLE STOPPER

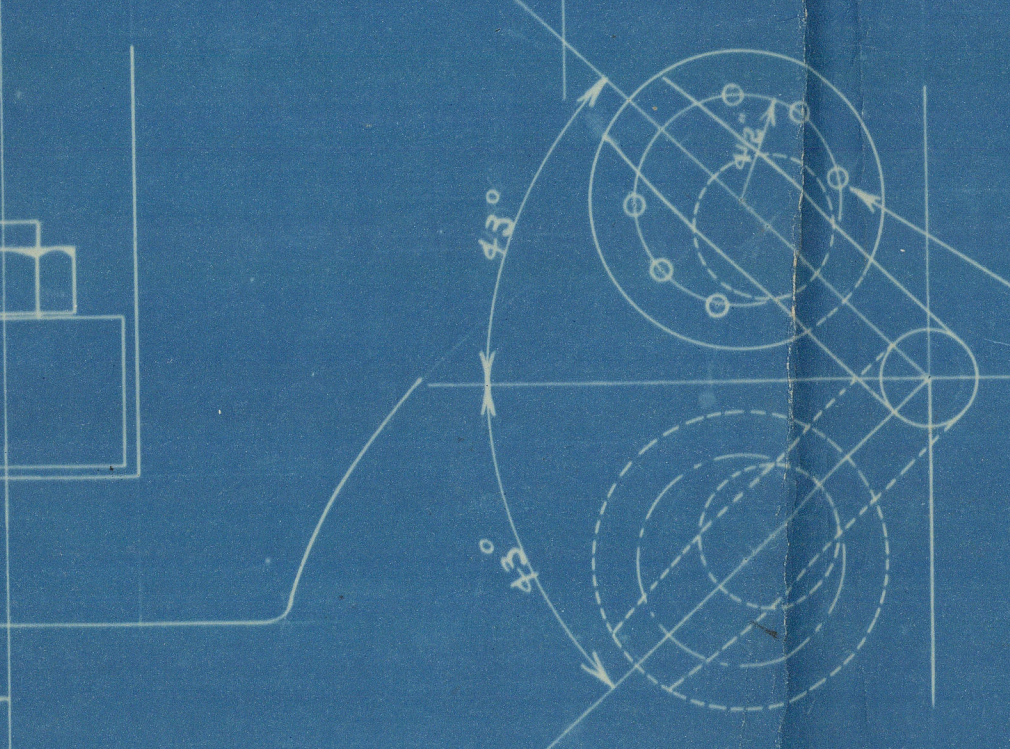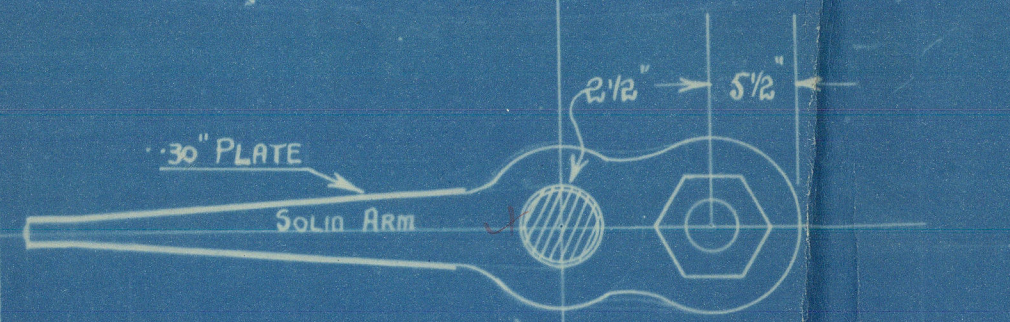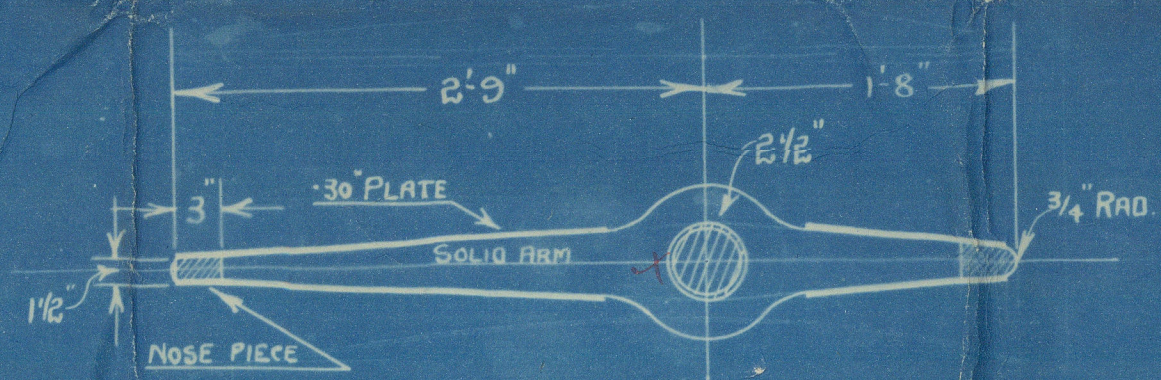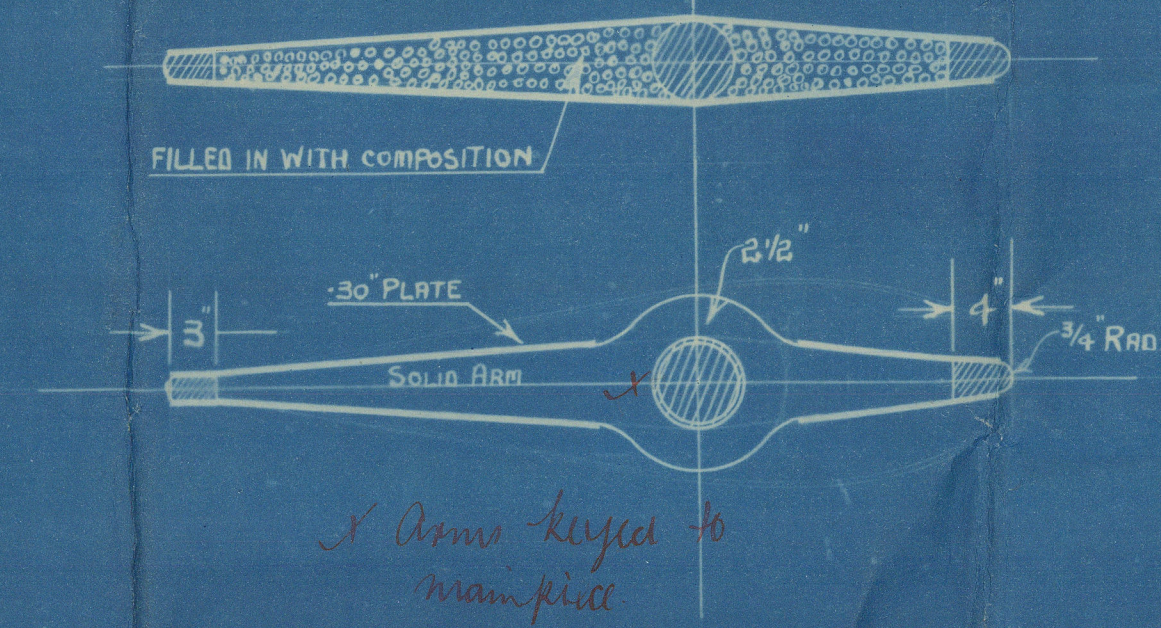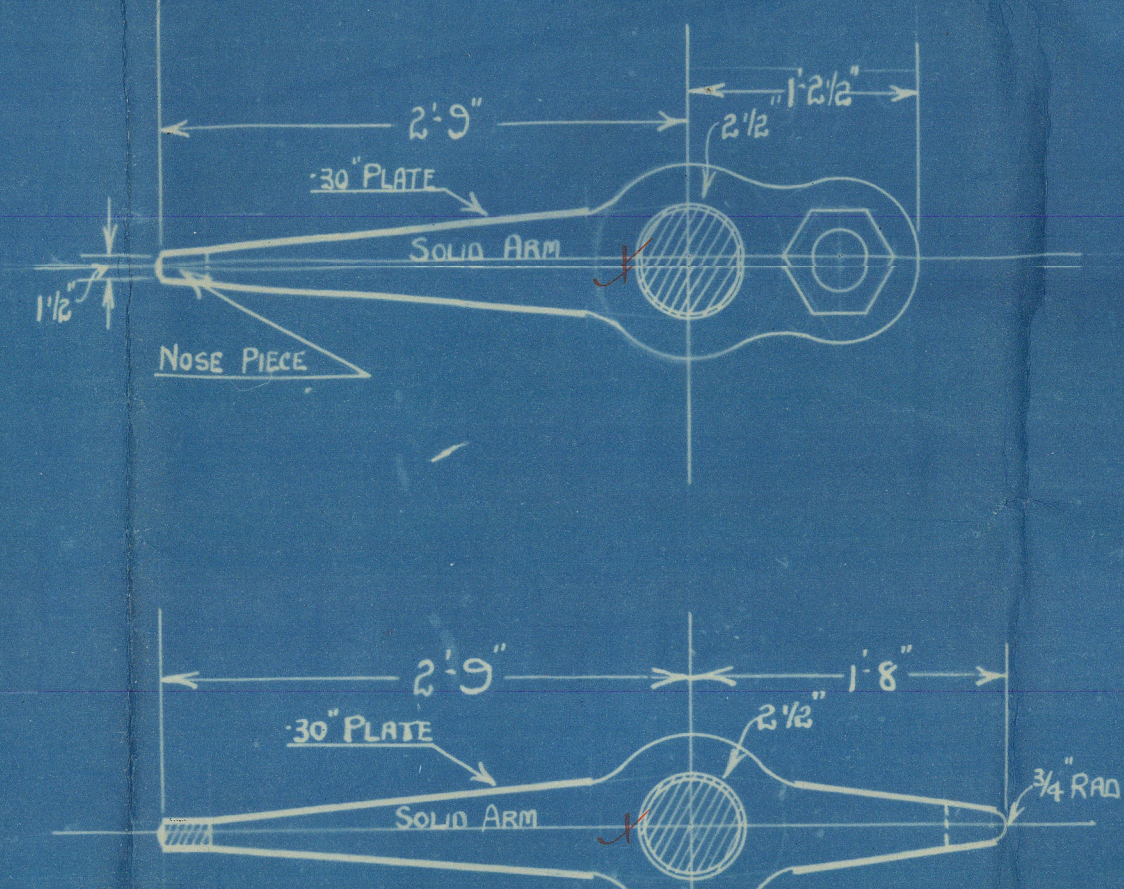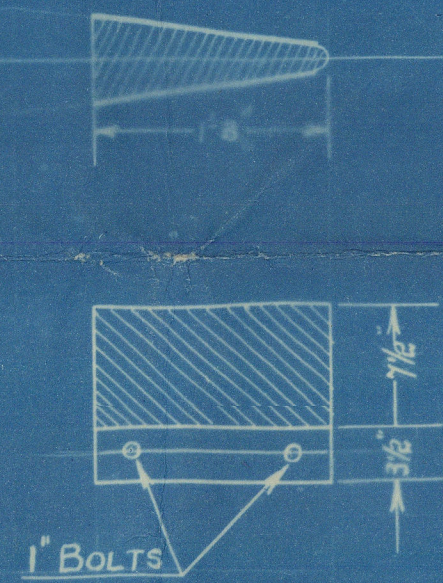


## DETAIL OF COUPLING


SCALE 1 1/2"=1 FT.

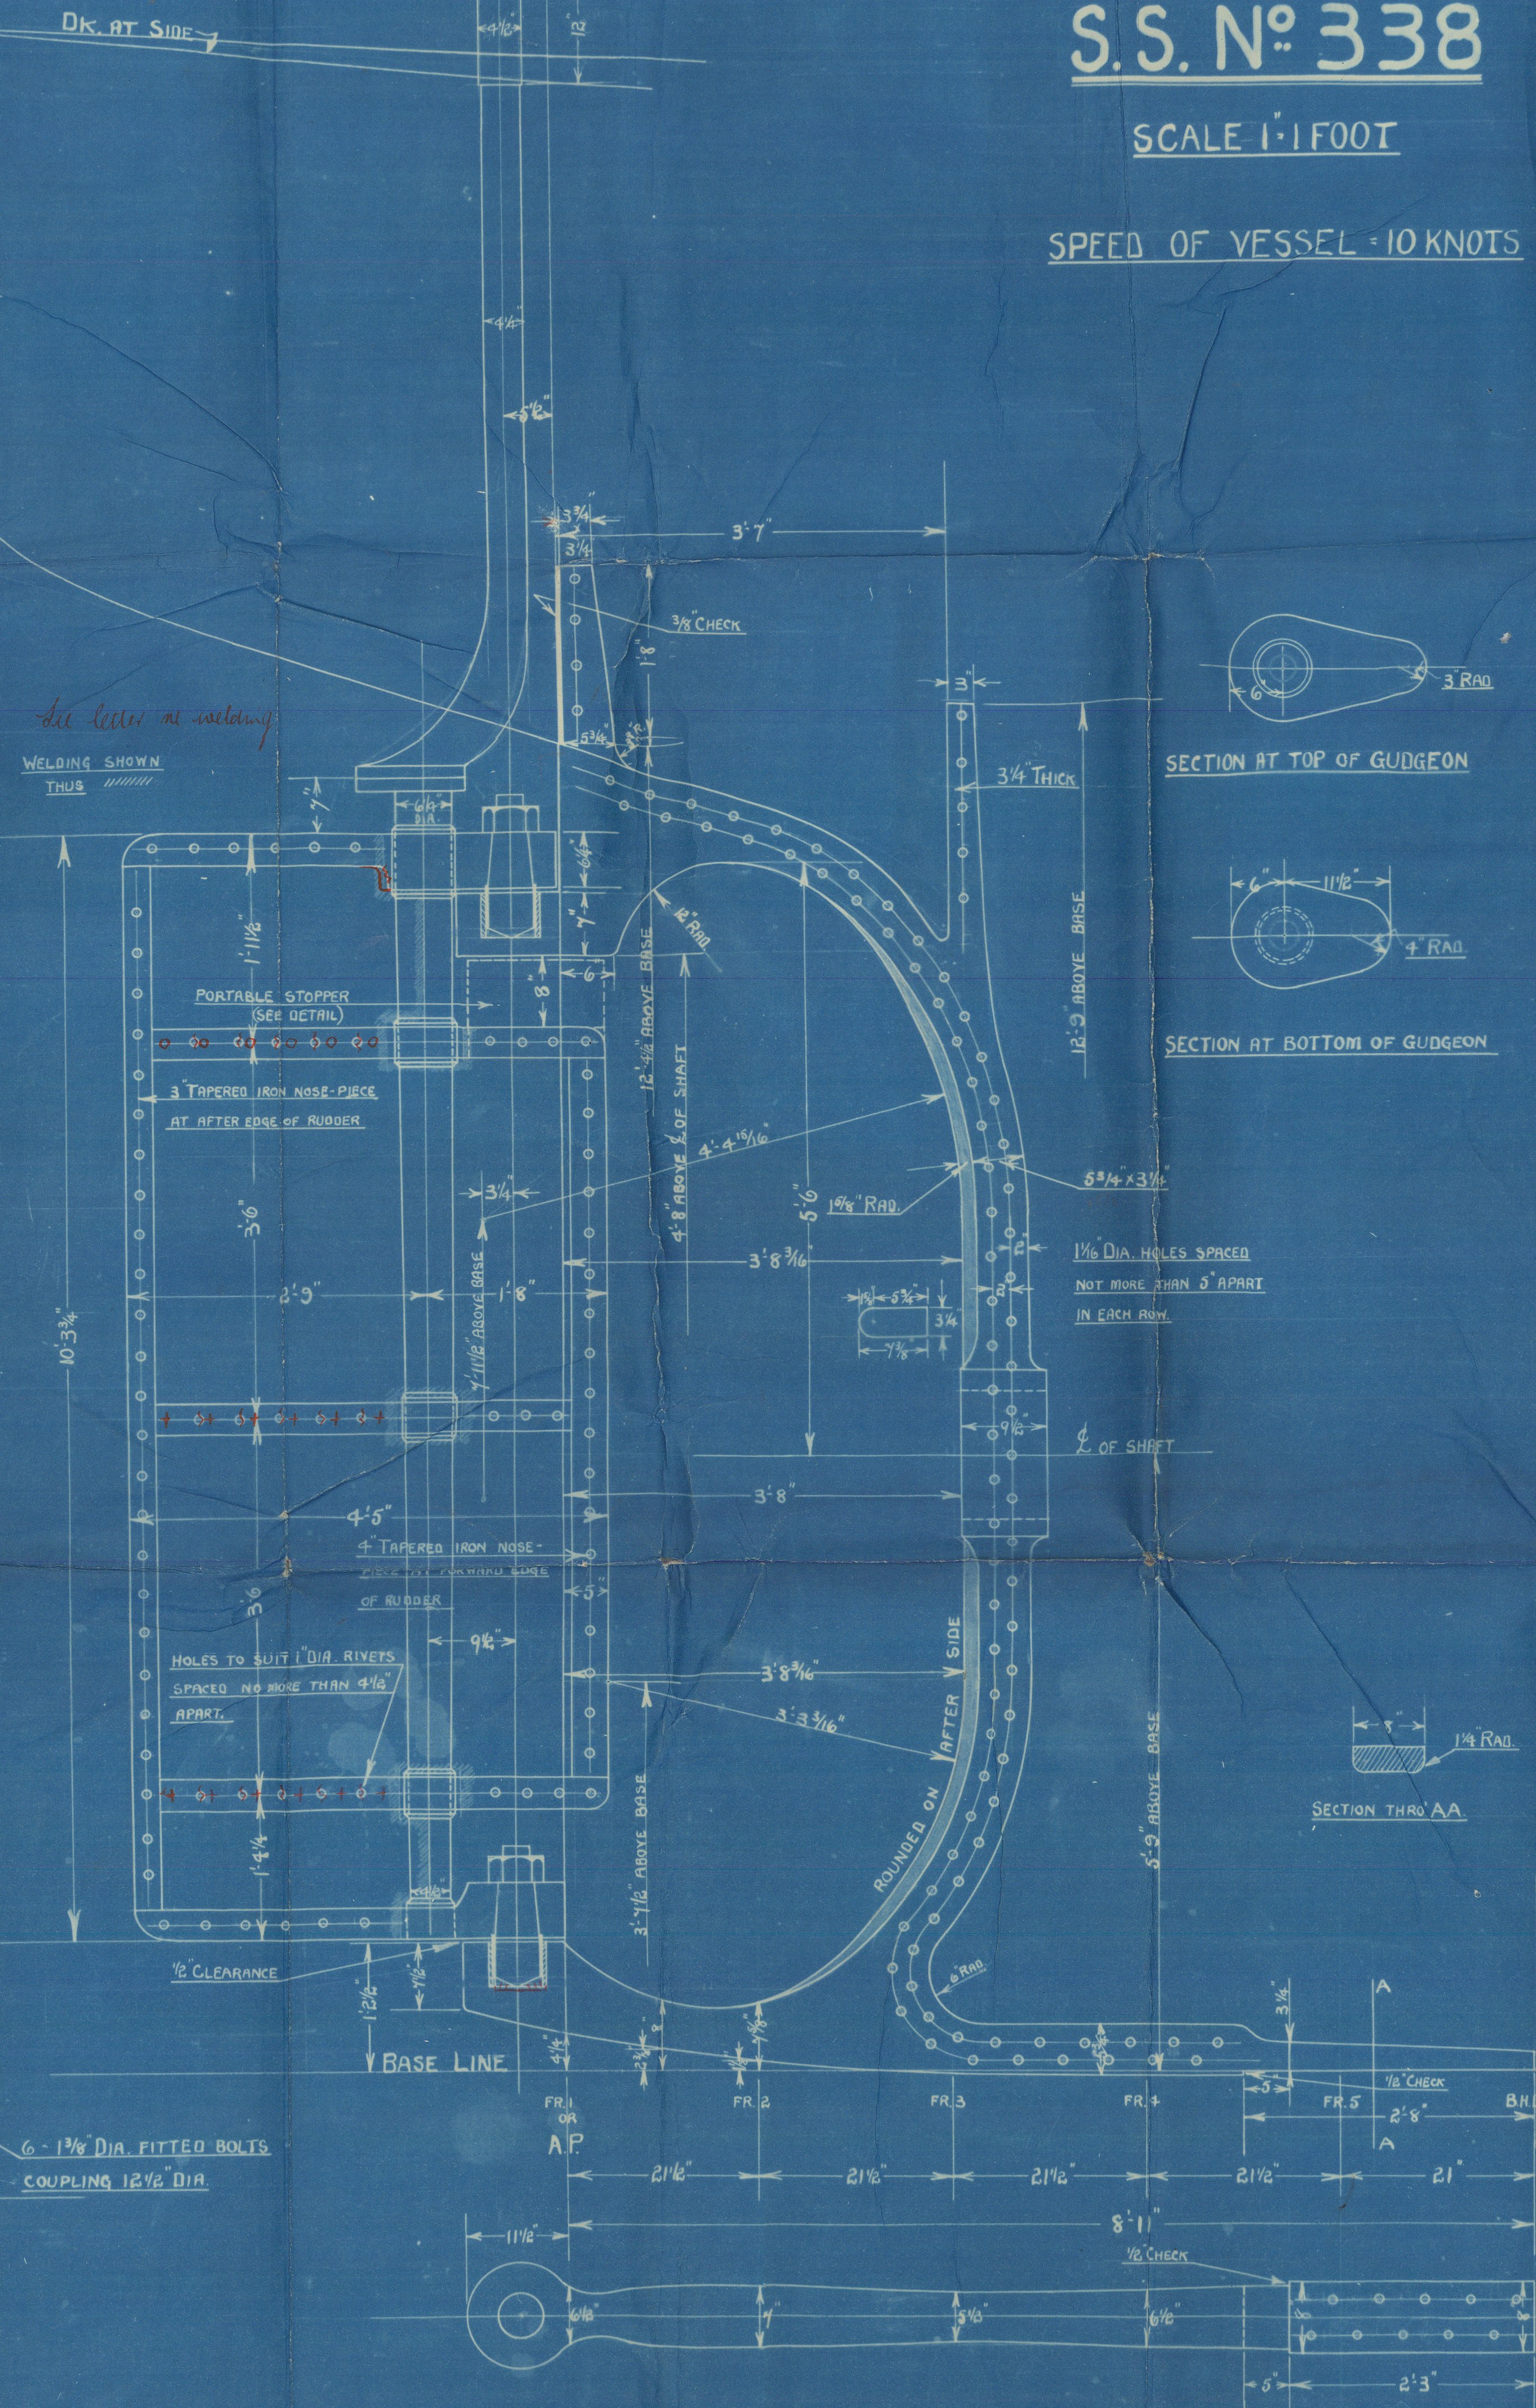



## SECTION AT TOP OF GUDGEON

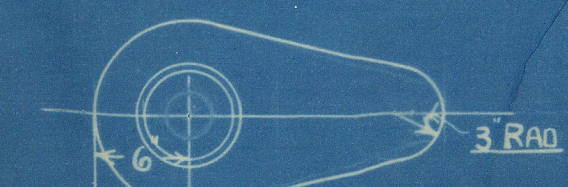

## SECTION AT BOTTOM OF GUDGEON

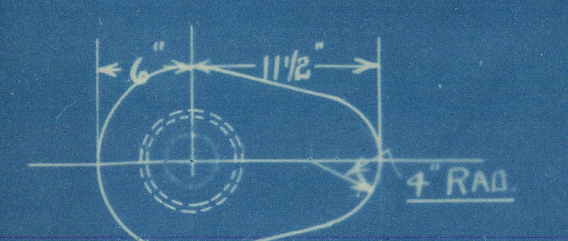

## SECTION THRO' AA

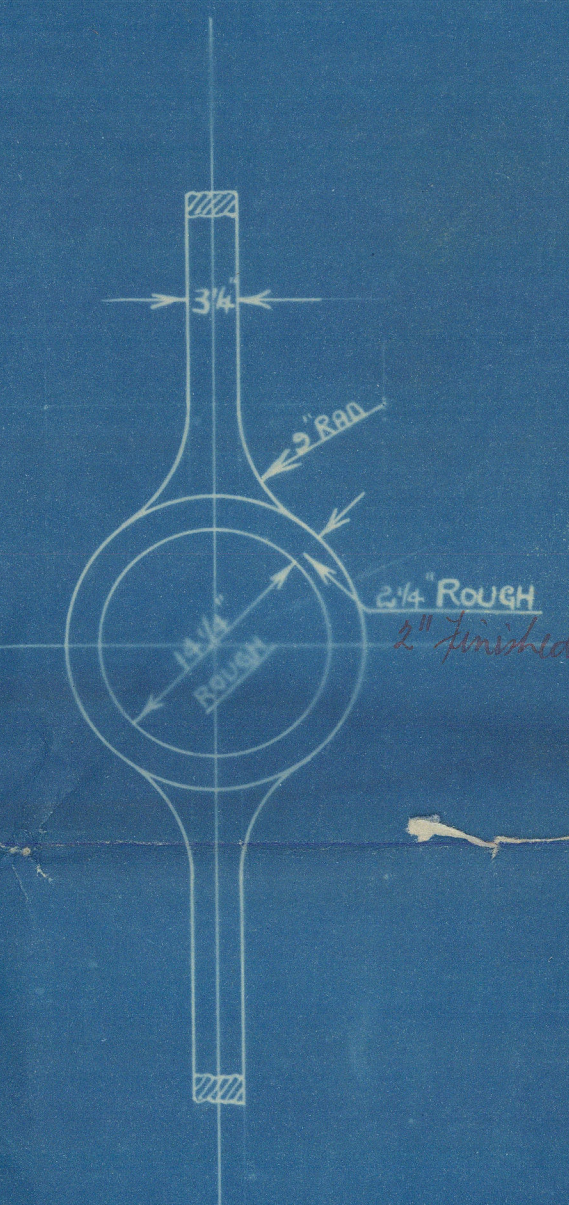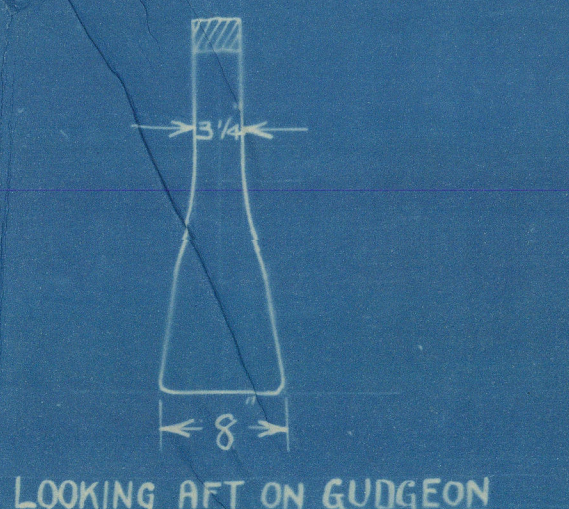

APPROVED  
LLOYD'S REGISTER OF SHIPPING  
Hickman  
DATE 5-2-36



*Nessy Scott & Son*

*Yard No 338*

*Radder Stemframe*

CUMA

M/M 10424

X  
*Pyrope*

GLASGOW REPORT No. 57275



© 2021

Lloyd's Register  
Foundation

010416 - 010427 - 0224