

N<sup>o</sup> 1010.  
PROFILE AND DECK PLANS.  
DIMENSIONS - Length BP 480.0 Breadth MP 61.0 Depth MP 35.9 to U. incl. 1/100 Scale.

LLOYDS 100 A.1. CLASS (SHADE DECK)  
AND REGISTRO NAZIONALE ITALIANO \* CLASS

TWIN SCREEN.

APPROXIMATE UNDER DECK TONNAGE TO UPPER DECK = 5120

" " " " " SHADE " = 6920

PLAN OF MATCHES  
TO BE SUBMITTED.

FORECASTLE DECK

STINGER Angle 85-25-30. SIDE PLATING 44"  
STINGER PLATE 24-25"  
OUT IS OVERLAPPED + DOUG. C. RUSTEN

PLAN OF CRUISER STERN  
9 BOSS FRAMING TO BE  
SUBMITTED


To be <sup>opening</sup> moved clear  
of ends of sections

compensation to be arranged in way of opening

ms  
- 18.8.15



6500-597010-197010

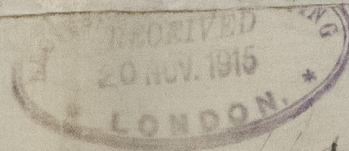

162-1070

Profile and Deck  
plans

as approved by

Lloyds

28/8/15-

Designs for Cuba



Havana

"Alfonso XIII"

Blo 6279.

010461-010465-0059



© 2021

Lloyd's Register  
Foundation