

7 FEB 1949

Index No.

Lloyd's Register of Shipping.

Ship's Name "MAYMERE"


Official No.

Memorandum of alterations reported since ship was surveyed for assignment of Load Lines in

The height of the coamings has now been increased to 450 mm and new hatchcovers of 65 mm thickness have now been supplied.

G. de Jong

Rotterdam 3 Feb 1949.

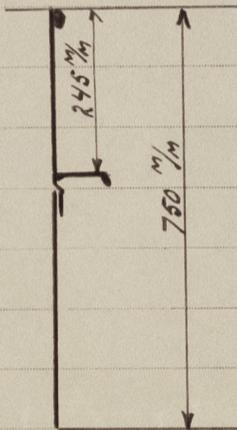

valid for
8- FEB 1949

Key



© 2021
Lloyd's Register
Foundation