

S.S. "Markab."


Tween Deck Bulkhead 68

Modification of Bulkheads 68 and 75

Considered & Approved for Tween Deck Bulkhead 68 only



Scale: 1/4" = 1 Foot

Typical detail of wing T.B.  
Connection to Bulkhead (Transverse Beam)

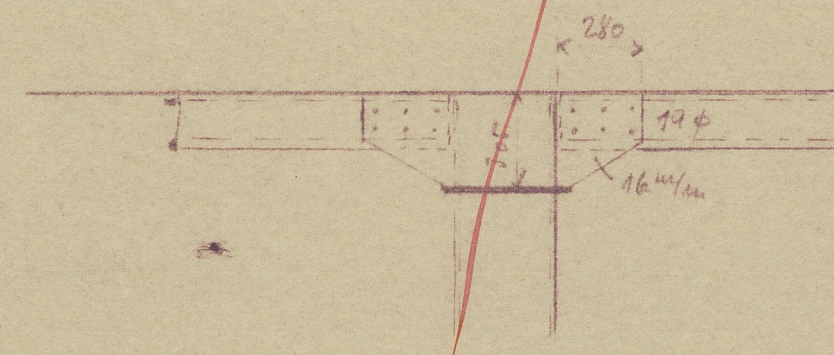


Section Frame 68

W.T. Bulkhead

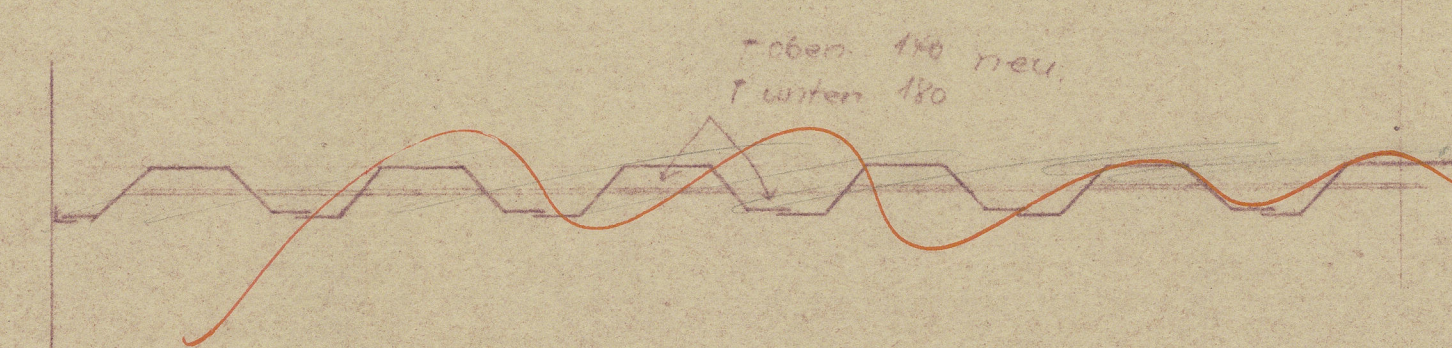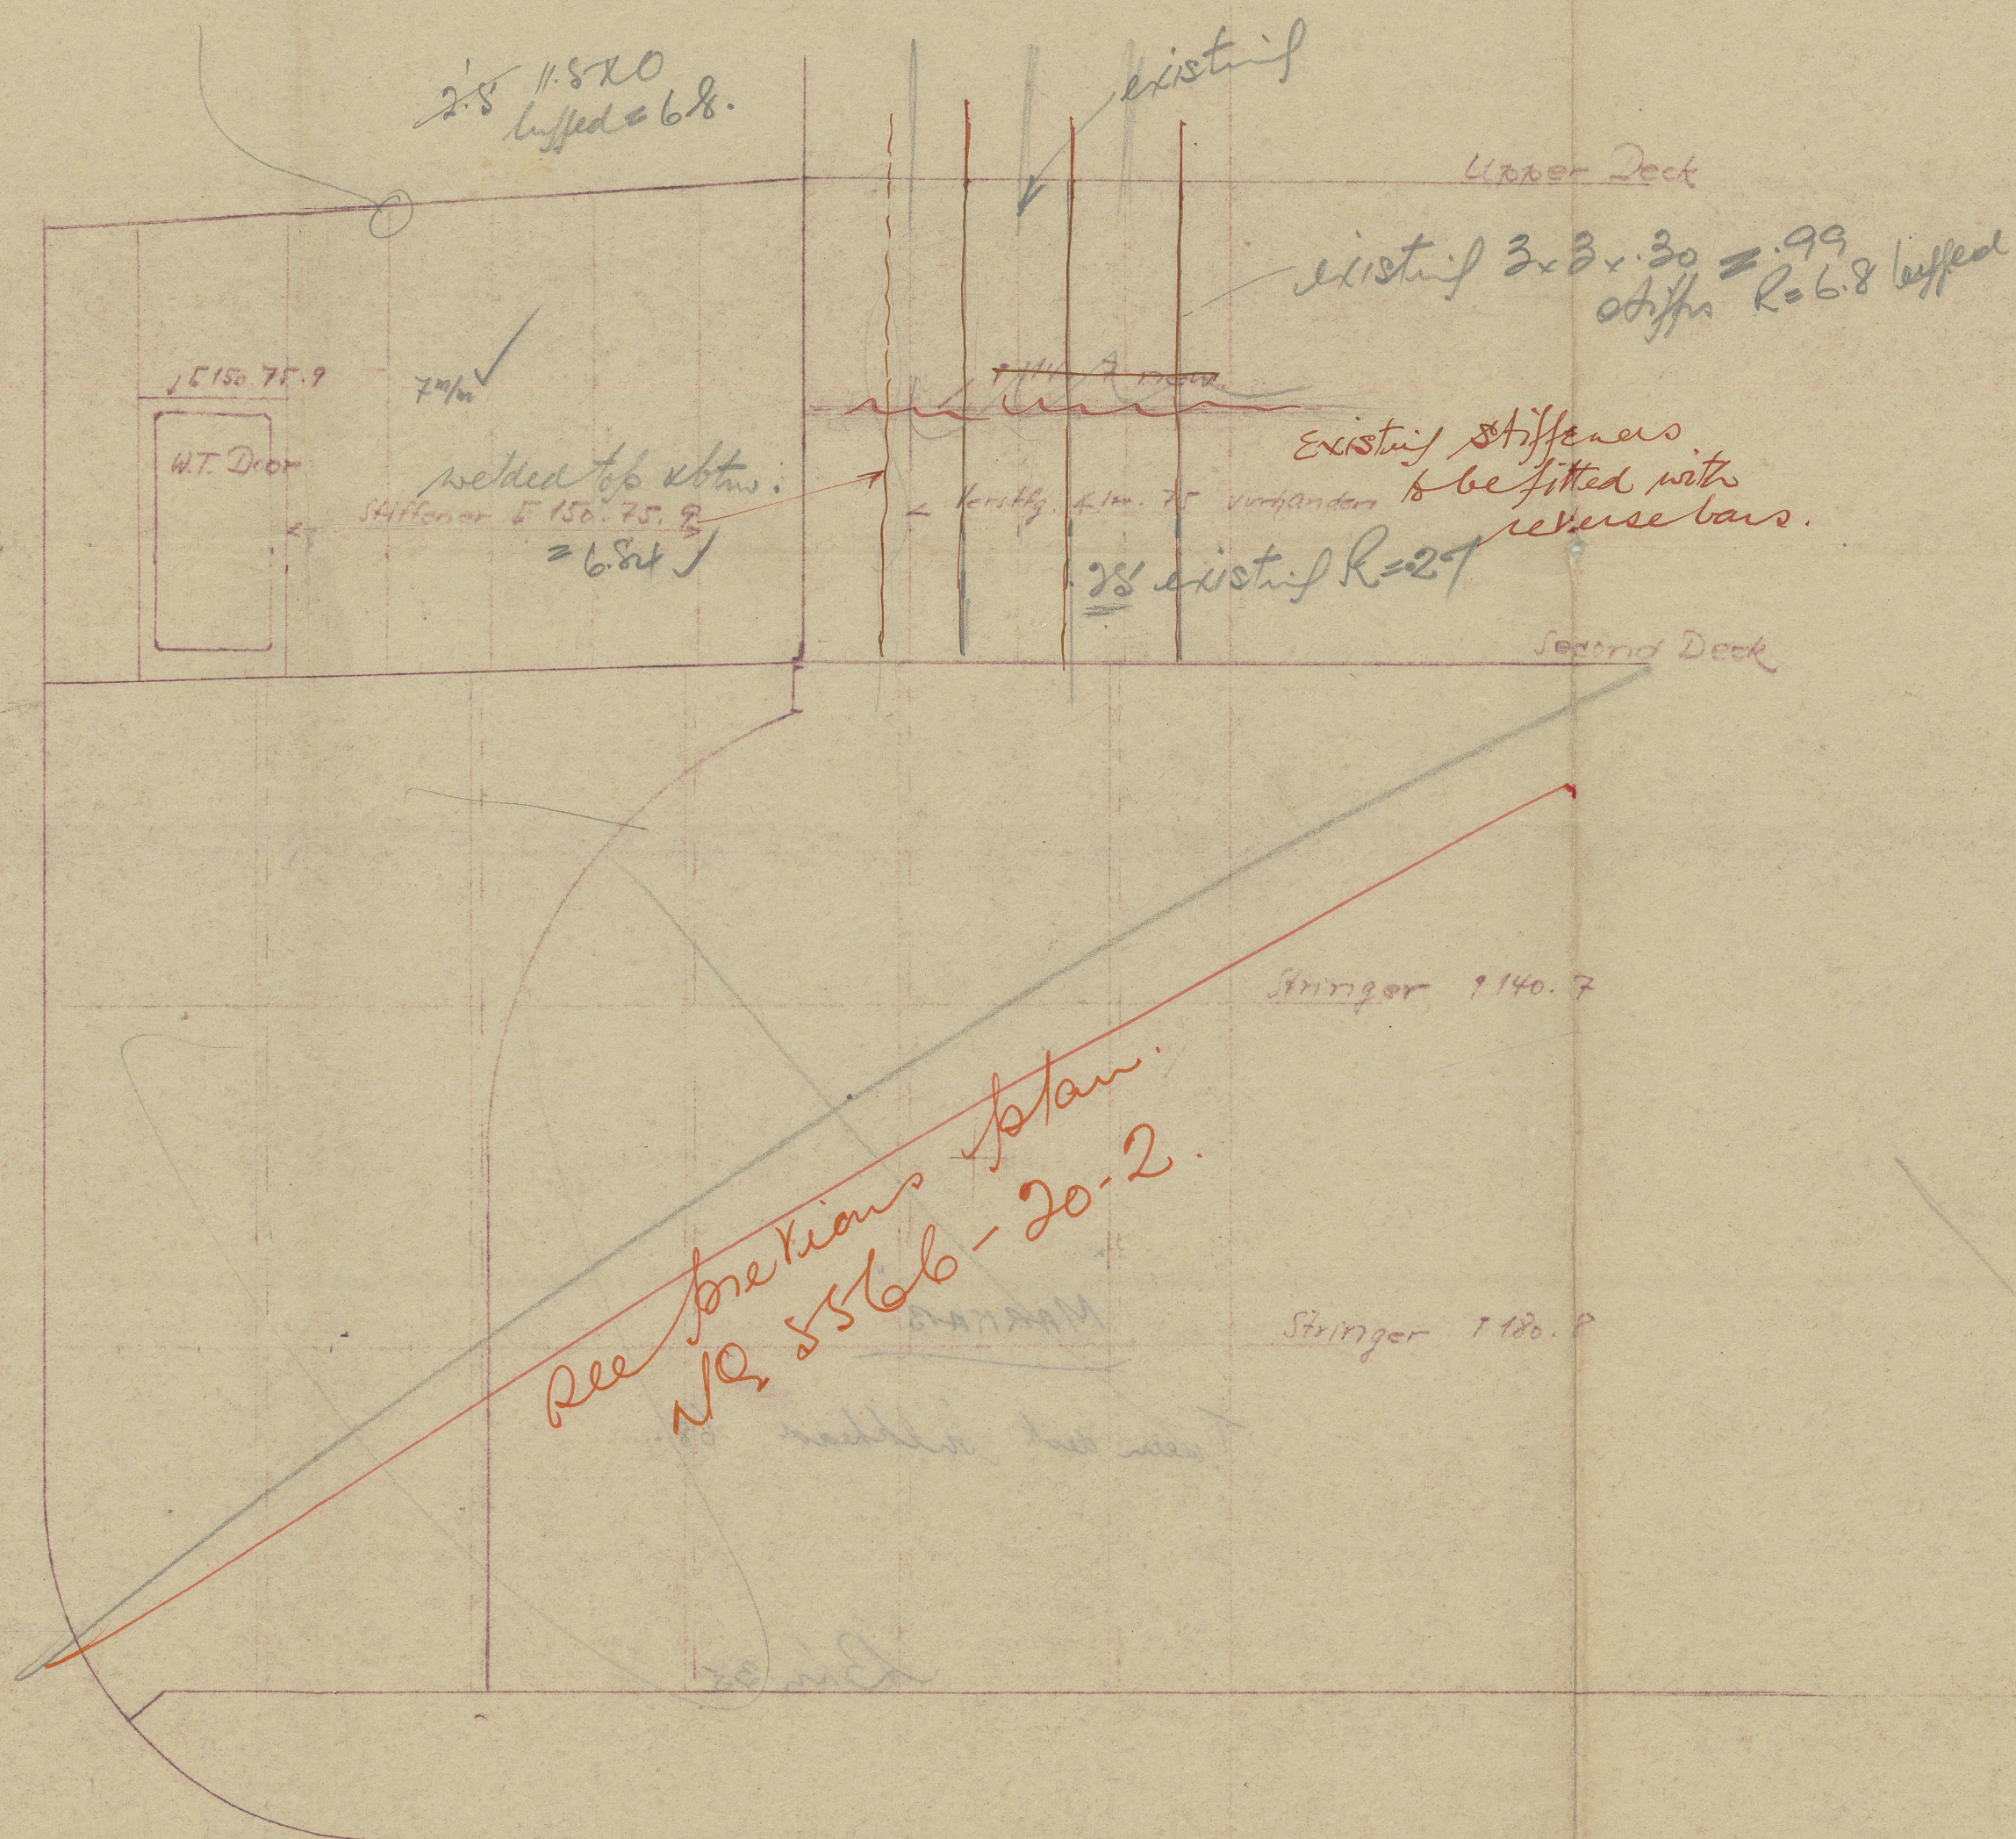

Section Frame 75

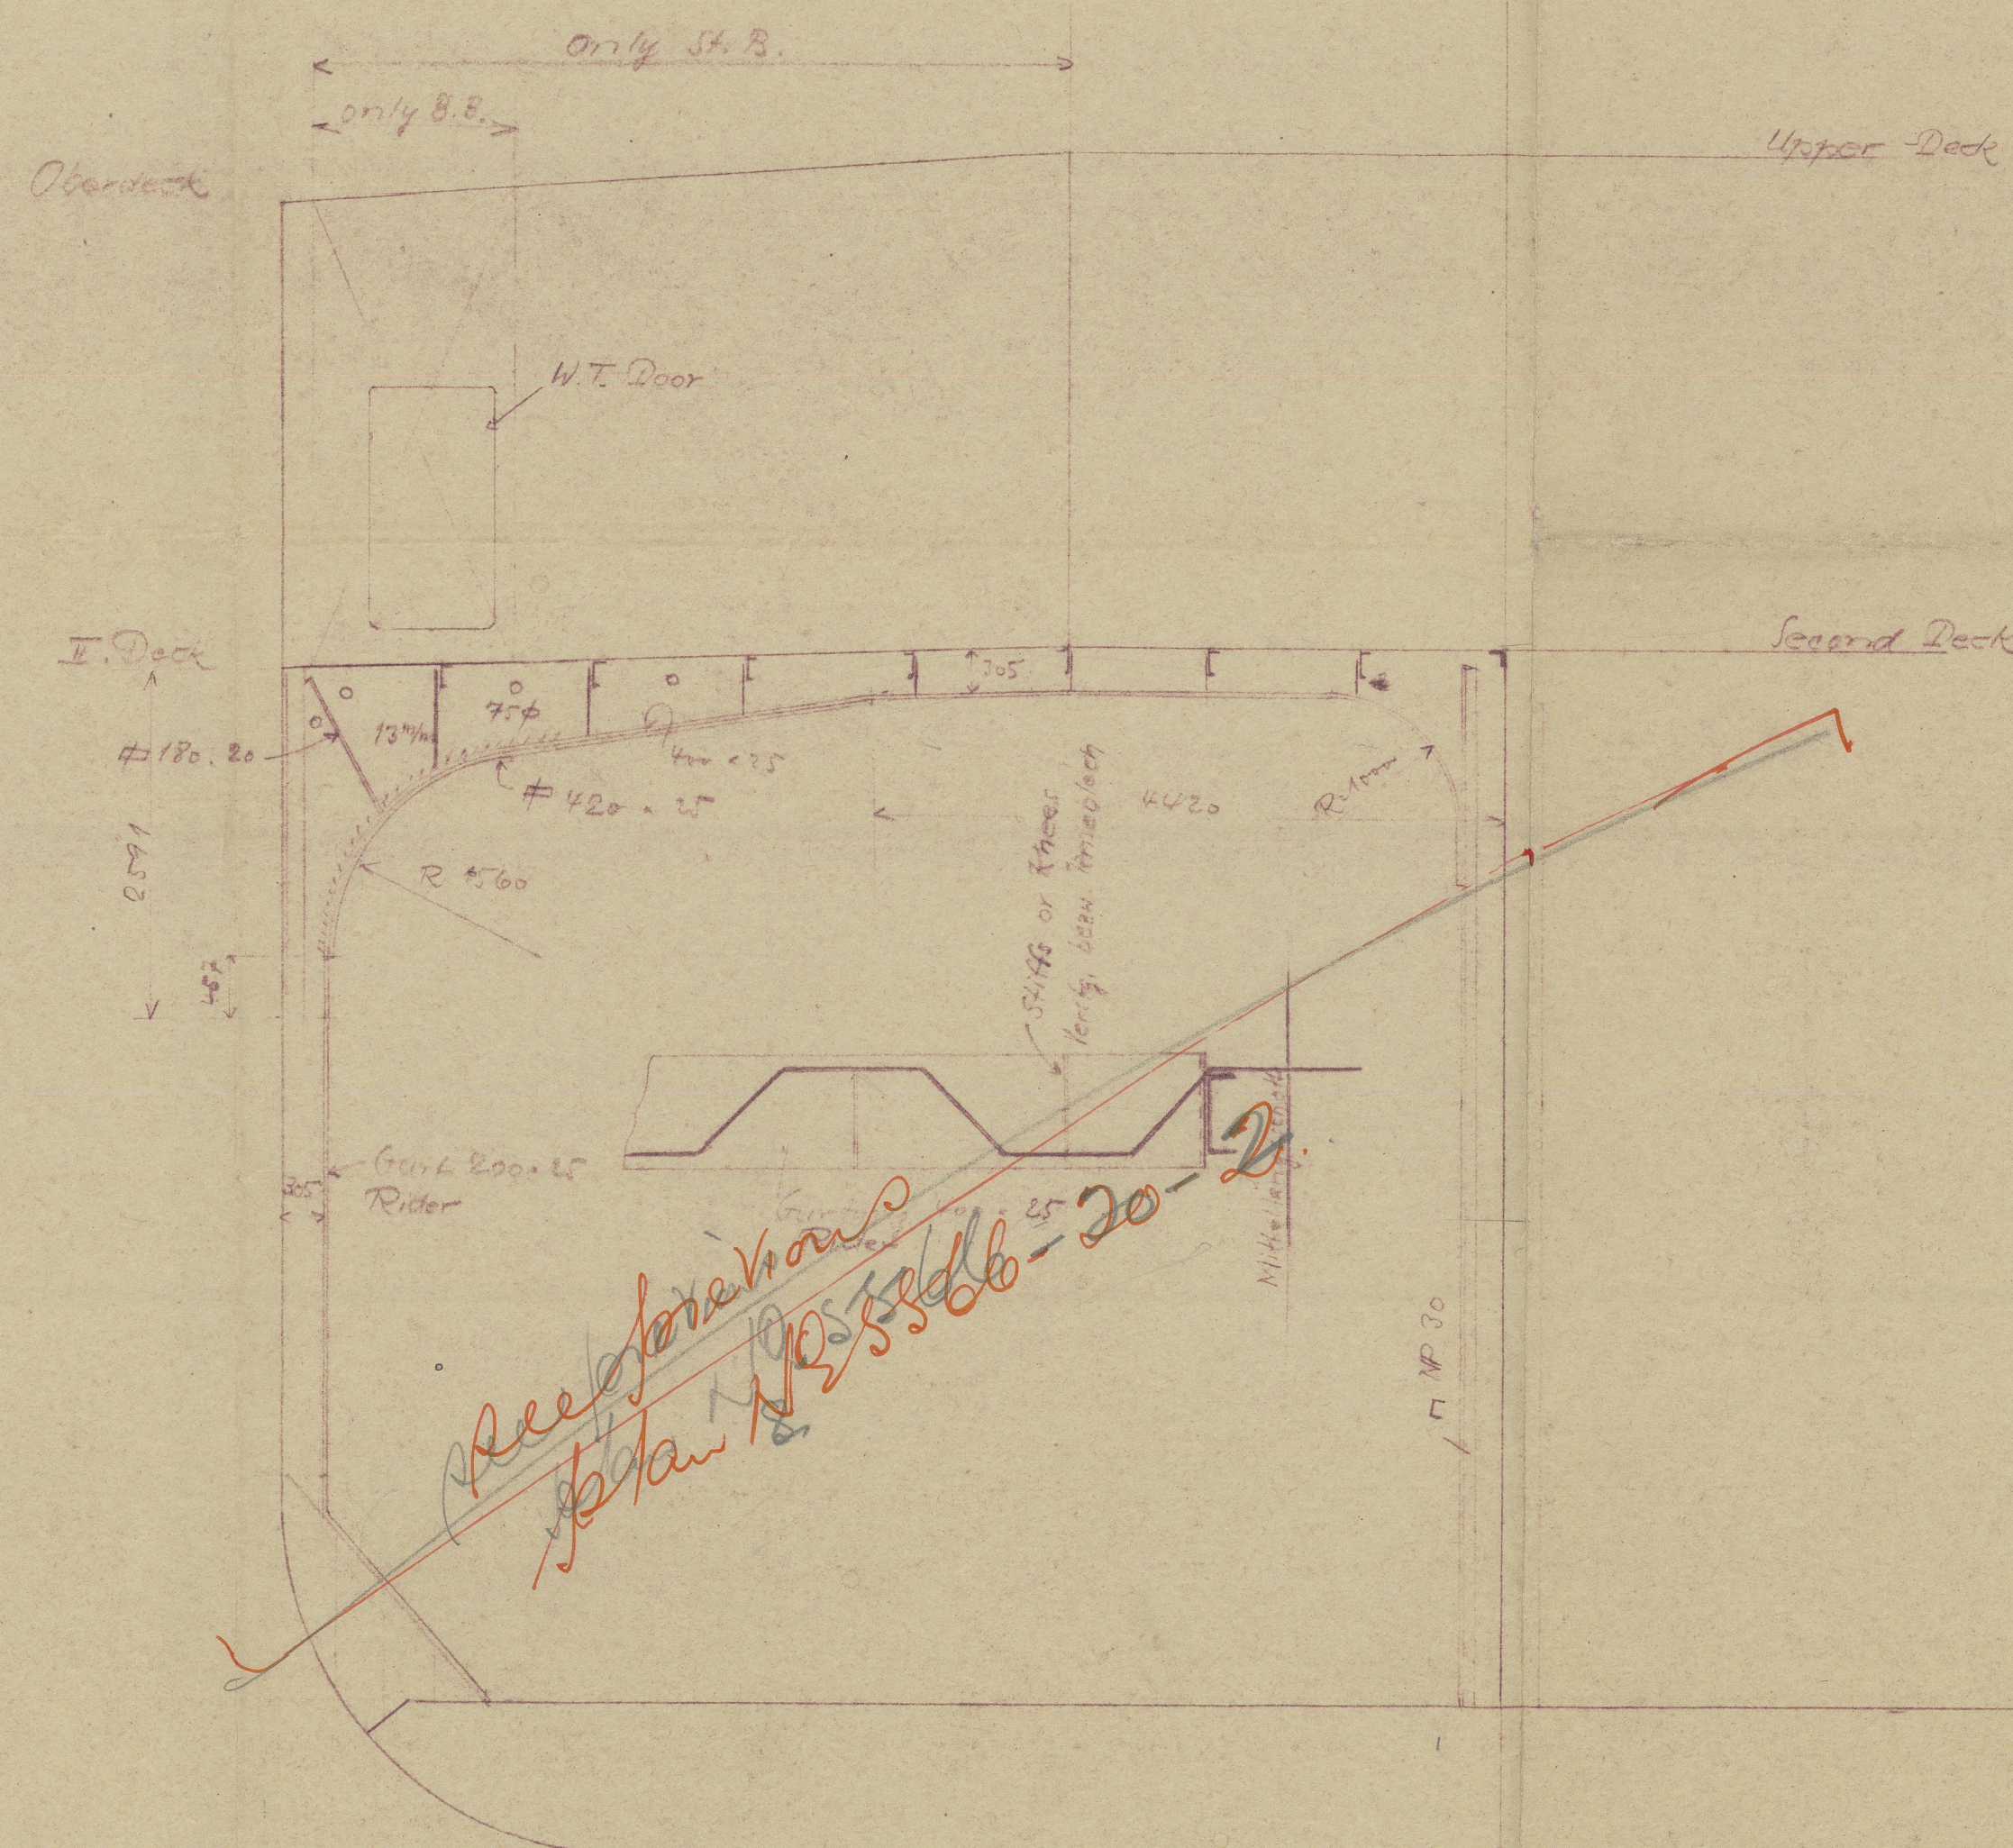

9.9.49

Copy 5566-20-2

	A.G. "WESER" BREMEN		Boz. Nr. 55, "Markab"
	Büro: T.B.S.		Zust. Nr. 1207
	Planung des Schiffes 68 und 75		Order Nr. 46/5566
			Maßstab: 1:50
			Gez. Nr. 12

010445-010501-0271



MARKAB

Tween deck bulkhead 68.

Bdn 35.



© 2021

Lloyd's Register  
Foundation

016445-012501-0277