

LLOYD'S REGISTER OF SHIPPING

UNITED WITH THE BRITISH CORPORATION REGISTER


11 JUL 1952

Ship's Name M.V.. " GAUTHIOD "Official No. 8879

Memorandum of alterations reported since ship was surveyed for assignment of Load Lines
in H A M B U R G.

A tank cleaning system has been installed during Special Survey this time and
12" Dia. holes have been cut in the upper deck in way of the main cargo tanks
(Not in bridge space).

Coamings of 6" x 3" x .44 O.A. welded toe on have been fitted complete with
bolted covers and in the way of each opening a .60 thick compensating doubling
plate has been fitted.

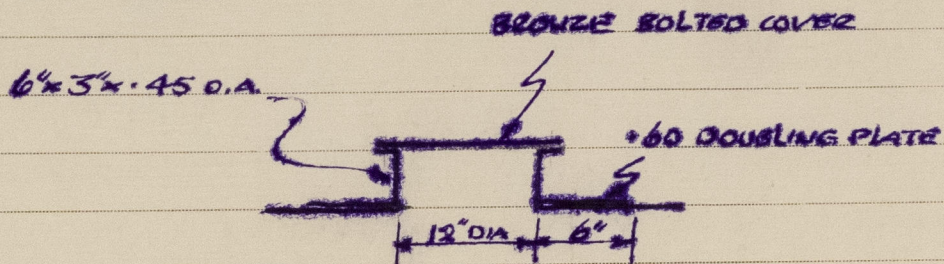

E. F. Lynn

11 JUL 1952