

24 MAR 1948
Ad. 821

Lloyd's Register of Shipping.


Ship's Name

"BRIKA"

Official No. 143998.

Memorandum of alterations reported since ship was surveyed for assignment of Load Lines in

Poop extended as shown below.

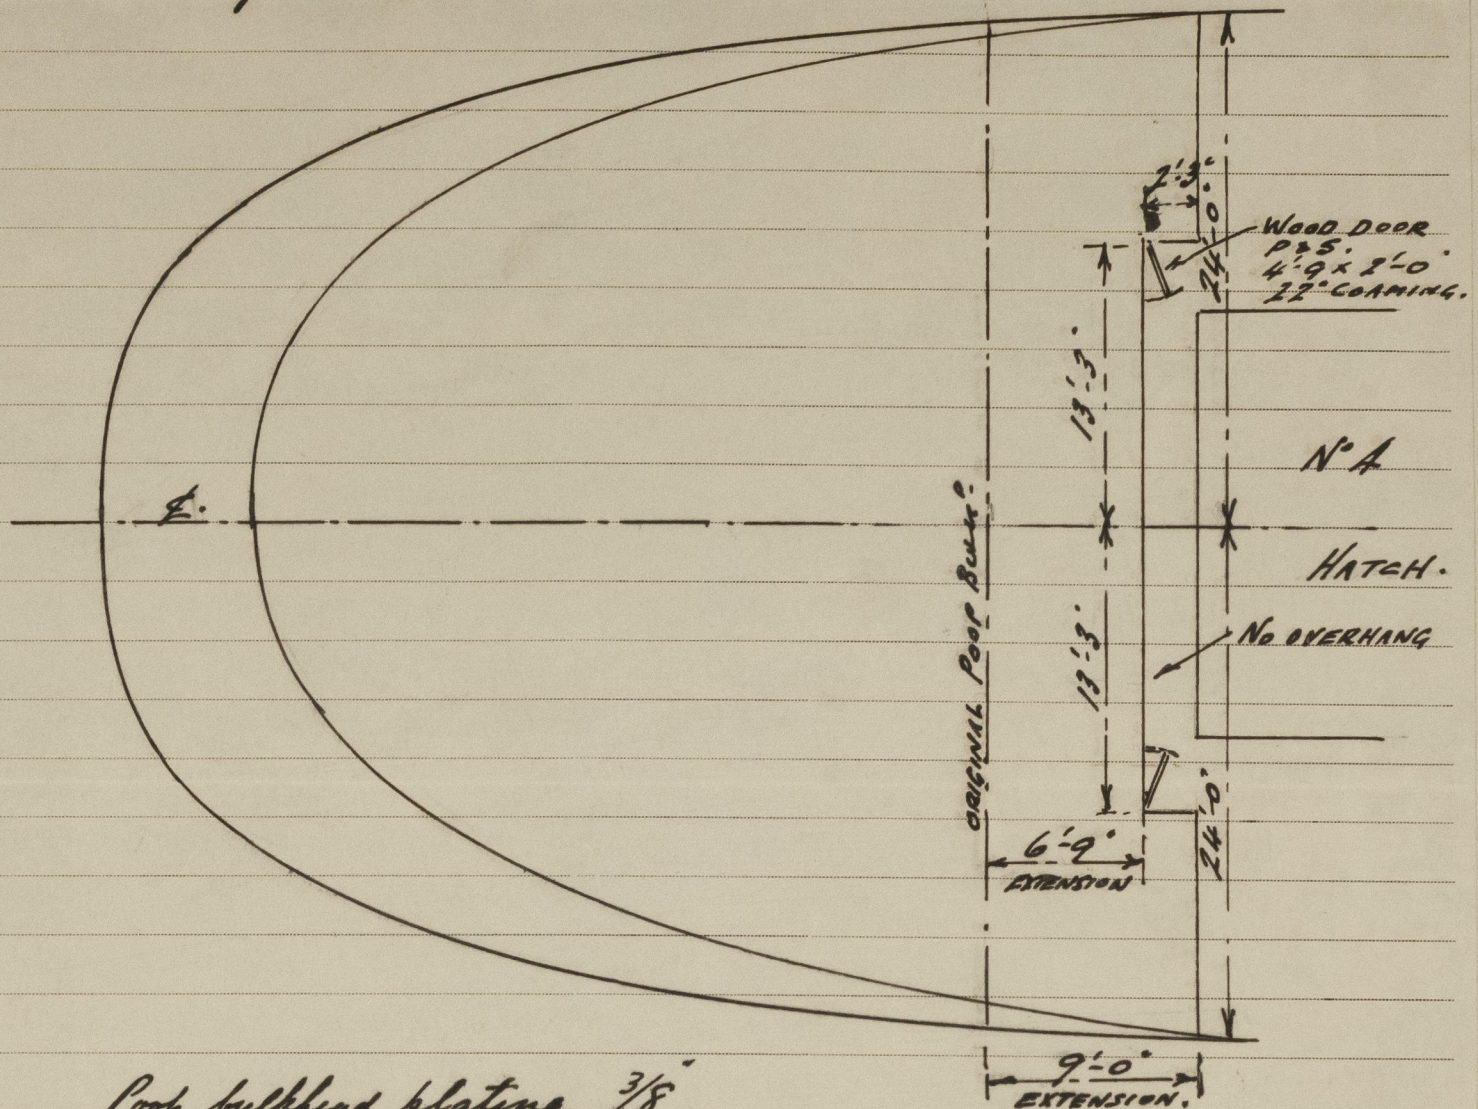

Poop bulkhead plating $\frac{3}{8}$ "
Stiffeners $6 \times 3\frac{1}{2} \times \frac{3}{8}$ "

Poop now fitted for Crews accommodation.

Access by wood door P.S., strongly constructed with 22' Coamings
8 - 13" dia sidelight & 1 - 10" dia sidelight fitted in side shell
Port and Starboard & 4 - 15" dia sidelights & 1 - 16" dia sidelight
fitted in Poop bulkhead, all with hinged deadlights.

4 - 12" dia ventilators and 1 - 9" dia ventilator fitted on
Poop Deck, Coamings 33" high, $\frac{3}{8}$ " thick closed by wood
plugs & canvas covers.

4 - 6" dia mushroom vents with screw down W.T. covers
fitted on Poop Deck

1 steel skylight with 4 hinged steel W.T., fitted on Poop Deck.
Cargo hatch on Poop Deck dispensed with and opening
plated over.

N° 4 (after) Cargo hatch on upper deck shortened 2'3".

John G. Lumley
Surveyor to Lloyd's Register of Shipping
Middlesbrough 22/3/48.