

S.S. 495.6.

FORGED STEEL RUDDER FRAME


ARMS SHRUNK ON & KEYED TO MAINPIECE

TO LLOYD'S TEST & SURVEY.

SCALE 3" = 1 FOOT

A x D = 131 2/3 x 18 = 417 2/6

SPEED UNDER 10 KNOTS


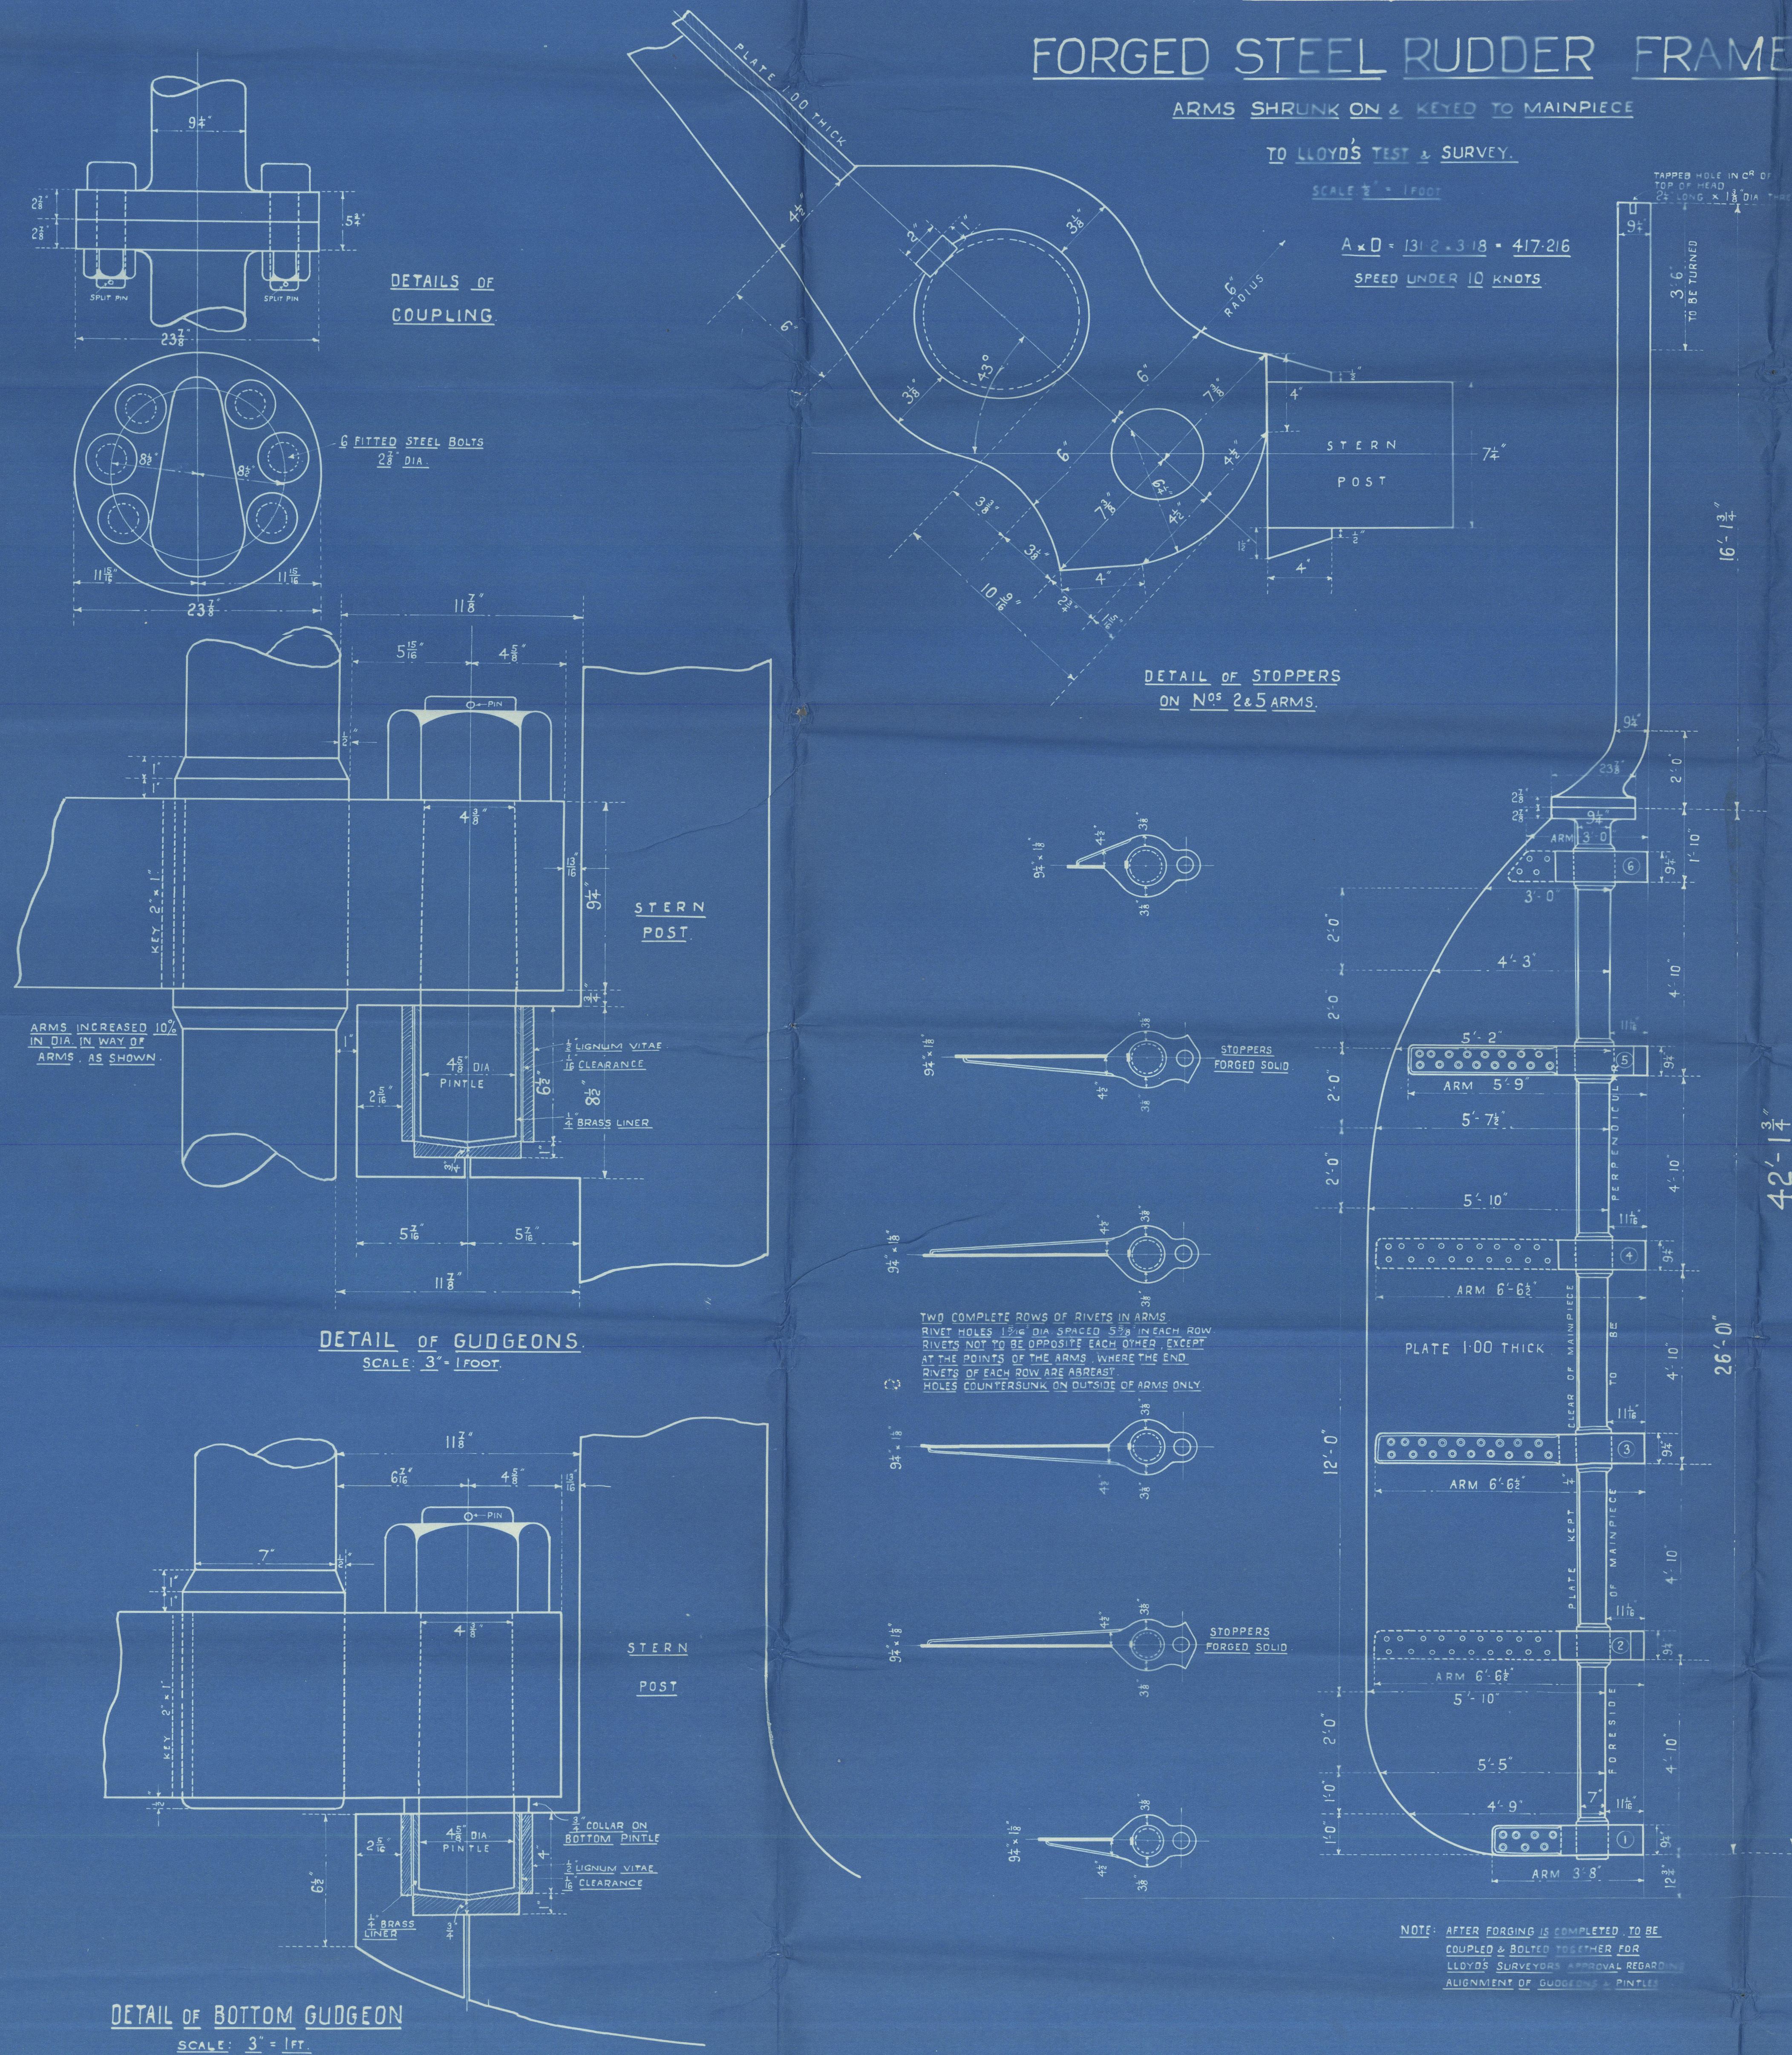


S.S. 495.6

FORGED STEEL STERN FRAME.

TO LLOYD'S TEST & SURVEY.

SCALE 3" = 1 FOOT

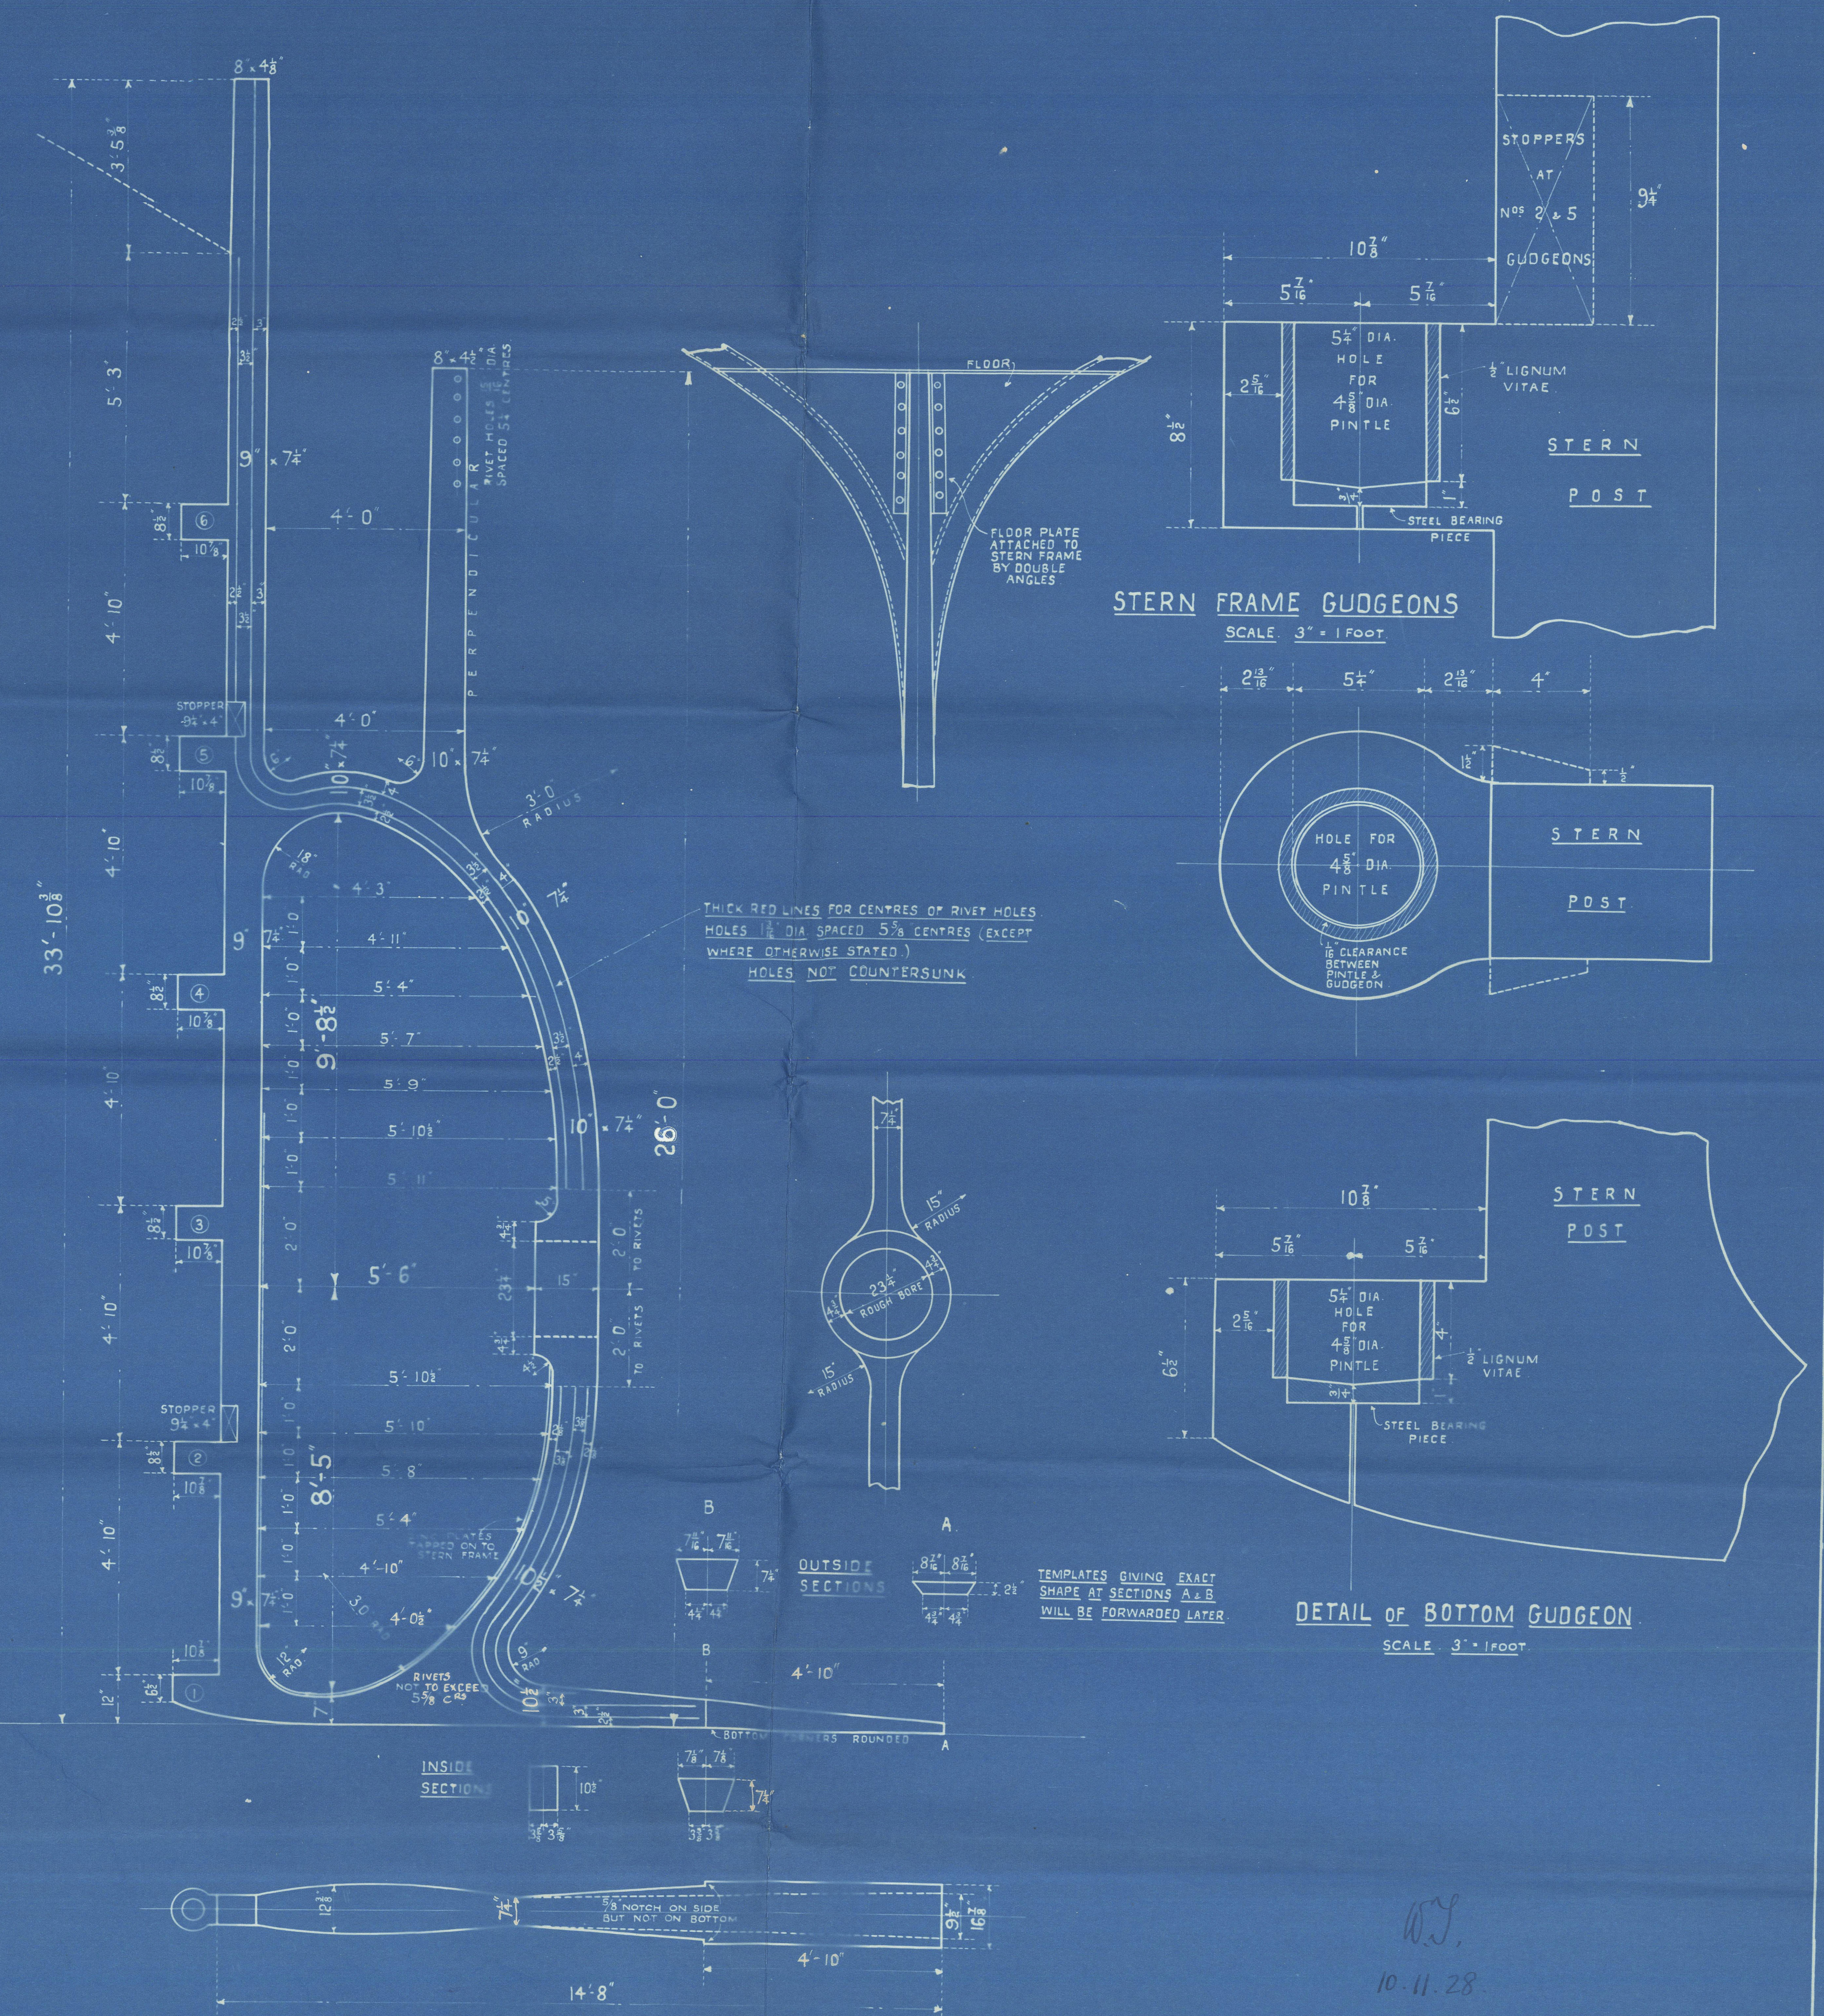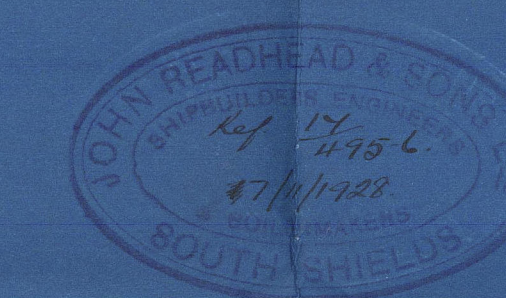

2. Headheads

495-

~~496~~ 497

Plain name ^{See} letter ~~497~~

^d Rudder 28/11/28

501 in letter dated 10 July 1929

S.S. Brika

NEWCASTLE ON TYNE.

KENZUI MARU

Report No. 84157. *

S.S. "HAMLA"

NEWCASTLE ON TYNE.

Report No. 84705

S.S. "TAFNA"

NEWCASTLE ON TYNE.

Report No. 85689.

9/567