



RODERAXELKOPPLINGAR:  
 NYB #359 - VARVETS TILLVERKN.  
 NYB #361 - SKIF - 226242  
 NYB #362 " " "  
 NYB #363 " " "  
 NYB #364 " " "  
 NYB #365 " " "



RODERTRUMMA  
 SEDD AKTERIFRAN

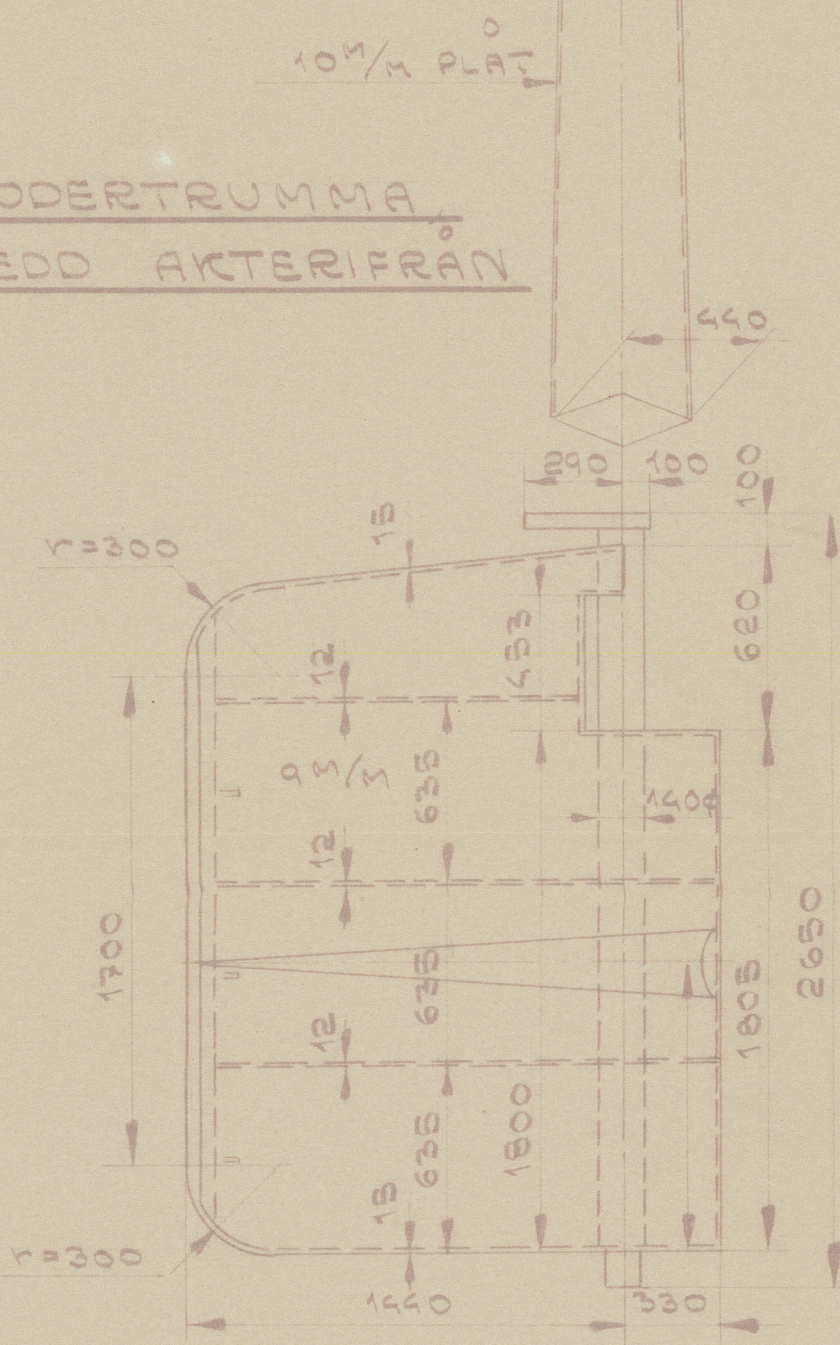


UTSLAG AV RODER

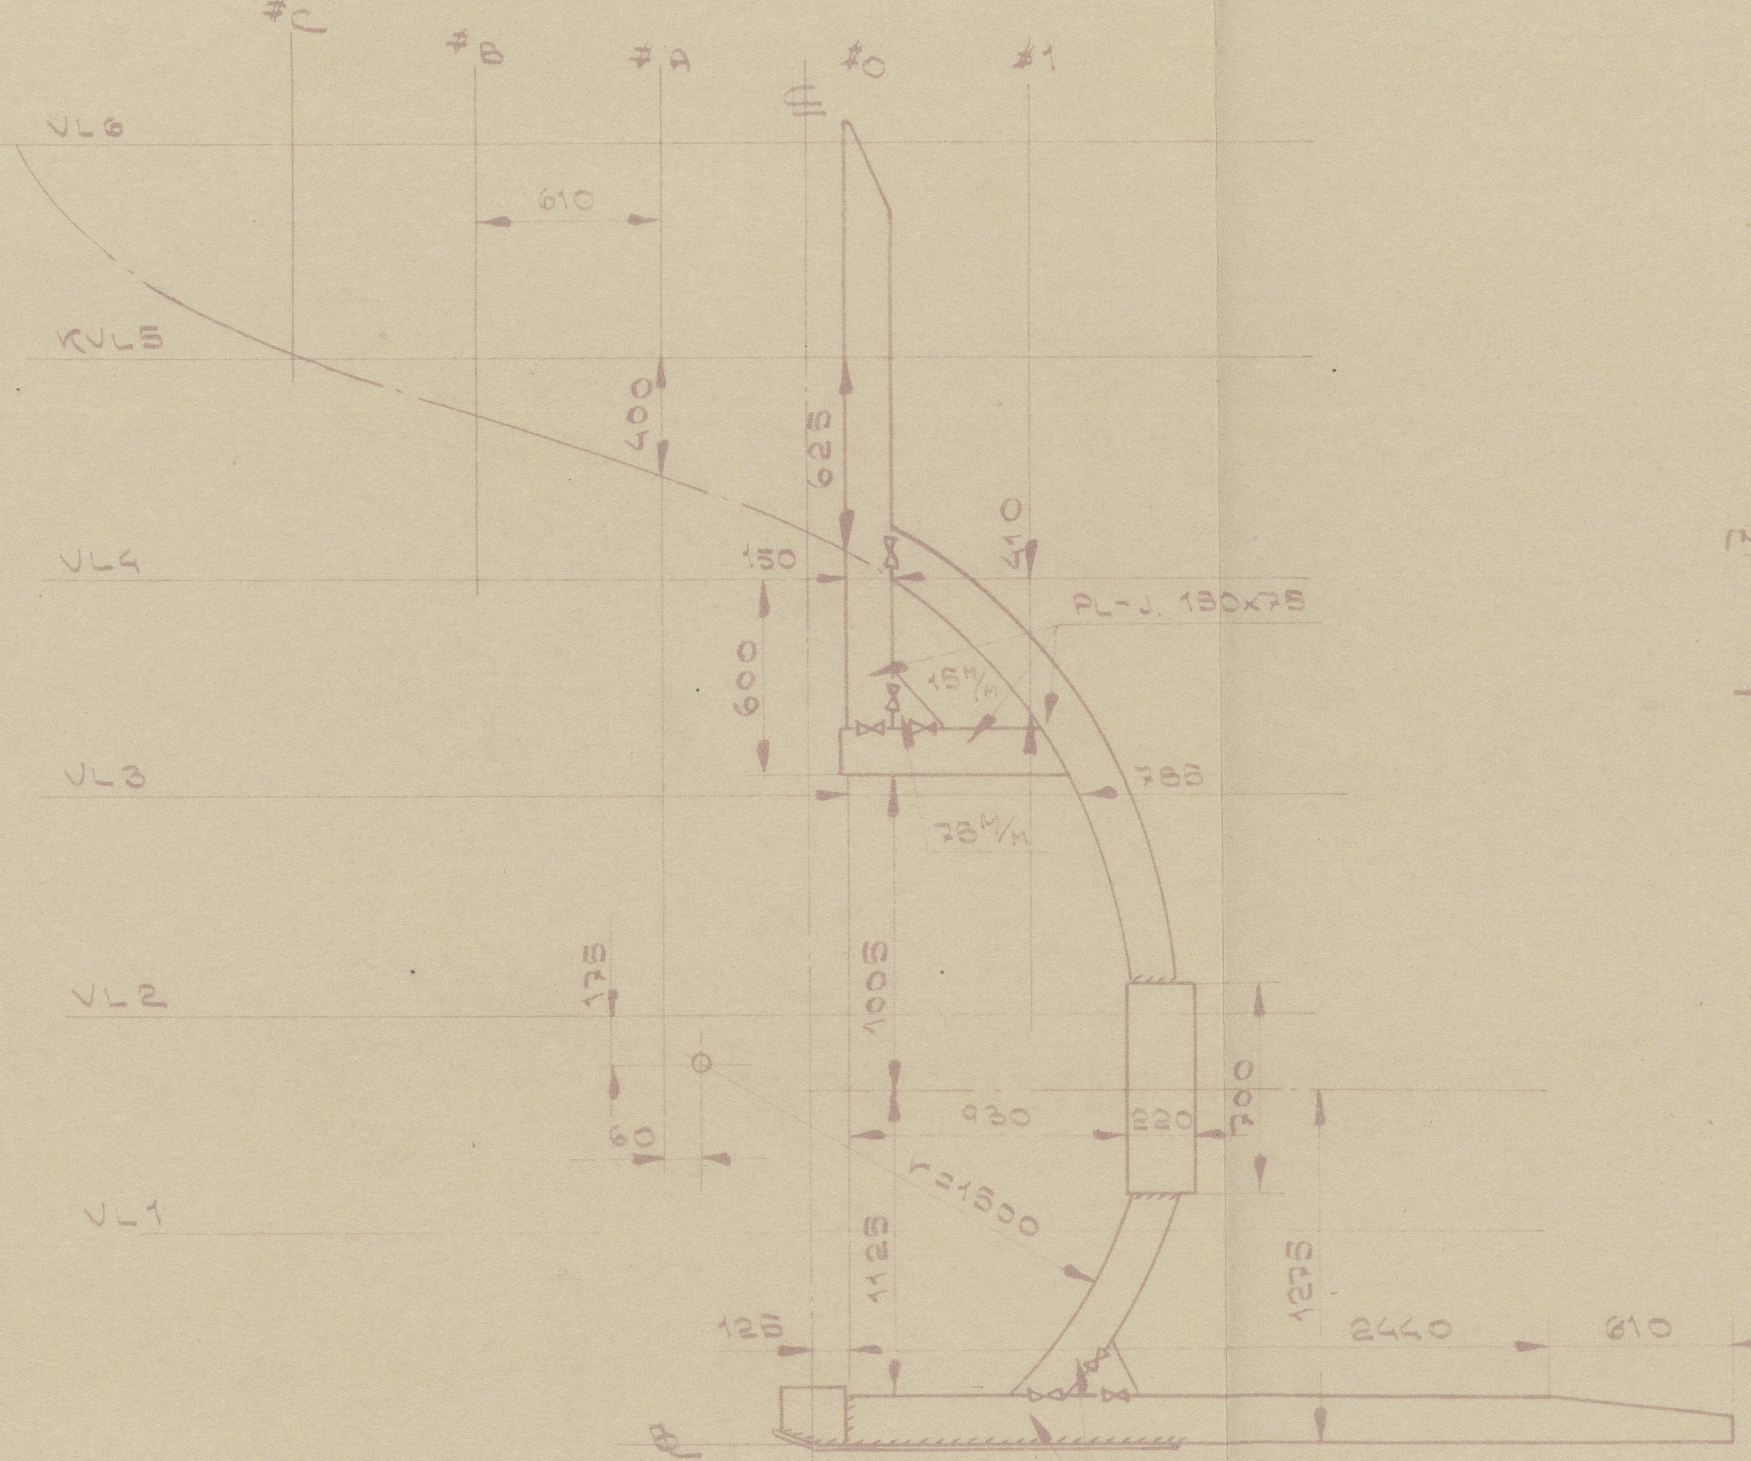


UTSLAG AV AKTERSTAV

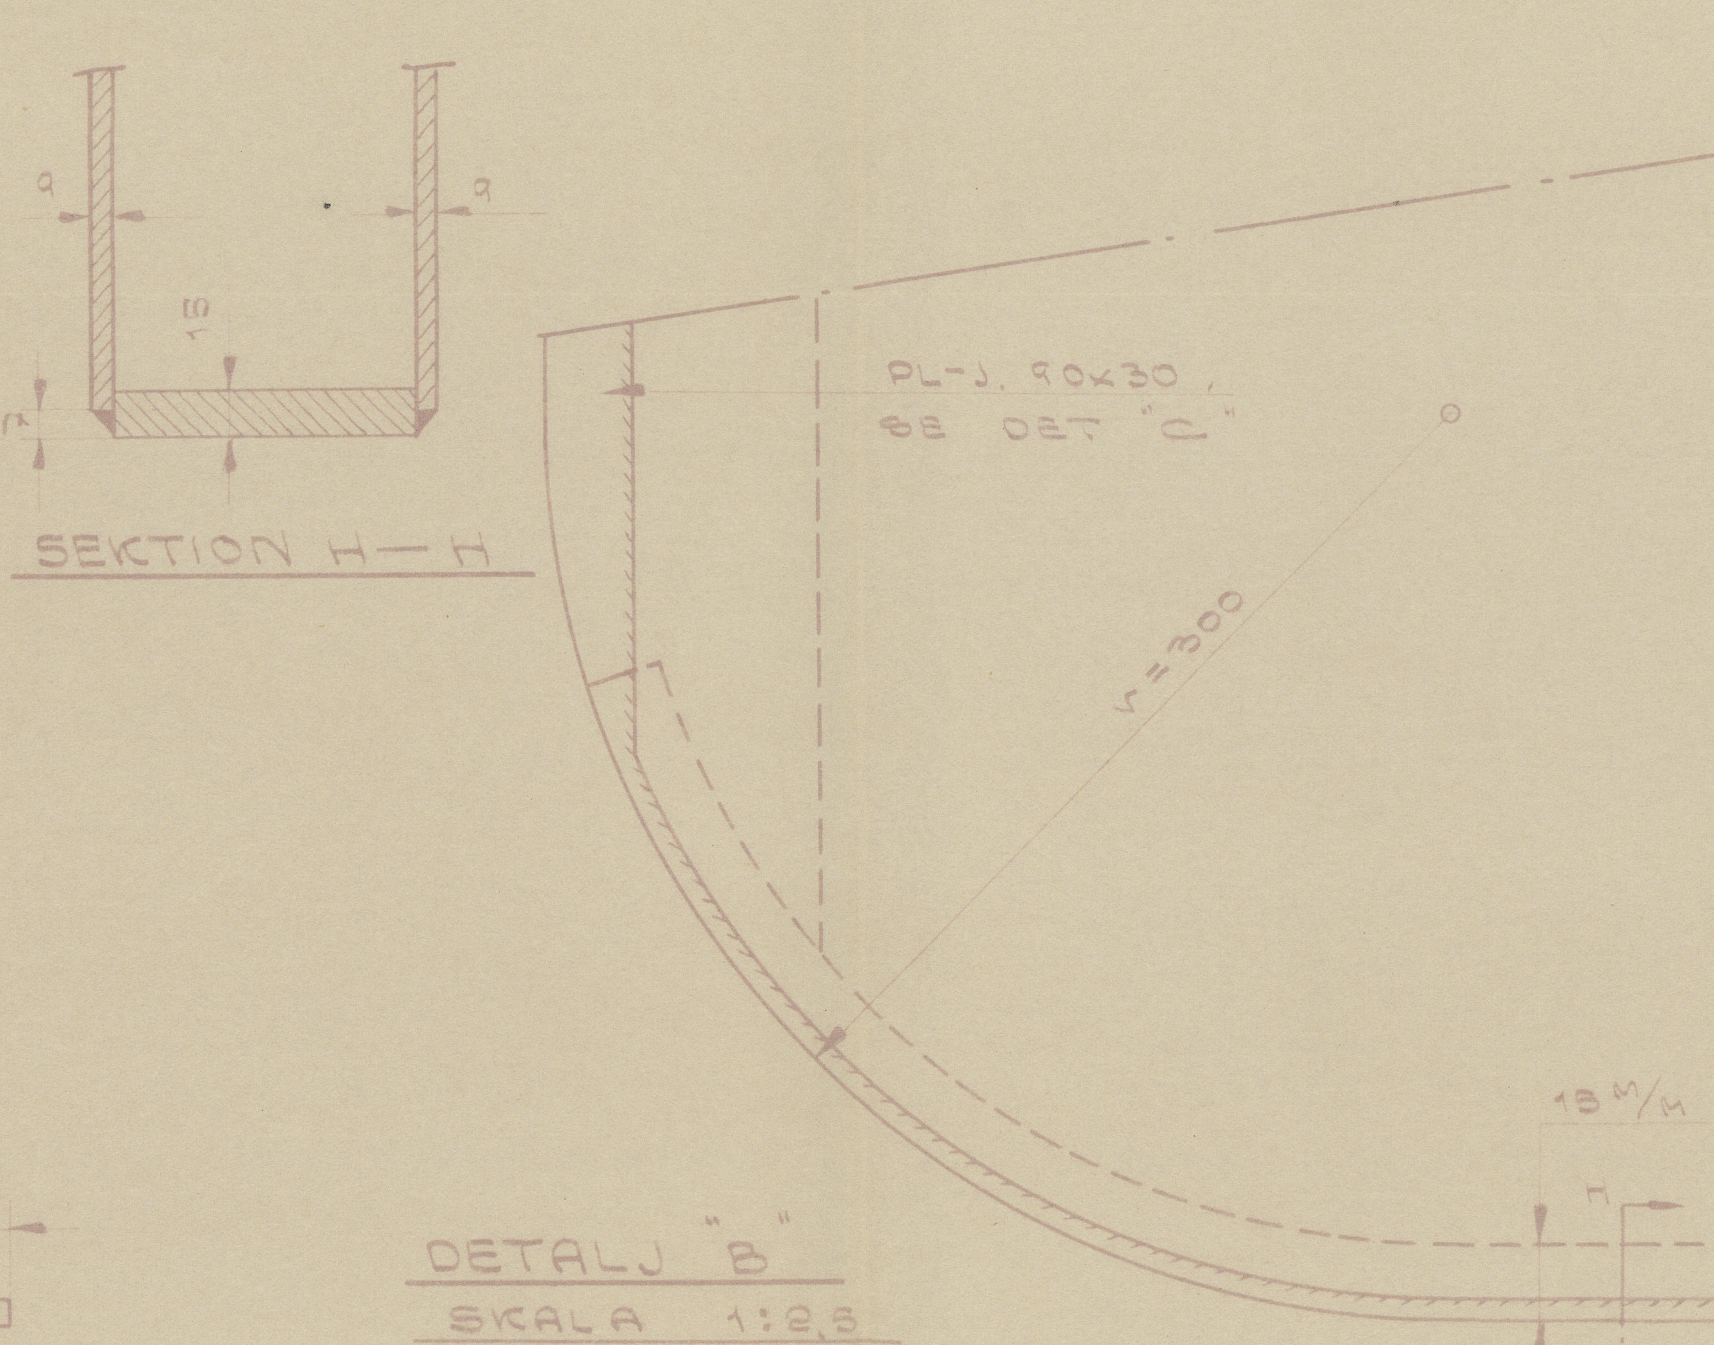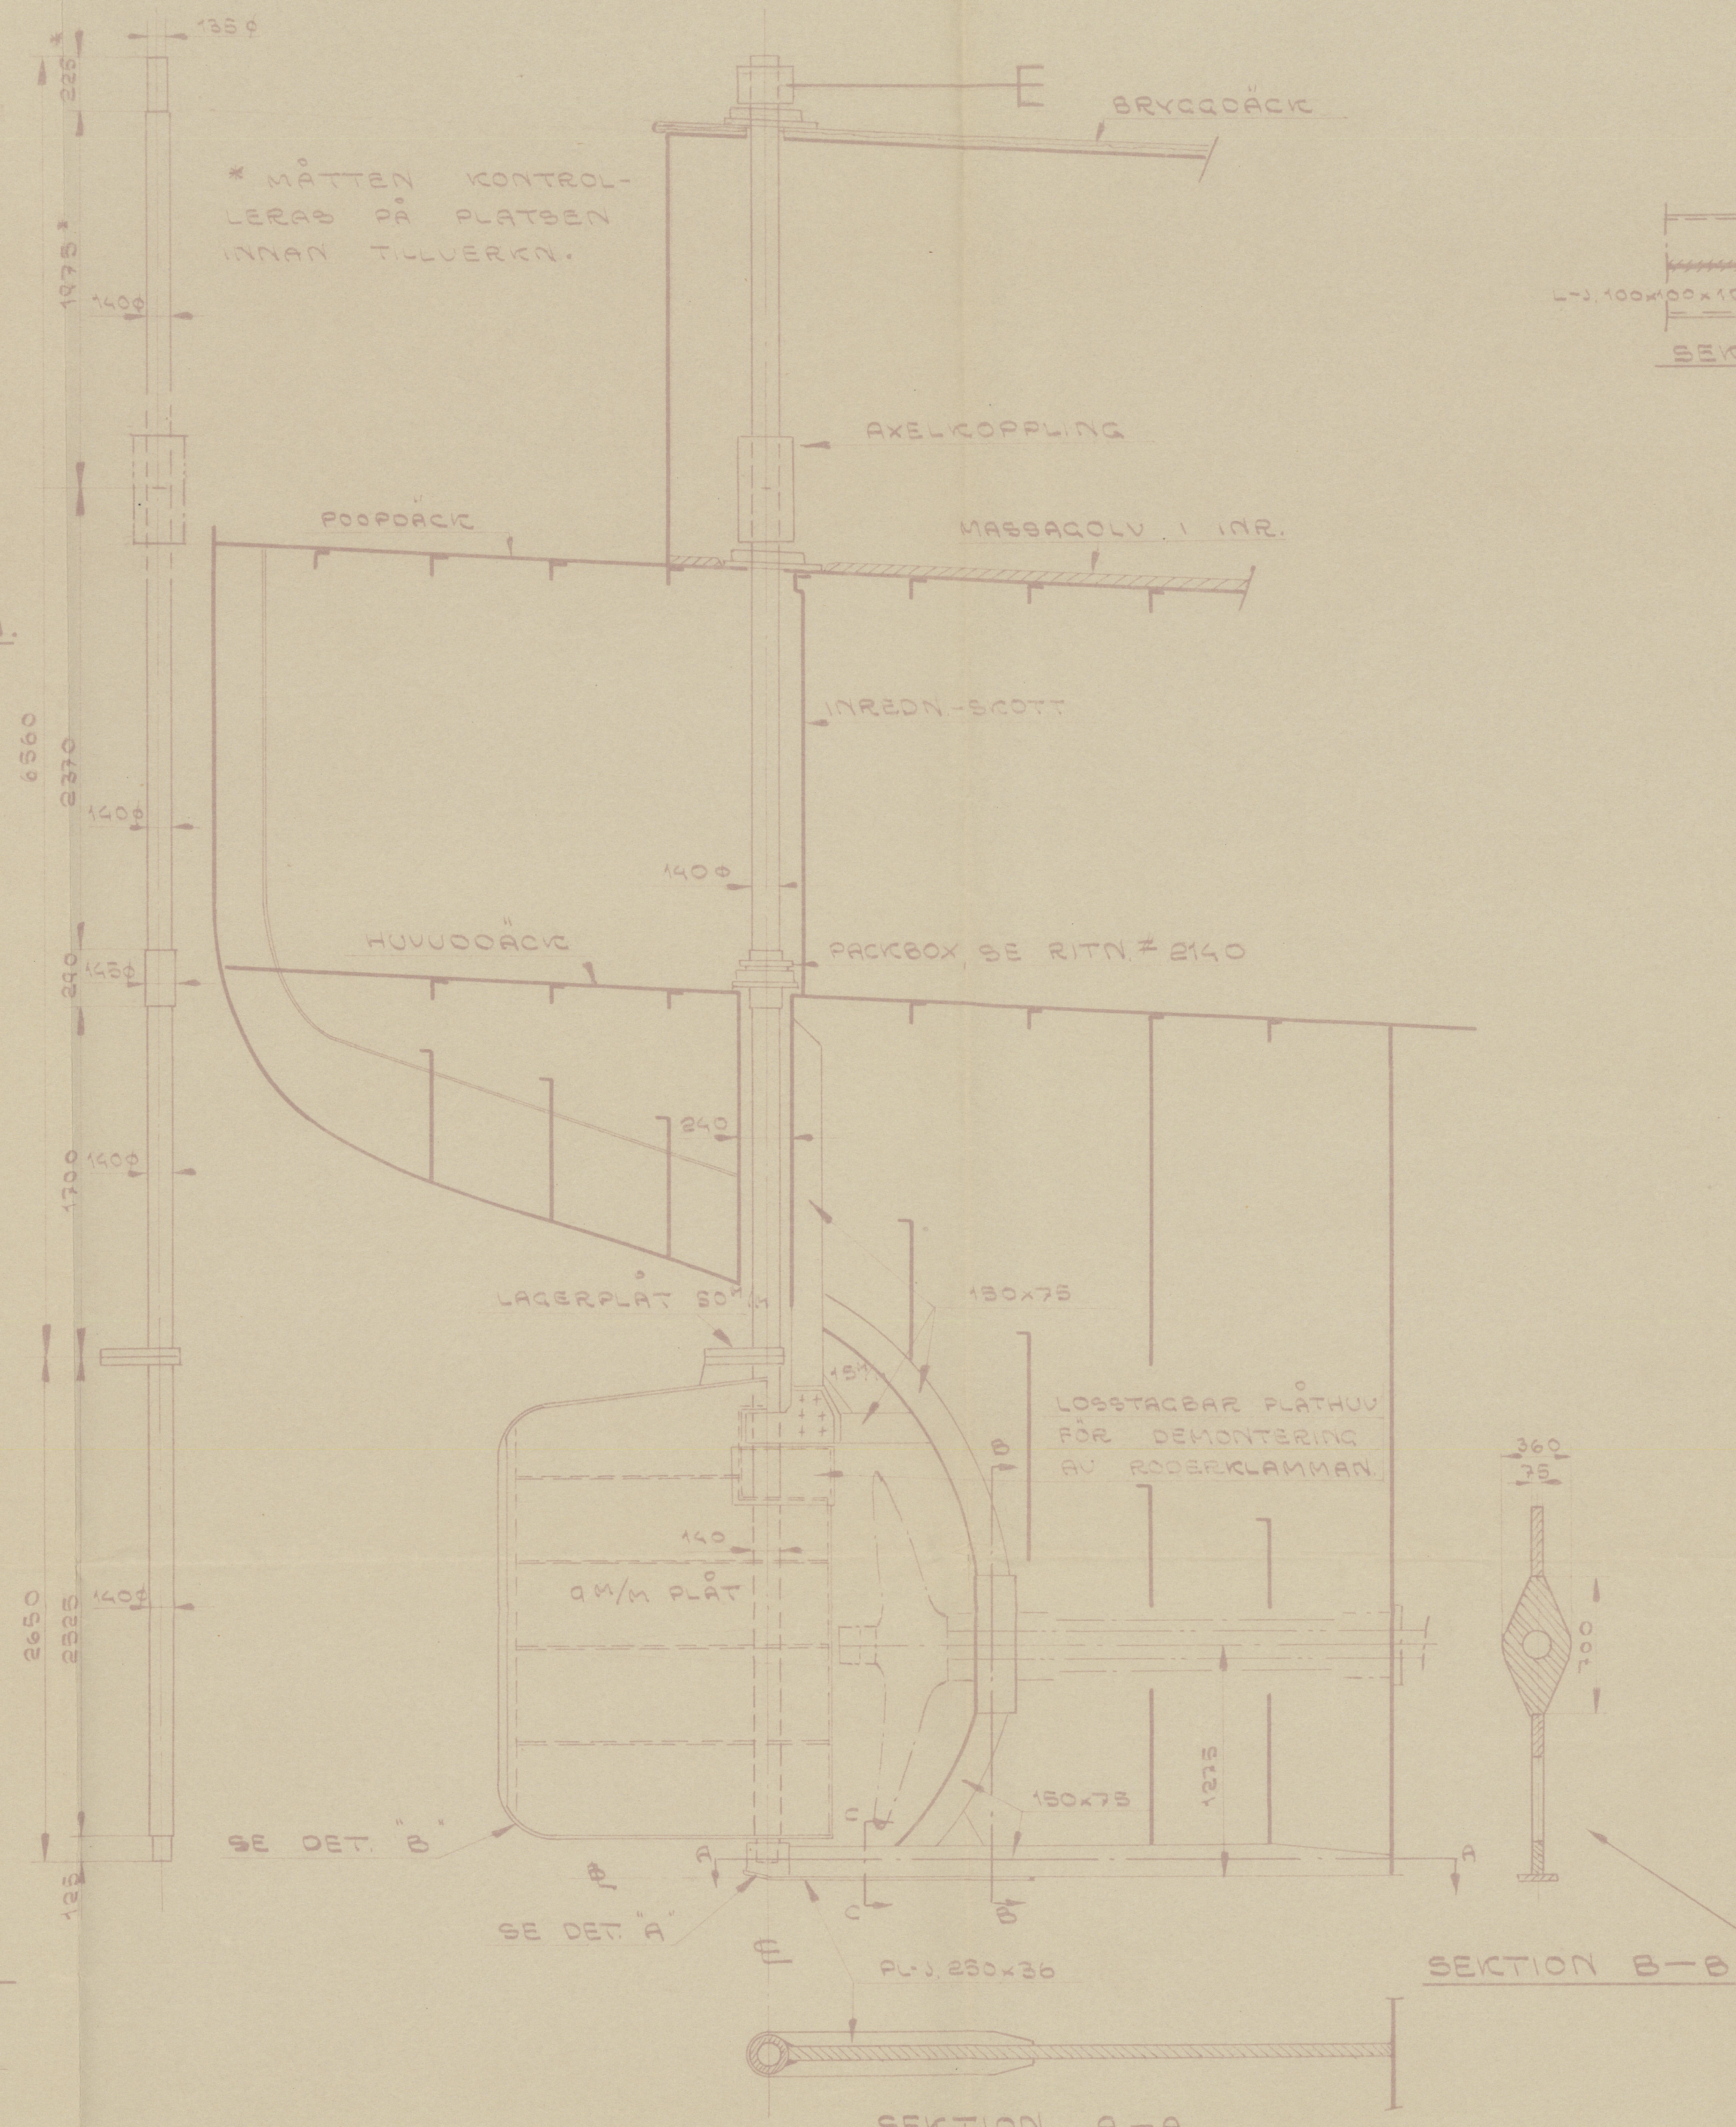


DETALJ B  
 SKALA 1:2,5

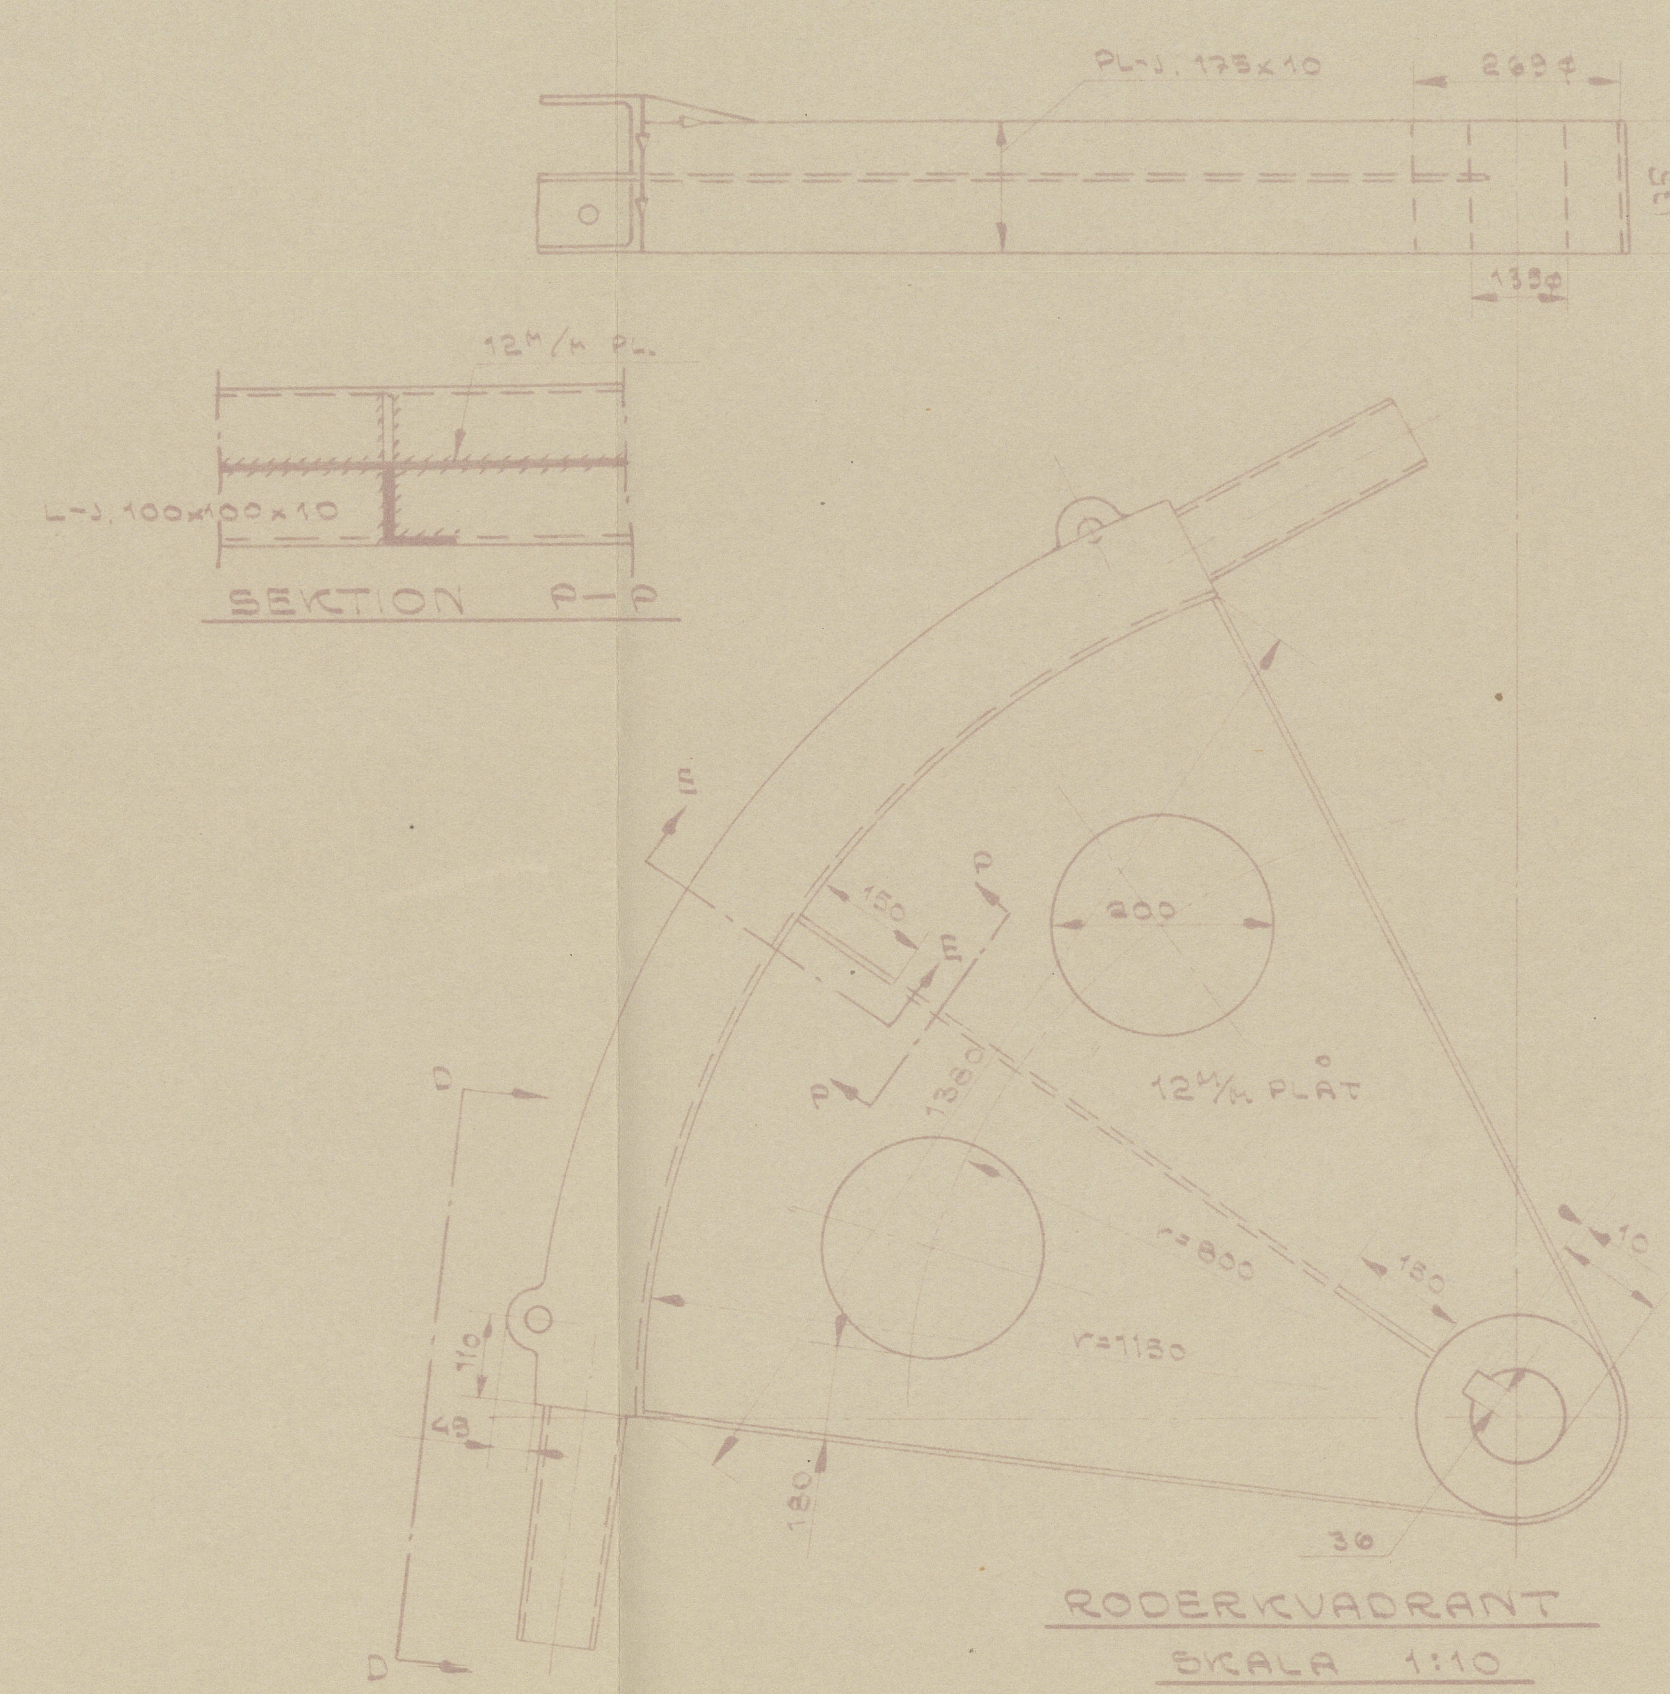



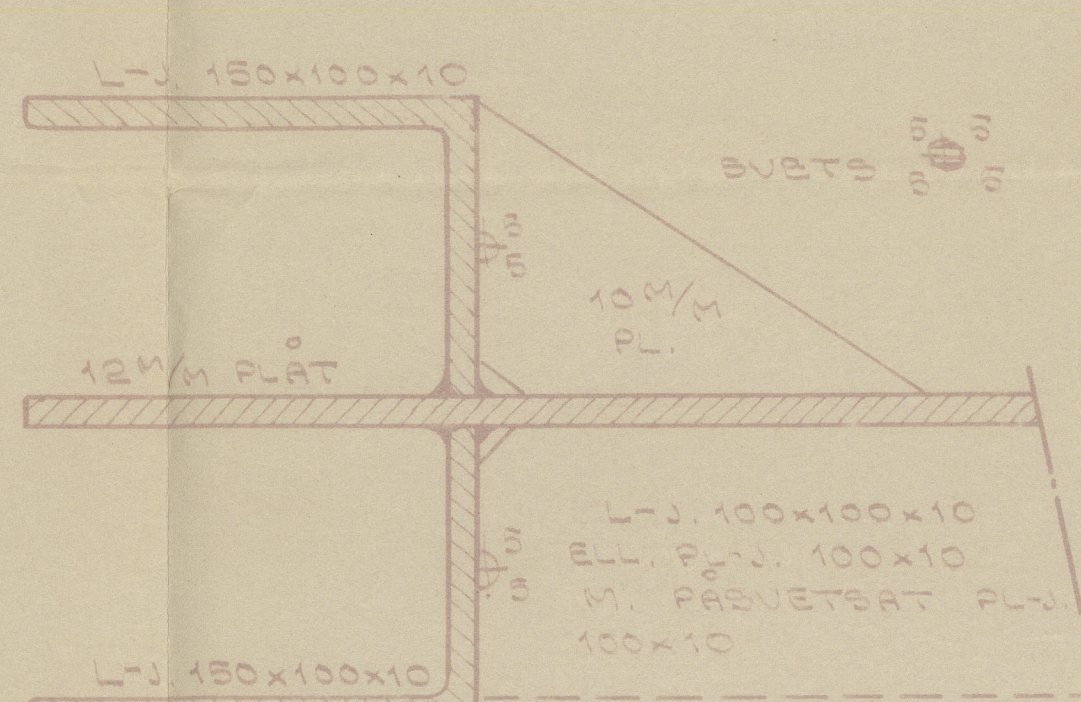



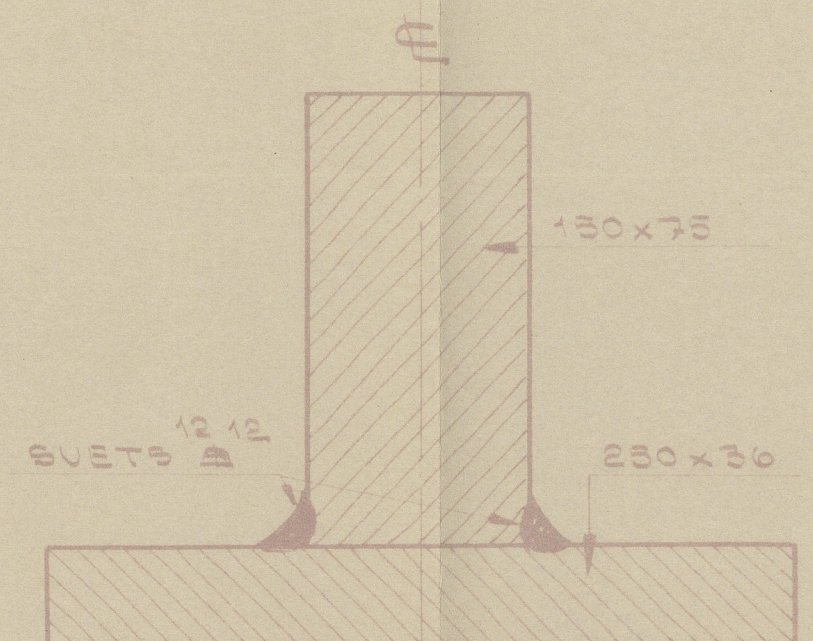



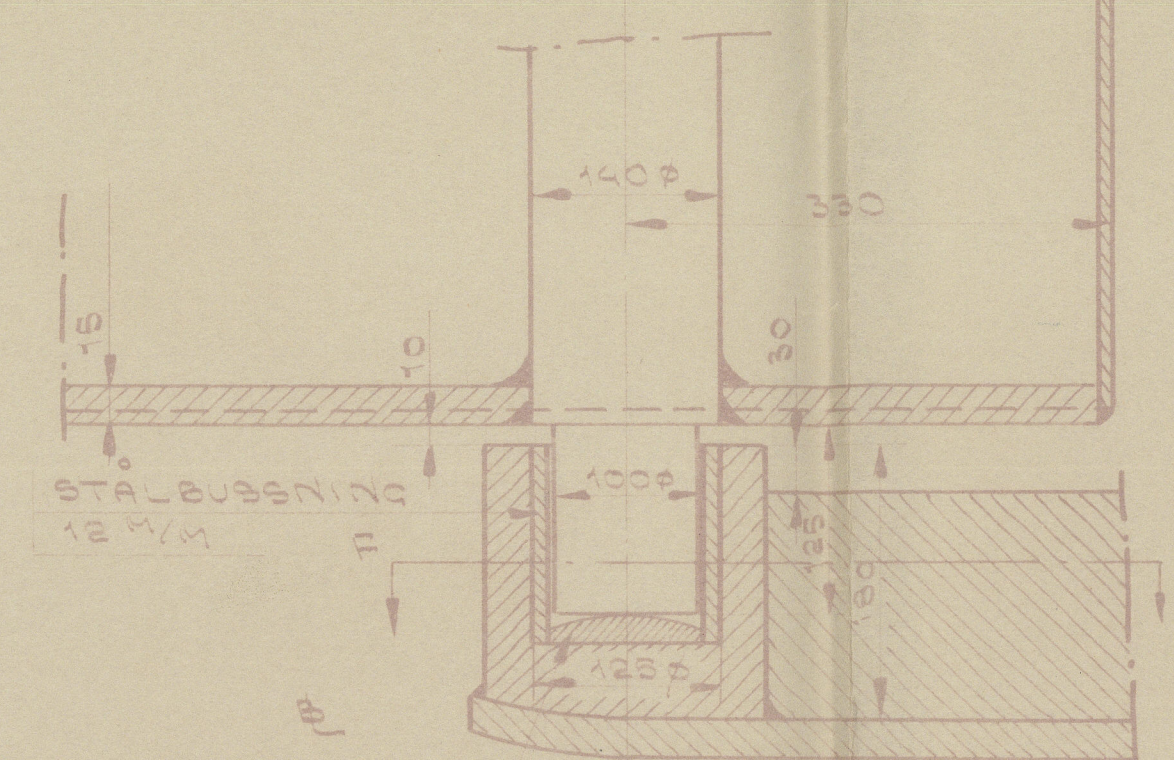



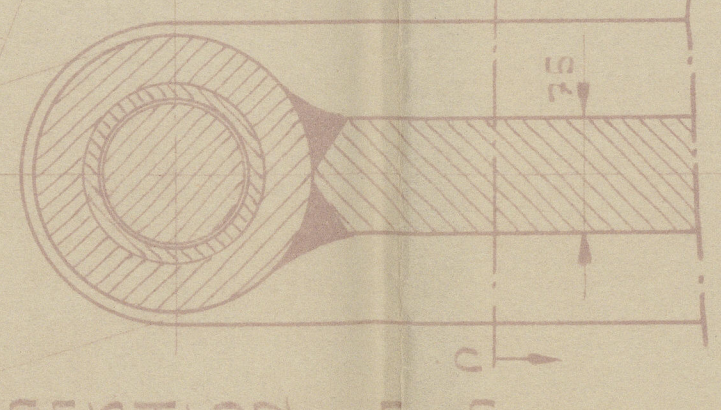



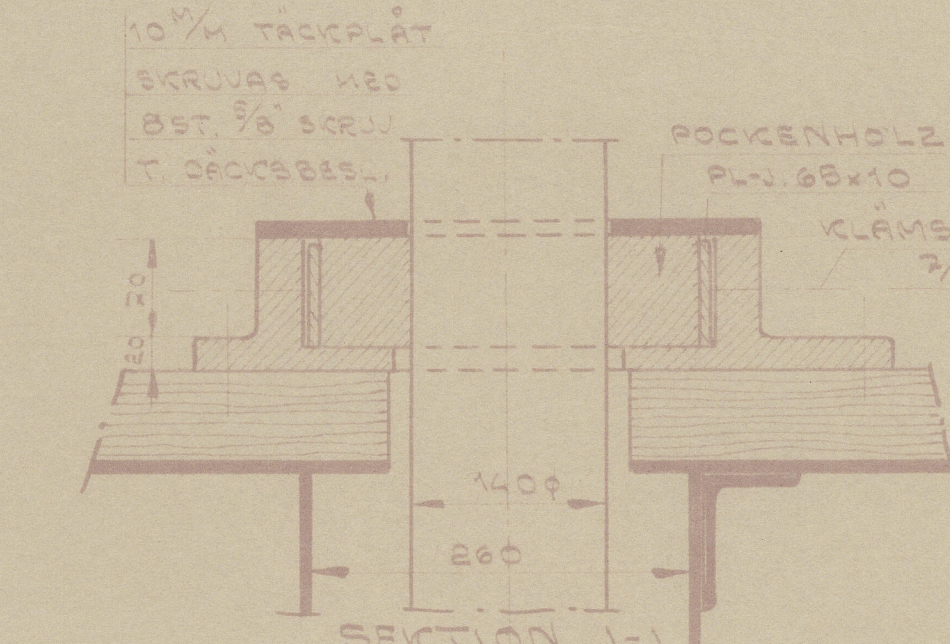



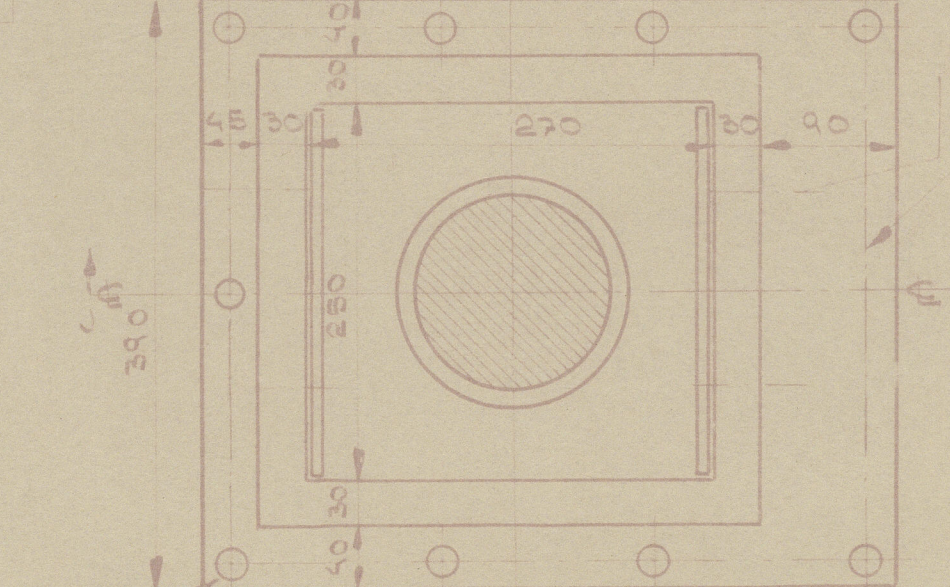



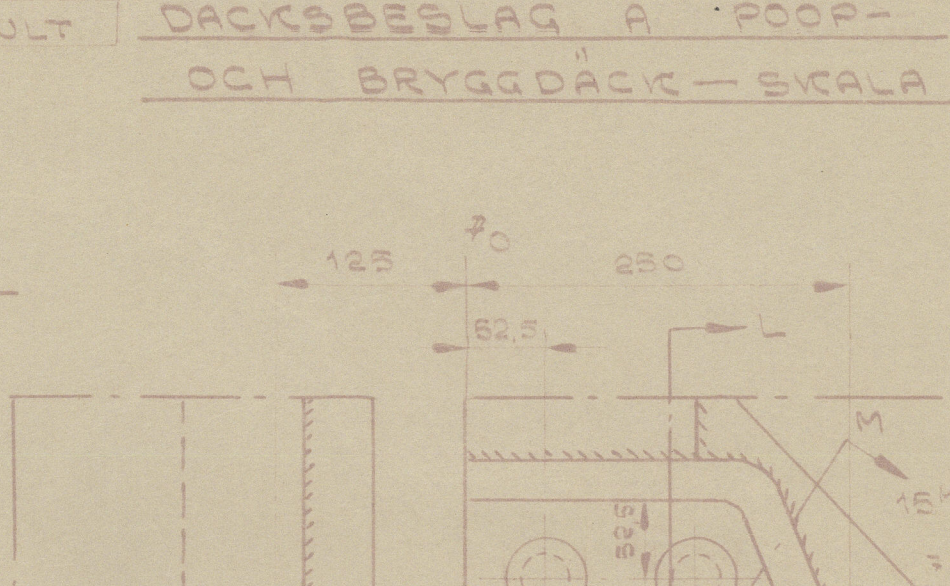



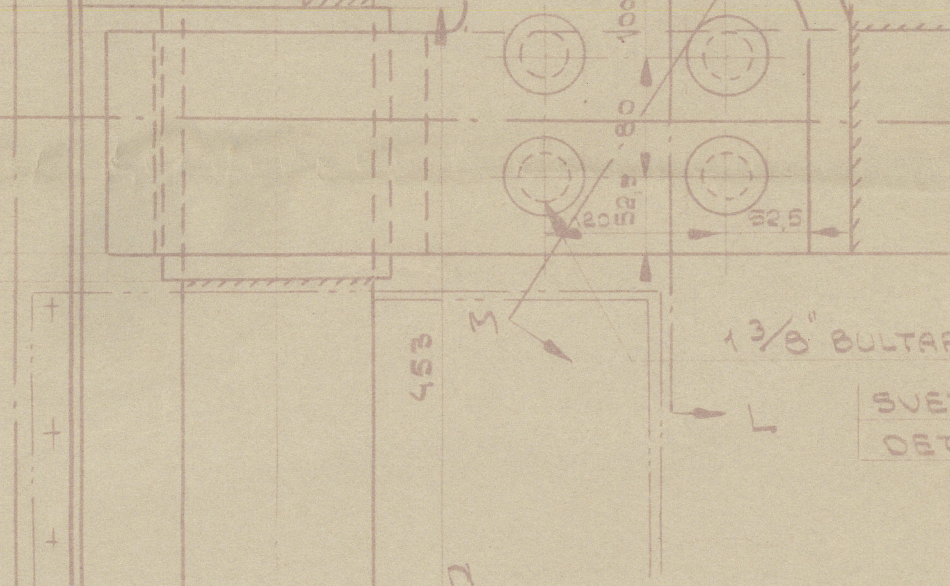



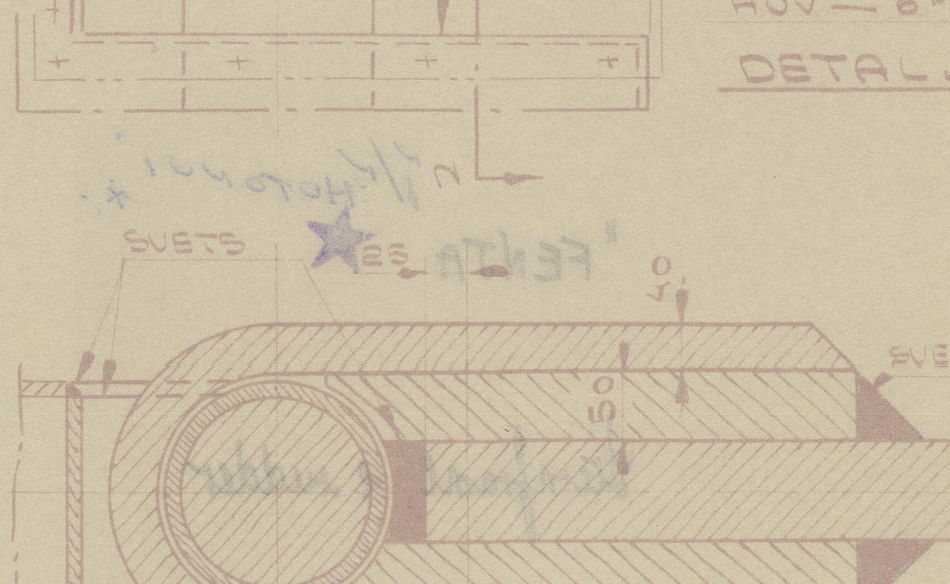



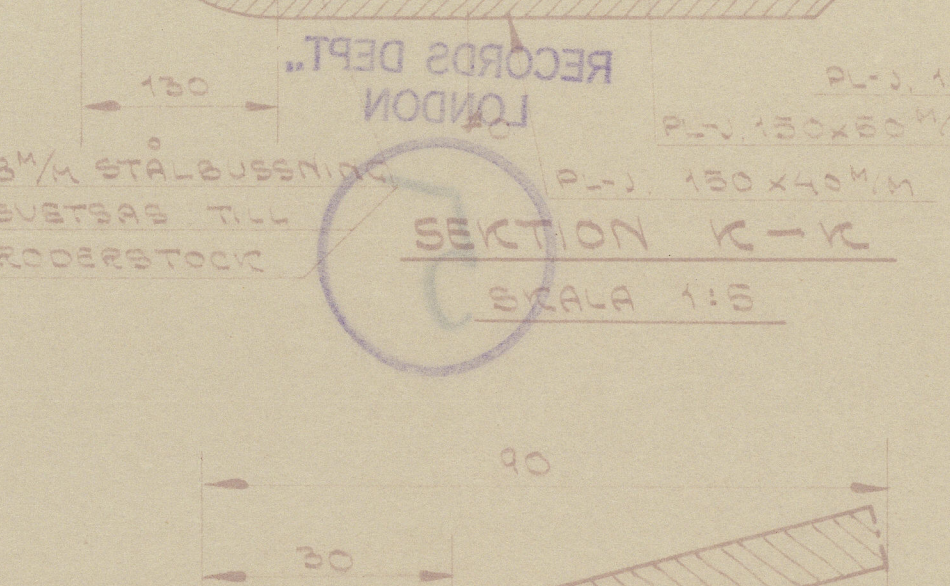



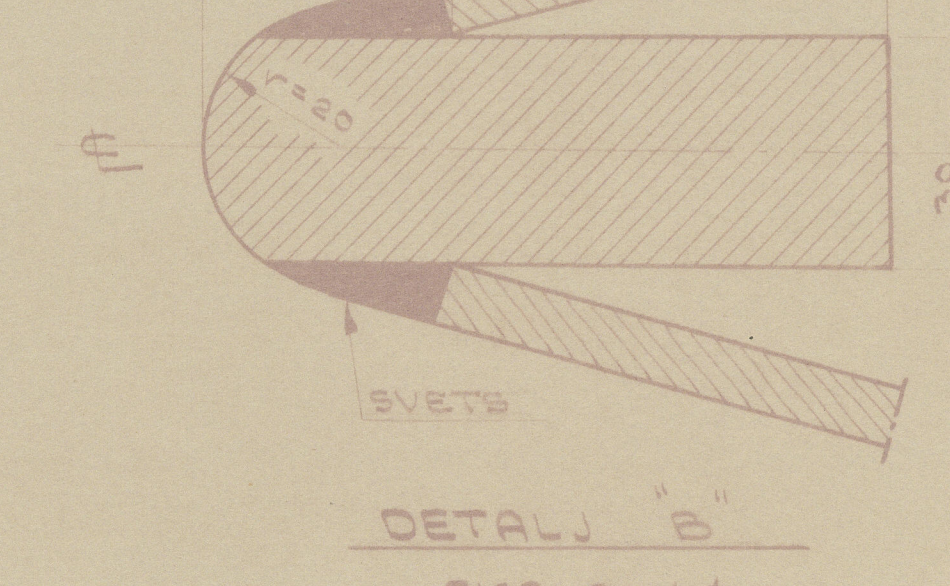



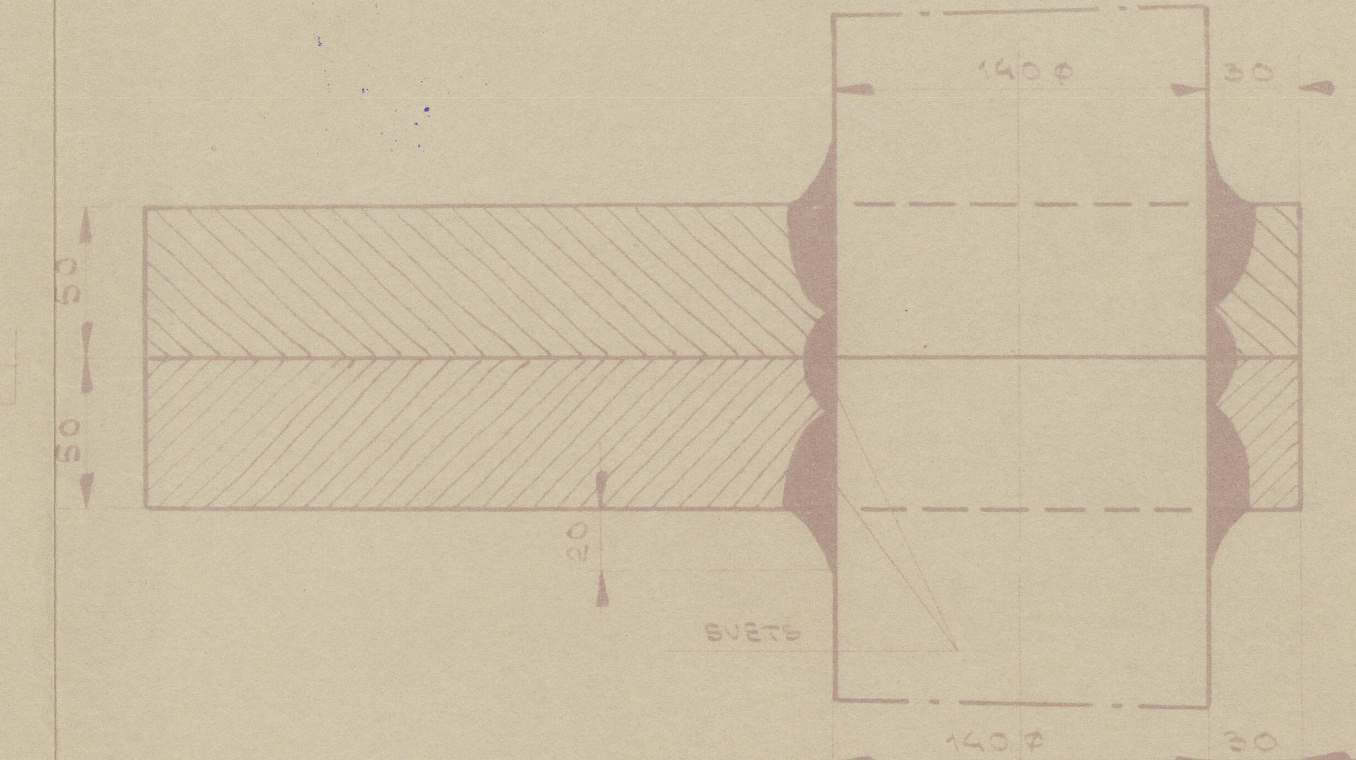



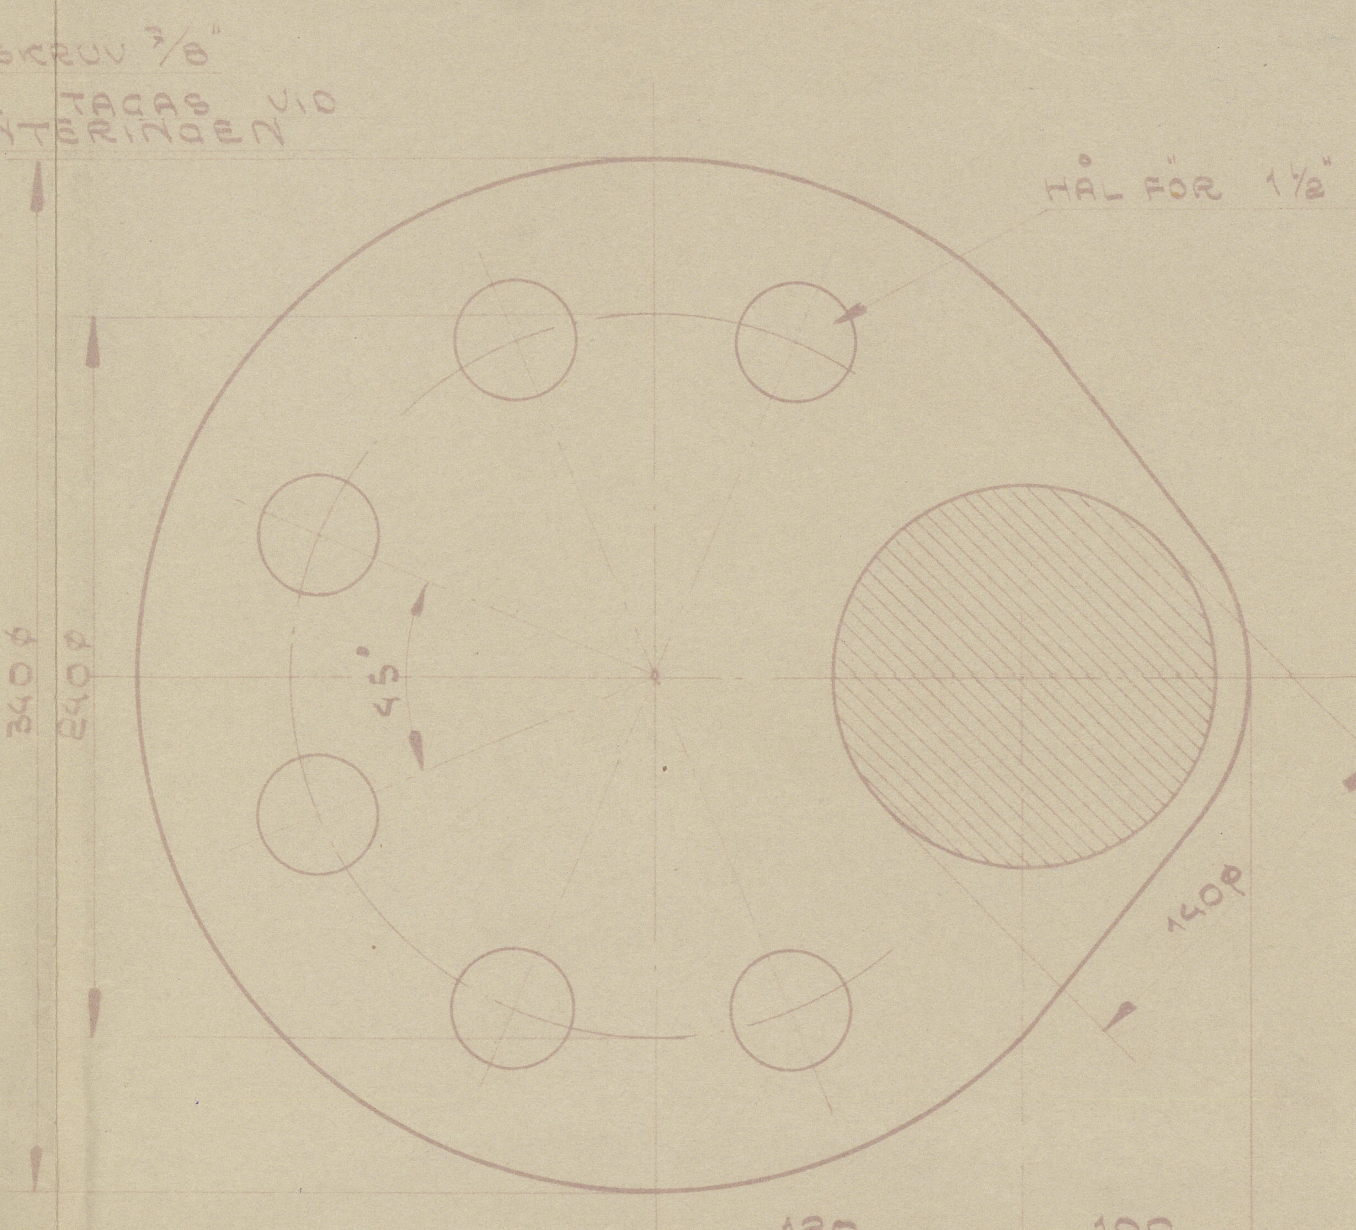



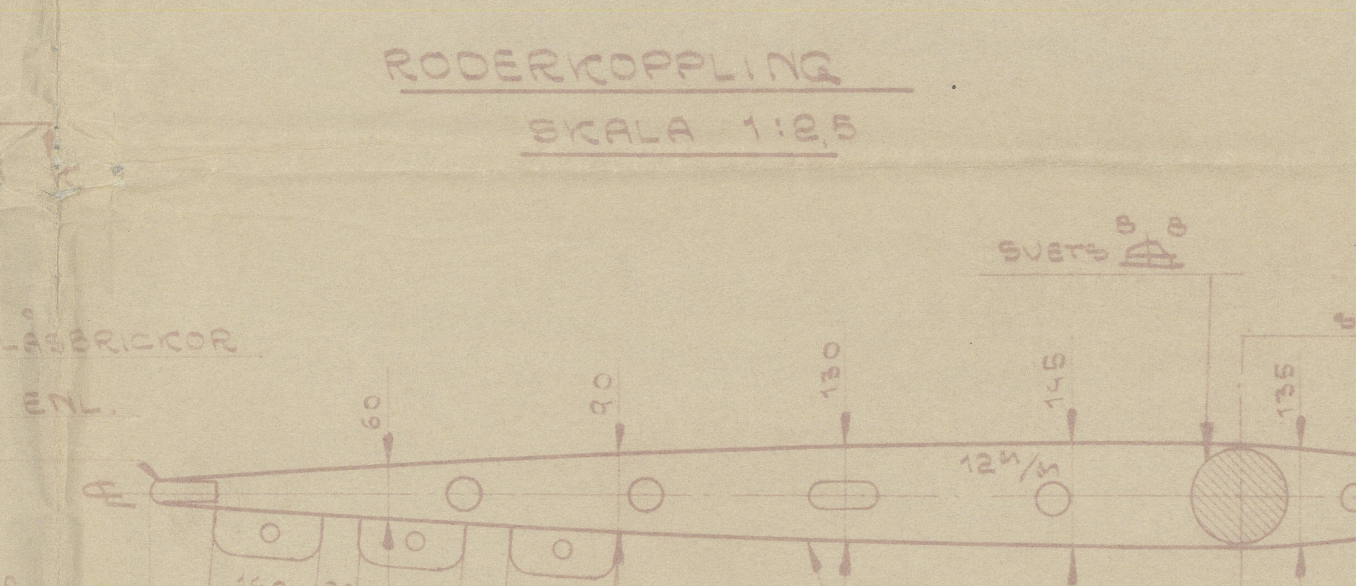



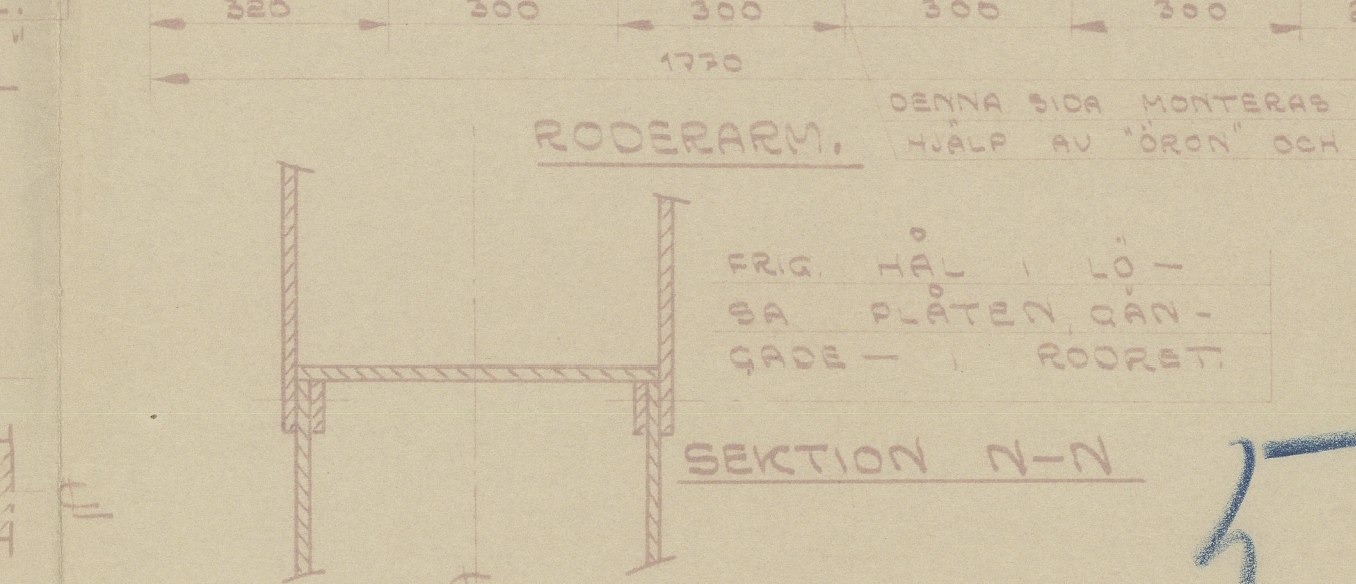


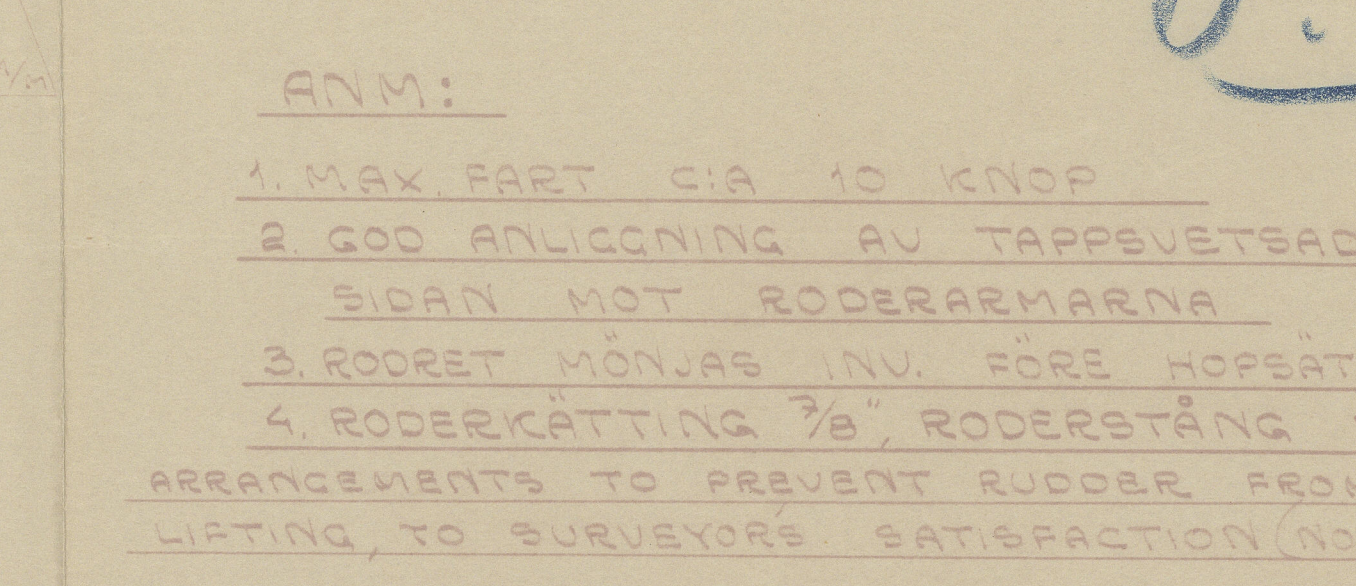


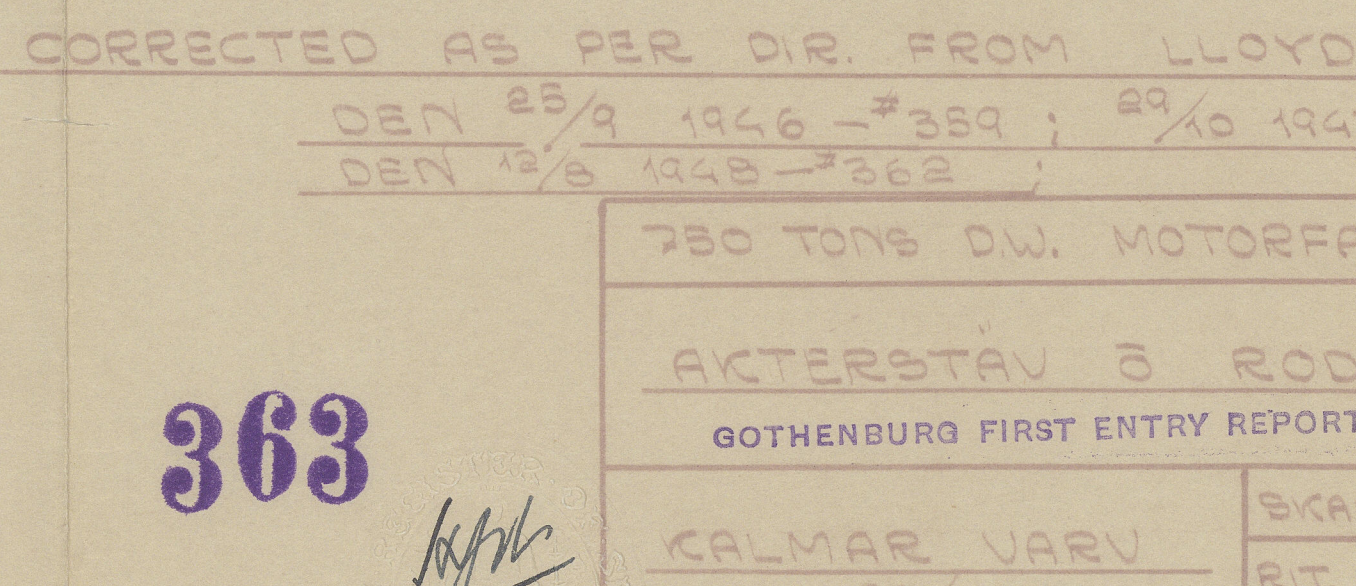


ANM:  
 1. MAX FART CIA 10 KNOP  
 2. GOD ANLIGNING AV TAPPEVETSADE  
 SIDAN MOT RODERARMARNA  
 3. ROORET MONJAS INV. FÖRE HÖPSTÄLLNING.  
 ARRANGEMENTS TO PREVENT RUDDER FROM  
 LIFTING, TO SURVEYORS SATISFACTION (NOTICE 186)


CORRECTED AS PER D.R. FROM LLOYDS  
 DEN 23/9 1946 - #359 ; 29/10 1947 - #361  
 DEN 12/8 1948 - #362

 AKTERSTAV 3 RODER  
 GÖTHEBURG FIRST ENTRY REPORT NO. 16561  
 KALMAR VARV  
 DEN 23/4 1948  
 NYB # 359 361 362  
 BEET # 8400 8600 8700

5.P

363



"FENJA"  *HOTONUI*

*Stemframe & rudder*

RECORDS DEPT.,  
LONDON

5



© 2020

Lloyd's Register  
Foundation

010631-010639-0223