


LLOYD'S
STAMP.
18. 12. 19.

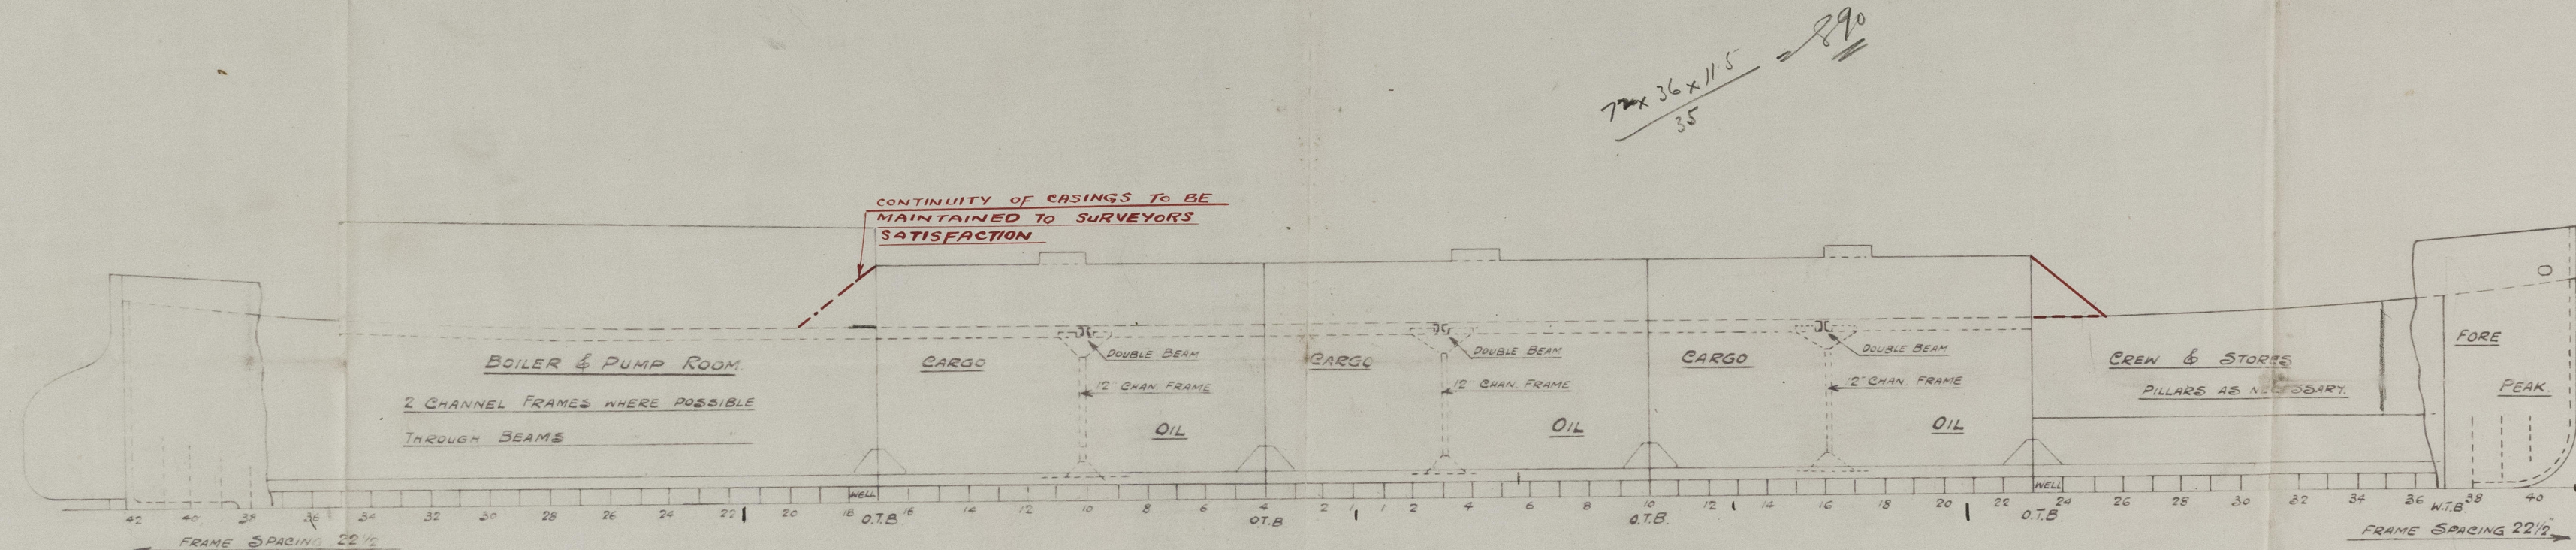

OIL BARGE No 617-18-19-20-21-22-23

155'-0" x 36'-0" x 11'-8" K. to B.

SCALE 1/8" = 1 FOOT.

PLANS SHOWING STIFFENING OF OIL BULKHEADS TO BE SUBMITTED

PLAN OF DECK TO BE SUBMITTED

PLAN SHOWING ARRANGEMENT BEFORE & AFT THE OIL FUEL


TANKS TO BE SUBMITTED

TO CLASS AT LLOYD'S AX FOR HARBOUR

AND RIVER PURPOSES ONLY

CARRYING OIL FUEL IN BULK.

L.W.F.
18. 12. 19

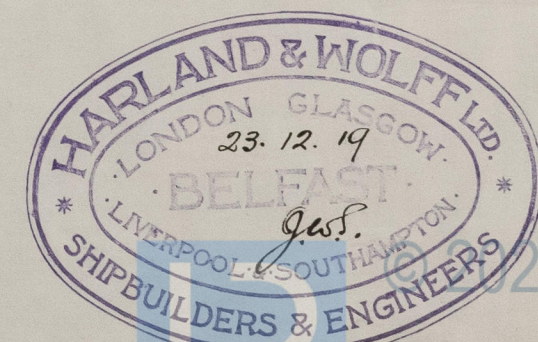

Lloyd's Register
Foundation

AS (SHOP)

Profile

617. Britmex No 2. *

BRITMEX No 2

010662-010674-0188



© 2021

Lloyd's Register
Foundation