


GEORGE CLARK (1938) LTD.

SUNDERLAND

Nov. 21. 1952.

NEWCASTLE-ON-TYNE, No. 110058

DEC 1952

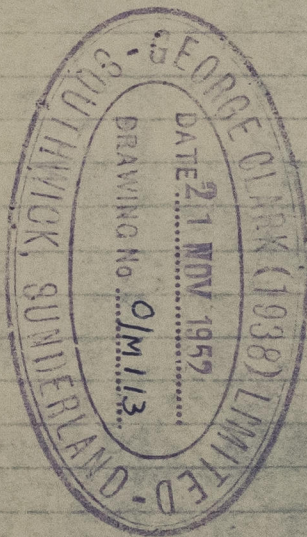



S/S BALTUK.

*Dia of Intermediate Coupling*

DISTANCES OF PLUGS FROM Y

A 5'-1 3/8" B 10'-3 1/2"

C 6'-10 3/8" D 12'-1 1/2"

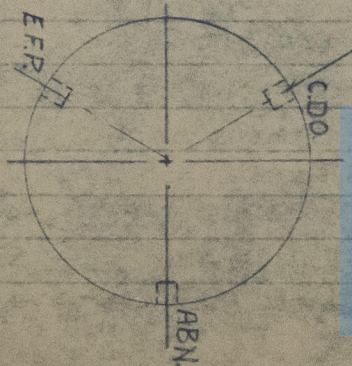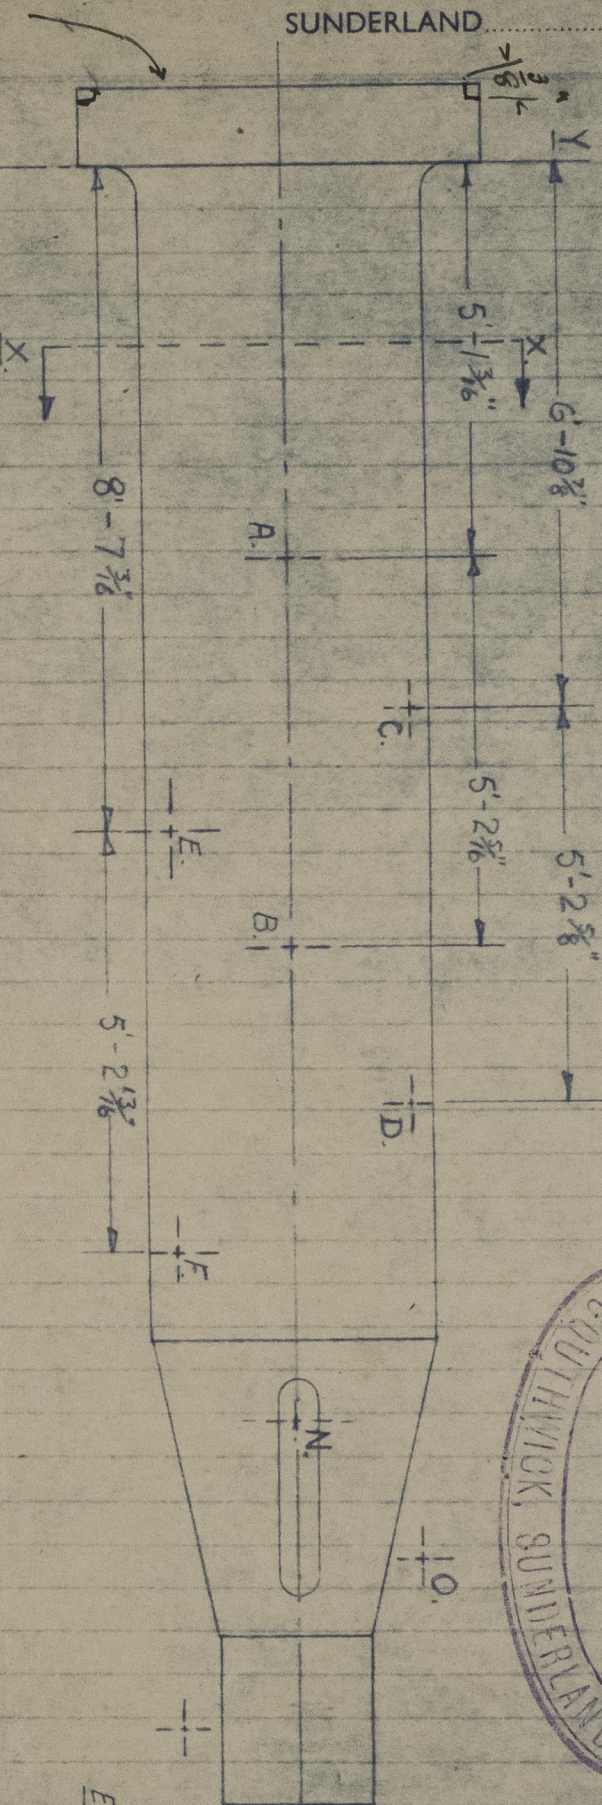

APPROX. POSITIONS OF PLUGS MARKED N.O.D.P.

ARE AS SHOWN. THESE PLUGS WERE TURNED OUT

SHORTENED.



© 2021 Lloyd's Register Foundation

010720-010726-0110