


2-4-45.

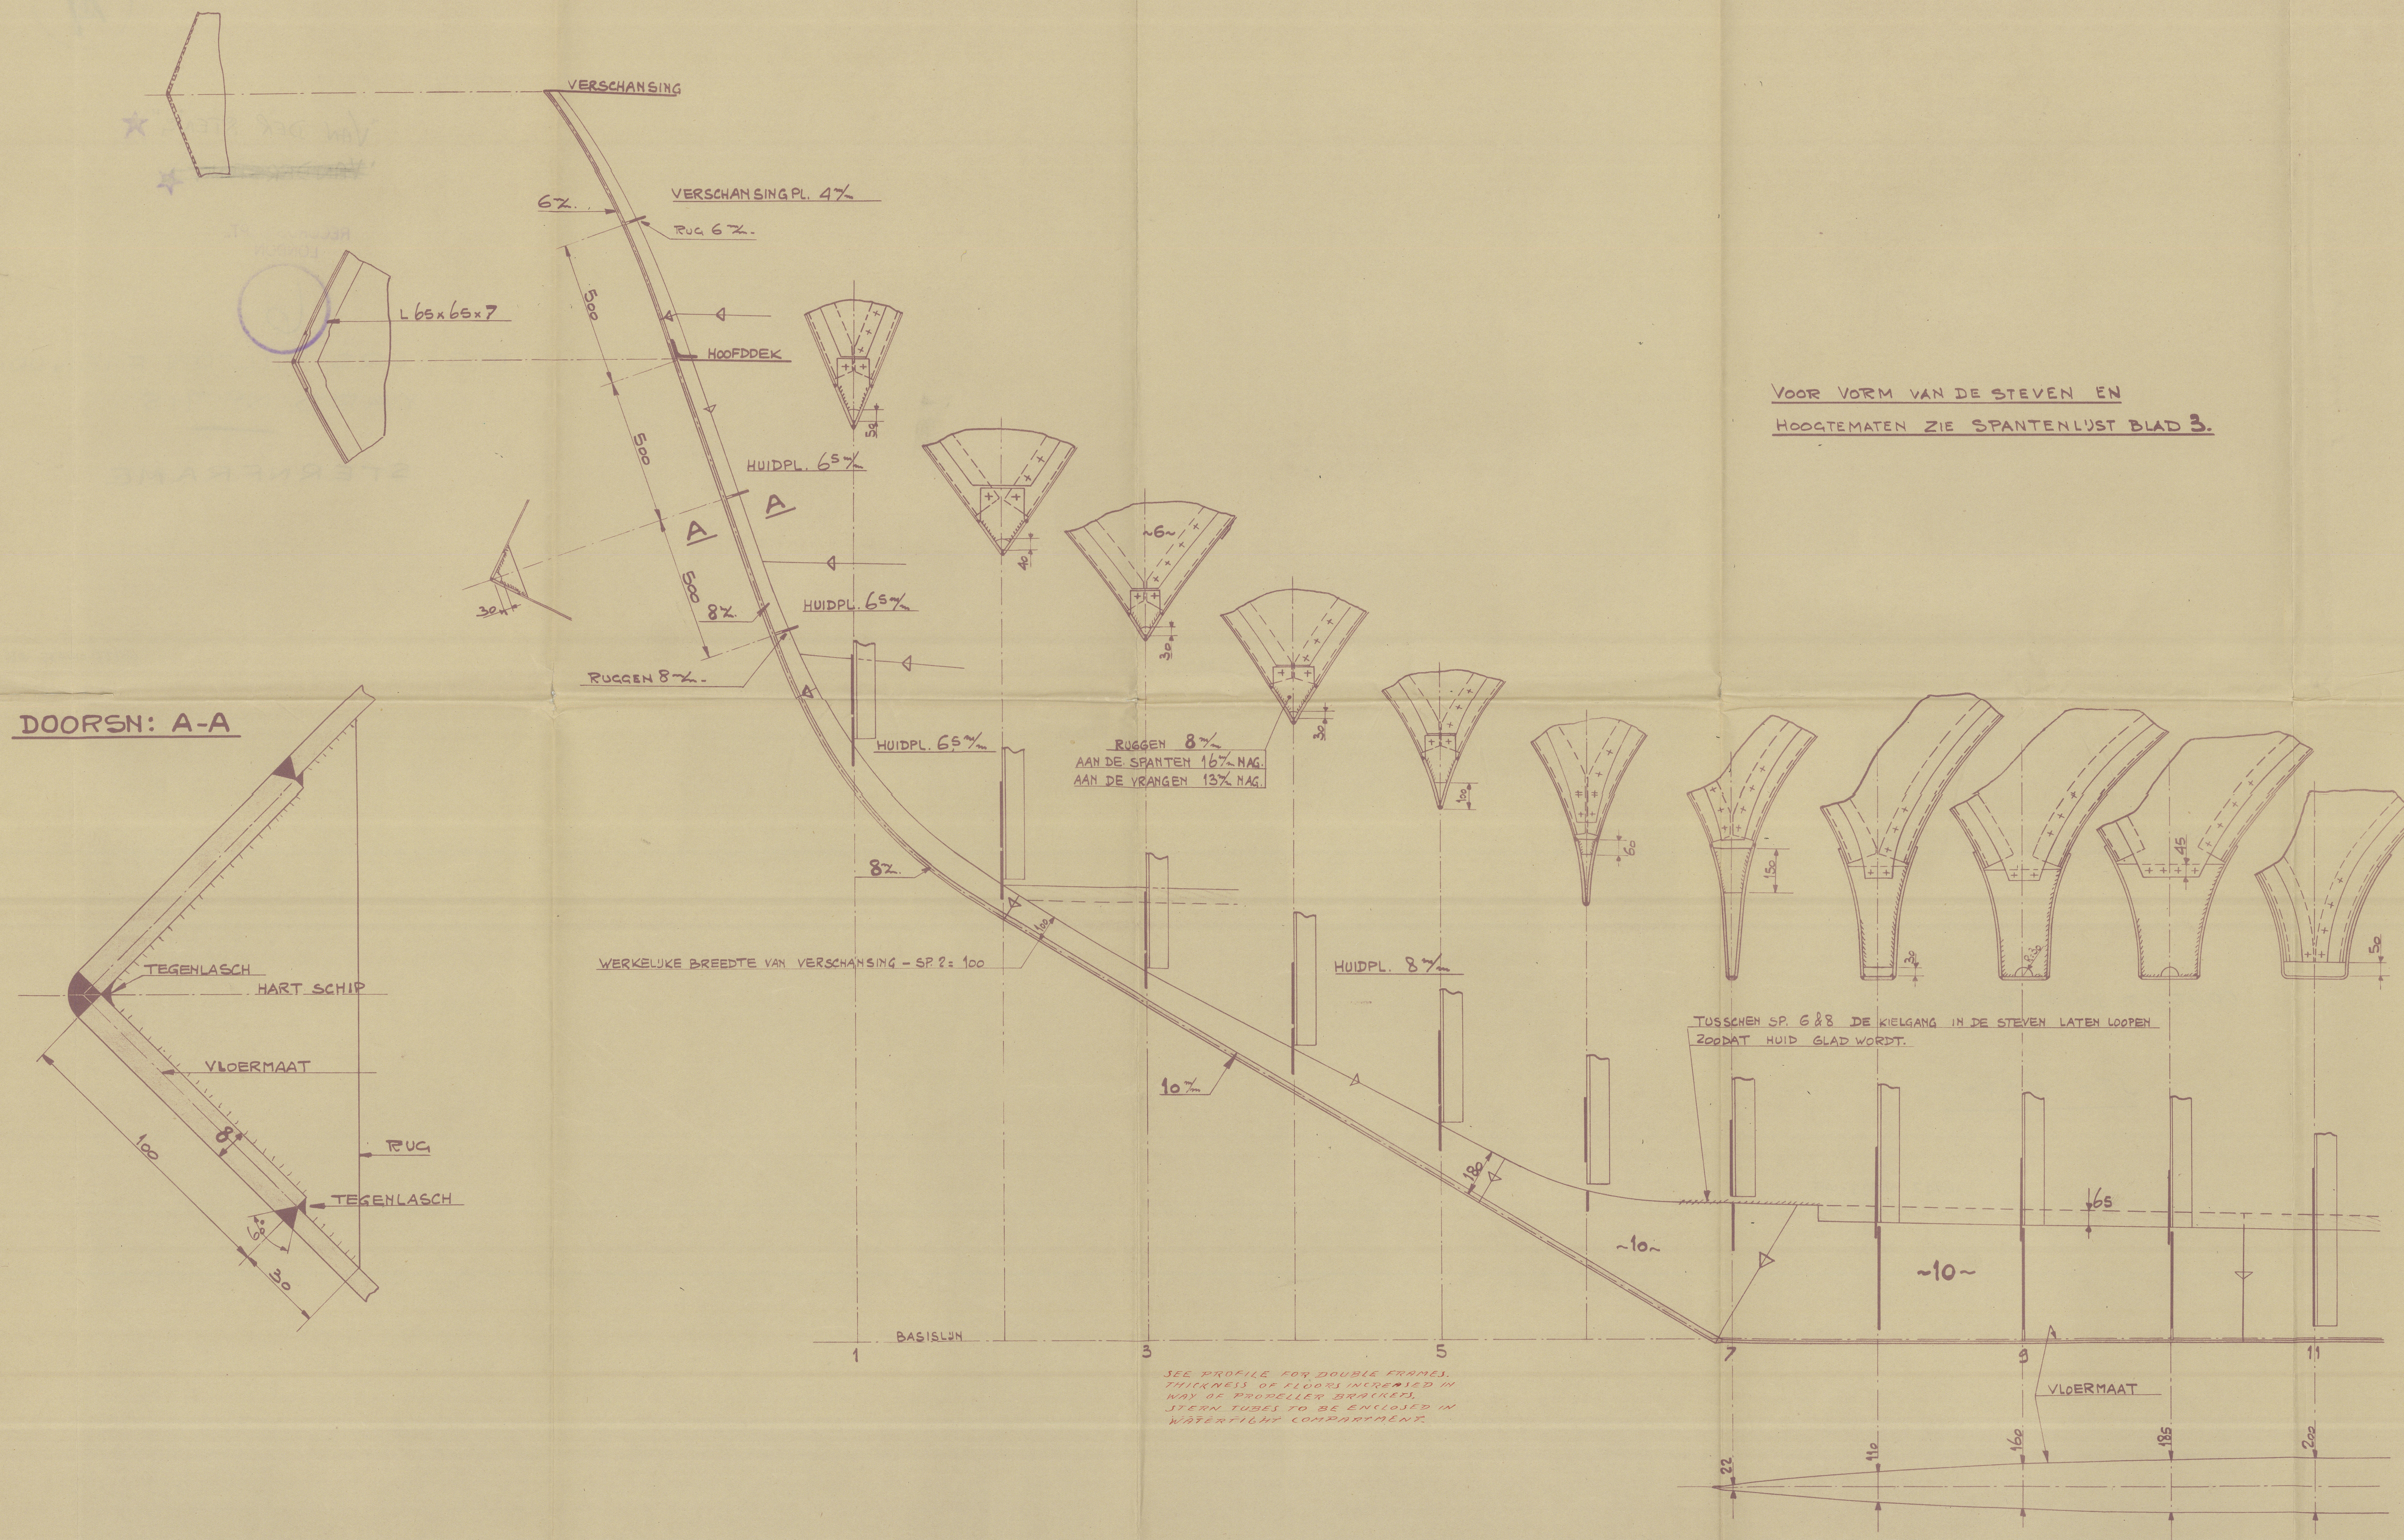

VOOR VORM VAN DE STEVEN EN  
HOOGTEMATEN ZIE SPANTENLIJST BLAD 3.

TUSSENEN SP. 6 & 8 DE KIELGANG IN DE STEVEN LATEN LOOPEN  
ZODAT HUID GLAD WORDT.

2-4-45.


TEEK. NO 3.

VANDER STENG  
ACHTER STEVEN

SCHAAL 1:10.

22-6-45.




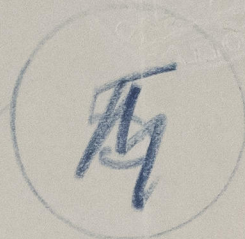

"VAN DER STENG" ★

~~"VANDERSTENG"~~ ★

RECORDS DEPT.,  
LONDON

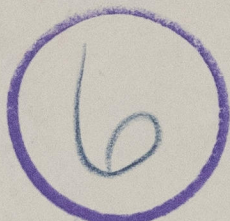

MESSRS. WILTON FVENDOORD

YARD NO. 715

STERNFRAME



© 2021

Lloyd's Register  
Foundation

0107271010733-0086



L.

MESSRS. WILTON-FYENHOOD  
YARD N° 415.

CONTACT-SHIP "VANDERSTENG"

STERN FRAME.

010727-010733-0086



© 2021

Lloyd's Register  
Foundation