

FEB 17 1941


Lloyd's Register of Shipping.

SURVEYS FOR FREEBOARD.

(CONDITIONS OF ASSIGNMENT.)

Ship's Name MOTOR COASTER "EMPIRE FORELAND" Port of Survey Skull.
 Official Number 164909. Surveyor's Signature [Signature]
 Nationality and Port of Registry British. Goole. Date of Survey While building at Goole.

Disposition and dimensions of superstructures, trunks, deckhouses and machinery casings to be inserted in the diagrams and tabular statement:—

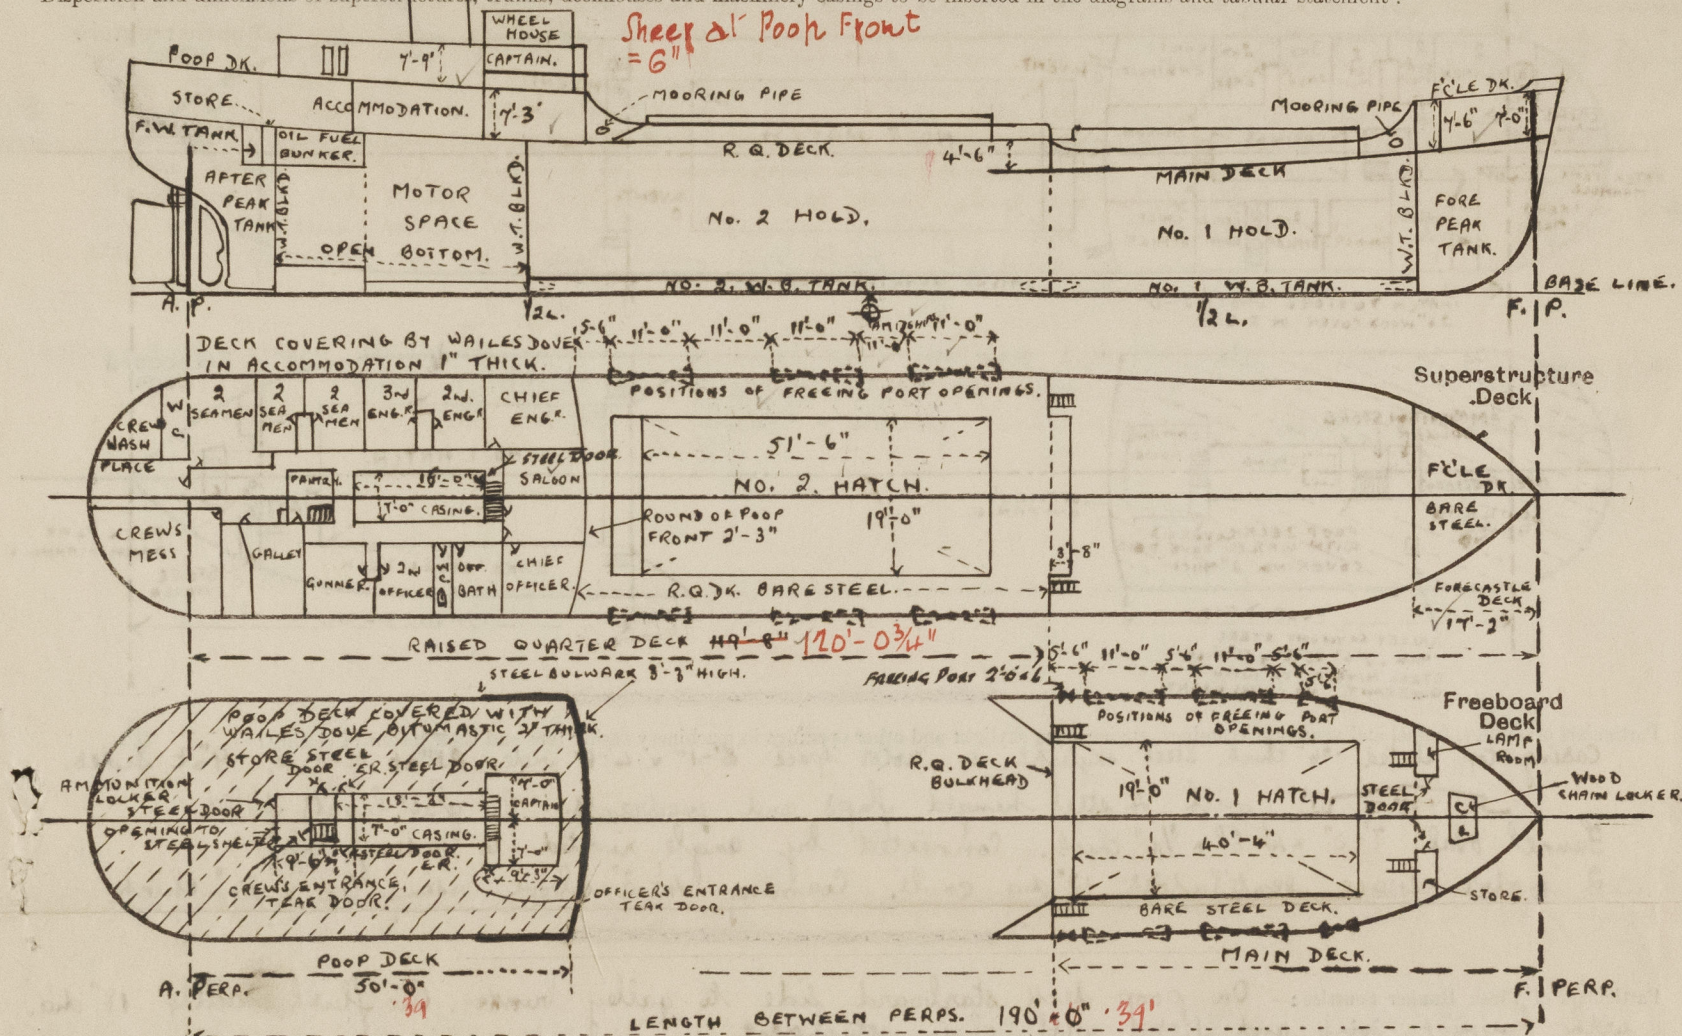

Particulars of Superstructures, Trunks, Casings, Deckhouses.

	Coaming	Plating	Stiffeners	Spacing	End Attachments of Stiffeners	Size of Openings	Height of Sills	Height of Casings
Poop Bulkhead ...	✓	.26	5 x 3 x 5/16"	30"	Knees top and bottom	None	✓	7'-3"
Raised Quarter Deck Bulkhead ...	✓	.32	3 x 3 x 5/16"	33"	✓	None	✓	4'-6"
Bridge, After Bulkhead ...	✓	✓	also diaphragm plates at centre and sides.	✓	✓	✓	✓	✓
Bridge, Forward Bulkhead ...	✓	✓	✓	✓	✓	✓	✓	✓
Forecastle Bulkhead (SIDE HOUSES) ...	✓	.26	2 1/2" Flanges.	33"	✓	Steel door 5'-0" x 1'-11"	21"	4'-6"
Trunk, Aft ...	✓	✓	✓	✓	✓	✓	✓	✓
Trunk, Forward ...	✓	✓	✓	✓	✓	✓	✓	✓
Exposed Machinery Casings on Freeboard or Raised Quarter Decks ...	✓	✓	✓	✓	✓	✓	✓	✓
Exposed Machinery Casings on Superstructure Decks ...	✓	.26	3 x 2 1/2 x .26	28"	Knees at top	4'-6" x 1'-10"	21"	7'-9"
Machinery Casings within Superstructures not fitted with Class I Closing Appliances ...	18 x .32	.26	3 x 2 1/2 x .26	28"	✓	1 Steel Hinged Door Emergency Escape from Fore Room 4'-6" x 1'-9"	6"	7'-3"
Deckhouses on Flush Deck Ships ...	✓	✓	✓	✓	✓	✓	✓	✓

Particulars of Closing Appliances (state if capable of being manipulated from both sides).

Poop Bulkhead ...	No openings.
Raised Quarter Deck Bulkhead ...	No openings.
Bridge, After Bulkhead ...	✓
Bridge, Forward Bulkhead ...	open Forecastle
Forecastle Bulkhead ...	Forecastle sidehouses I.P. & I.S. Steel hinged doors with spring locks handles both sides.
Exposed Machinery Casings on Freeboard or Raised Quarter Decks ...	E.R. entrance steel door P.S. 4'-6" x 1'-10" spring locks and handles both sides. Officers entrance on starboard side of Captains deckhouse back door 4'-6" x 1'-9" x 1 1/2" thick spring lock handles both sides. Crews entrance by back door 4'-6" x 1'-10" with 21" fill spring lock and handles both sides. Protected by steel shelter having entrance opening 4'-7" x 2'-0" with 21" fill. Ammunition locker and store steel doors hinged 4'-6" x 2'-0" with 21" fill, rubber jointed and secured by butterfly fasteners.
Machinery Casings within Superstructures not fitted with Class I Closing Appliances ...	1 Steel Hinged Door Emergency Escape from Fore Room 4'-6" x 1'-9"
Deckhouses on Flush Deck Ships ...	✓

PARTICULARS OF PROTECTION TO OPENINGS, ETC.

HATCHWAYS ON FREEBOARD AND SUPERSTRUCTURE DECKS.									
Description of Hatchway		No. 1. Hatch Main Deck			No. 2 Hatch R. Q. Deck				
Dimensions of Hatchway		40'-4" x 19'-0" at Hatch top.			51'-6" x 19'-0" at Hatch top.				
COAMINGS	Height above Deck	3'-6" at fore end.			3'-6"				
	Thickness	.43			.43				
	Sides	.43			.43				
	Ends	.43			.43				
Stiffeners	...	7 x 3 x 3/8" B.A. upper stiff. 5 x 3 x 3/8" B.A. lower stiff.			7 x 3 x 3/8" B.A.				
	Brackets, Stays	5 off each side .30 flanged plates			7 off .30 flanged plates				
HATCH BEAMS	Number	7 Webs.			9 Webs.				
	Spacing	5'-0 1/2"			5'-1 5/8"				
	Scantling and Sketch	<p>ANGLES 5" x 3" x 5/16" ✓ PLATE 17" x 36" CENTRE ✓</p>			<p>ANGLES 5" x 3" x 5/16" ✓ PLATE 13" x 34" CENTRE ✓</p>				
	Bearing Surface	5"			5"				
FORE AND AFTERS	Number	NONE			NONE				
	Spacing								
	Unsupported Lengths								
	Scantling* and Sketch								
HATCH COVERS	Material	white pine with steel end shoes.			white pine with steel end shoes.				
	Thickness	3 1/2"			3 1/2"				
	How fitted	Fore and aft.			Fore and aft. ✓				
	Bearing Surface	3"			3"				
Spacing of Cleats		24"			24"				
Number of Tarpaulins		2.			2.				
<p>*Are wood fore and afters steel shod at all bearing surfaces? ✓ yes.</p> <p>Are battens and wedges efficient and in good condition? ✓ yes.</p> <p>Are tarpaulins in good condition and in accordance with rule requirements? ✓ yes.</p> <p>Are lashings provided in accordance with rule requirements? ✓ yes. 1/2" wire lashings with 5/8" stretching screws. ✓ 2 lashings for each bay of covers.</p>									

Particulars of any special features:—

Endorsement at first survey and at surveys for renewal of Certificate:—

The fittings and appliances are in accordance with the particulars shown on this form (or as now modified) and are in good condition.



© 2021

Lloyd's Register Foundation