


RAISED QUARTER DECK 3'-4"
SCALE 1/2" = 1 FT
TO CLASS LLOYDS 100 A.I. ✚

$$\begin{array}{rcl} L \times D & = & 150 \times 10.0 = 1500 \\ L \times (B+D) & = & 150 \times 36 = 5400 \\ \frac{L}{D} & = & \frac{150}{10} = 15 \\ d & = & 7.66 \end{array}$$

L*(B+D)	150(26+10)	=	5400
RAISED Q. D.	66*3.33		220
POOP	27*6.75*75		137
FORECASTLE	18*5*6*75		83
CASING	18*6.75*.50		61
BRIDGE	12.25*6.75*.50		41
			5942

2 BOWER ANCHOR	9 CWTs.	Stockless
1 Stream	3 "	Ex Stock
165 FATHOMS	1 "	5" Stud Link Cable
45 "	2 1/2 "	5 Wire Stream
75 "	2 1/2 "	5 Wire Towline
90 "	5 1/2 "	Manilla Hawser

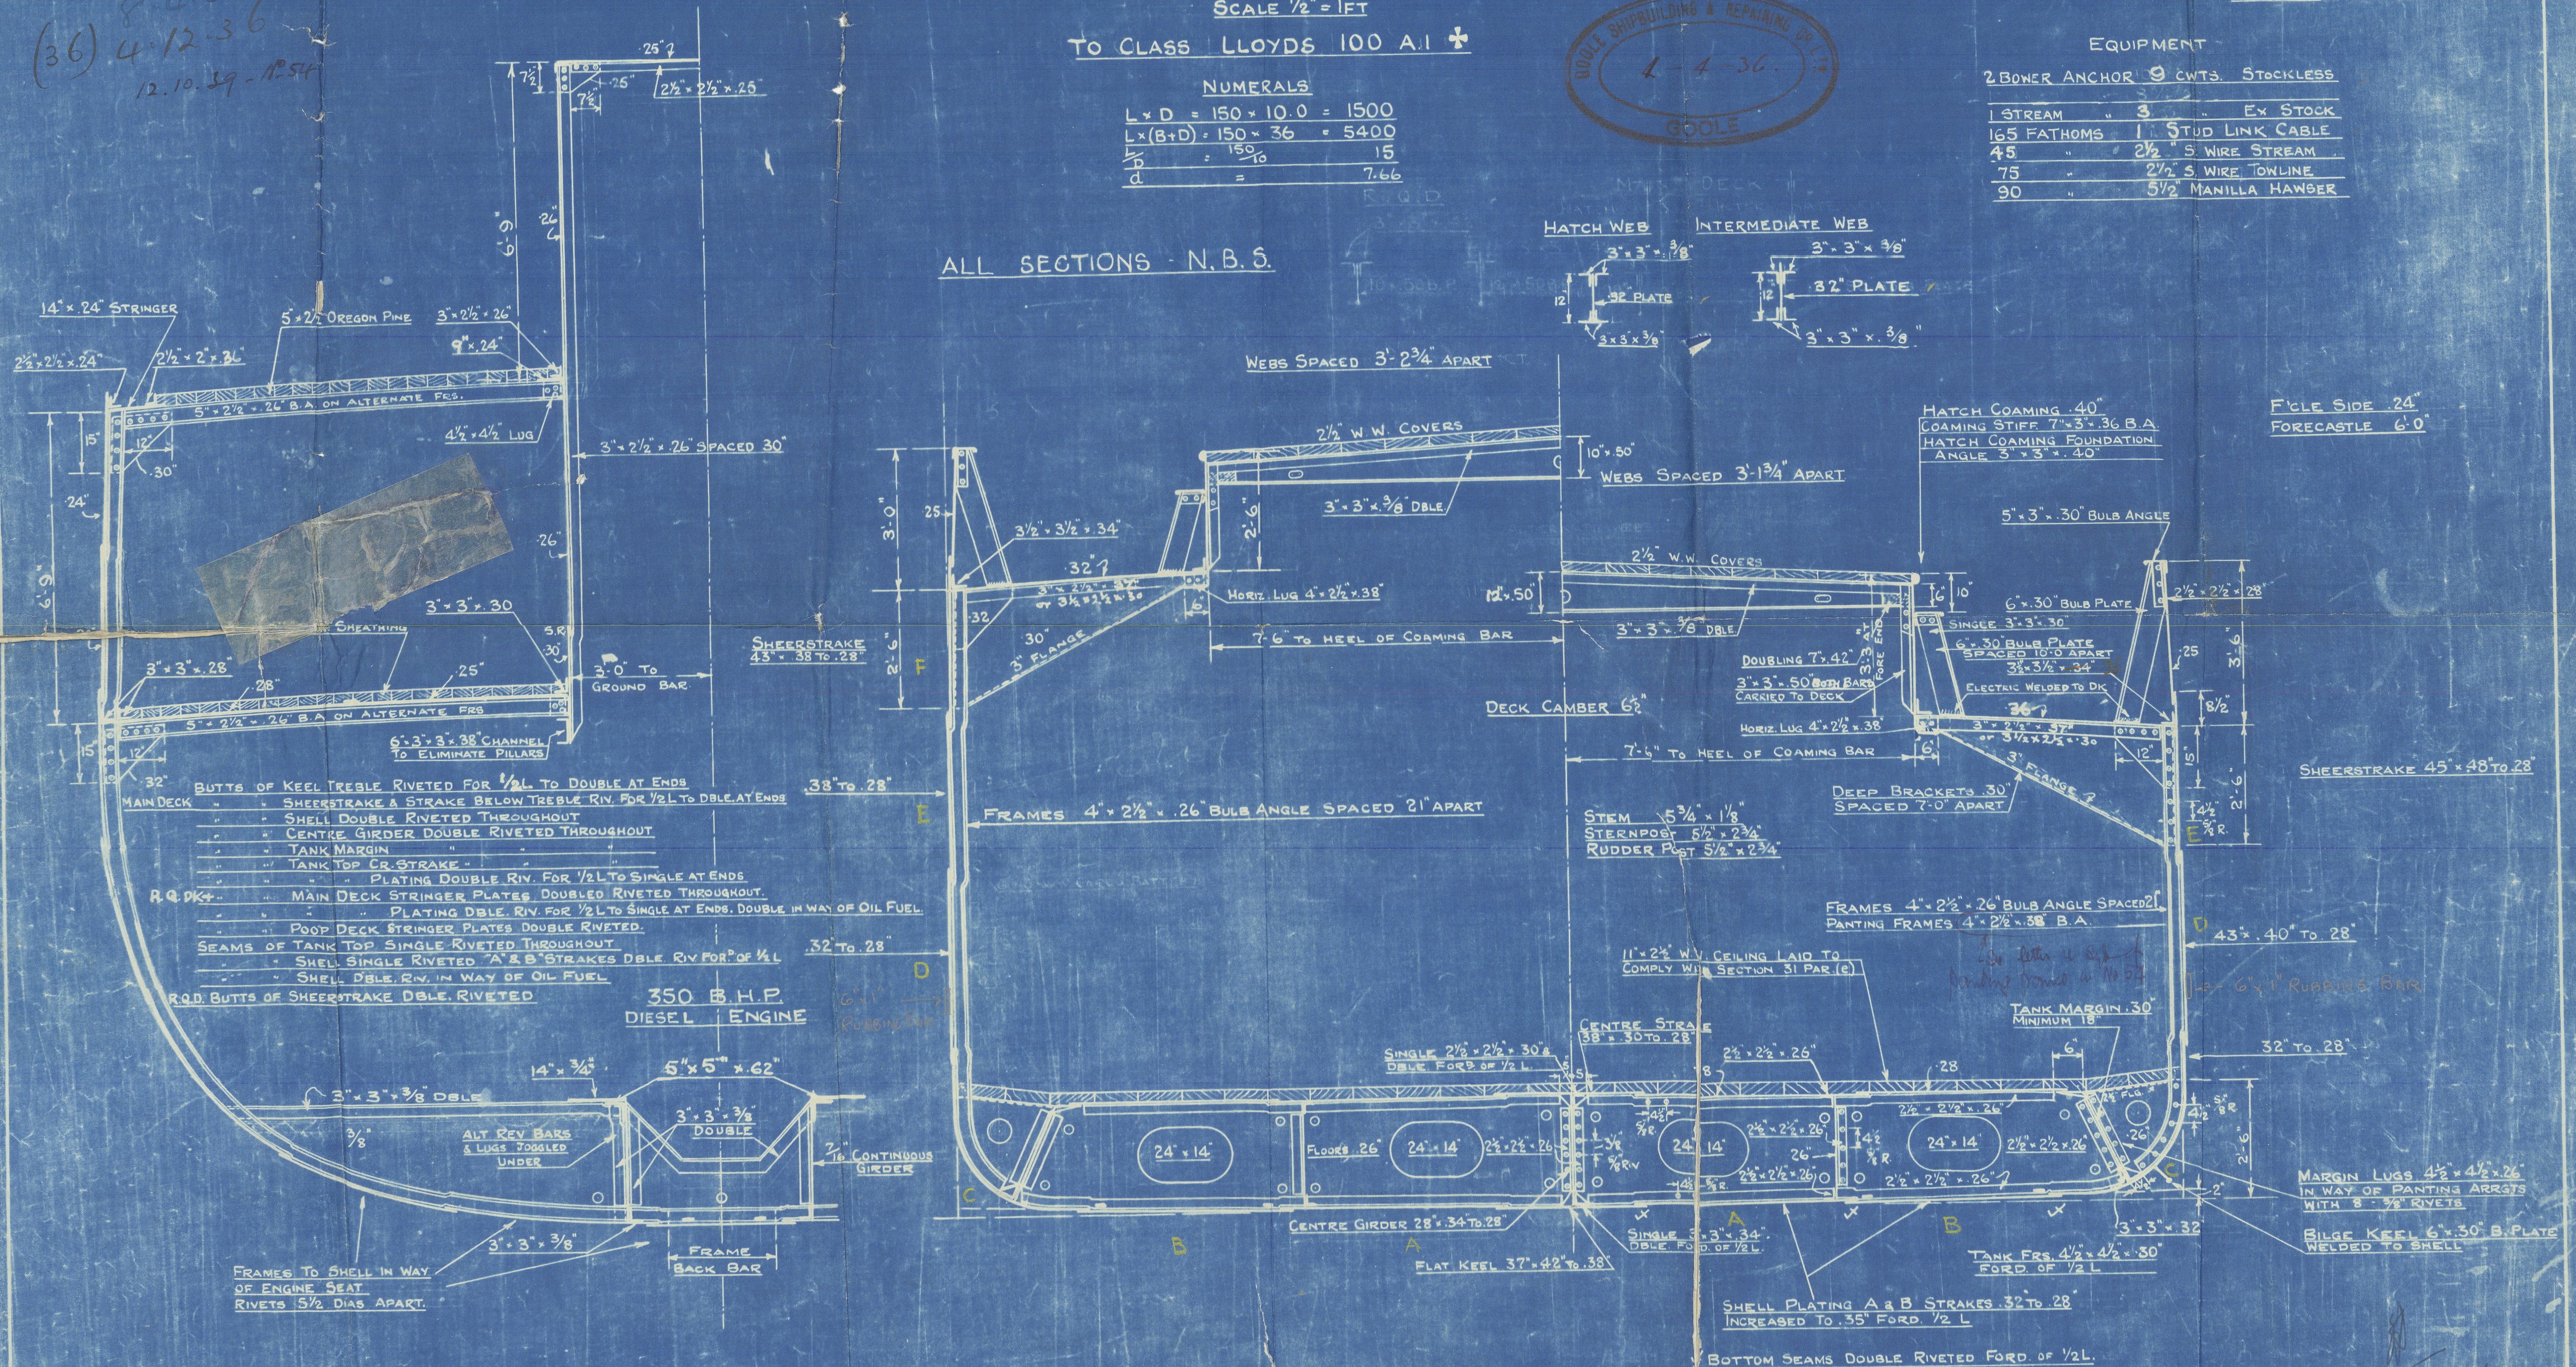

PRINT No.

GOOLE SHIPBUILDING & REPAIRING CO. LTD
GOOLE

①
Clelands Ship No 35.136. ~~154~~

Midship Section.

Ss. Hullgate

NEWCASTLE ON TYNE.

Report No. 94402.

Mr. NORTHGATE *

NEWCASTLE ON TYNE.

Report No. 99121.

PLANS TRANSFERRED
TO SISTER VESSEL

Nyngate



© 2021

Lloyd's Register
Foundation

2000-06010-82F010