

31.8.26



# PROPOSED M.V. 400' BP: 54'-6" MLD: 29'-7 1/2" MLD TO UPPER D.K.

## LONGITUDINAL ELEVATION.

SCALE 1/8" = 1 FOOT.

TO CLASS 100A1. SINGLE DECK WITH 52% SUPERSTRUCTURE.

Note: Correct position of Buckheads, Holders, Etc. are indicated in Yellow

  



N<sup>os</sup> 760-761-762 & 763.  
Harland & Wolff Ltd


Proposed 400 ft MV.

Profile

Gull Scantlings with  
P.B & F - 52%.

Single Deck.

alterations indicated in  
Yellow. ink.


"King John"  W/S 507

"King Lud"

"King Neptune" *Wing on* n/n

"King Arthur"

PLANS TRANSFERRED  
TO SISTER VESSEL

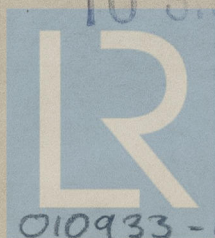

© 2021

Lloyd's Register  
Foundation

010933-010942-0073