
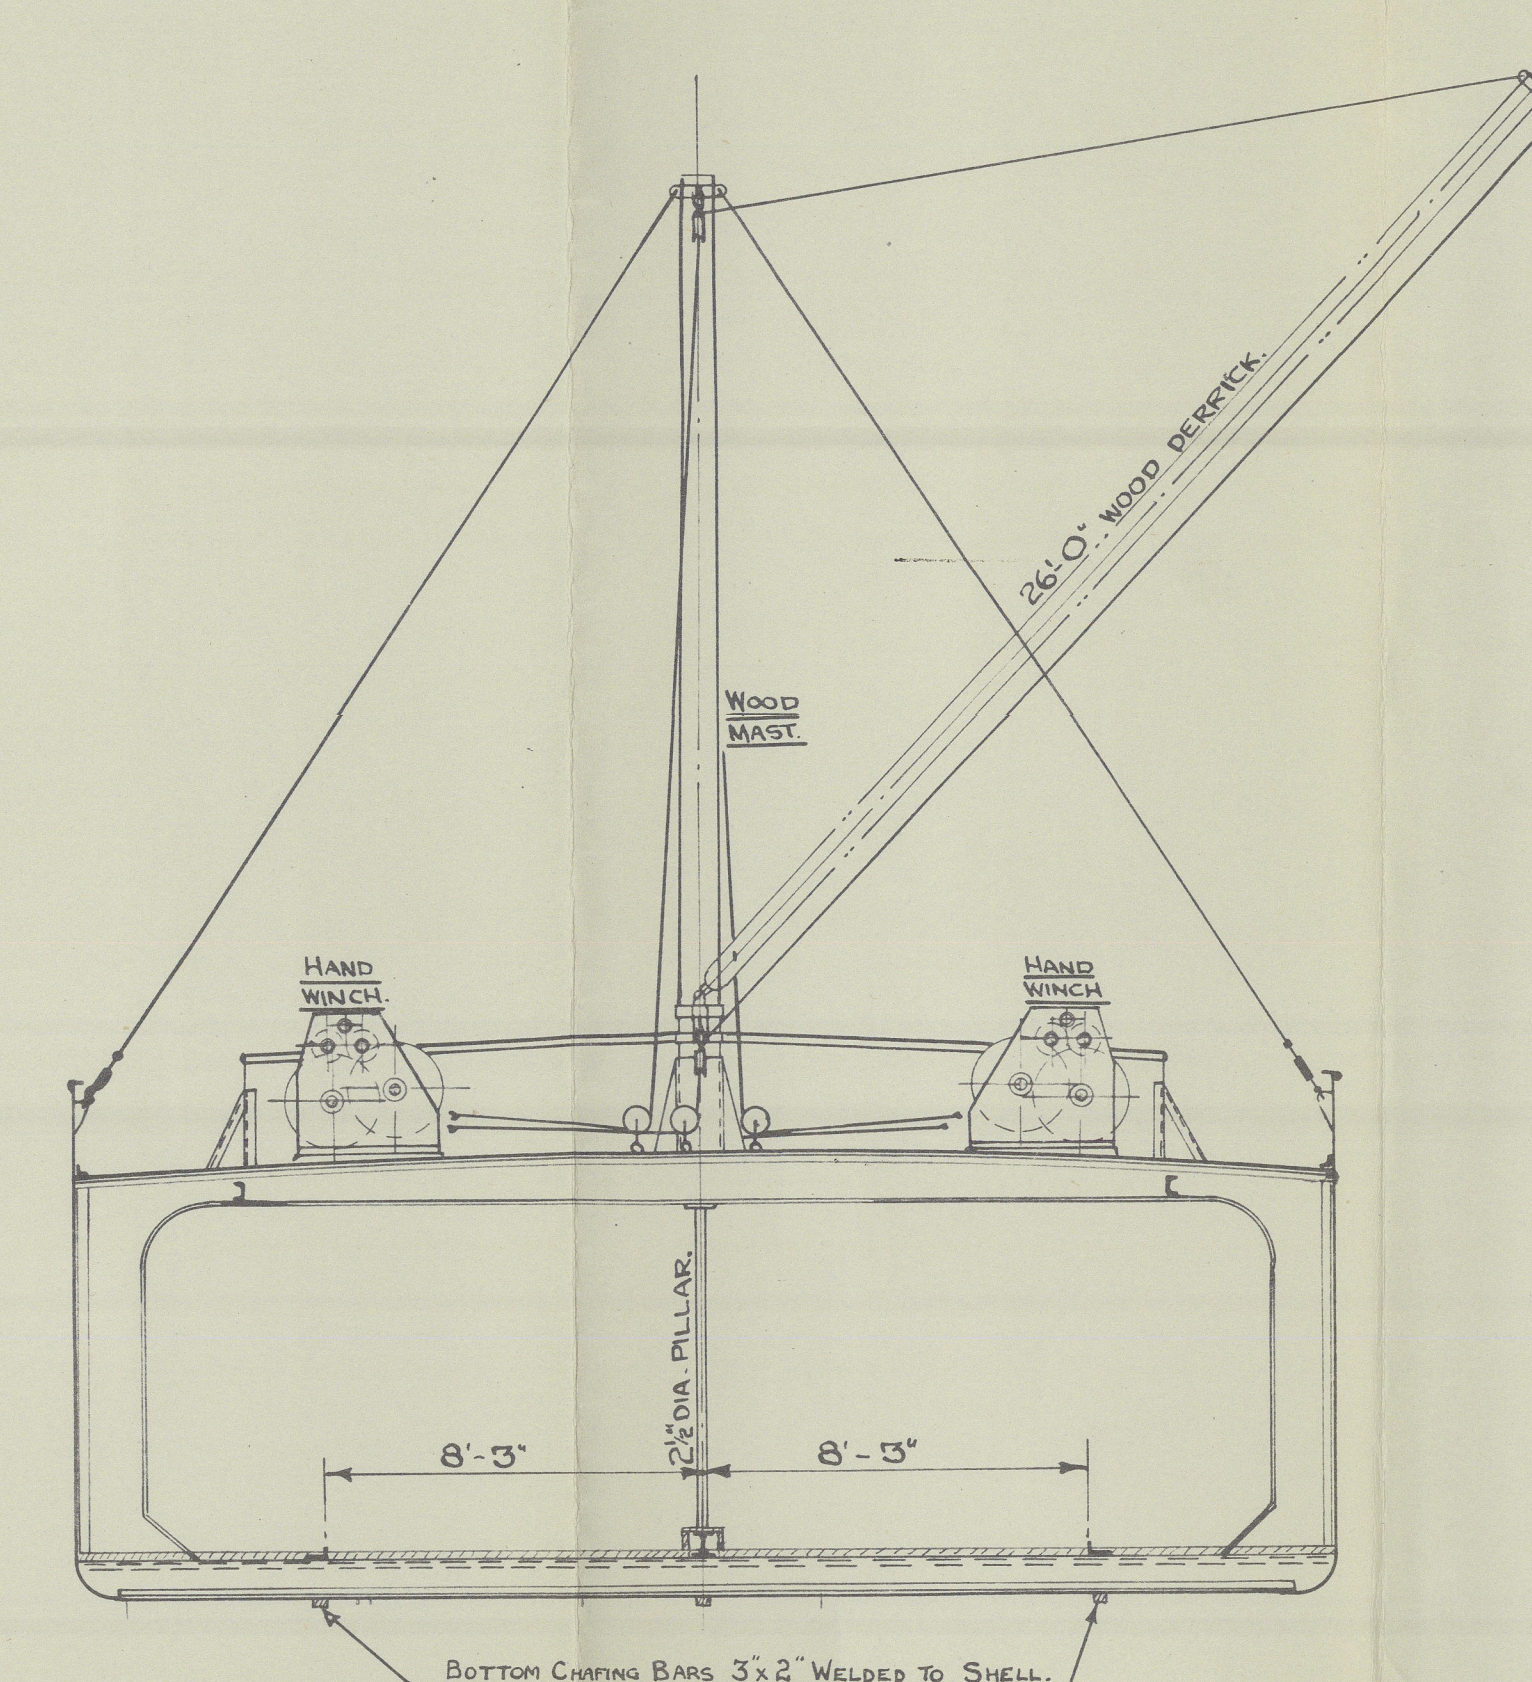


**SHIPS N<sup>o</sup> 244-248.**  
**STEEL CARGO LIGHTER.**  
**GENERAL ARRANGEMENT.**  
**SCALE:- 1/4 INCH = 1 FOOT.**


**PRINCIPLE DIMENSIONS:-**  
**LENGTH B.P. 82' - 3 1/2"**  
**MLD. BREADTH. 26' - 3"**  
**MLD. DEPTH. 8' - 9 1/2"**

**BARGE N<sup>o</sup> 244**  
**245 246**

LLOYDS  
 REGISTRY OF  
 SHIPPING  
 INT'L  
 DATE 12-5-49

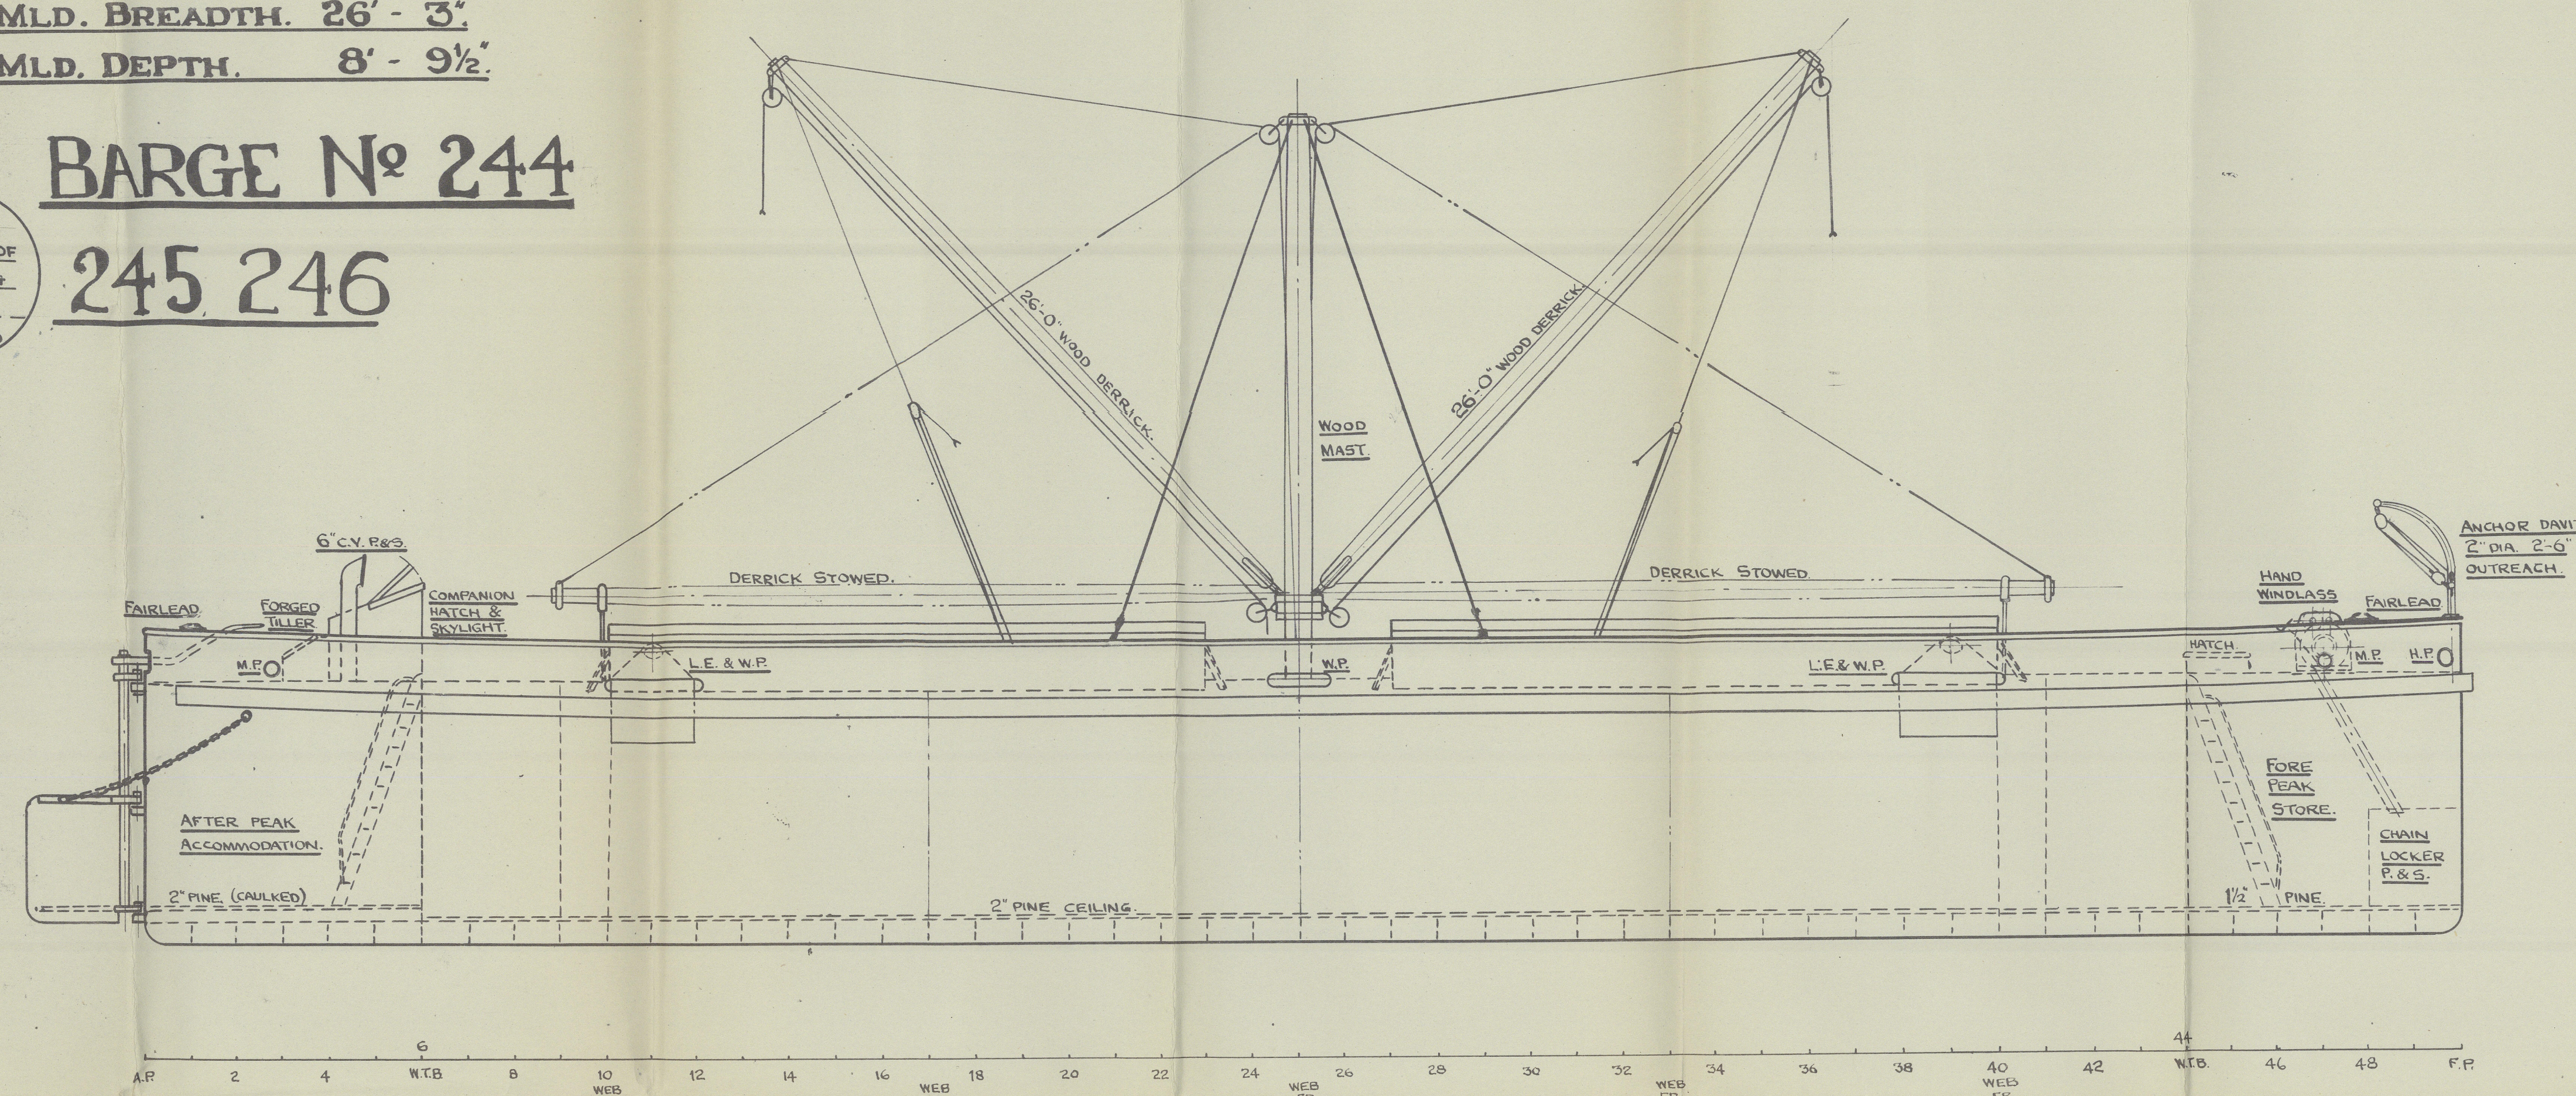

**SECTION AT FRAME No. 25.**

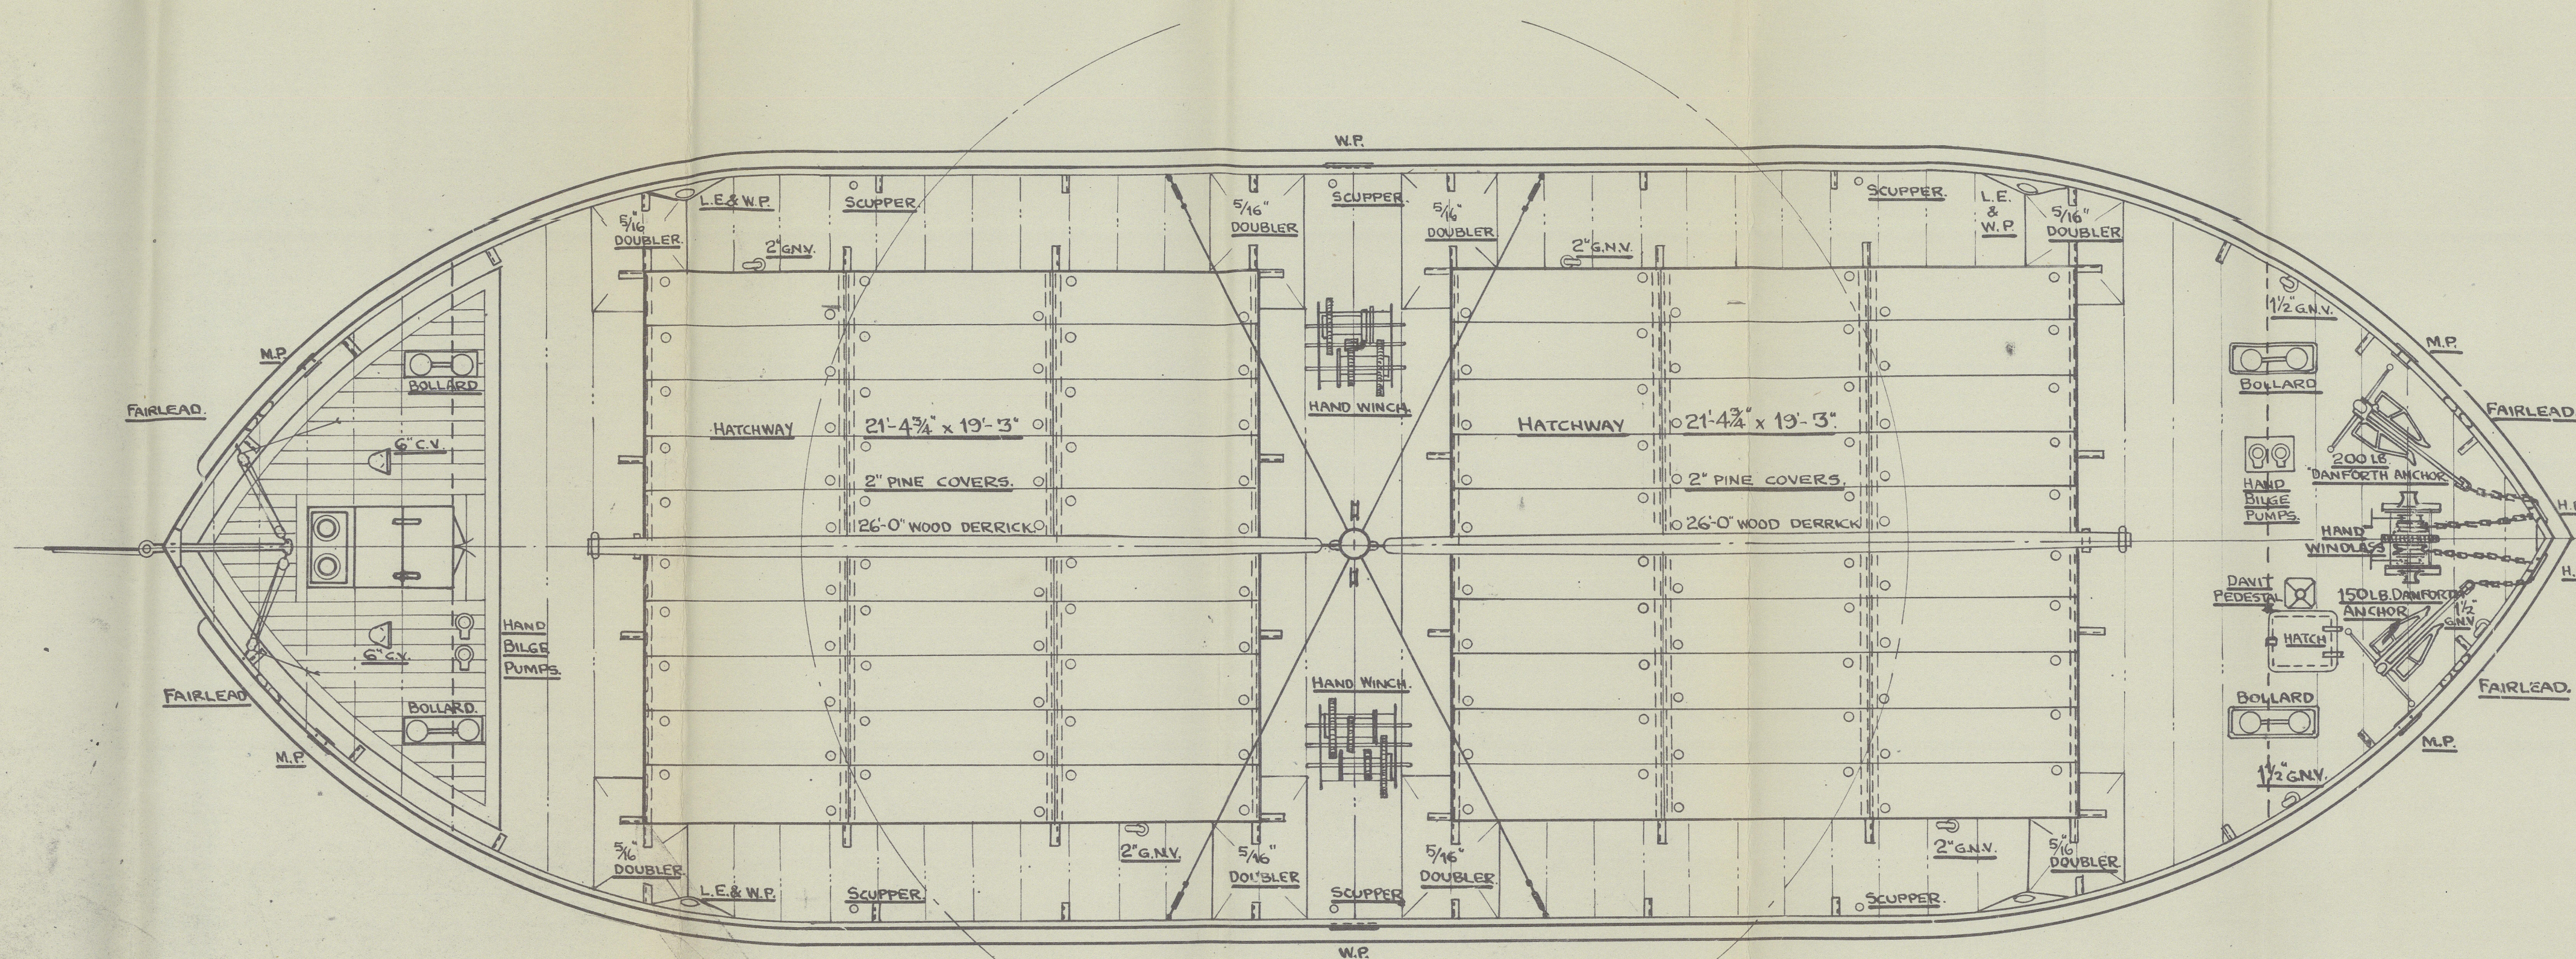

**LEGEND:-**

- C.V. COWL VENT.
- GNV. GOOSE NECK VENT.
- H.P. HAWSE PIPE.
- L.E. LIFTING EYE.
- M.P. MOORING PORT.
- W.P. WASH PORT.

WHITES SHIPYARD (SOUTHAMPTON) LTD.  
 DRAWING  
 21 MAR 1950  
 OFFICE  
 LITTON, SOUTHAMPTON

**WHITES SHIPYARD**  
**(SOUTHAMPTON) LIMITED.**  
 ITCHEN SOUTHAMPTON.

DRAWN	DATE	SHIP:-	DESCRIPTION:-	SCALE	PRINT No.
48.	24-11-49.	244 - 248.	GENERAL ARRANGEMENT.	1" = 1'-0	1/244-48/48
TRCD.	182.				
DATE	25-11-49.				


010443-01096220118



"MARTA" ★

General art.

RECORDS DEPT.,  
LONDON

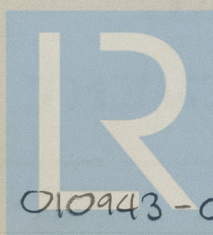

© 2020

Lloyd's Register  
Foundation

010943-010952-0118