


*Chesford*  
GEN. BOX NO. 15

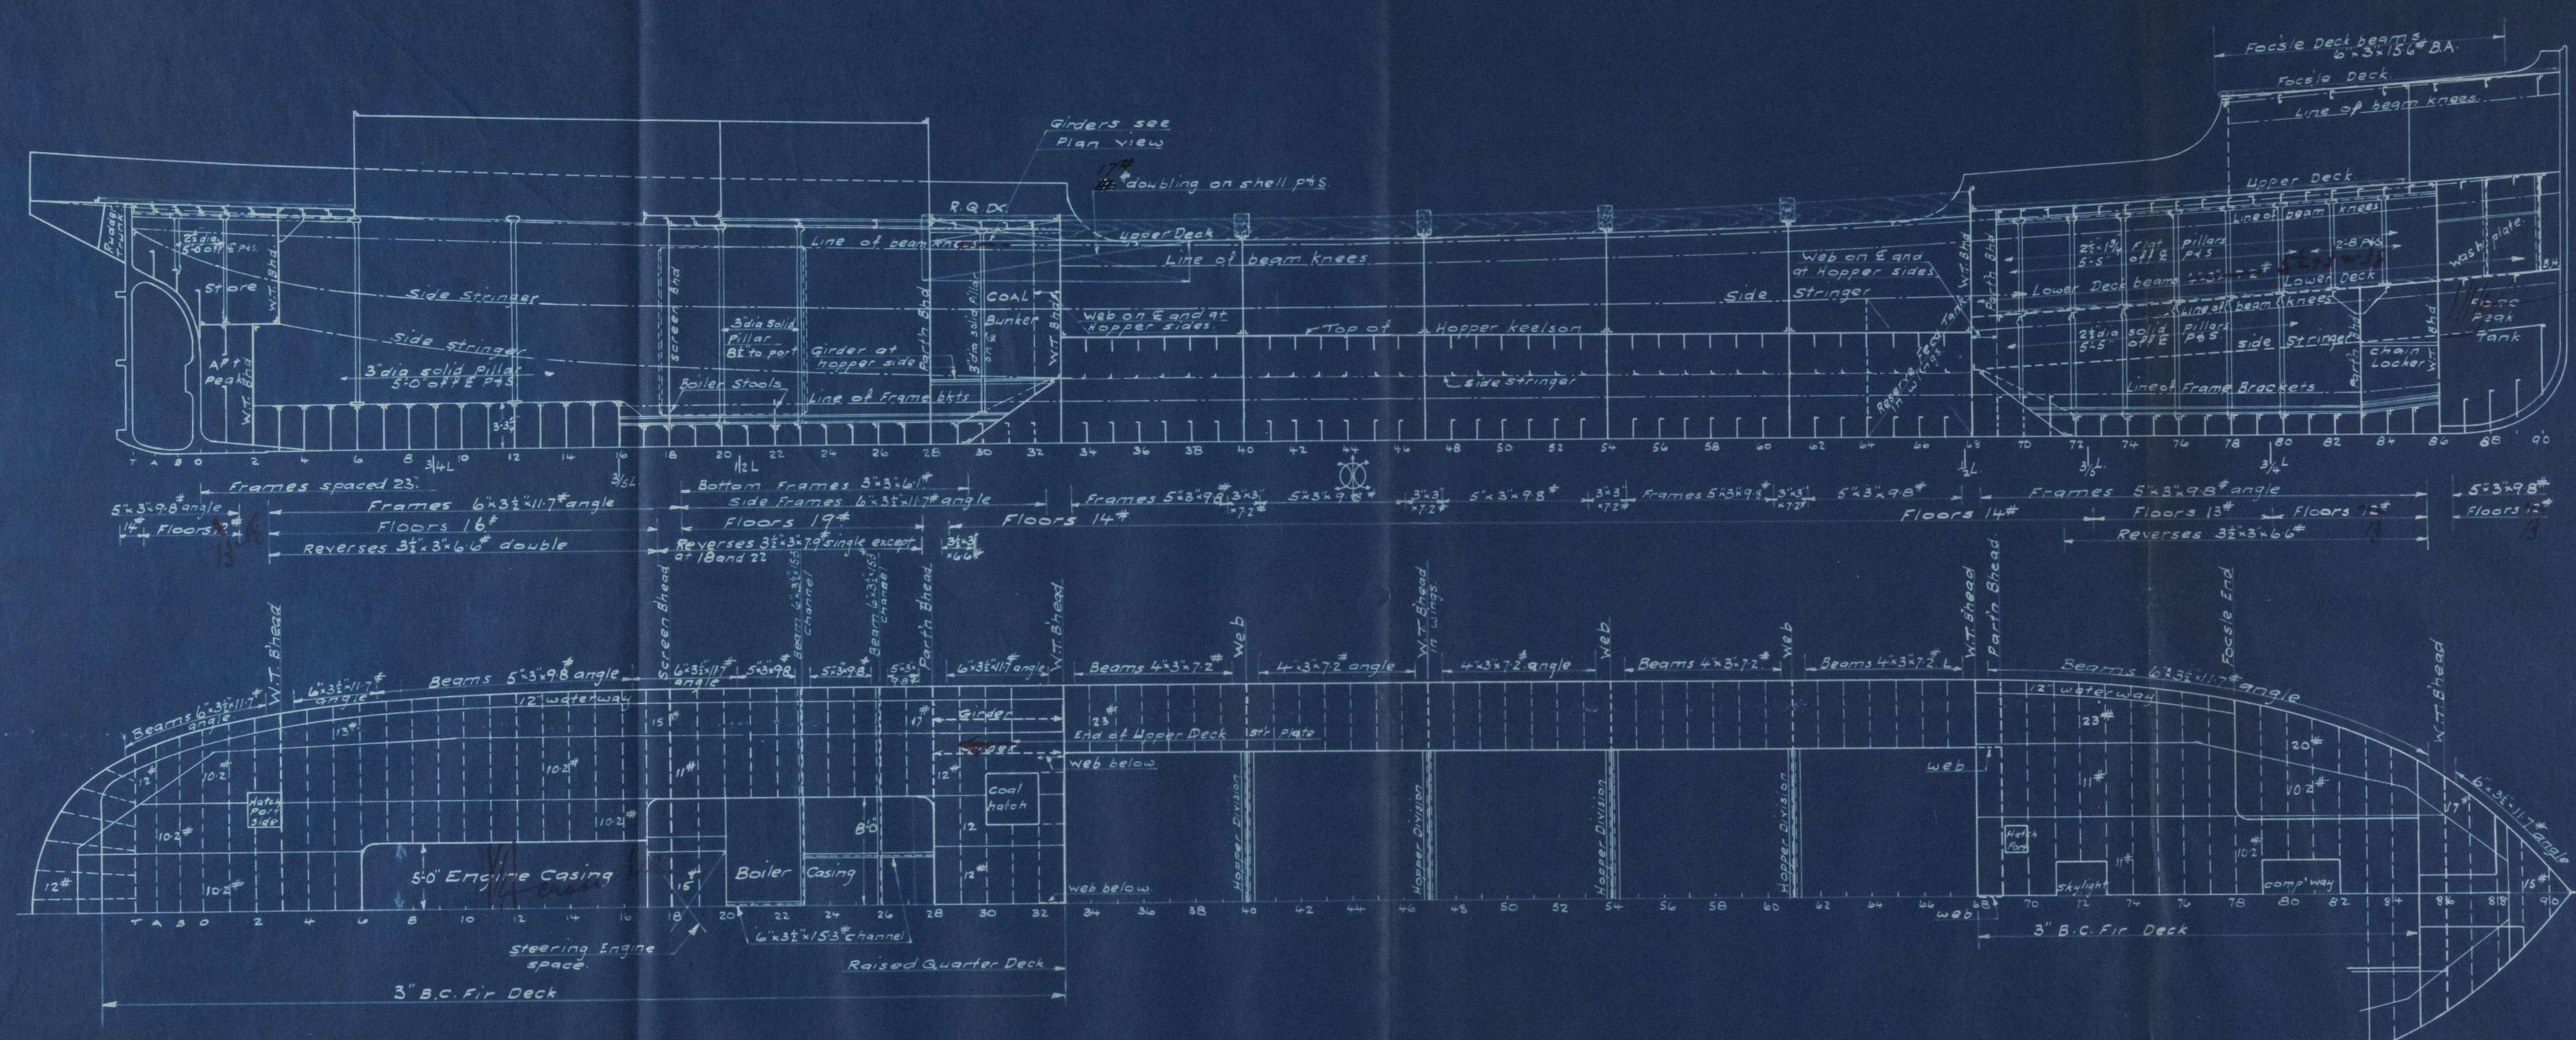

*Small plate*

*W.B.*

APPROVED  
MAR 6 1928  
LIMITED SHIPYARDS  
NEW YORK

*Landon left*  
+Lloyds-

COLLINGWOOD SHIPYARDS  
LIMITED  
4828  
Date 7/3/28  
COLLINGWOOD, ONT.

**COLLINGWOOD SHIPYARDS LIMITED**  
COLLINGWOOD, ONTARIO  
Scale  $\frac{1}{8}'' = 1'-0''$   
Ship No. 82  
LONGITUDINAL OF HOPPER BARGE  
DRAWING No. \_\_\_\_\_ DRAWN BY J.B.  
FILE \_\_\_\_\_ TRACED BY \_\_\_\_\_  
DATE 6th March 1928 CHECKED BY \_\_\_\_\_