

Rpt.

Port of Rio de Janeiro


Continuation of Report No.

dated RIO GUADIANA.

on the

26 NOV 1955

44525

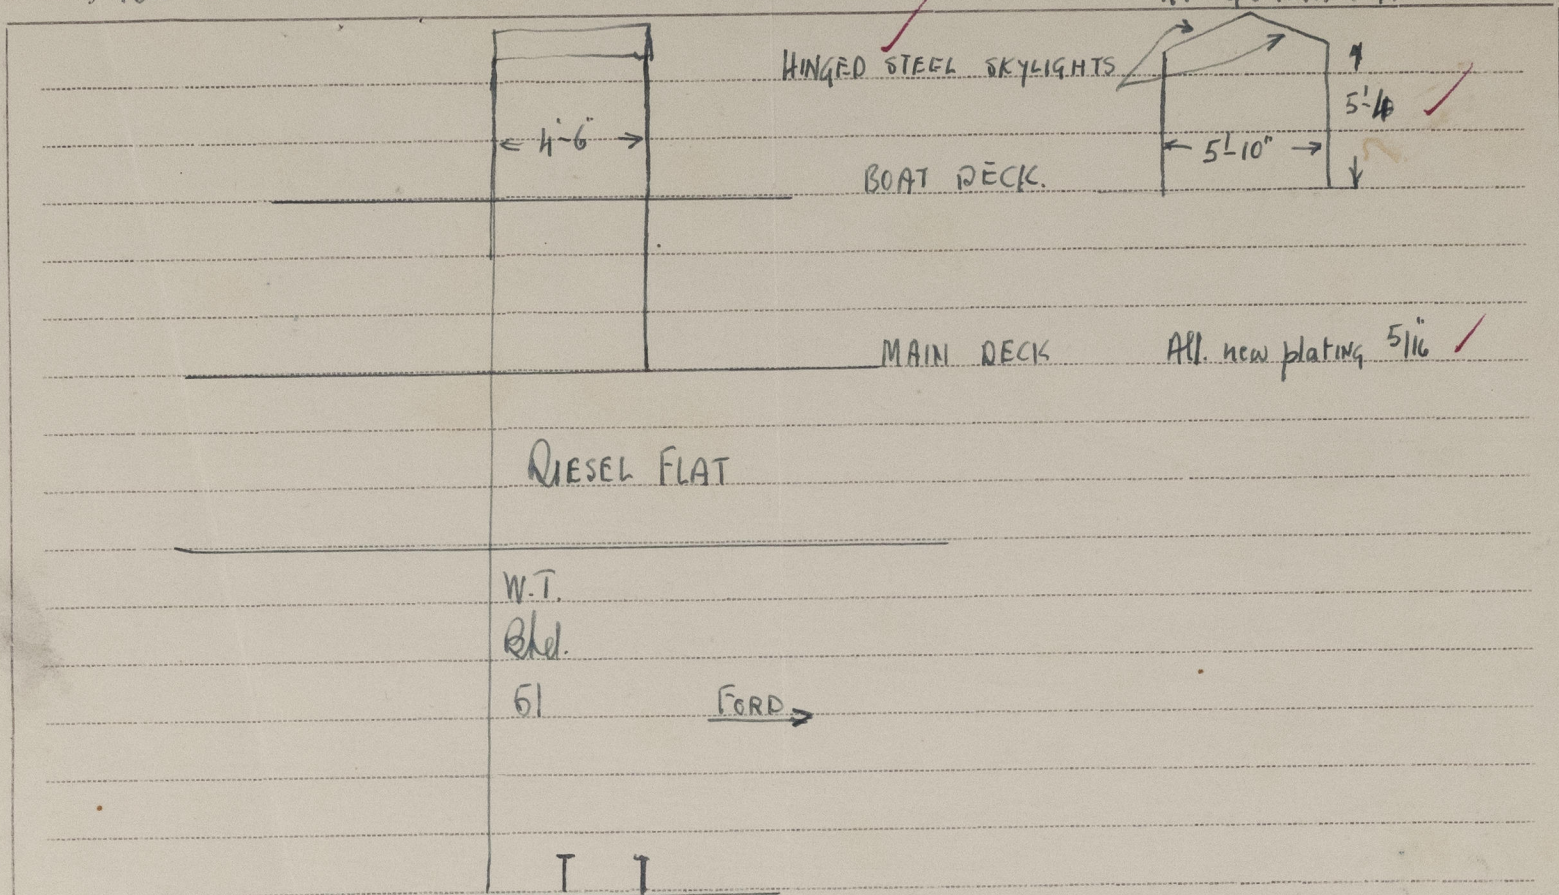

New skylight Ventilator on Boat deck to Diesel Flat

Notes 10 FEB 1956



© 2021

Lloyd's Register Foundation

011071-011078-0159