

14/4/20

No 1118 1167

— PROFILE & DECK PLANS —

DIMENSIONS: 290' PP - 42' 4" BTH M.O. - 21' 2" DEPTH M.O. TO UPPER DECK.

CURVES 100 AT LLOYDS

SCALE 1/8" = 1 FOOT

APPROXIMATE UNDER DECK TONNAGE

{ 2570 TO SHELTER DECK
1680 TO UPPER DECK


LONGITUDINAL NO 18412.10

TRANS NO 63.49

PLAN OF FILLING HATCHES & GROUND TO BE SUBMITTED

Submits under Windows Windows
Charts & Steering Head to Company Satisfaction

Stiffness to
improve satisfaction

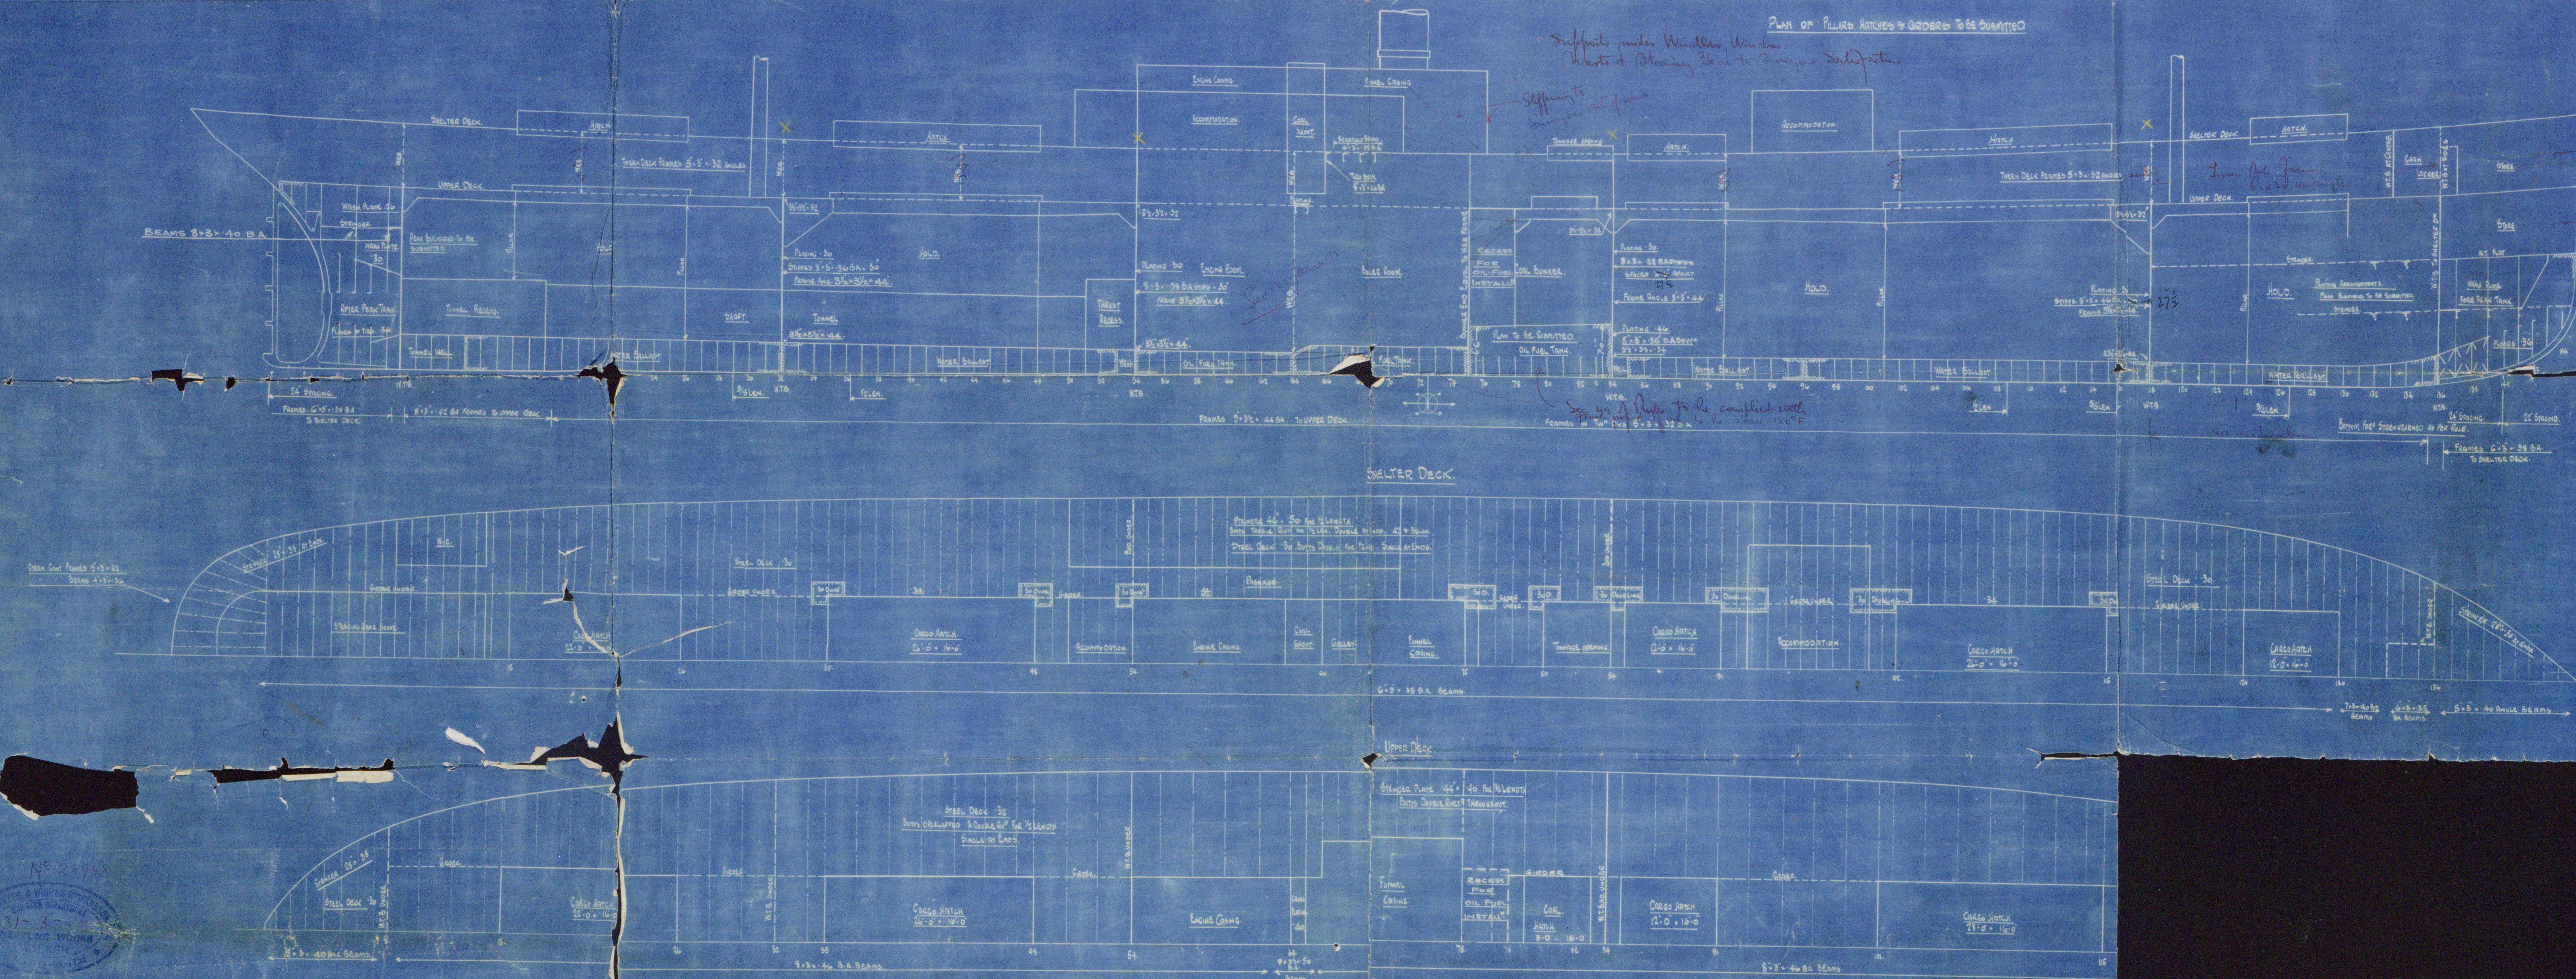

No 24748
31-3-20
LLOYD'S REGISTER
MARITIME WORKS
LONDON

Tunderland.

Swan Hunter & Nigham Richardson

N^o 1118 at Neptune Shipyard

N^o 1167 at Southwark Shipyard

Profile & Deck Plans

N.N. "GEORGIOS S."

x

N^o 1167

S. S. "RALLUS"

Sld. Rpt N^o 28352



© 2021

011115-011119-L-0160

Lloyd's Register
Foundation