



HATCHWAY BEAMS

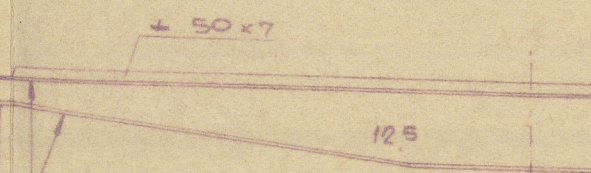


DECK	HATCH N°	HATCHWAY BEAMS N°	THICKNESS OF WOOD COVERS
SECOND DECK	1	5	69
"	2	5	72
"	3	7	66
"	4	7	69
"	5	6	72
UPPER DECK	1	1	8" x 0.86
THIRD DECK	3	3	10" x 0.84

DECK	HATCH N°	HATCHWAY BEAMS N°	THICKNESS OF WOOD COVERS
UPPER DECK	1	5	69
SECOND DECK	1	5	72
"	2	5	69
"	3	7	66
"	4	7	69
"	5	6	72
UPPER DECK	1	1	8" x 0.86
THIRD DECK	3	3	10" x 0.84



SECT. A-A

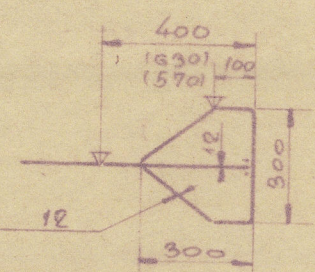

SECT. B-B

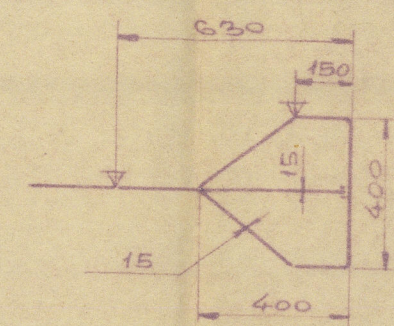

SECT. C-C

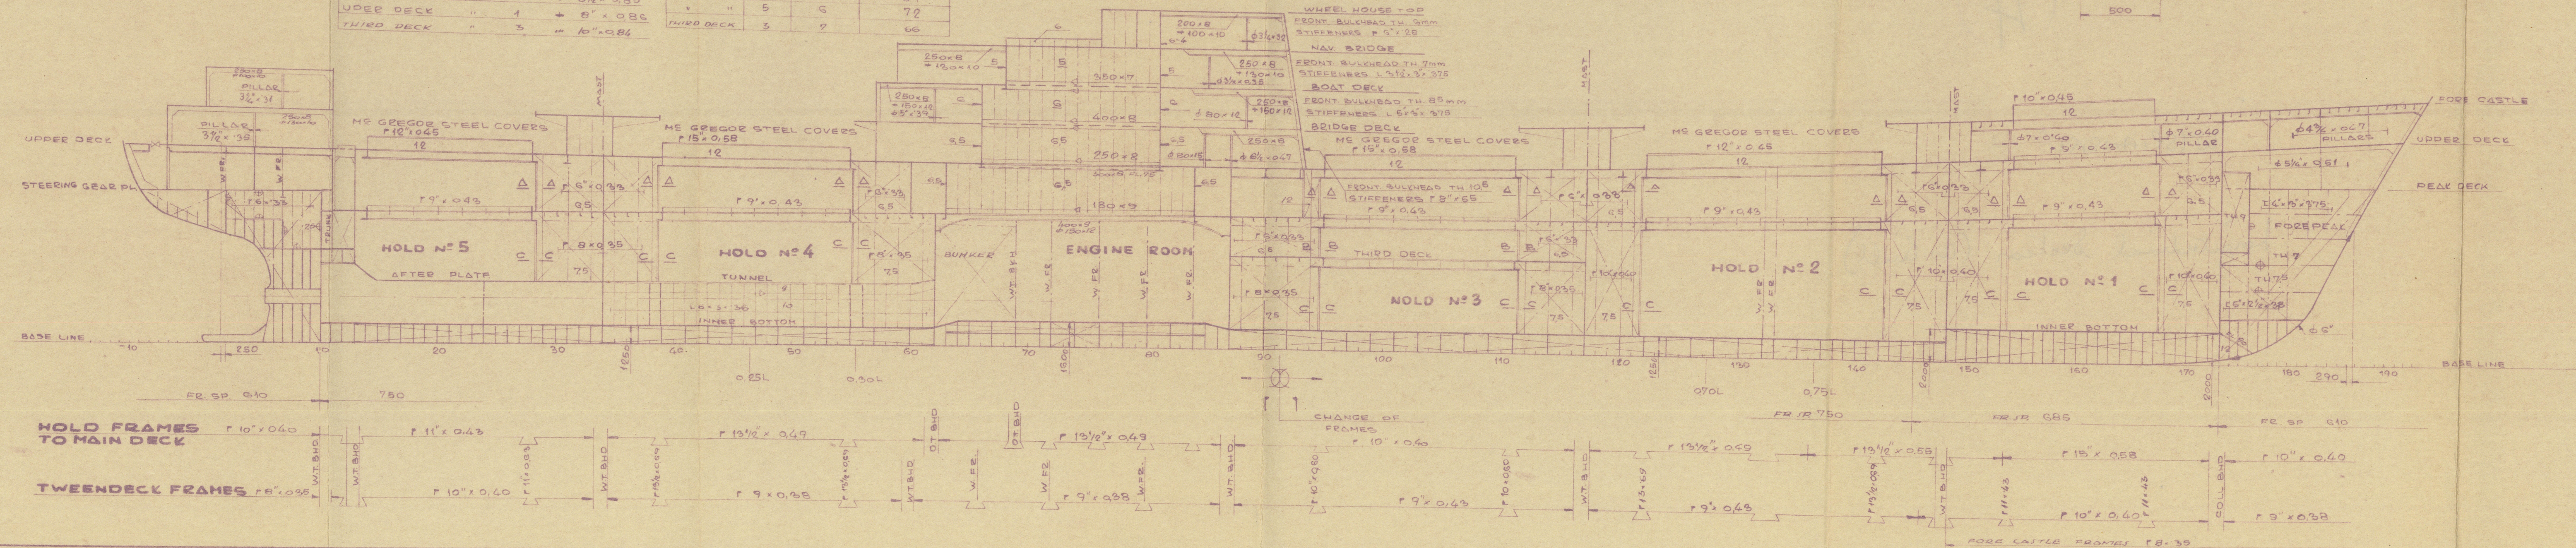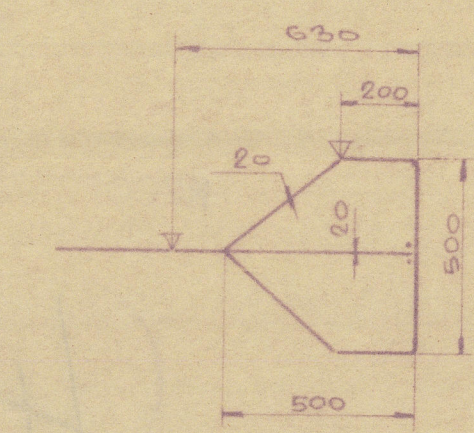

YARD N° 482

BUDIMIR R. 1961
 LONGITUDINAL SECTION AS BUILT
 10151 482
 0312
 Lloyd's Register Foundation

RECORDS DEPT.
LONDON

4

WYSP, ANSKI ★

Longitudinal Section (as built)



© 2021

Lloyd's Register
Foundation

01110-01119-0185