

2 NOV 1939

Nº 65 - 72
JOB Nº J 1155
STRUCTURAL SECTIONS






SCALE 1/2" = 1 FOOT
DIMENSIONS 200'-0" B.P. x 33'-0" MLD x 13'-6" TO UPPER DECK
CLASS LLOYDS 100A1 CARRYING PETROLEUM IN BULK
LONGITUDINAL FRAMING IN CENTRE TANKS AT BOTTOM AND DECK

NUMERALS		RULE EQUIPMENT	
LENGTH OVER CRUISED STEEL	210'-0"	3 BOWER ANCHORS STOCKLESS COLL WEIGHT 60 1/2 CWTs	
L/D	20 1/2	1 STEAM " EX STOCK 5 1/4 CWTs	
L/D	20 1/2	210 FATHOMS 19/6 STUD CHAIN CABLE	
L/D	20 1/2	60 " 3/4 6x12 FLEX STEEL WIRE (STEAM)	
L/D	20 1/2	90 " 5" 6x12 " " (TOWLINE)	
L/D	20 1/2	100 " 2 1/4 6x12 " " (HAWSER)	
L/D	20 1/2	100 " 1 3/4 6x12 " " (WARRPS)	

EQUIPMENT - NUMERALS	
L/D	93744
FOUR	35.8 x 1.75
POOP	35.8 x 1.75
HOUSE ON POOP	35.8 x 1.75
	10315.4

STEM 6 1/2 x 1 1/8
FRAME SPACING 2' THROUGHOUT

CAMBER 8
TEST HEAD 7'-0" ABOVE CROWN OF TANKS
THREE 2'-0" OPENINGS IN SAME TRANSVERSE PLANE
DECK LONGITUDINALS 6'-0" x 1/2" B.A. SPACED 2'-0"
DECK PLATING .40

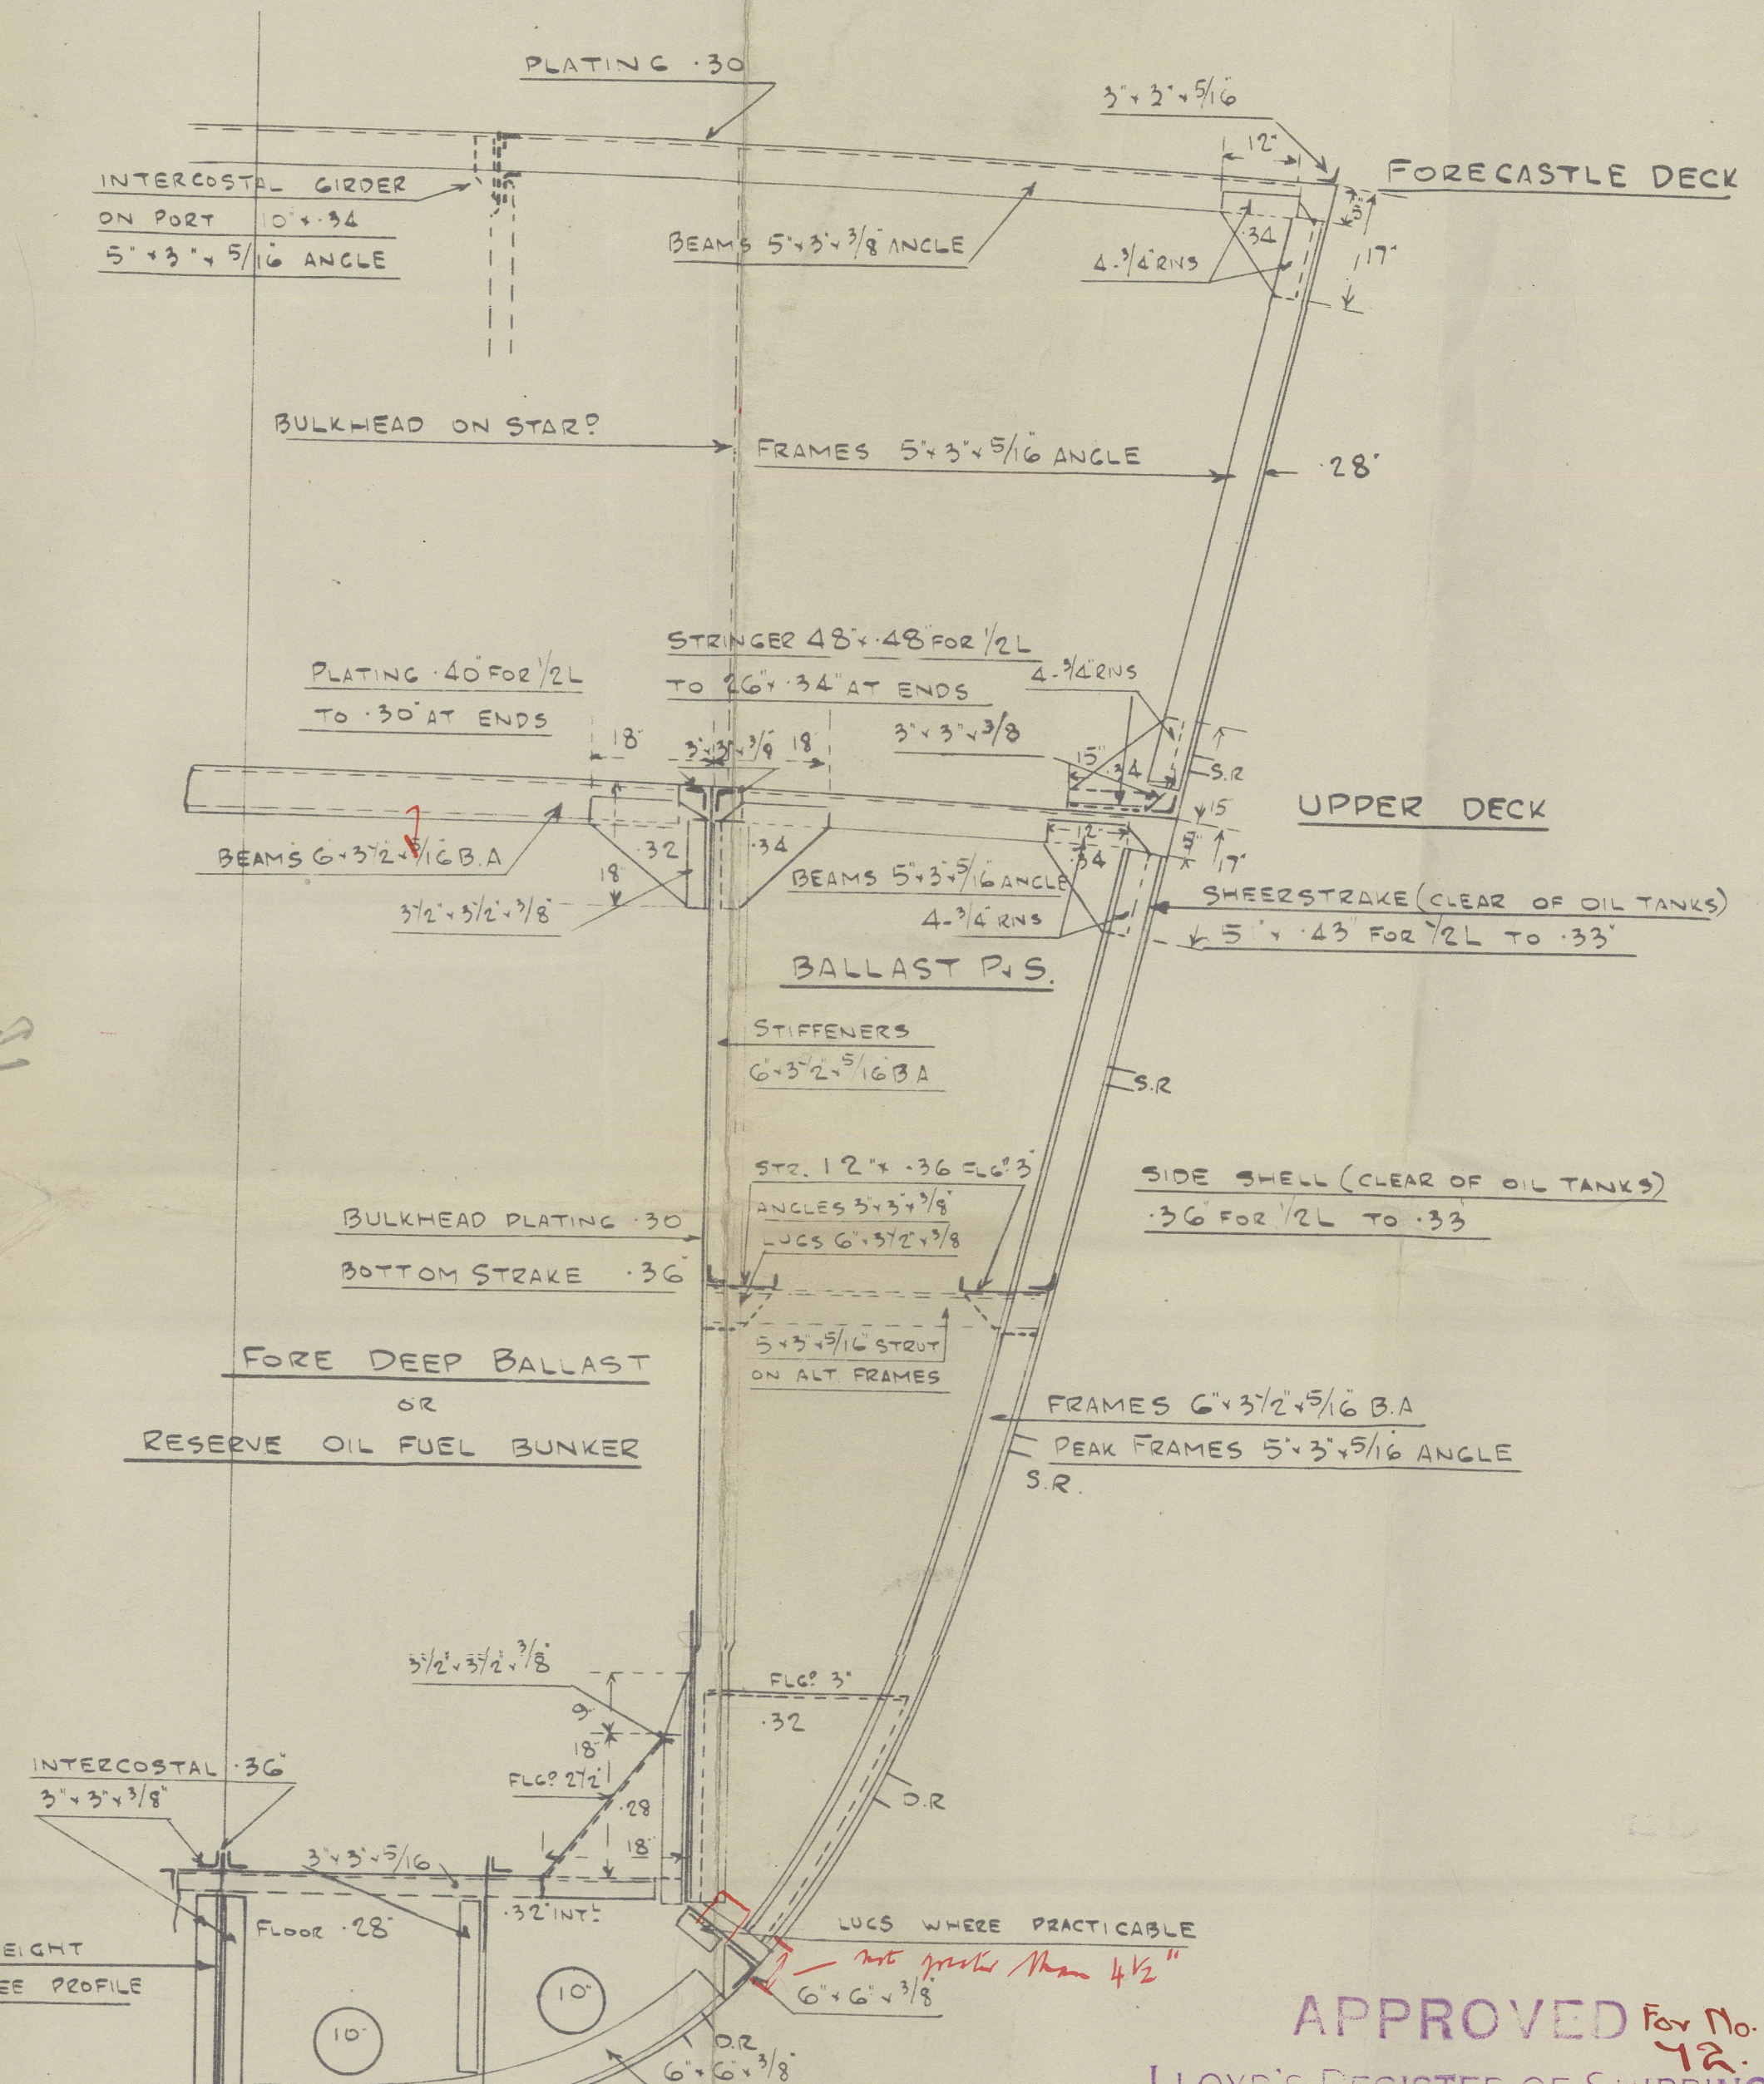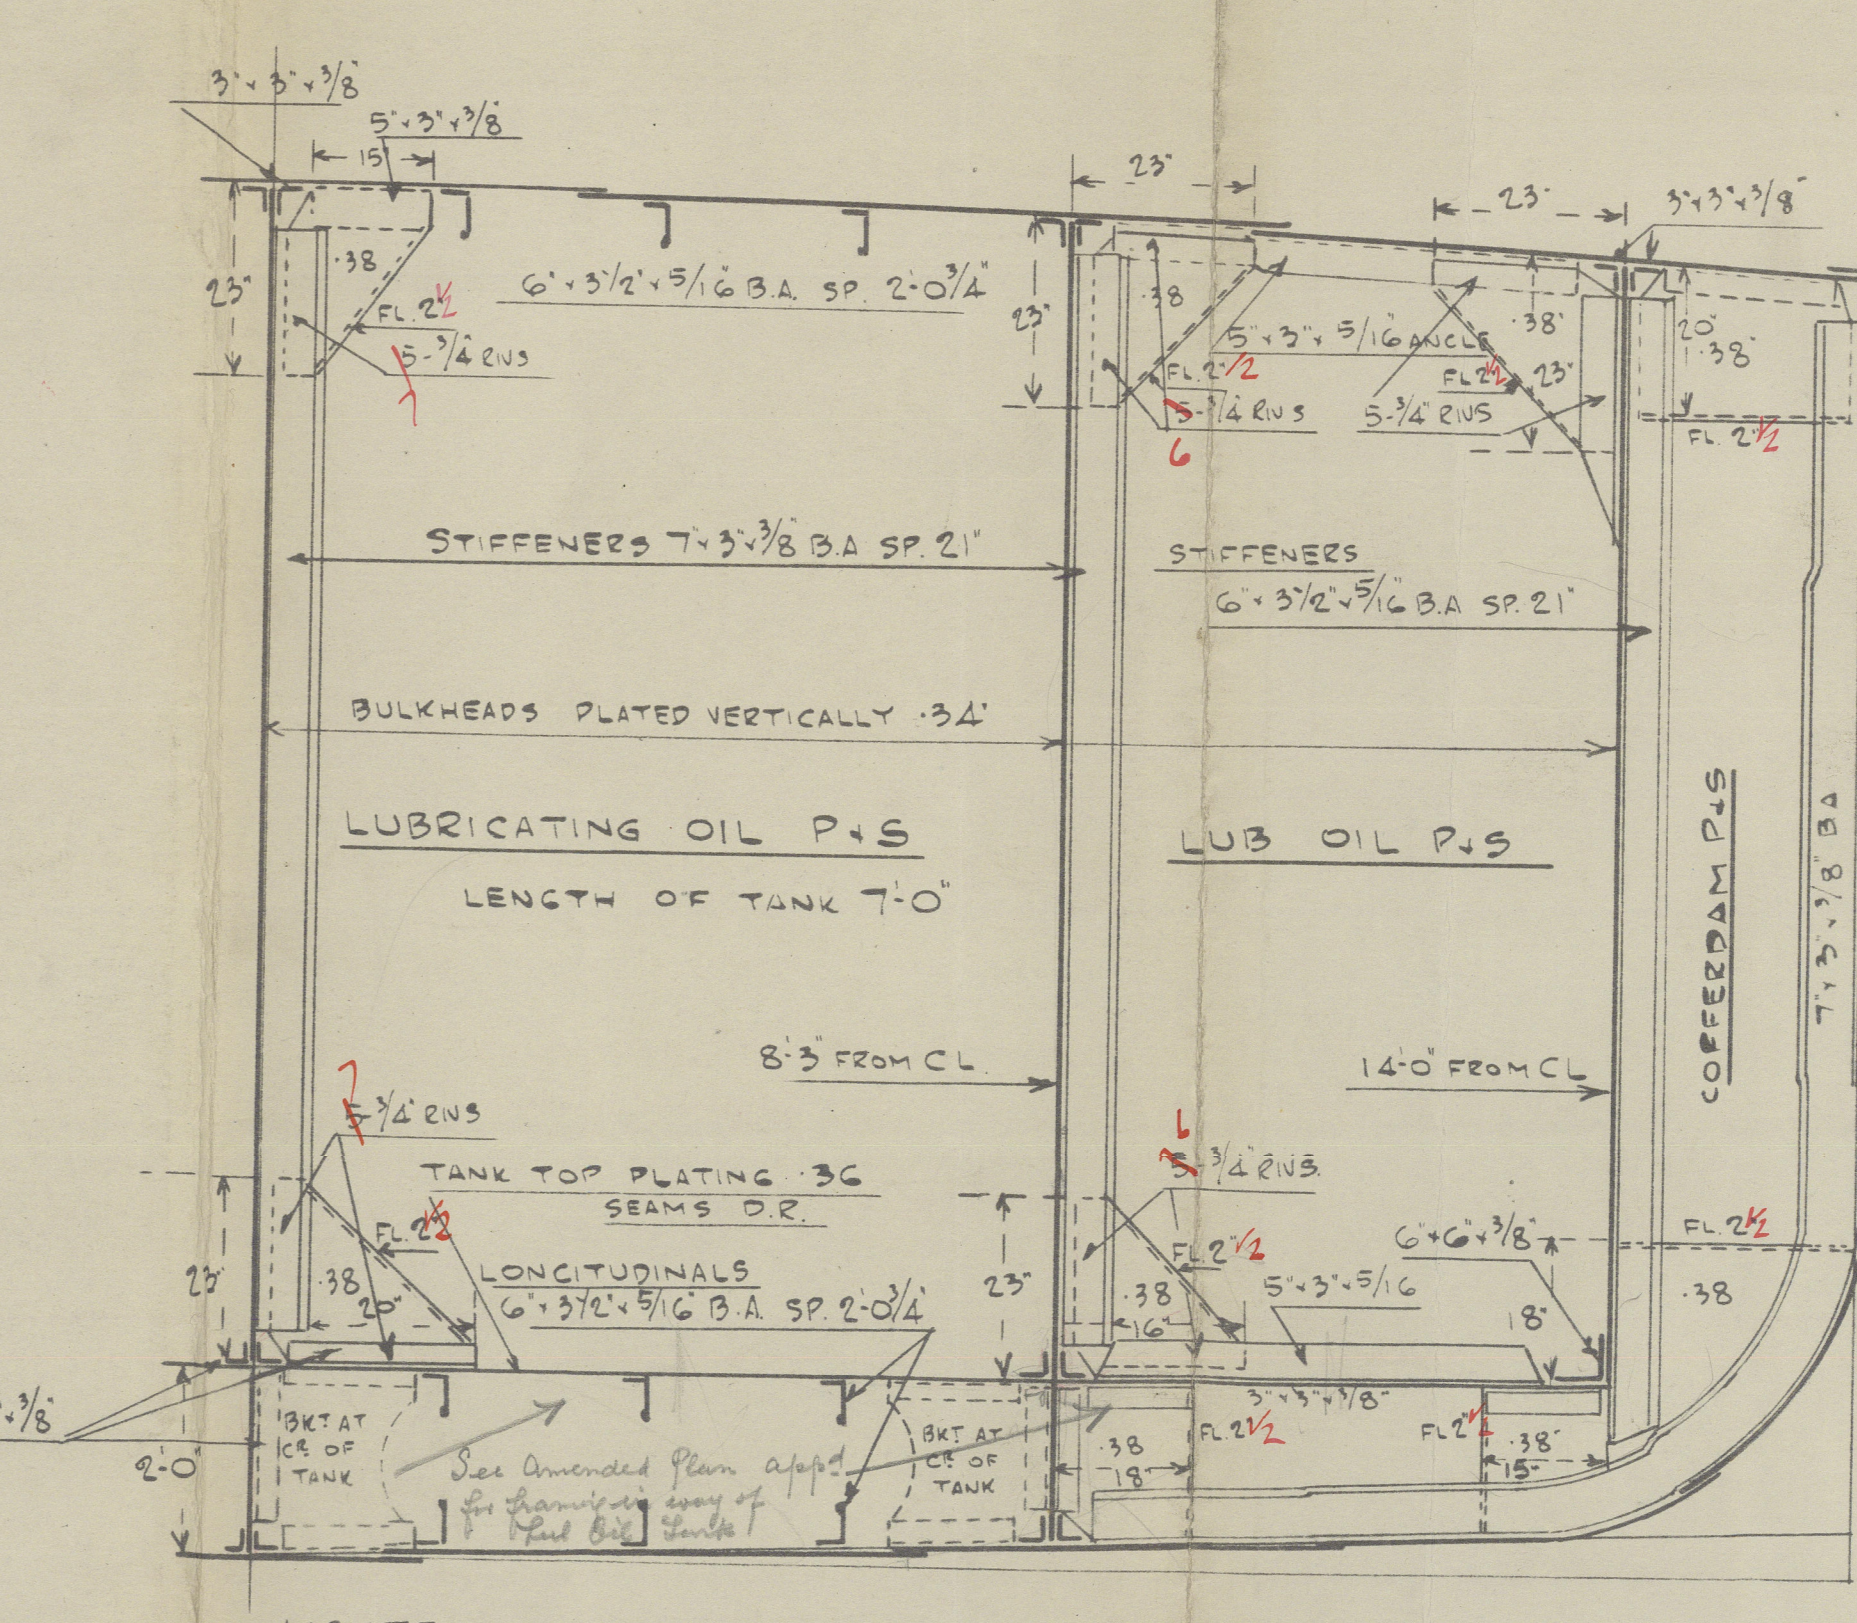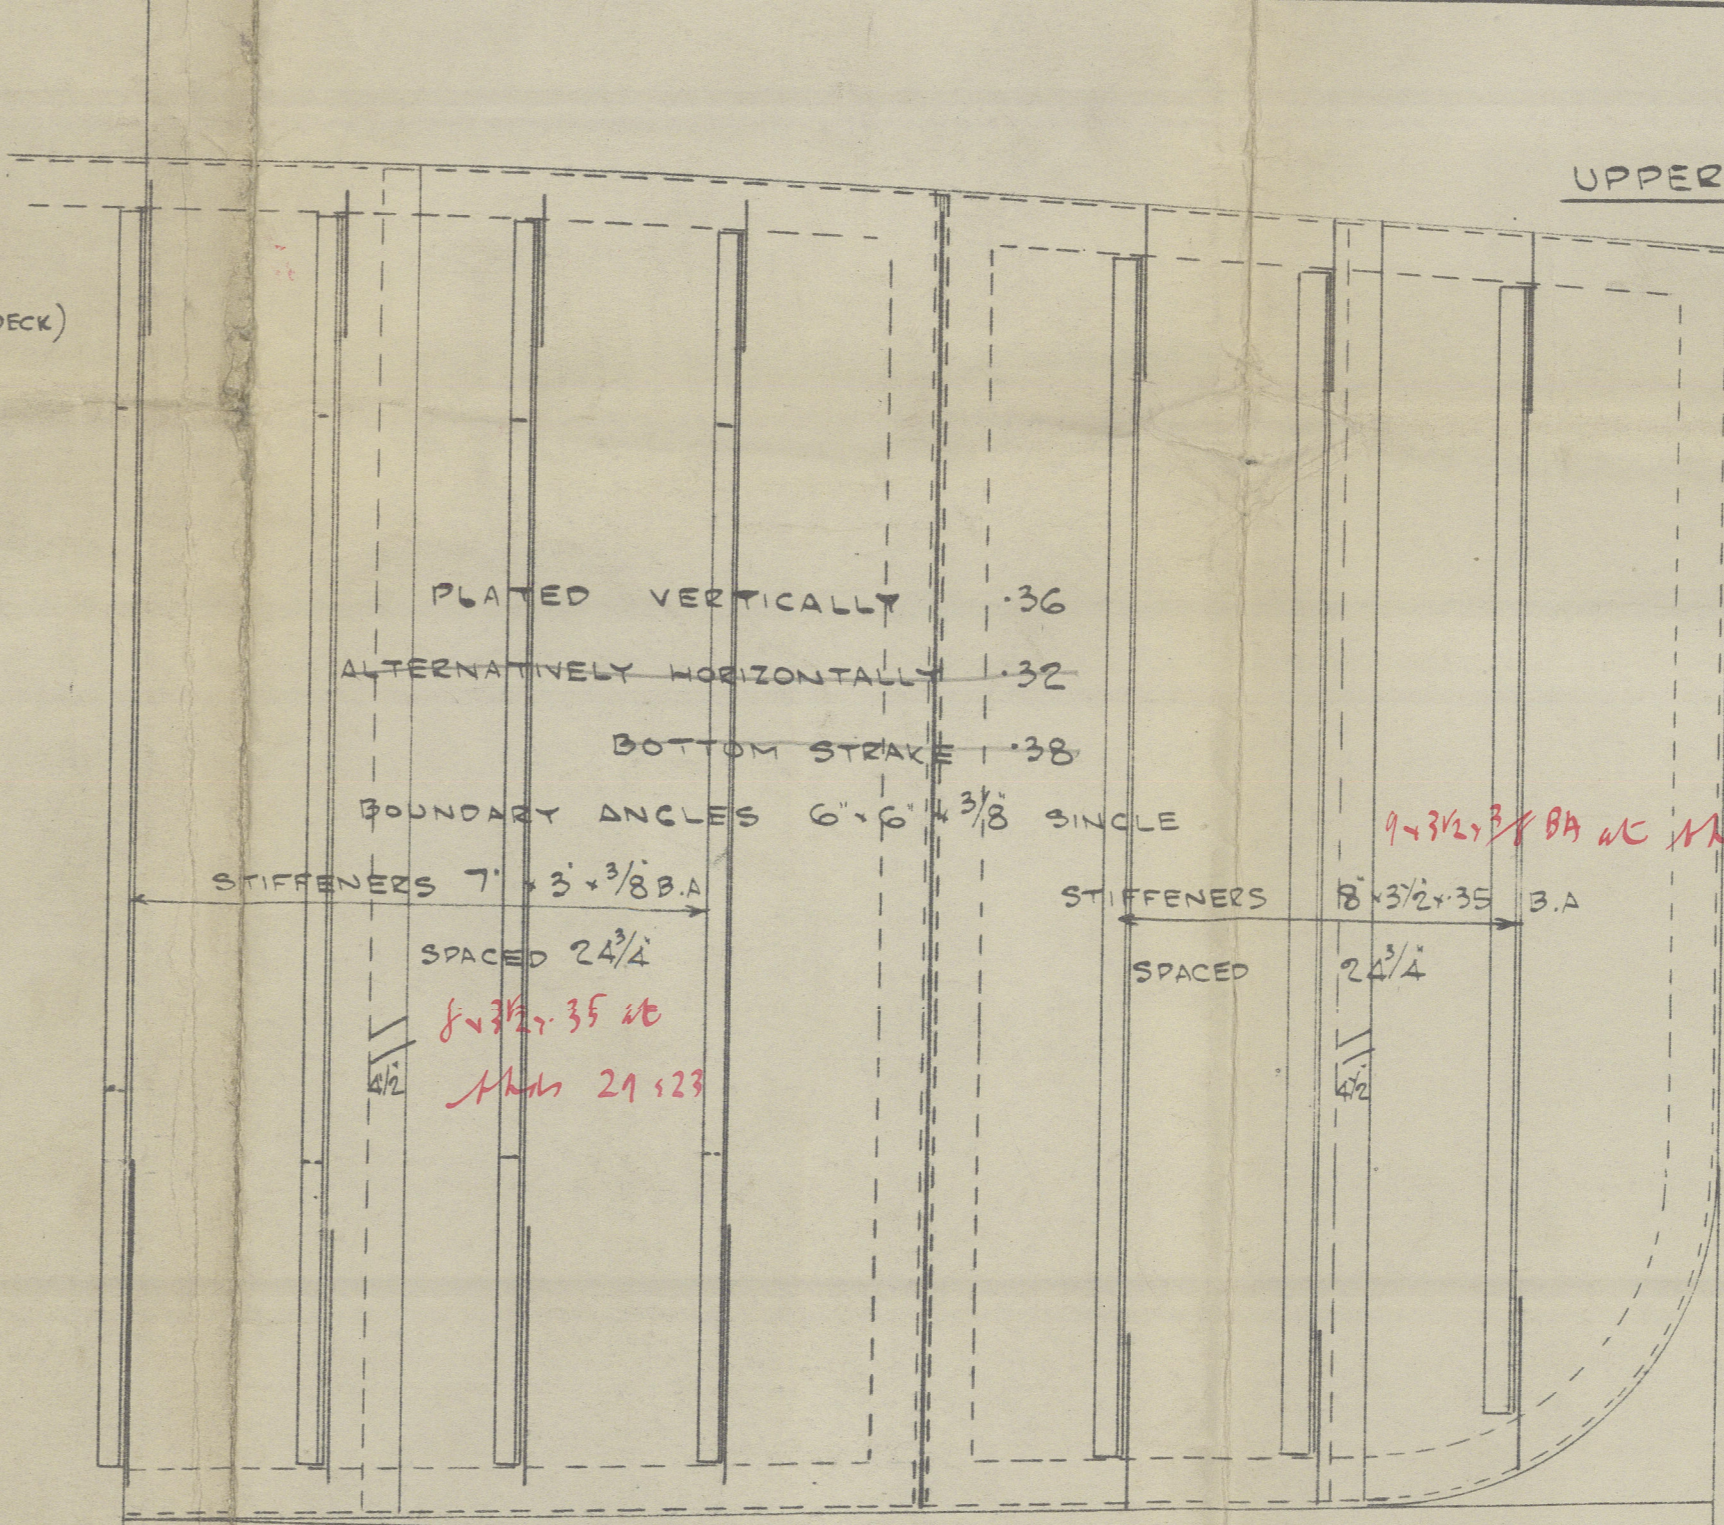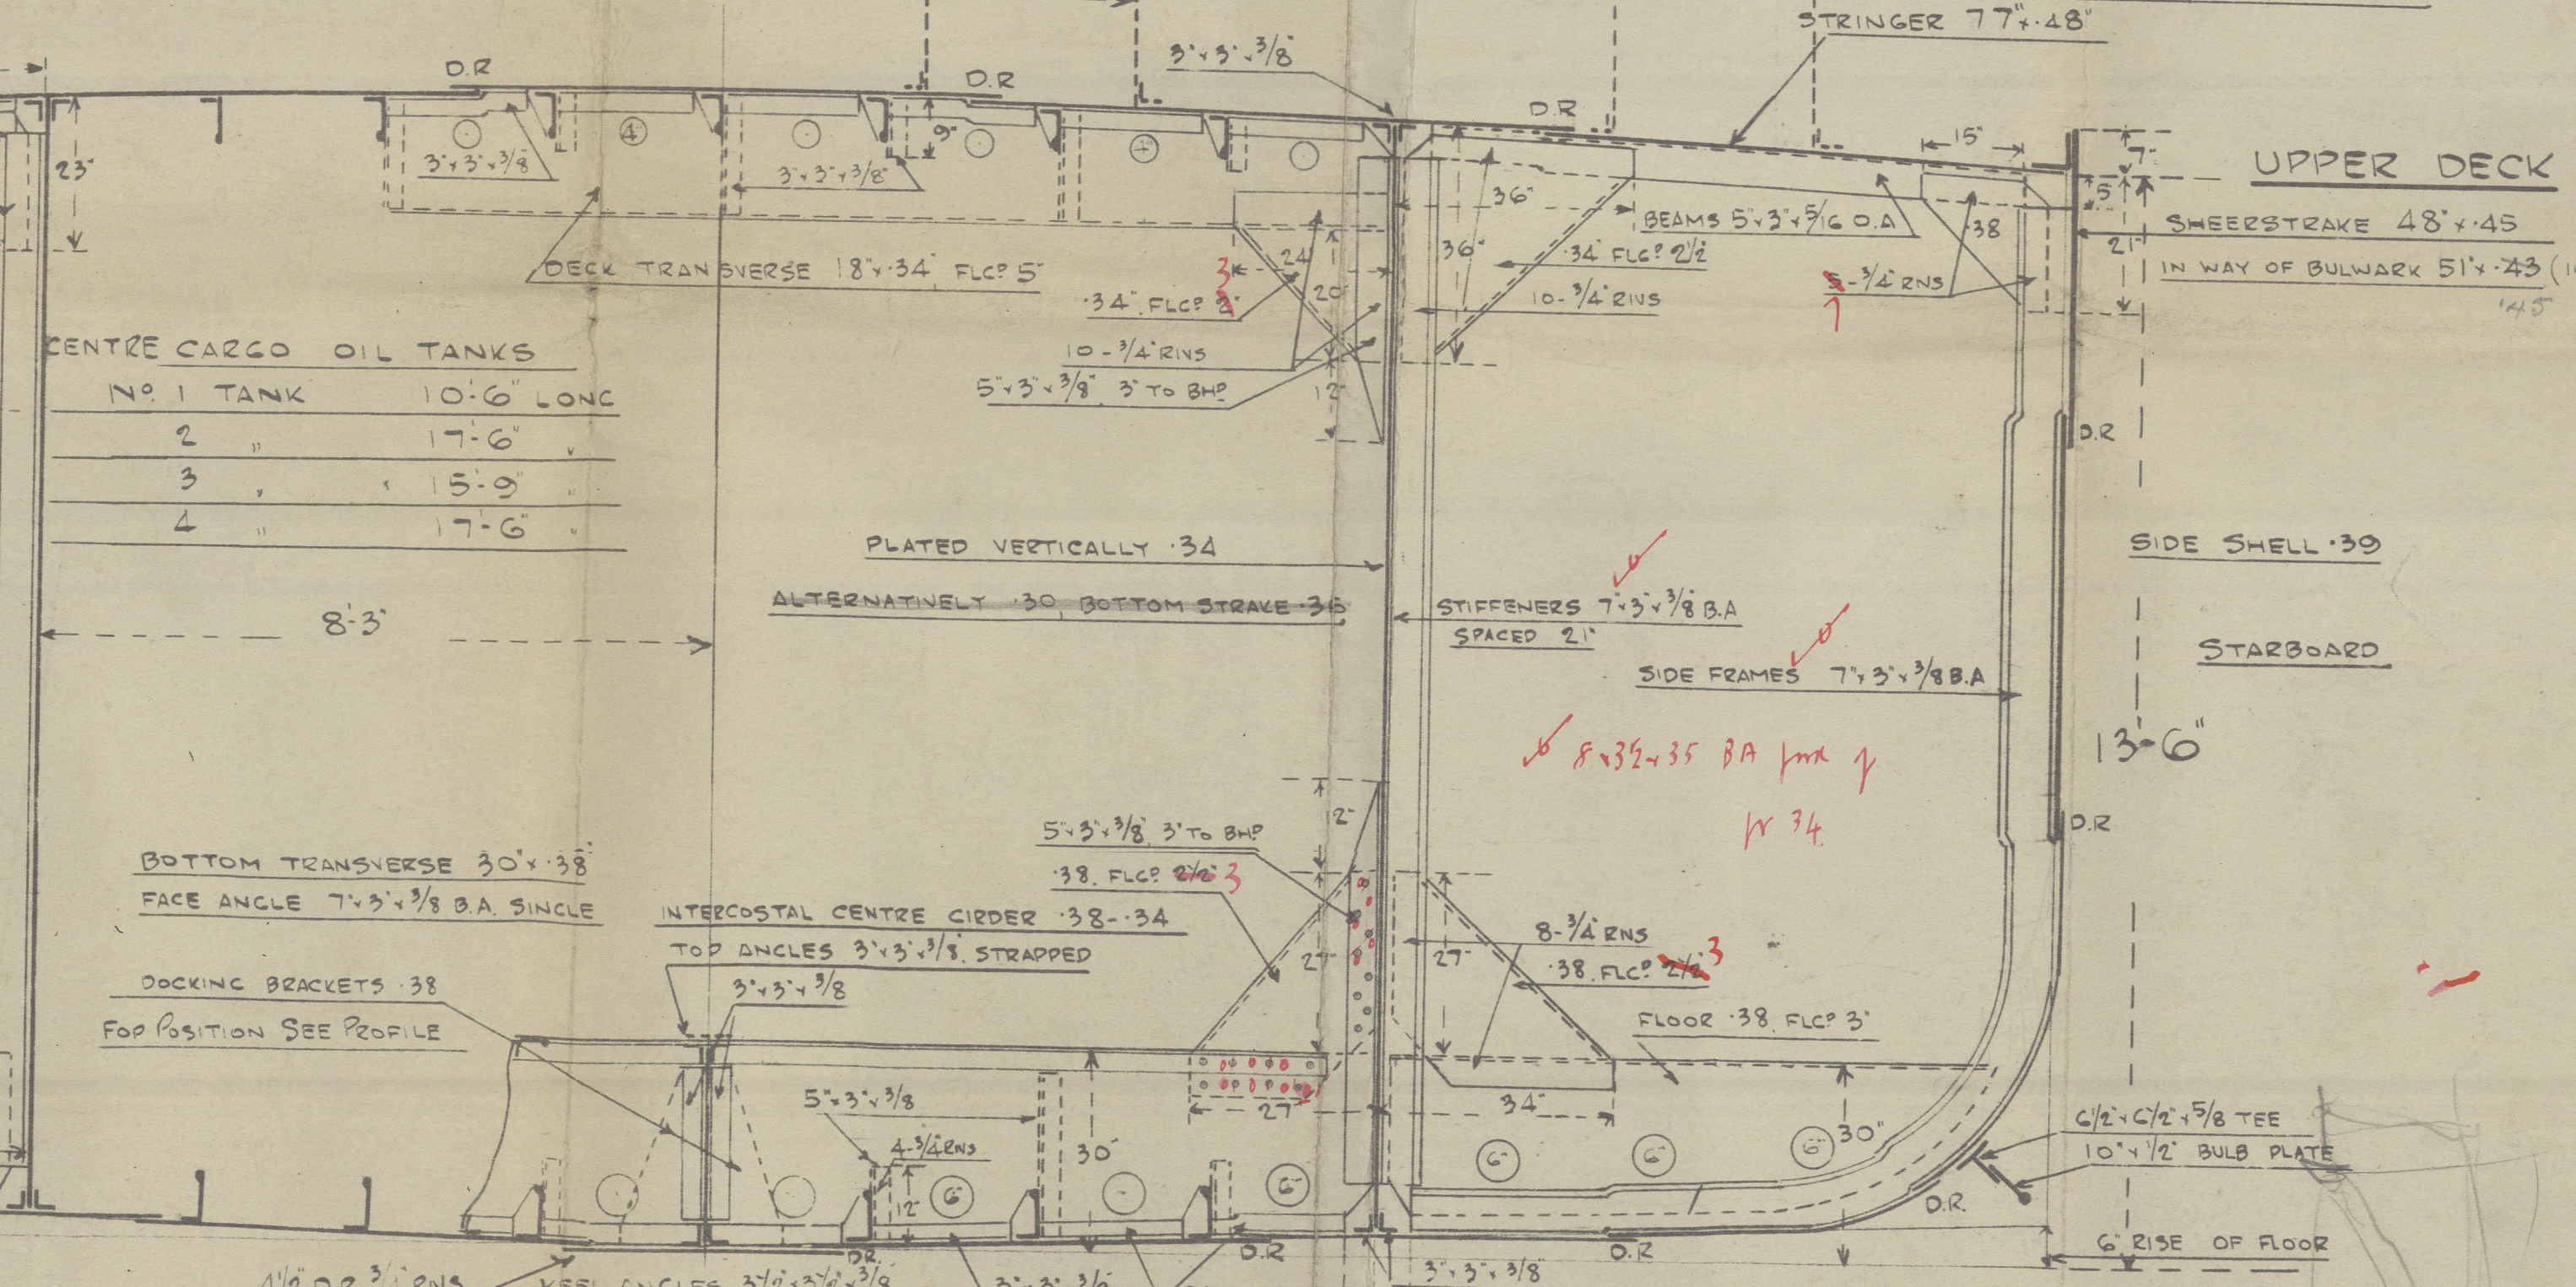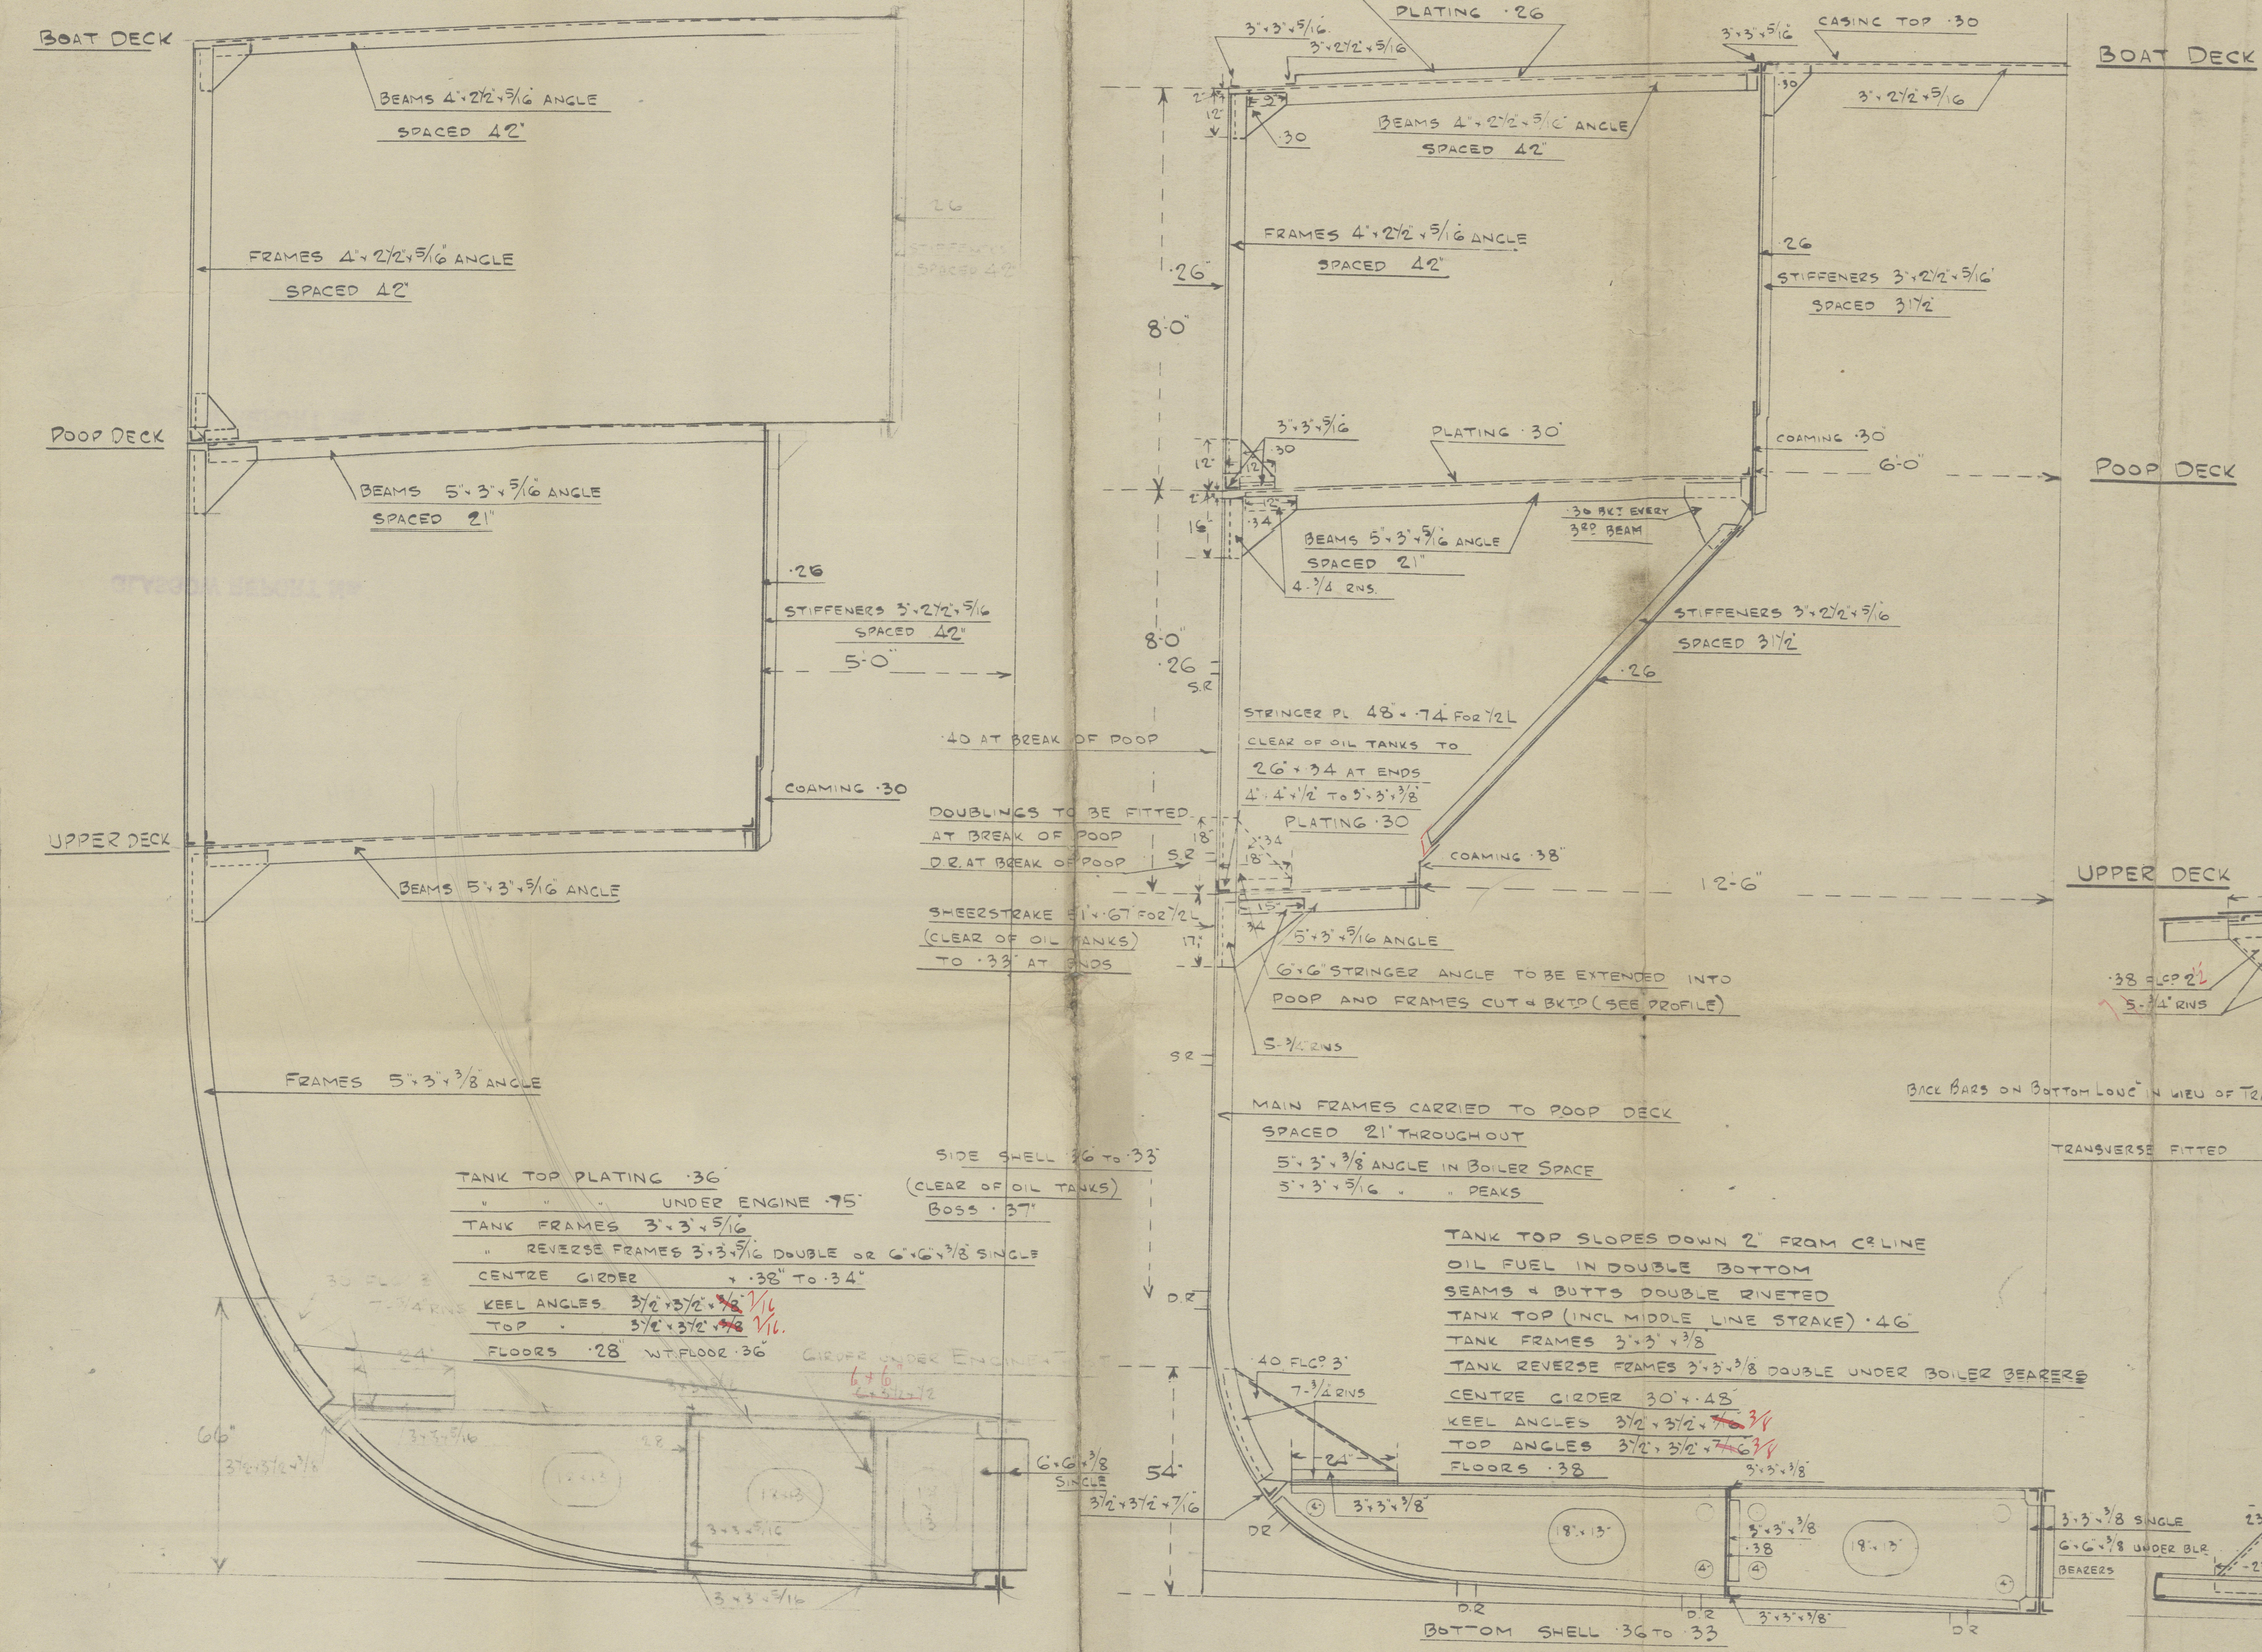

APPROVED FOR NO. 12
LLOYD'S REGISTER OF SHIPPING
James R. Clark
DATE 25/1/40

①

Blythwood S.B. & Co.

No. 65 - J. 1155.
42.

Structural Sections.

GLASGOW REPORT No 61875

4th
GLASGOW REPORT No 63167

* 65 Masprite
GLASGOW REPORT No 63500

4th 72 Airsprite
GLASGOW REPORT No 66271

72 Airsprite
GLASGOW REPORT No. 66613



© 2021

01110-01119-0237

Lloyd's Register
Foundation