

No 2107.

"PADAMYA"


QUARTER WHEEL MOTOR VESSELS
FOR
INLAND WATER TRANSPORT BOARD, BURMA.
CONSTRUCTIONAL SECTIONS (AS FITTED).

SCALE: $\frac{1}{2}$ - 1 FOOT.




LENGTH OVERALL	148'-6"
LENGTH HULL EX TONGUE	134'-0"
LENGTH WATERLINE	130'-0"
BREADTH MOULDED	34'-0"
DEPTH	5'-6"
LOAD DRAUGHT	4'-0"

EQUIPMENT:-
ONE STOCKLESS ANCHOR - 6 CHTS.
45 FATHOMS $\frac{7}{8}$ STUD LINK CABLE
IN THREE 15 FATHOM LENGTHS.

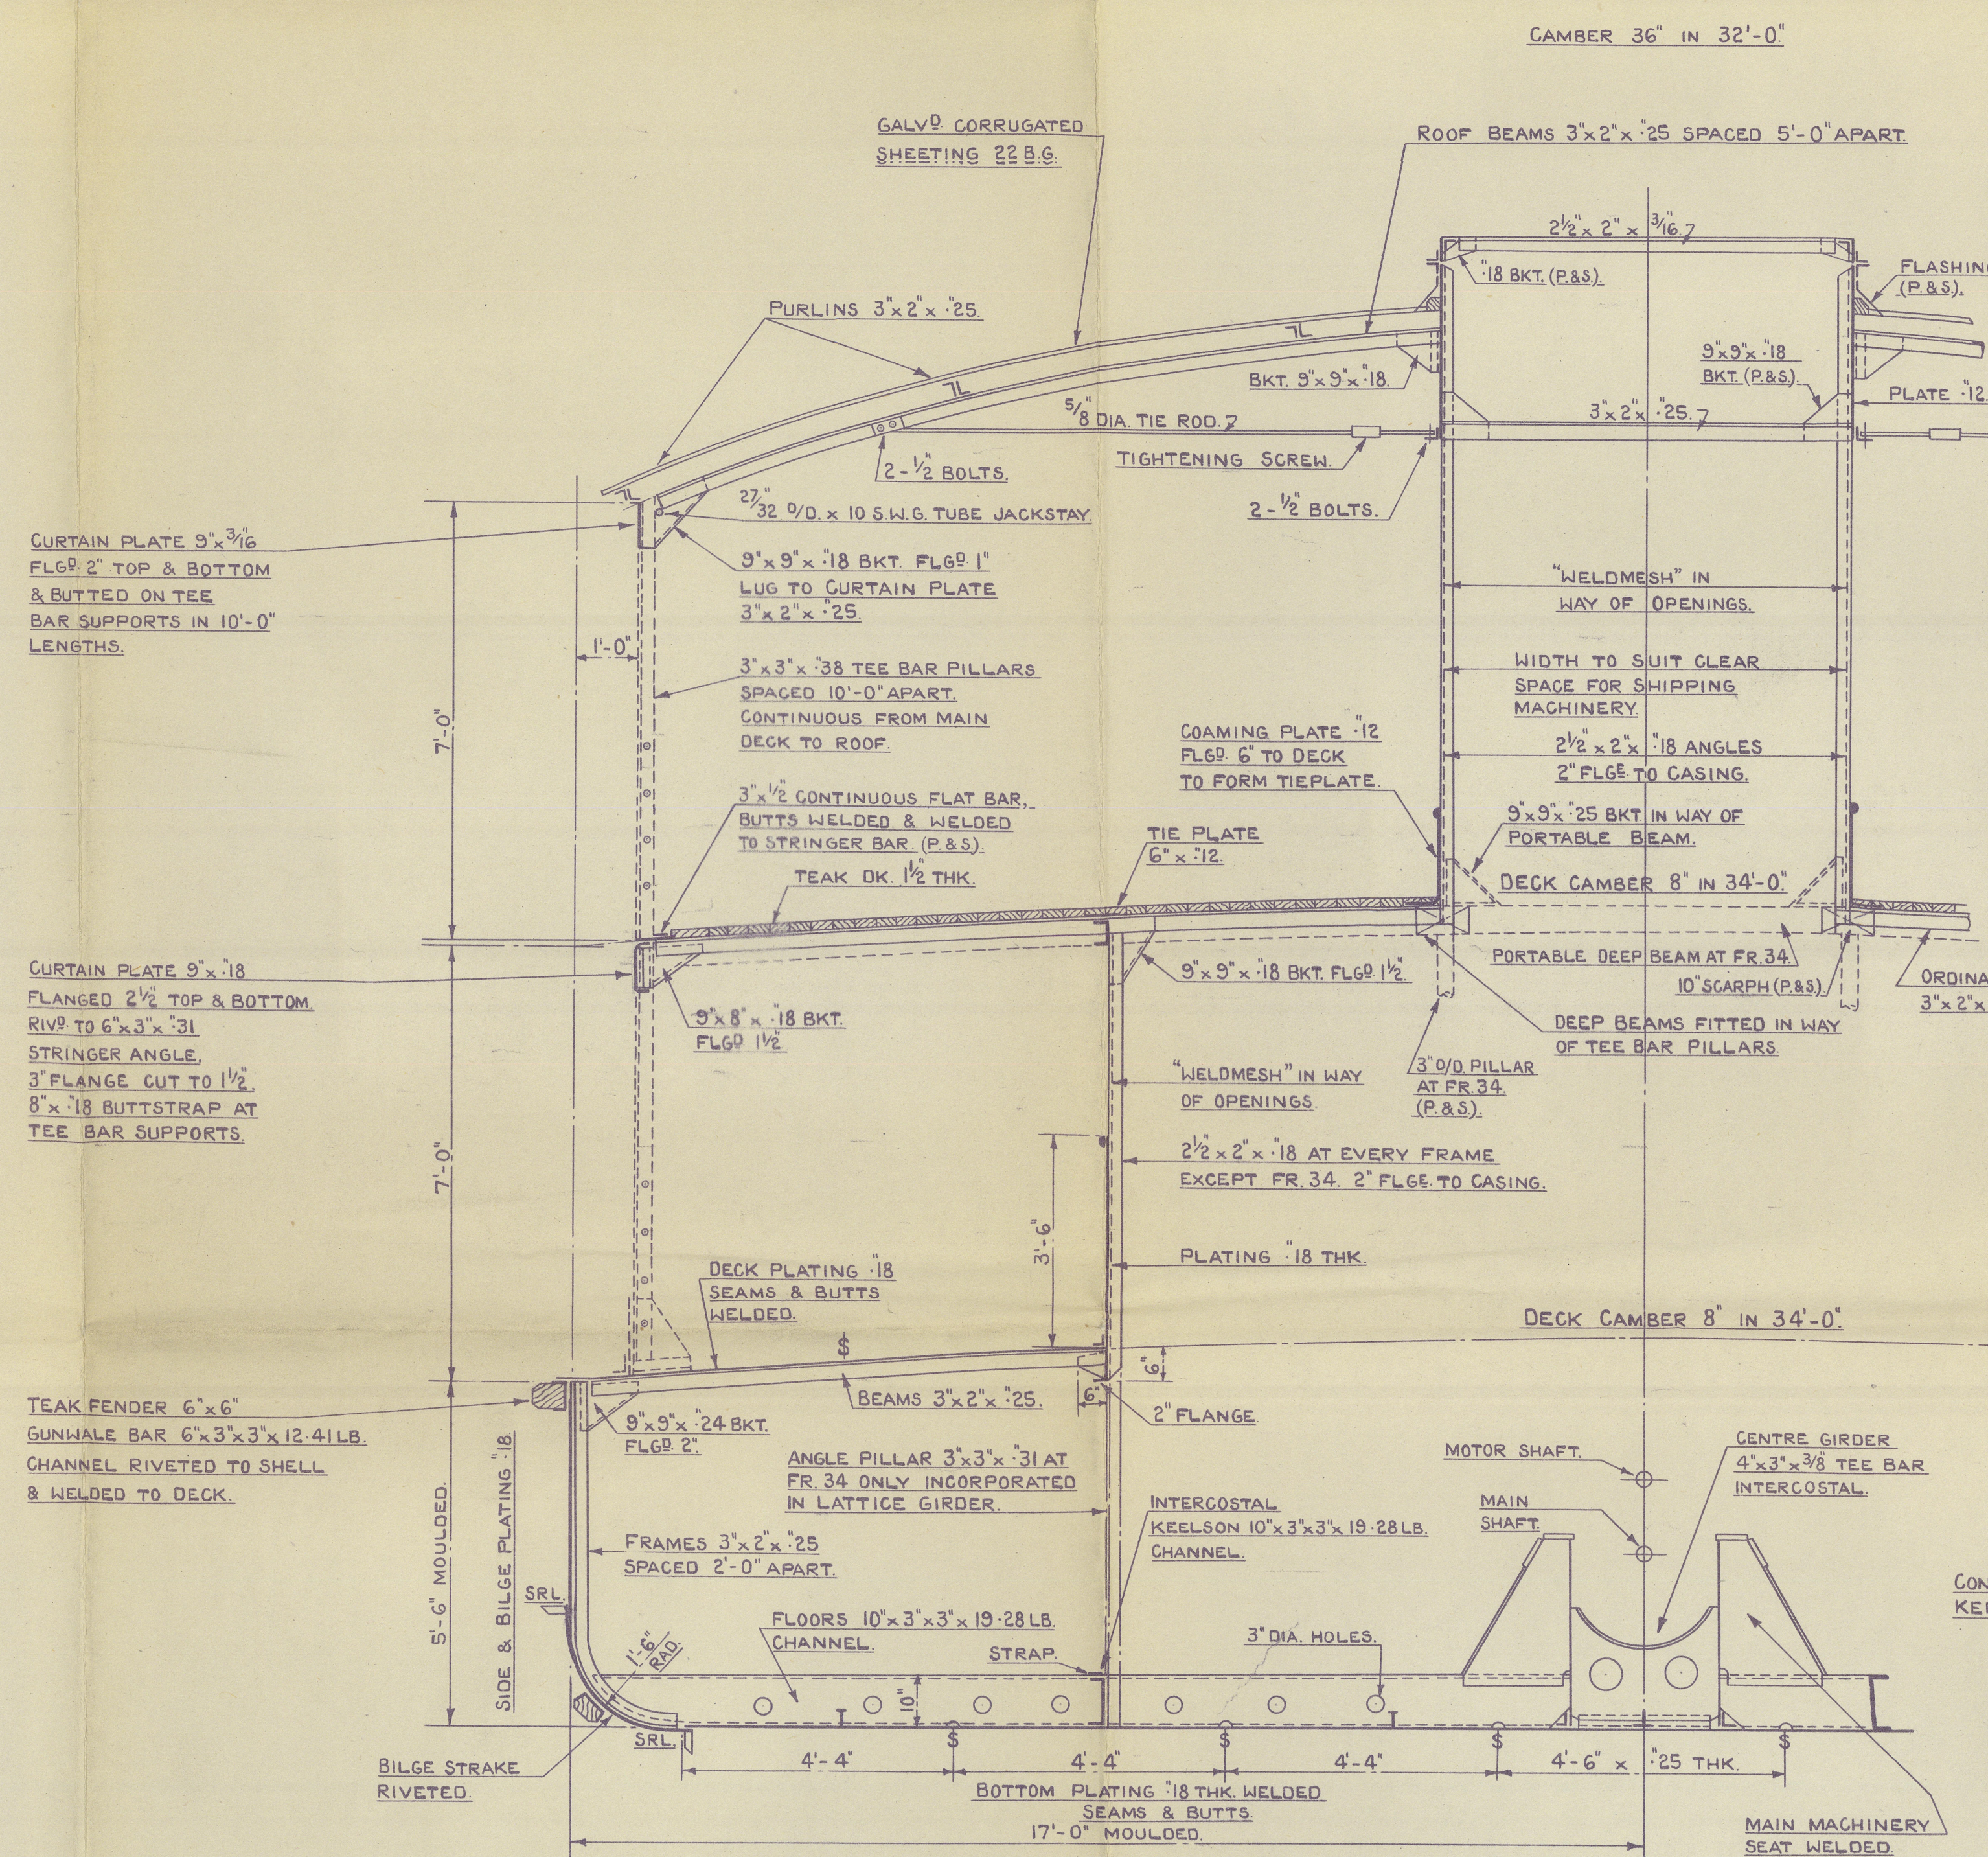

SECTION IN WAY OF MACHY SPACE.

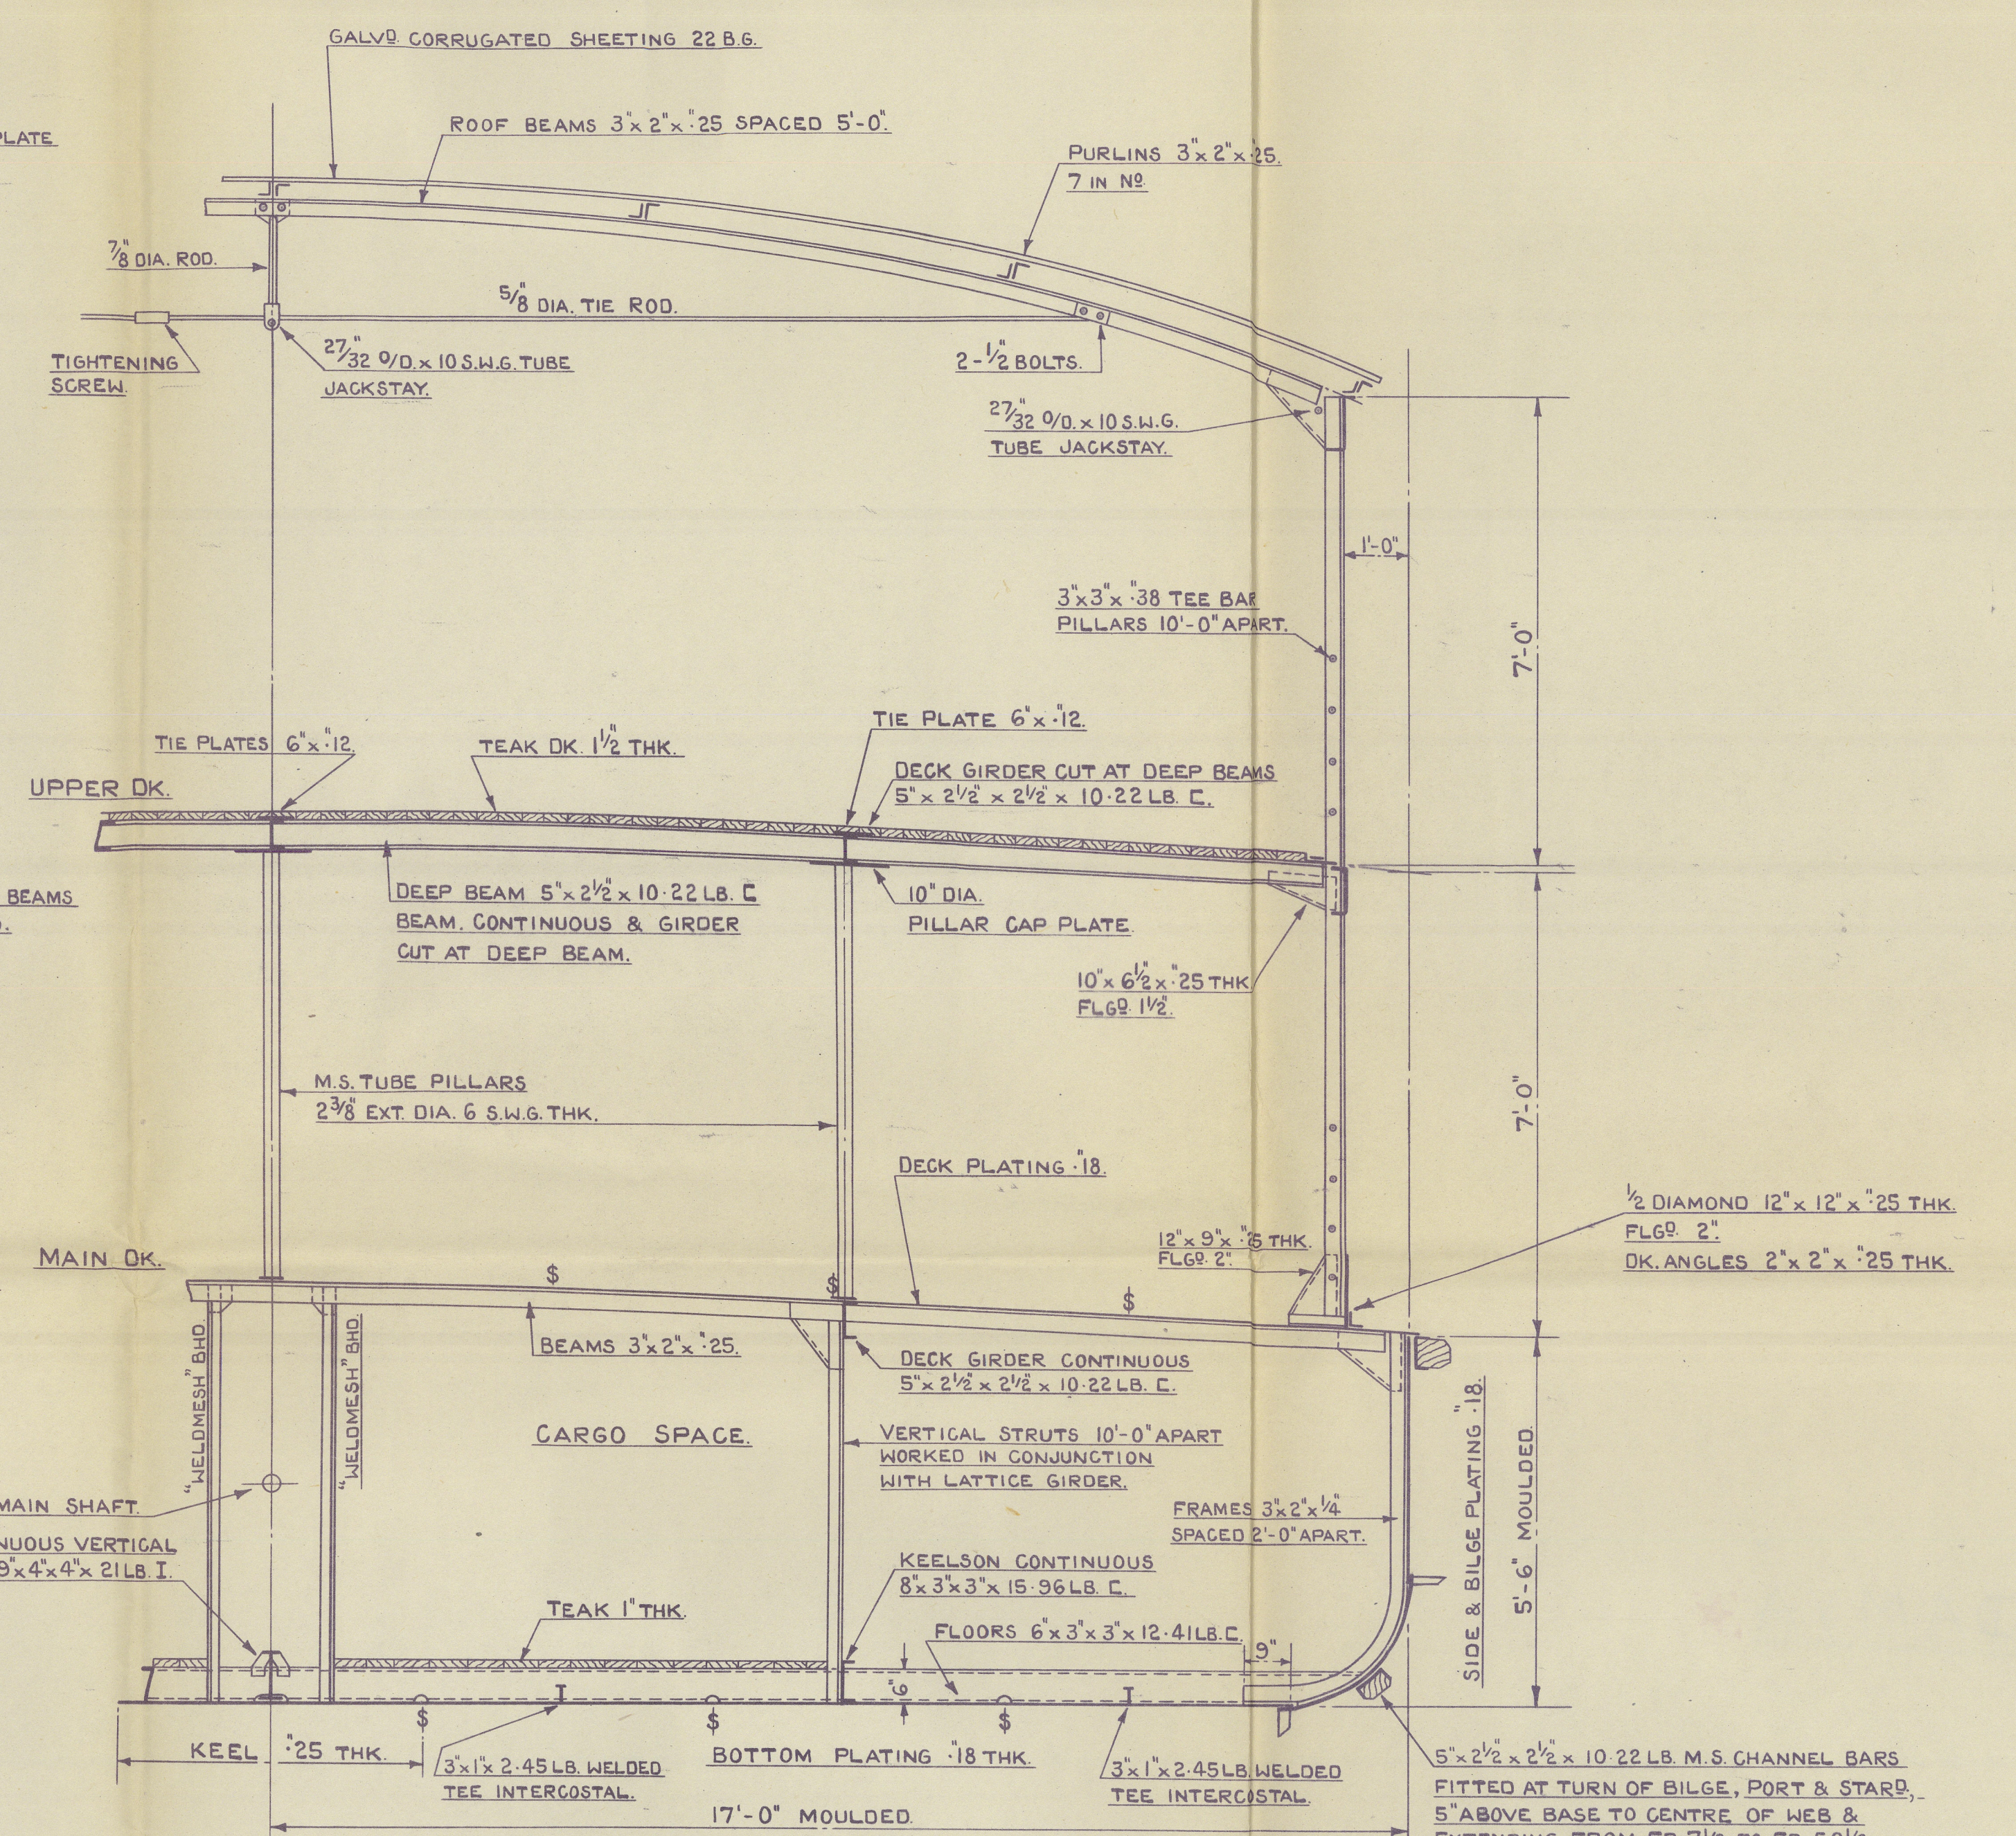

SECTION AFT OF MACHY SPACE.

No 40788.

No 40788.

FENC
ALE E
NEL F
.DED

"
PADAMYA ★
"

RECORDS DEPT.
LONDON.

2

40

Midship Section
as Fitted



© 2021

Lloyd's Register
Foundation

011197-011206-0093