

'CHANT 58'


CONVERSION TO CARGO CARRIER.

SCALE $\frac{3}{4}$ " : 1'

5 AUG 1946

Q46

Approved
9.8.46
[Signature]

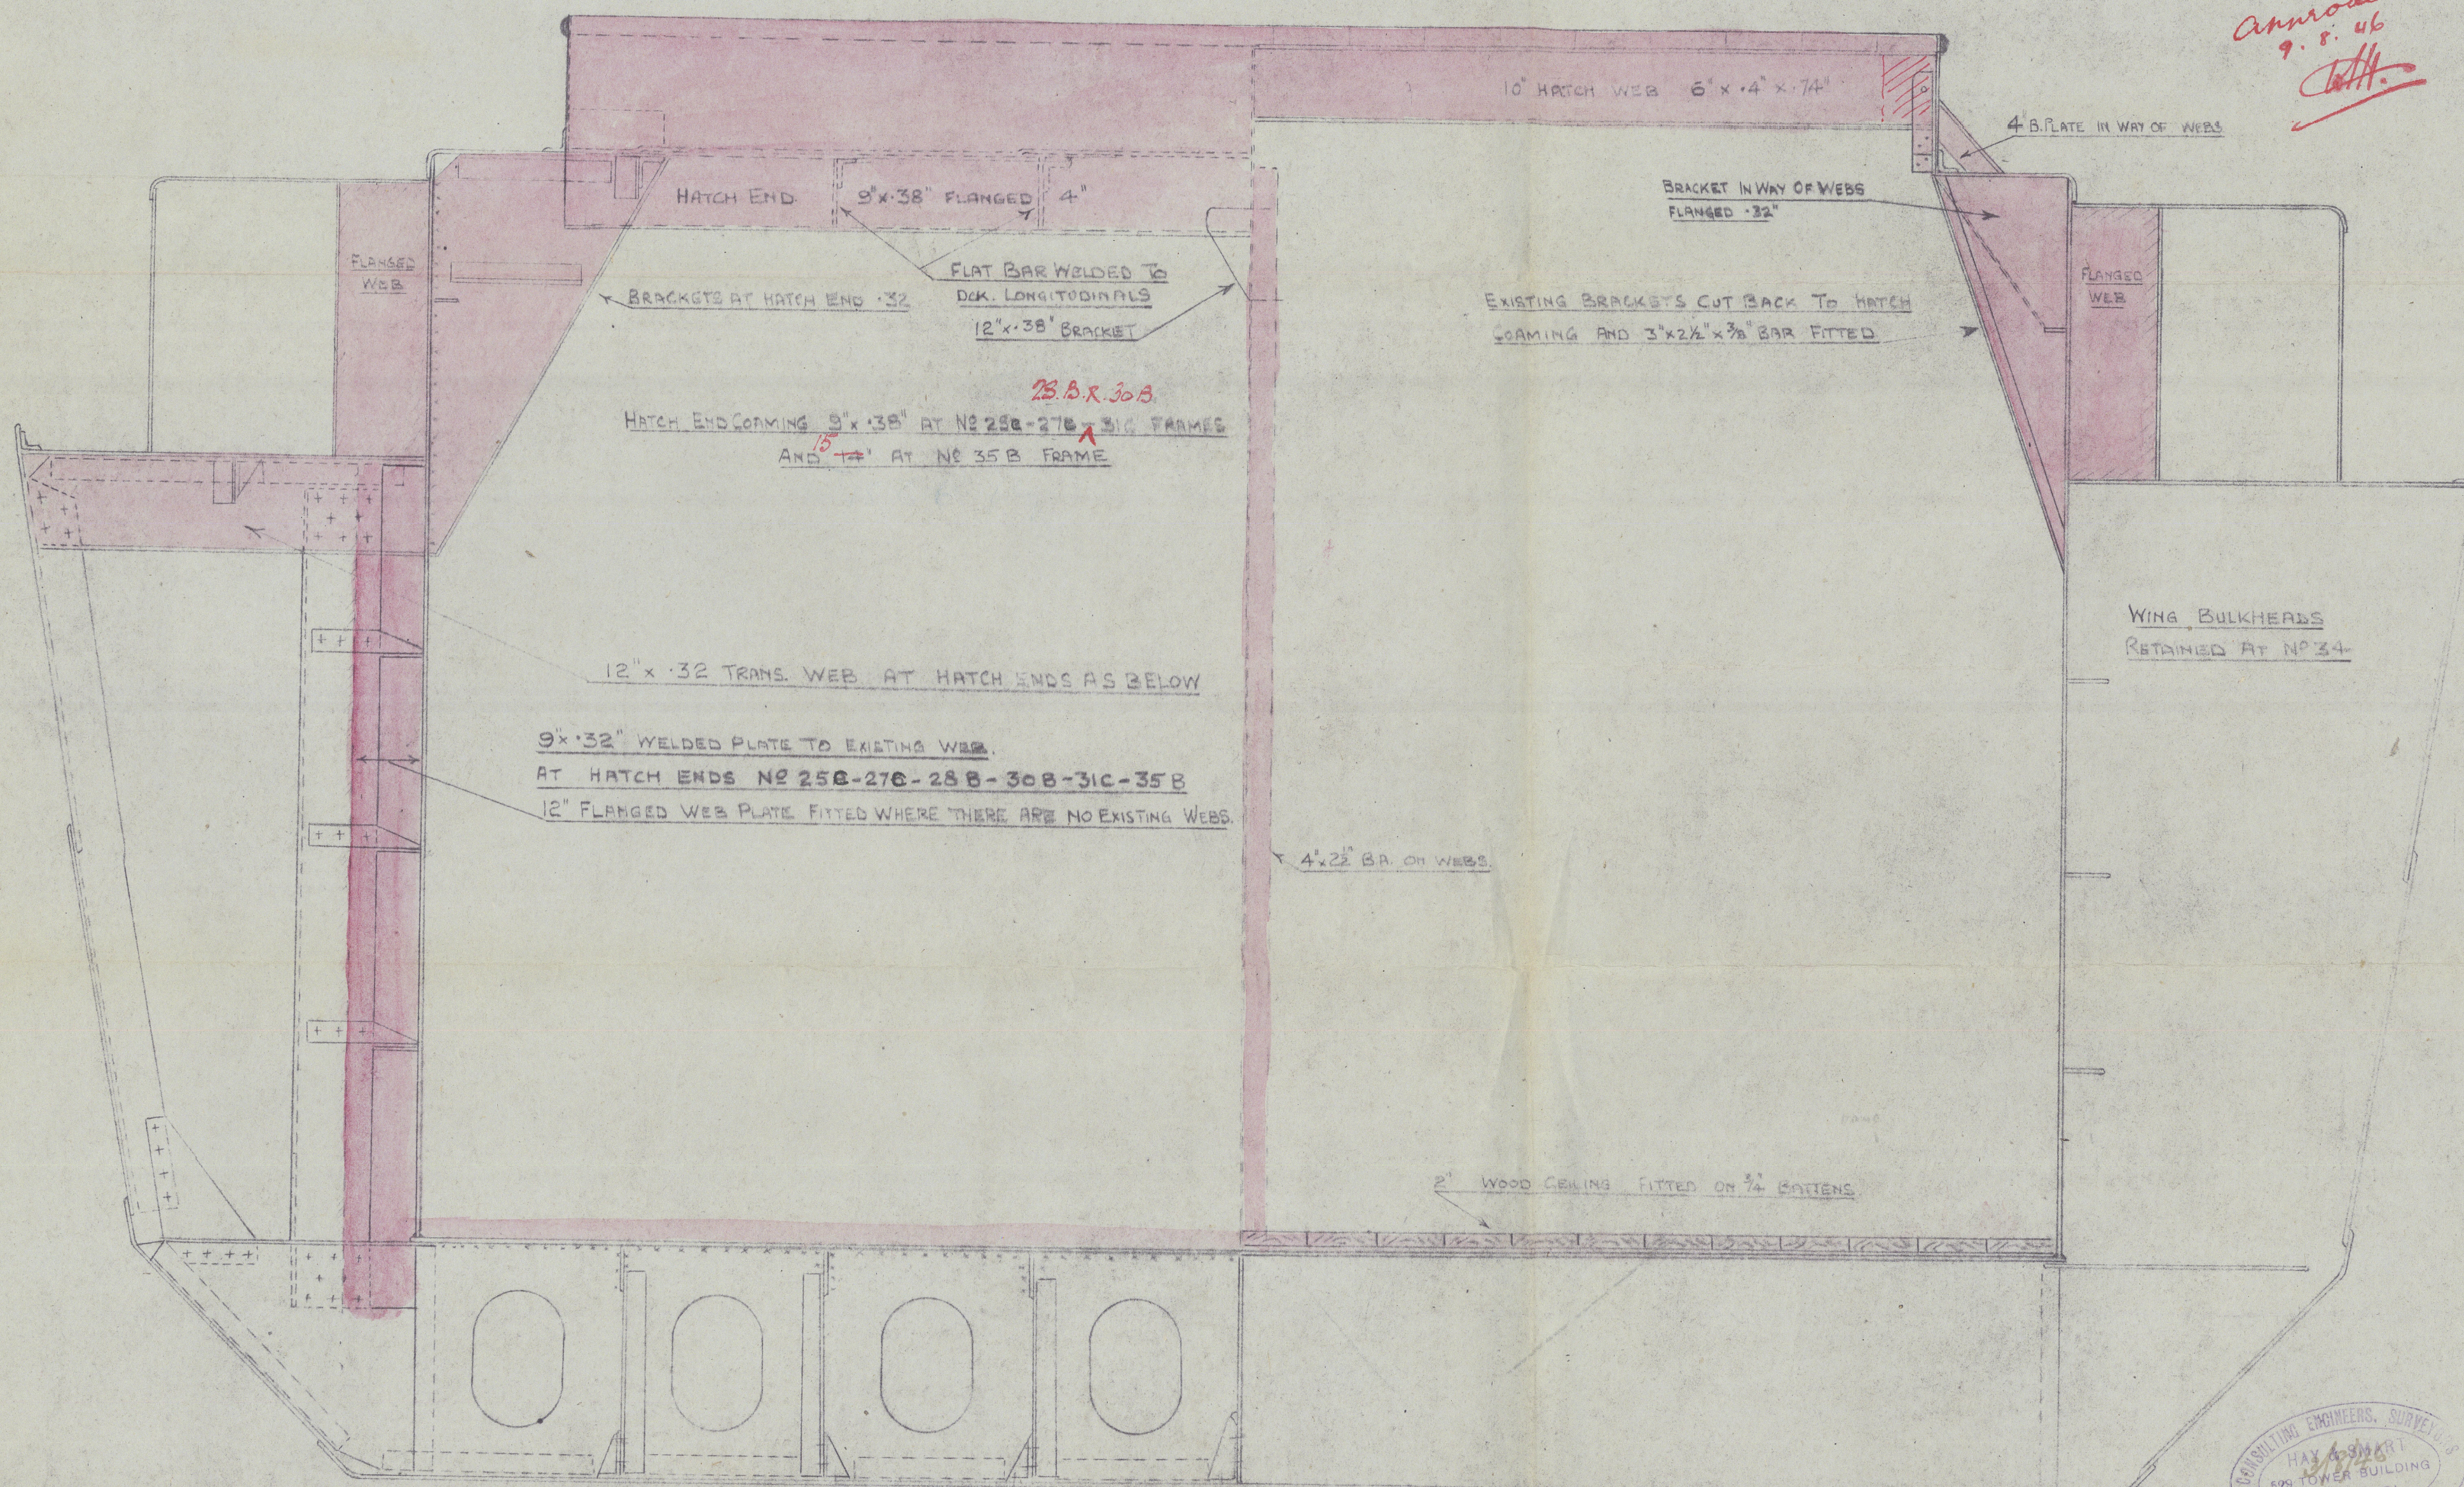

3

Convnt Midship Section
Phant 58.

5 AUG 1946

Conversion Midship Section
KAMUNI
EX
5m CHANT 58.

Liverpool 9.8.46.

Bay

011235-011243-0185



© 2021

Lloyd's Register
Foundation