

STERN FRAME & RUDDER PLAN.

YARD No. 345


SCALE 1" = 1 FT. DETAILS 1/2" & 1" = 1 FT.

TO LLOYD'S REQUIREMENTS, TESTS & INSPECTION.

STERN FRAME & RUDDER OF BEST SCRAP IRON.

SPEED NOT EXCEEDING 10 KNOTS.

See 344
320
310

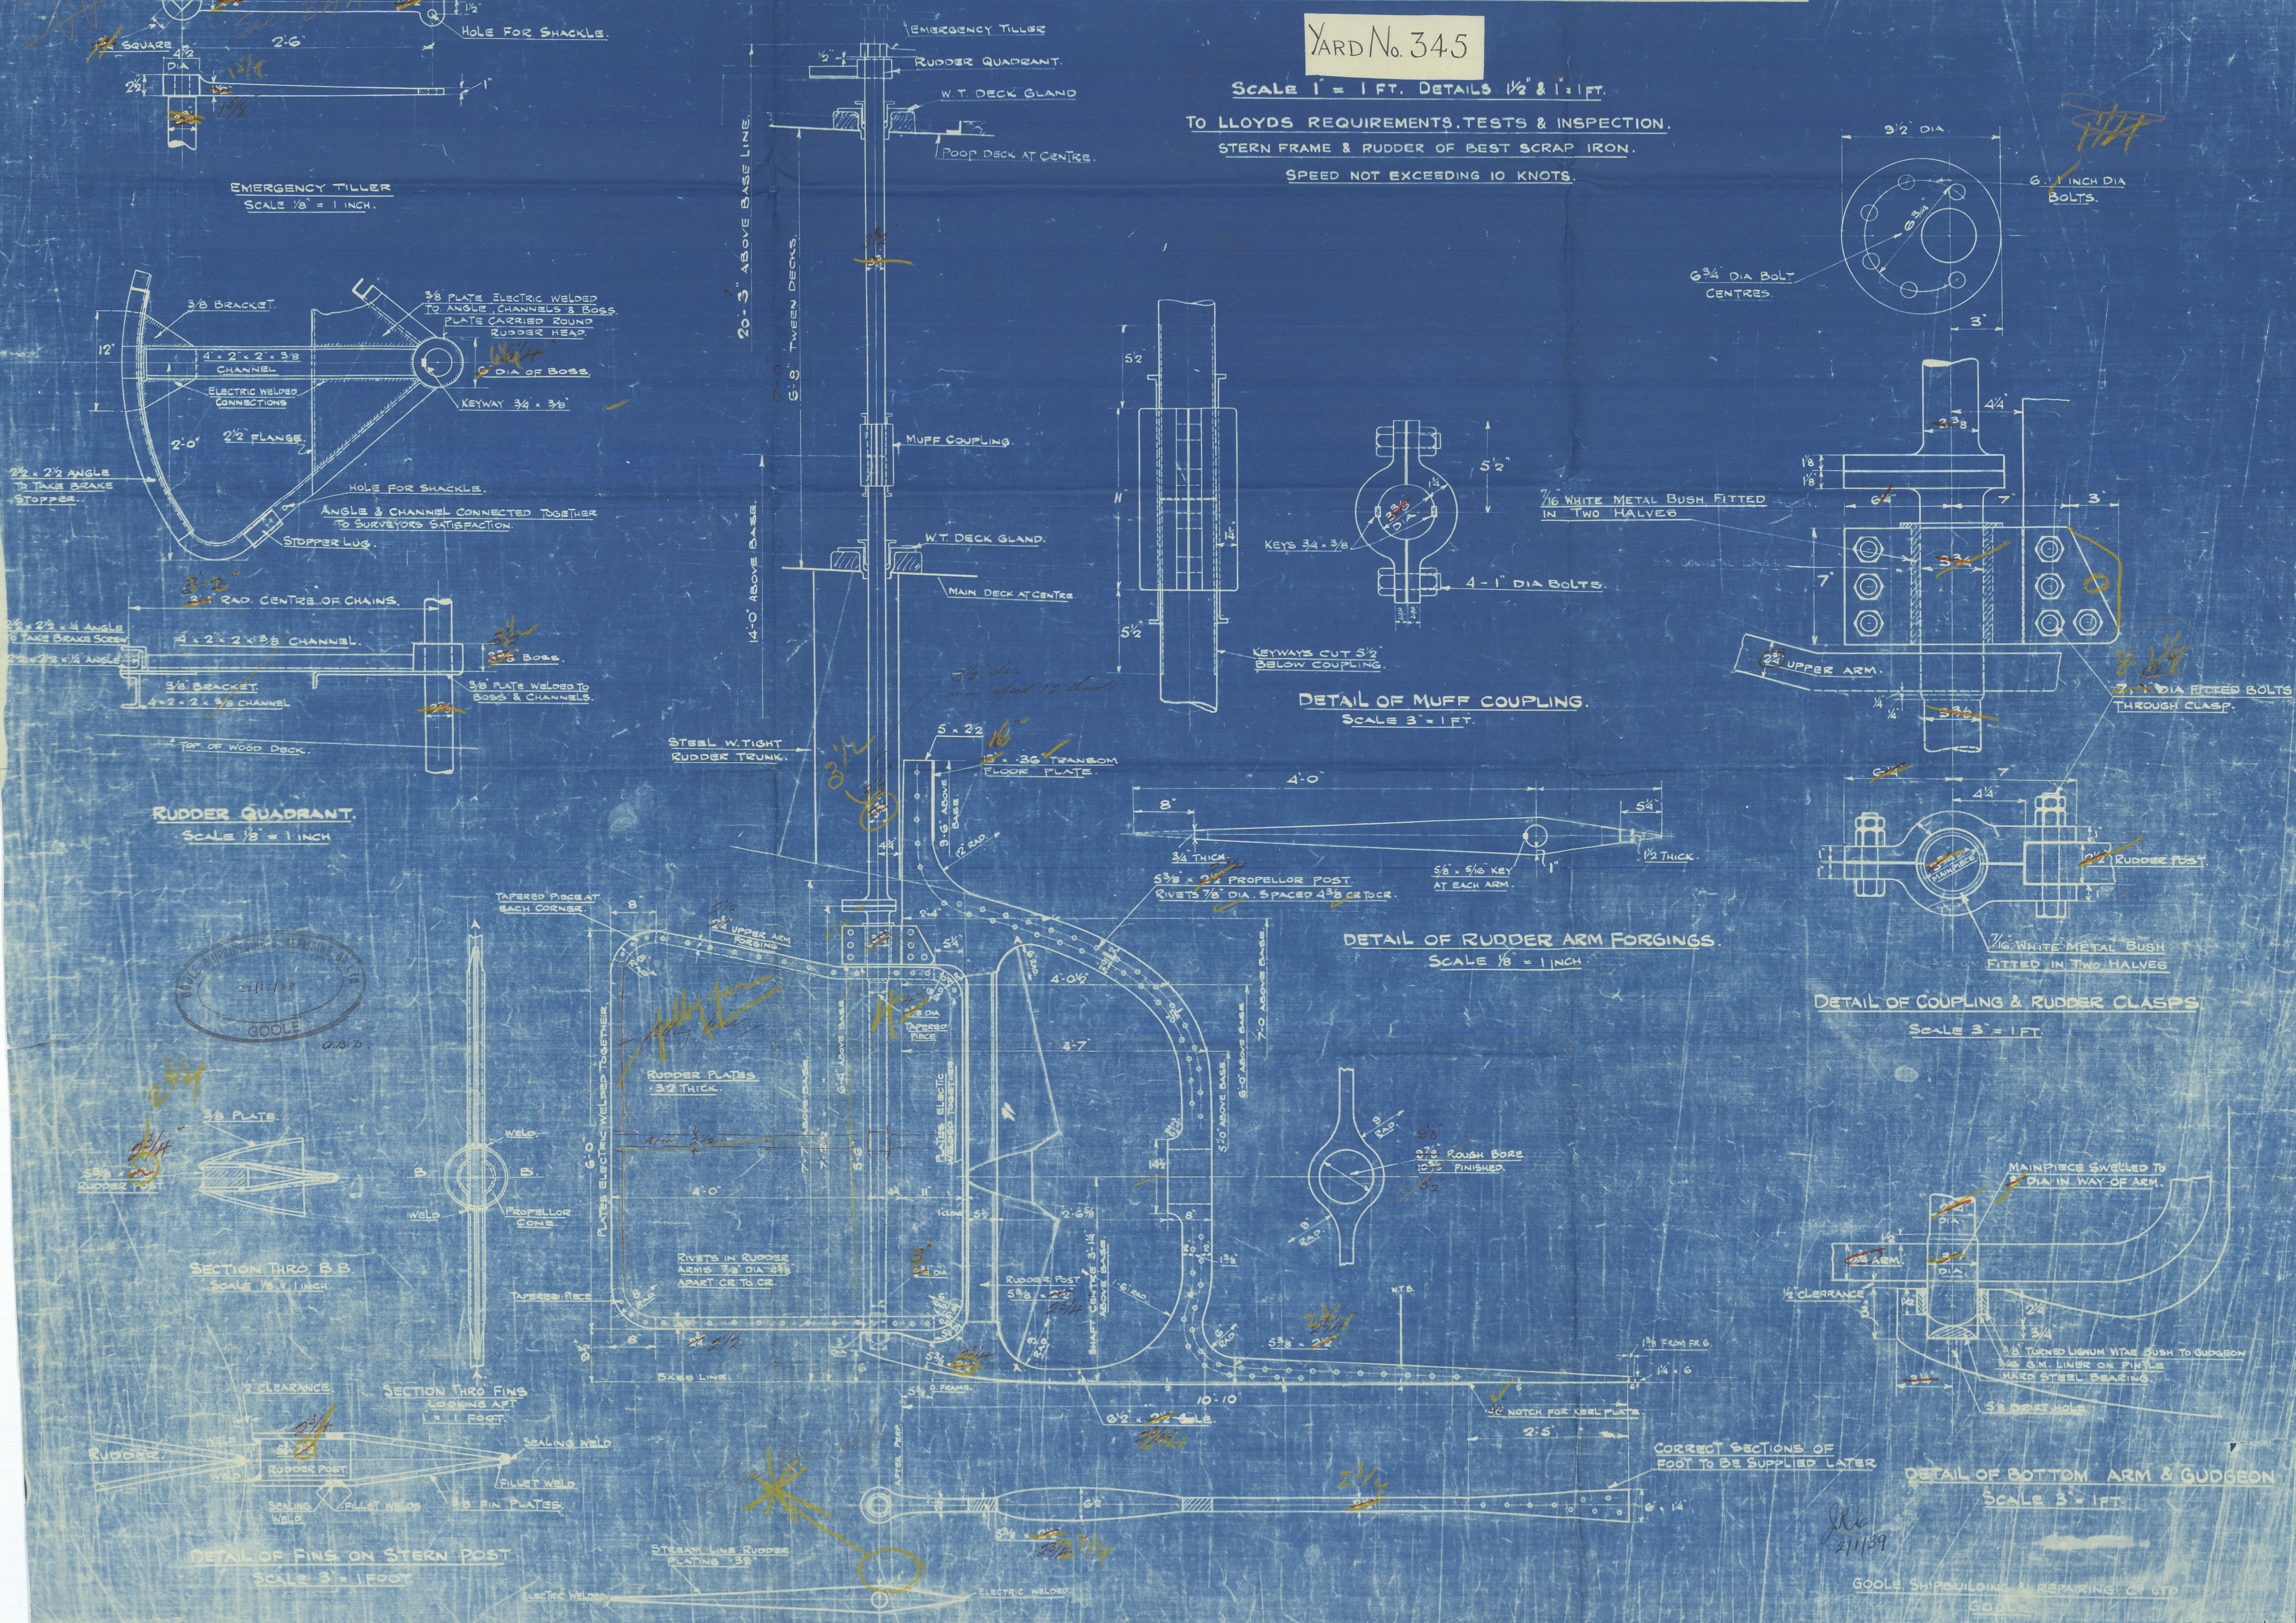

HULL

Goolle Shipbuilding
& Repairing Co, Ltd.

Yard No. 345

—
Sternframe & Rudder.

M.V. GLADONIA

~~GEN. BOX NO 358~~

4



© 2021

Lloyd's Register
Foundation

011251-011258-0169