

YARD N° 345 - PROFILE & DECK PLANS.

SCALE: $\frac{1}{8}" = 1 \text{ FOOT}$ - DIMENSIONS: - 140'-0" B.P. x 24'-6" MLD. x 10'-1" MLD.








TO CLASS LLOYDS 100 A.I. ∇

GOOLE SHIPBUILDING & REPAIRING CO. LTD.

GOOLE

PLAN N° 3578

PRINT N° 12883

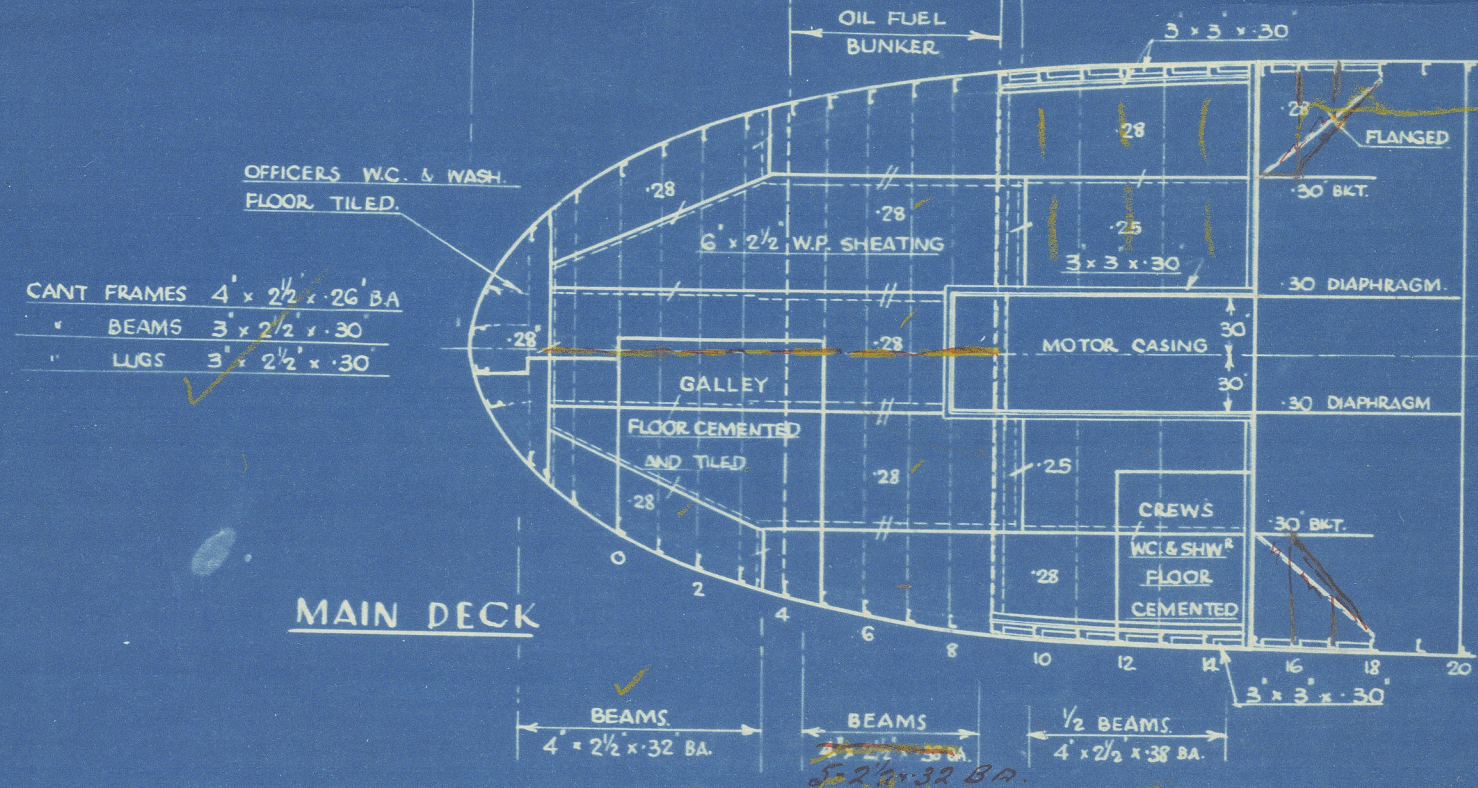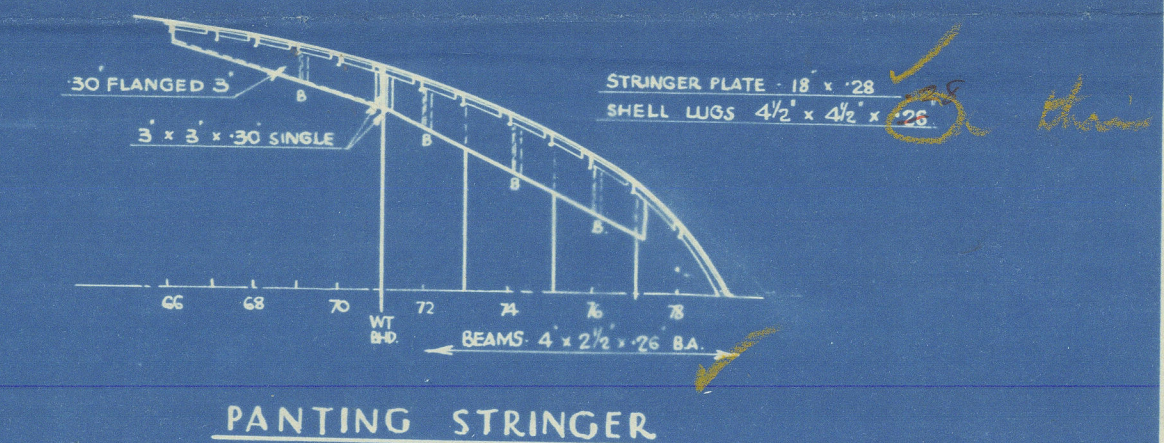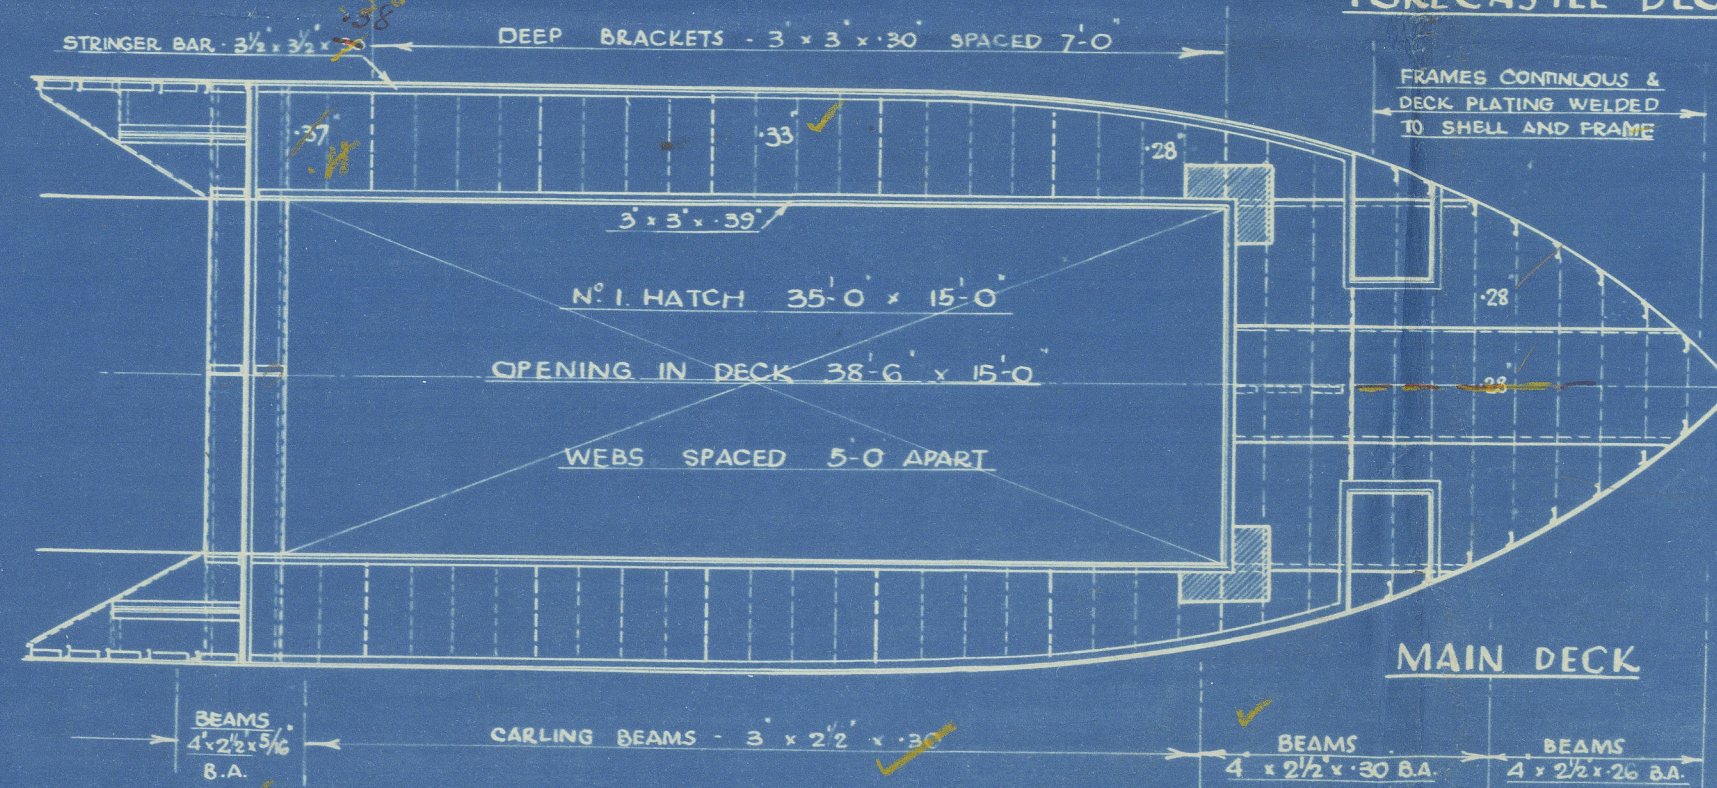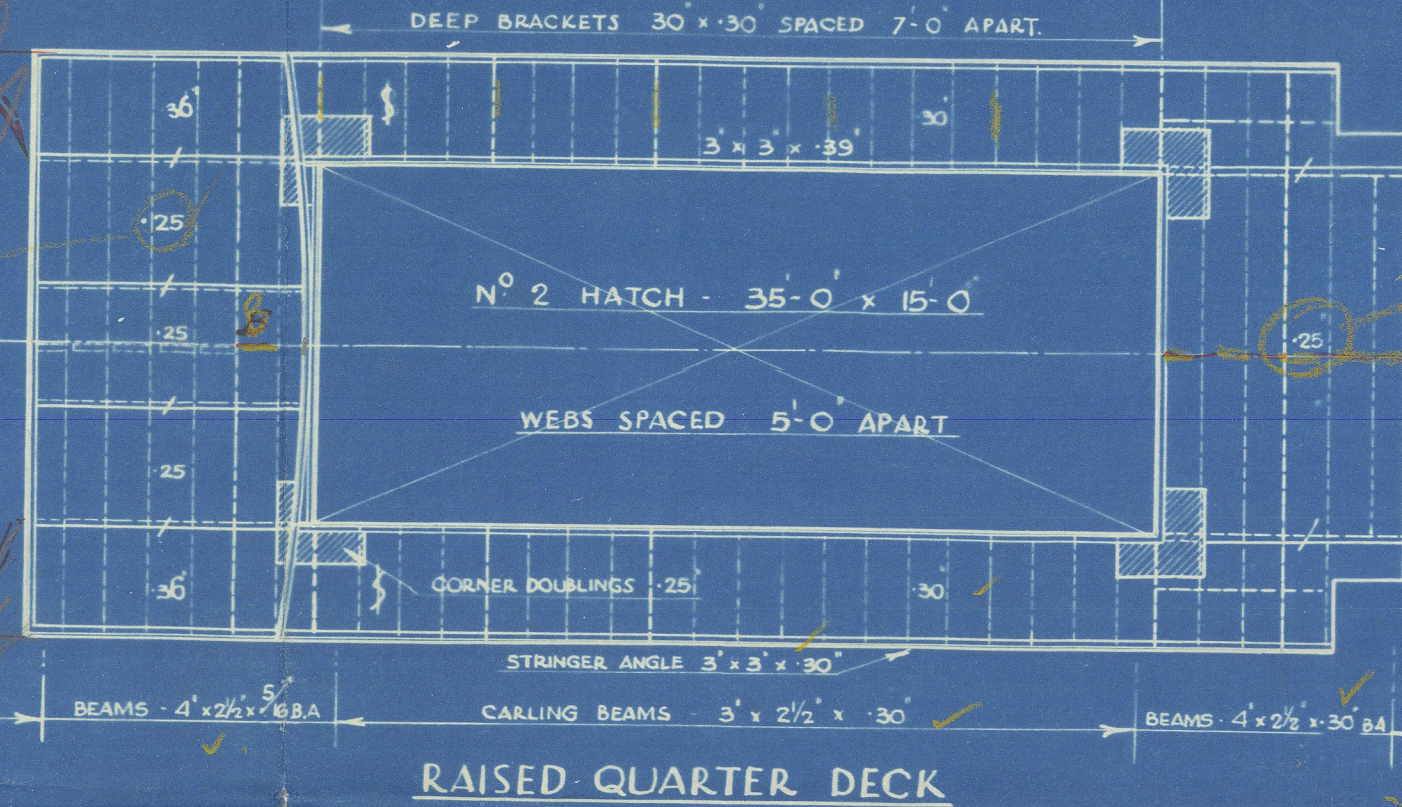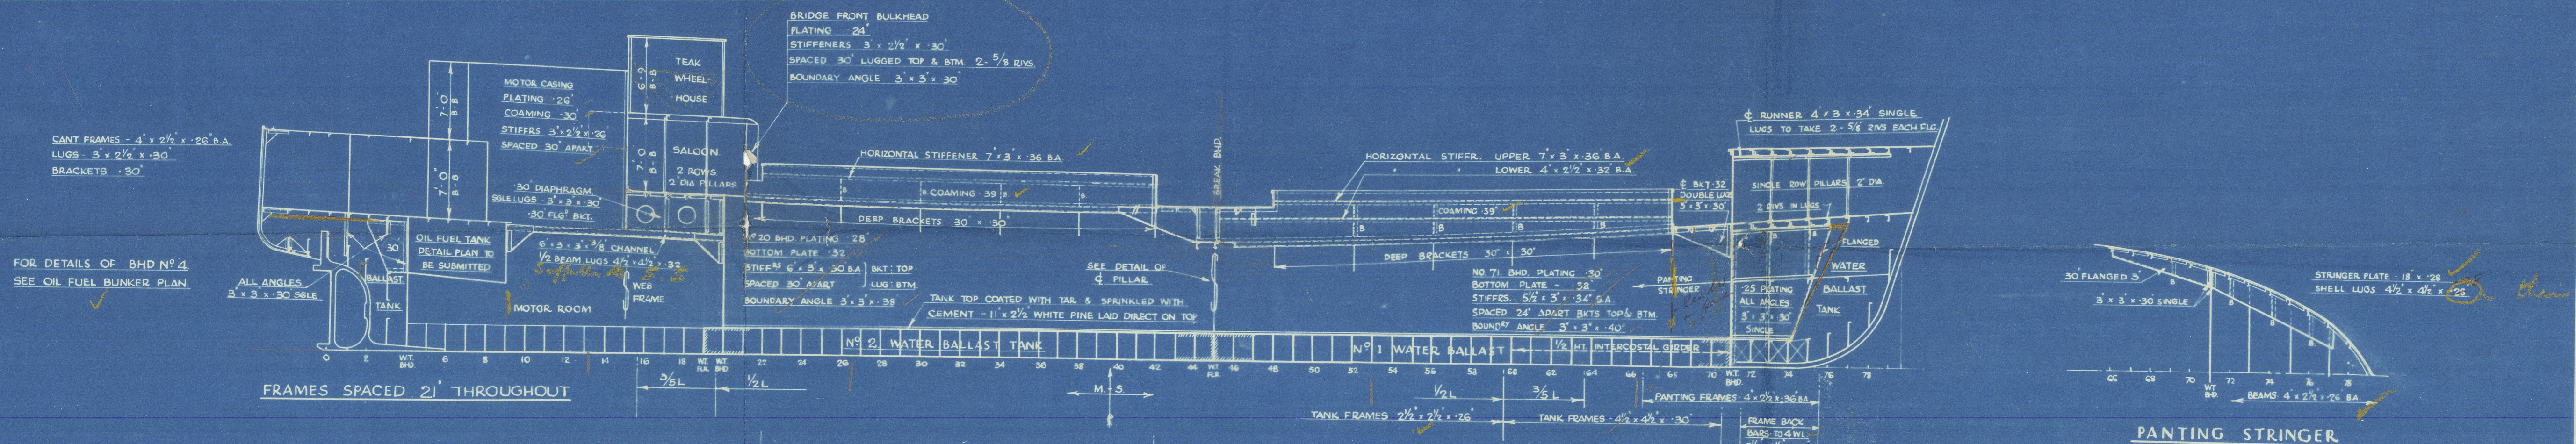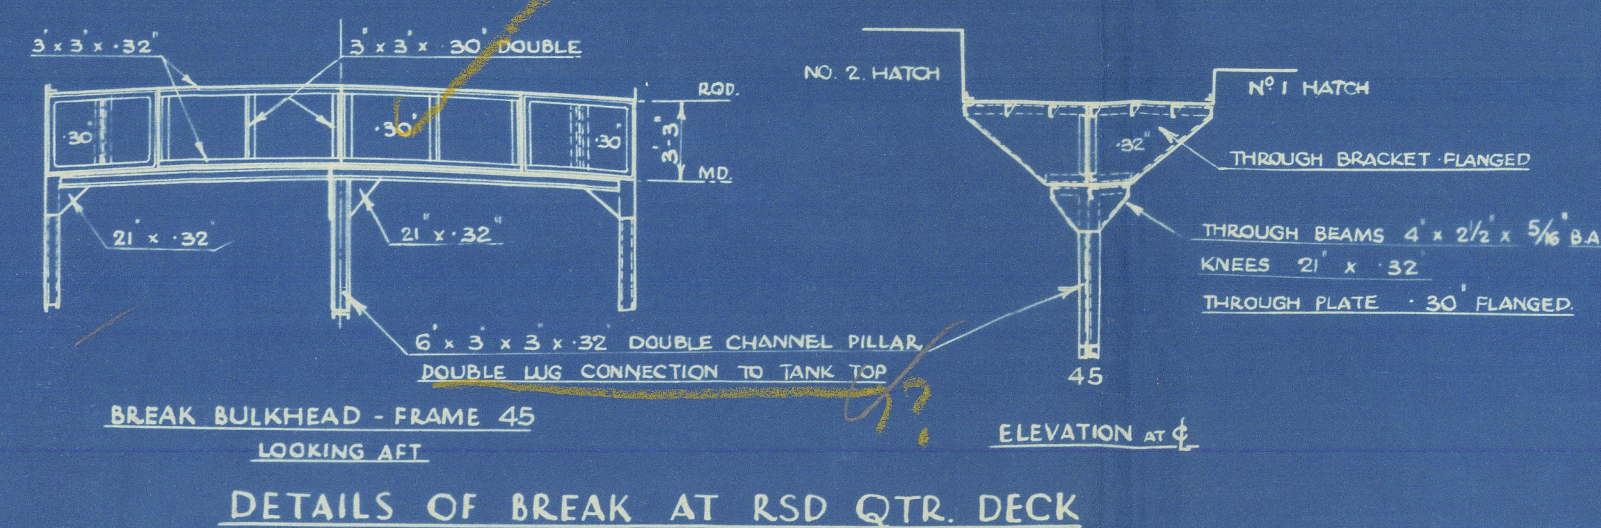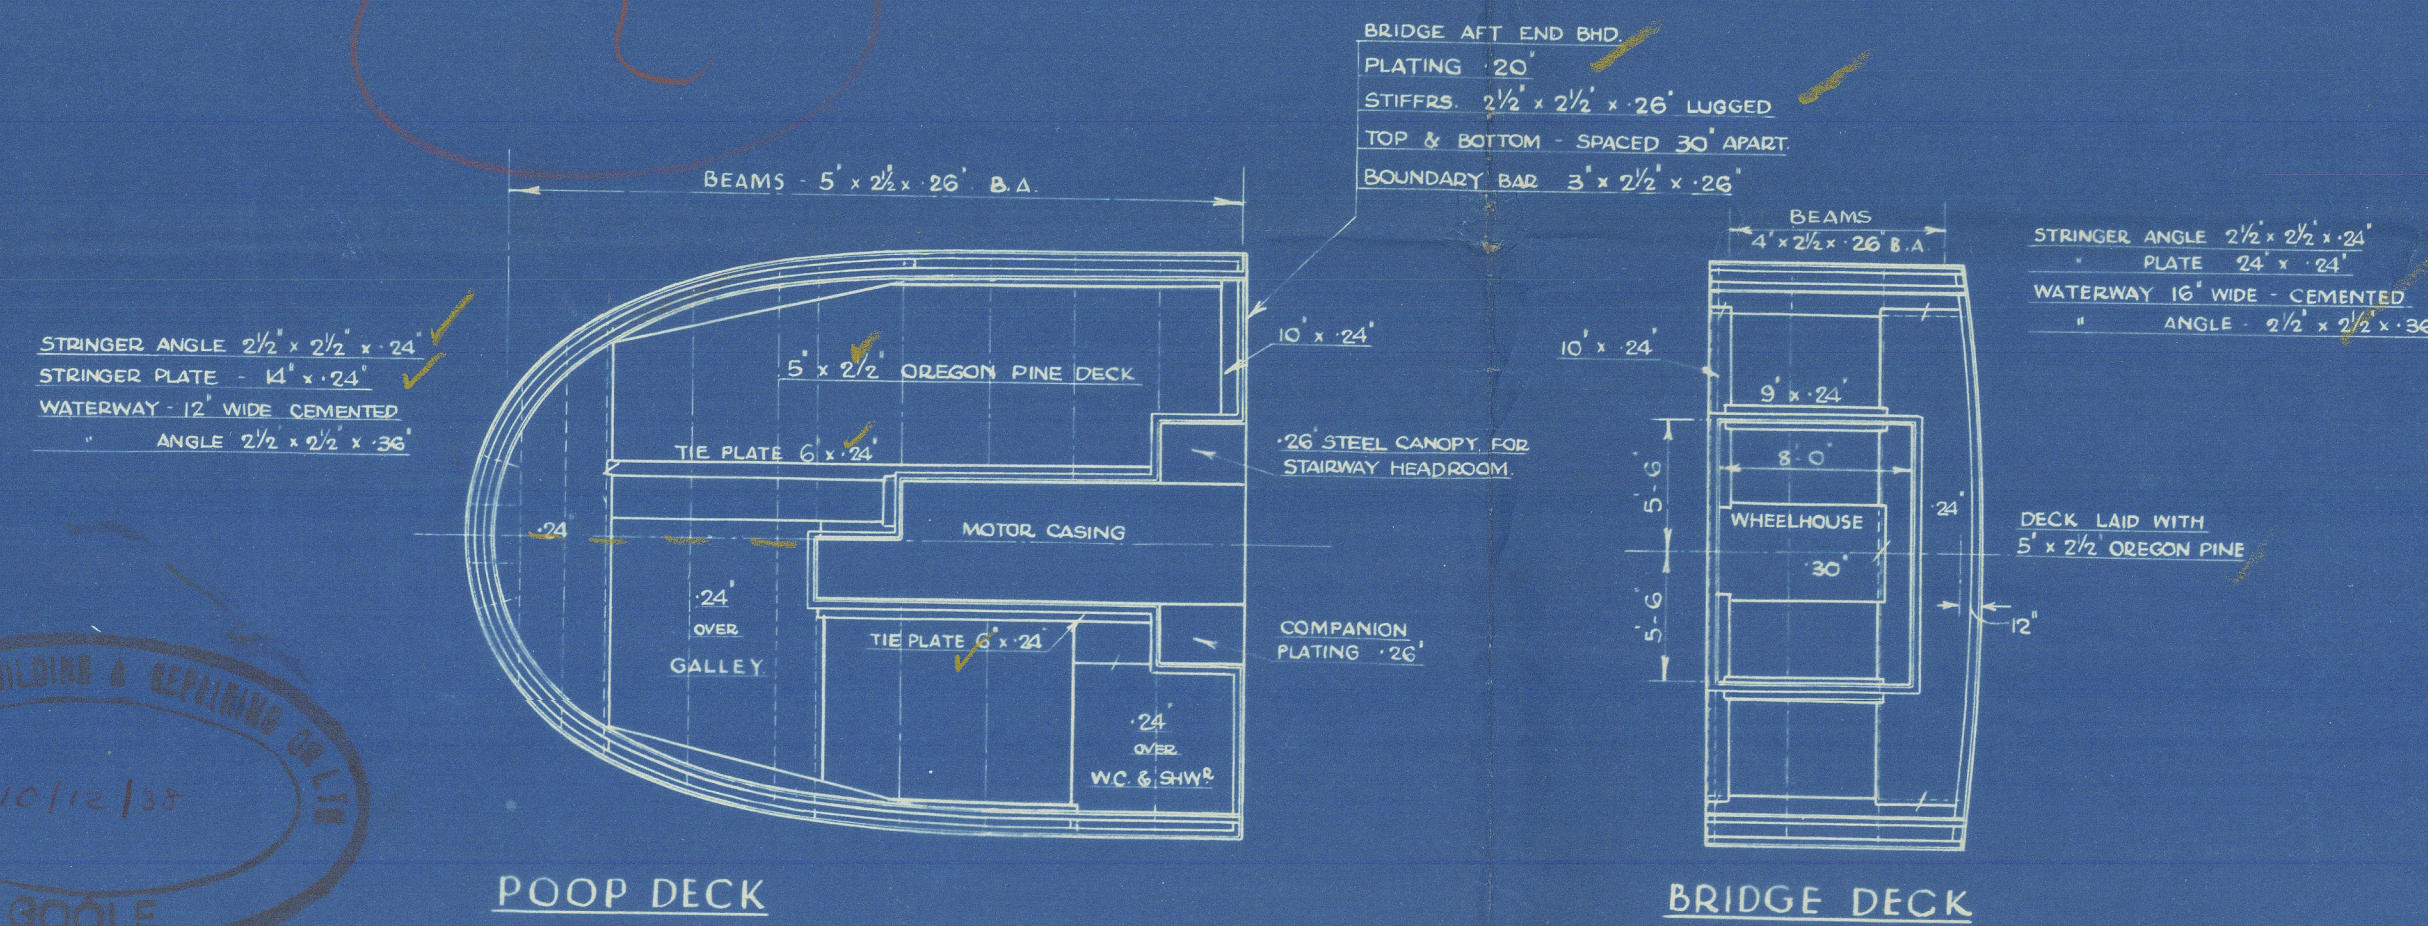

ADDITIONAL STRENGTHENING OF BOTTOM FWD. TANK FRAMES FORWARD OF $\frac{1}{2}L$ - $4\frac{1}{2} \times 4\frac{1}{2} \times 30$ D.B. A AND B STRAKES OF SHELL PLATING INCREASED TO '35' RIVETS SPACED $5\frac{1}{2}$ DIAS. APART OR TO CR. IN FRAMES FLOORS AND PLATING SEAMS OF SHELL PLATING TO BE DOUBLE RIVETED

See 317

1912/38

Books N-345-

Profile & Decks

M.V. GLADONIA

~~GEN BOX N2 358~~

10



© 2021

Lloyd's Register
Foundation

011251-011258-0111