

PROFILE & DECK PLANS.

N° 265.



LENGTH B.P. 312'-6"

BREADTH MLO 45'-0"

DEPTH MLO 23'-1 1/2"

CLASS 100 A. & LLOYDS.

19.12.11
21.3.12

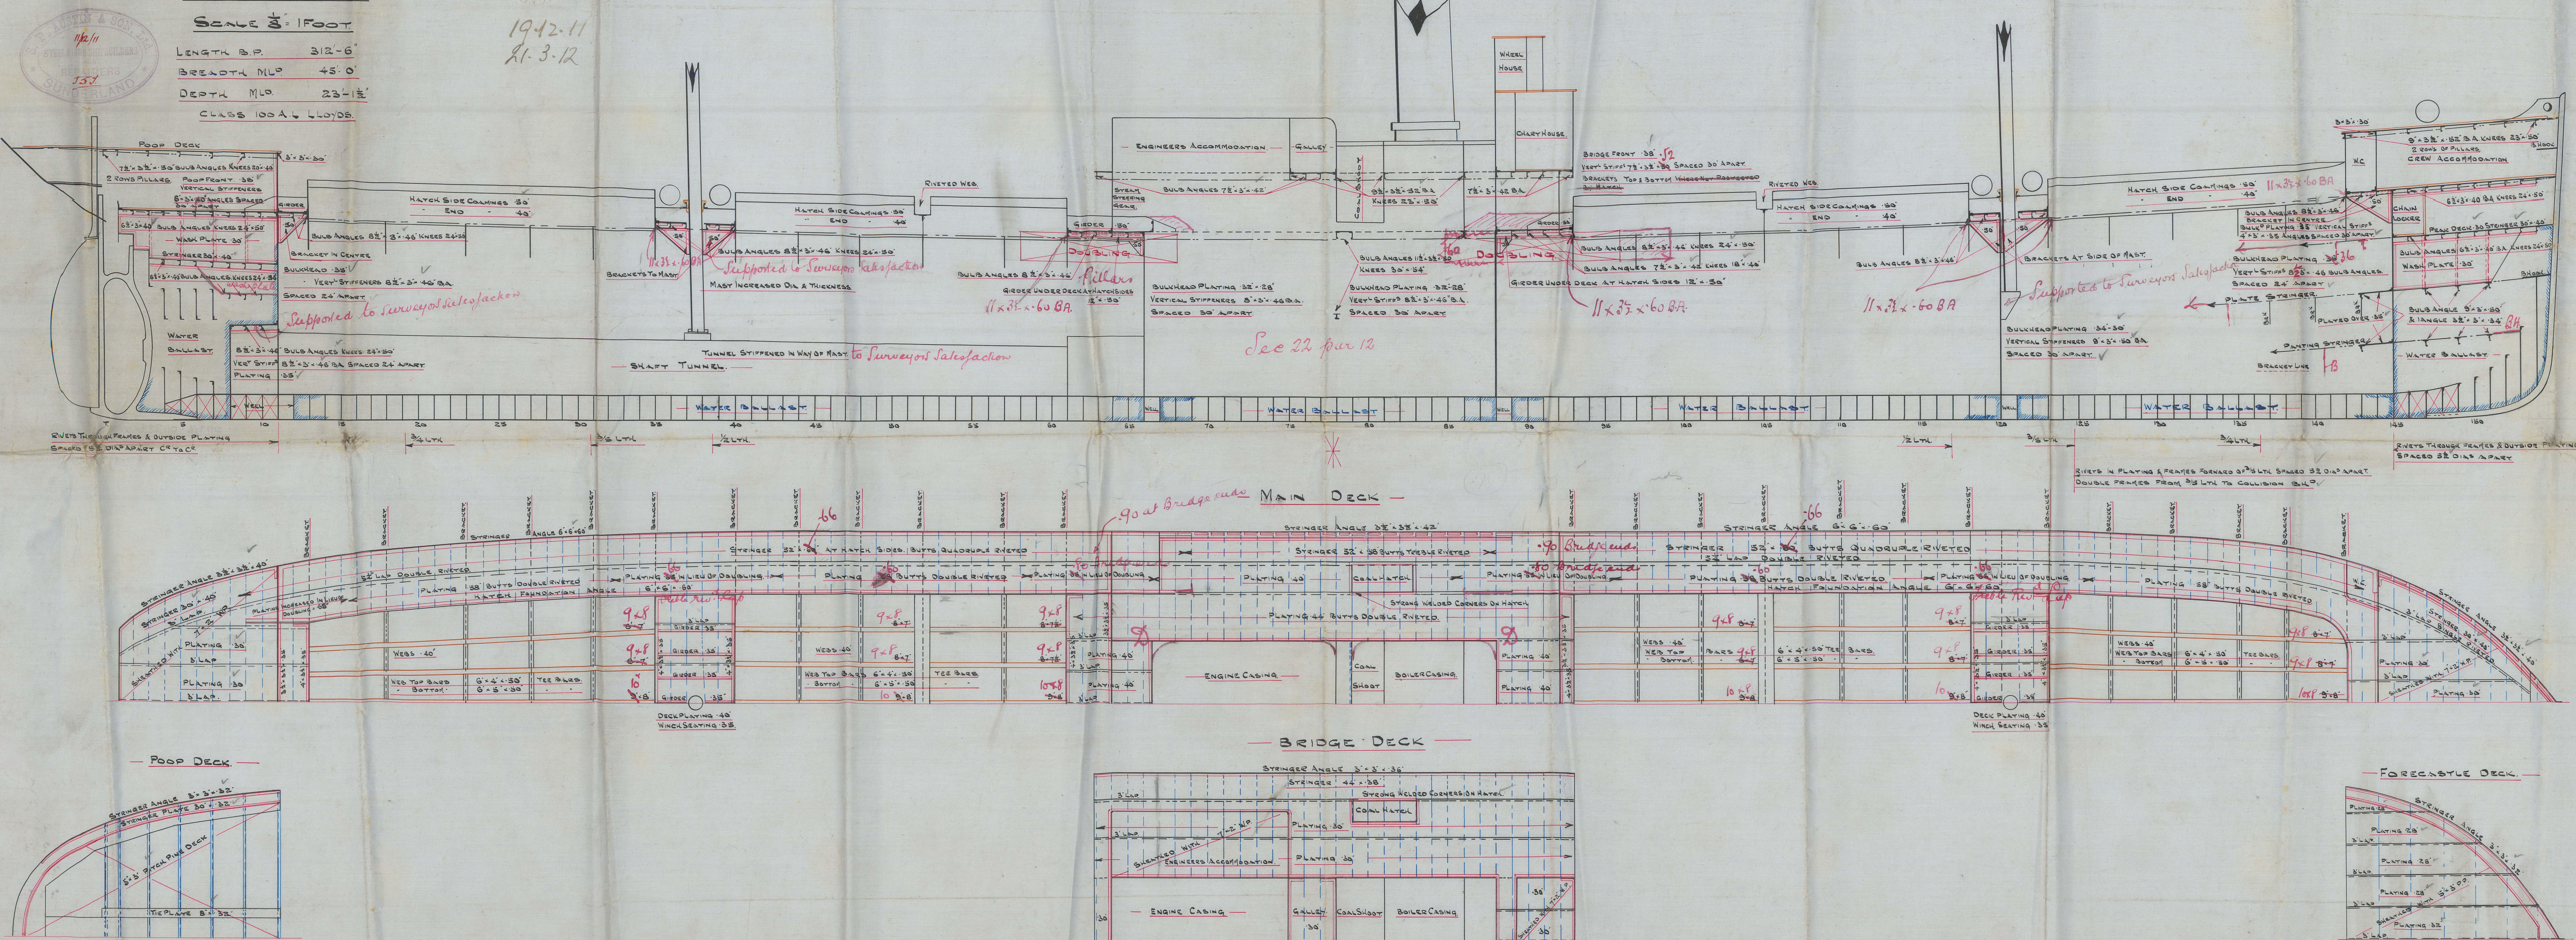

C.F.
19.12.11

8/8 "COVE"

PROFIE

S. P. Austin & Son

Nº 265

Sed. Rpt. no. 25504

Westcove

Nº 265

COVE = 1500

LENGTH 315

BREADTH 45

DEPTH 25

CLASS 100 A 1000



011316 = 011329-0050



© 2021

Lloyd's Register
Foundation